



JOB NO. 412.170

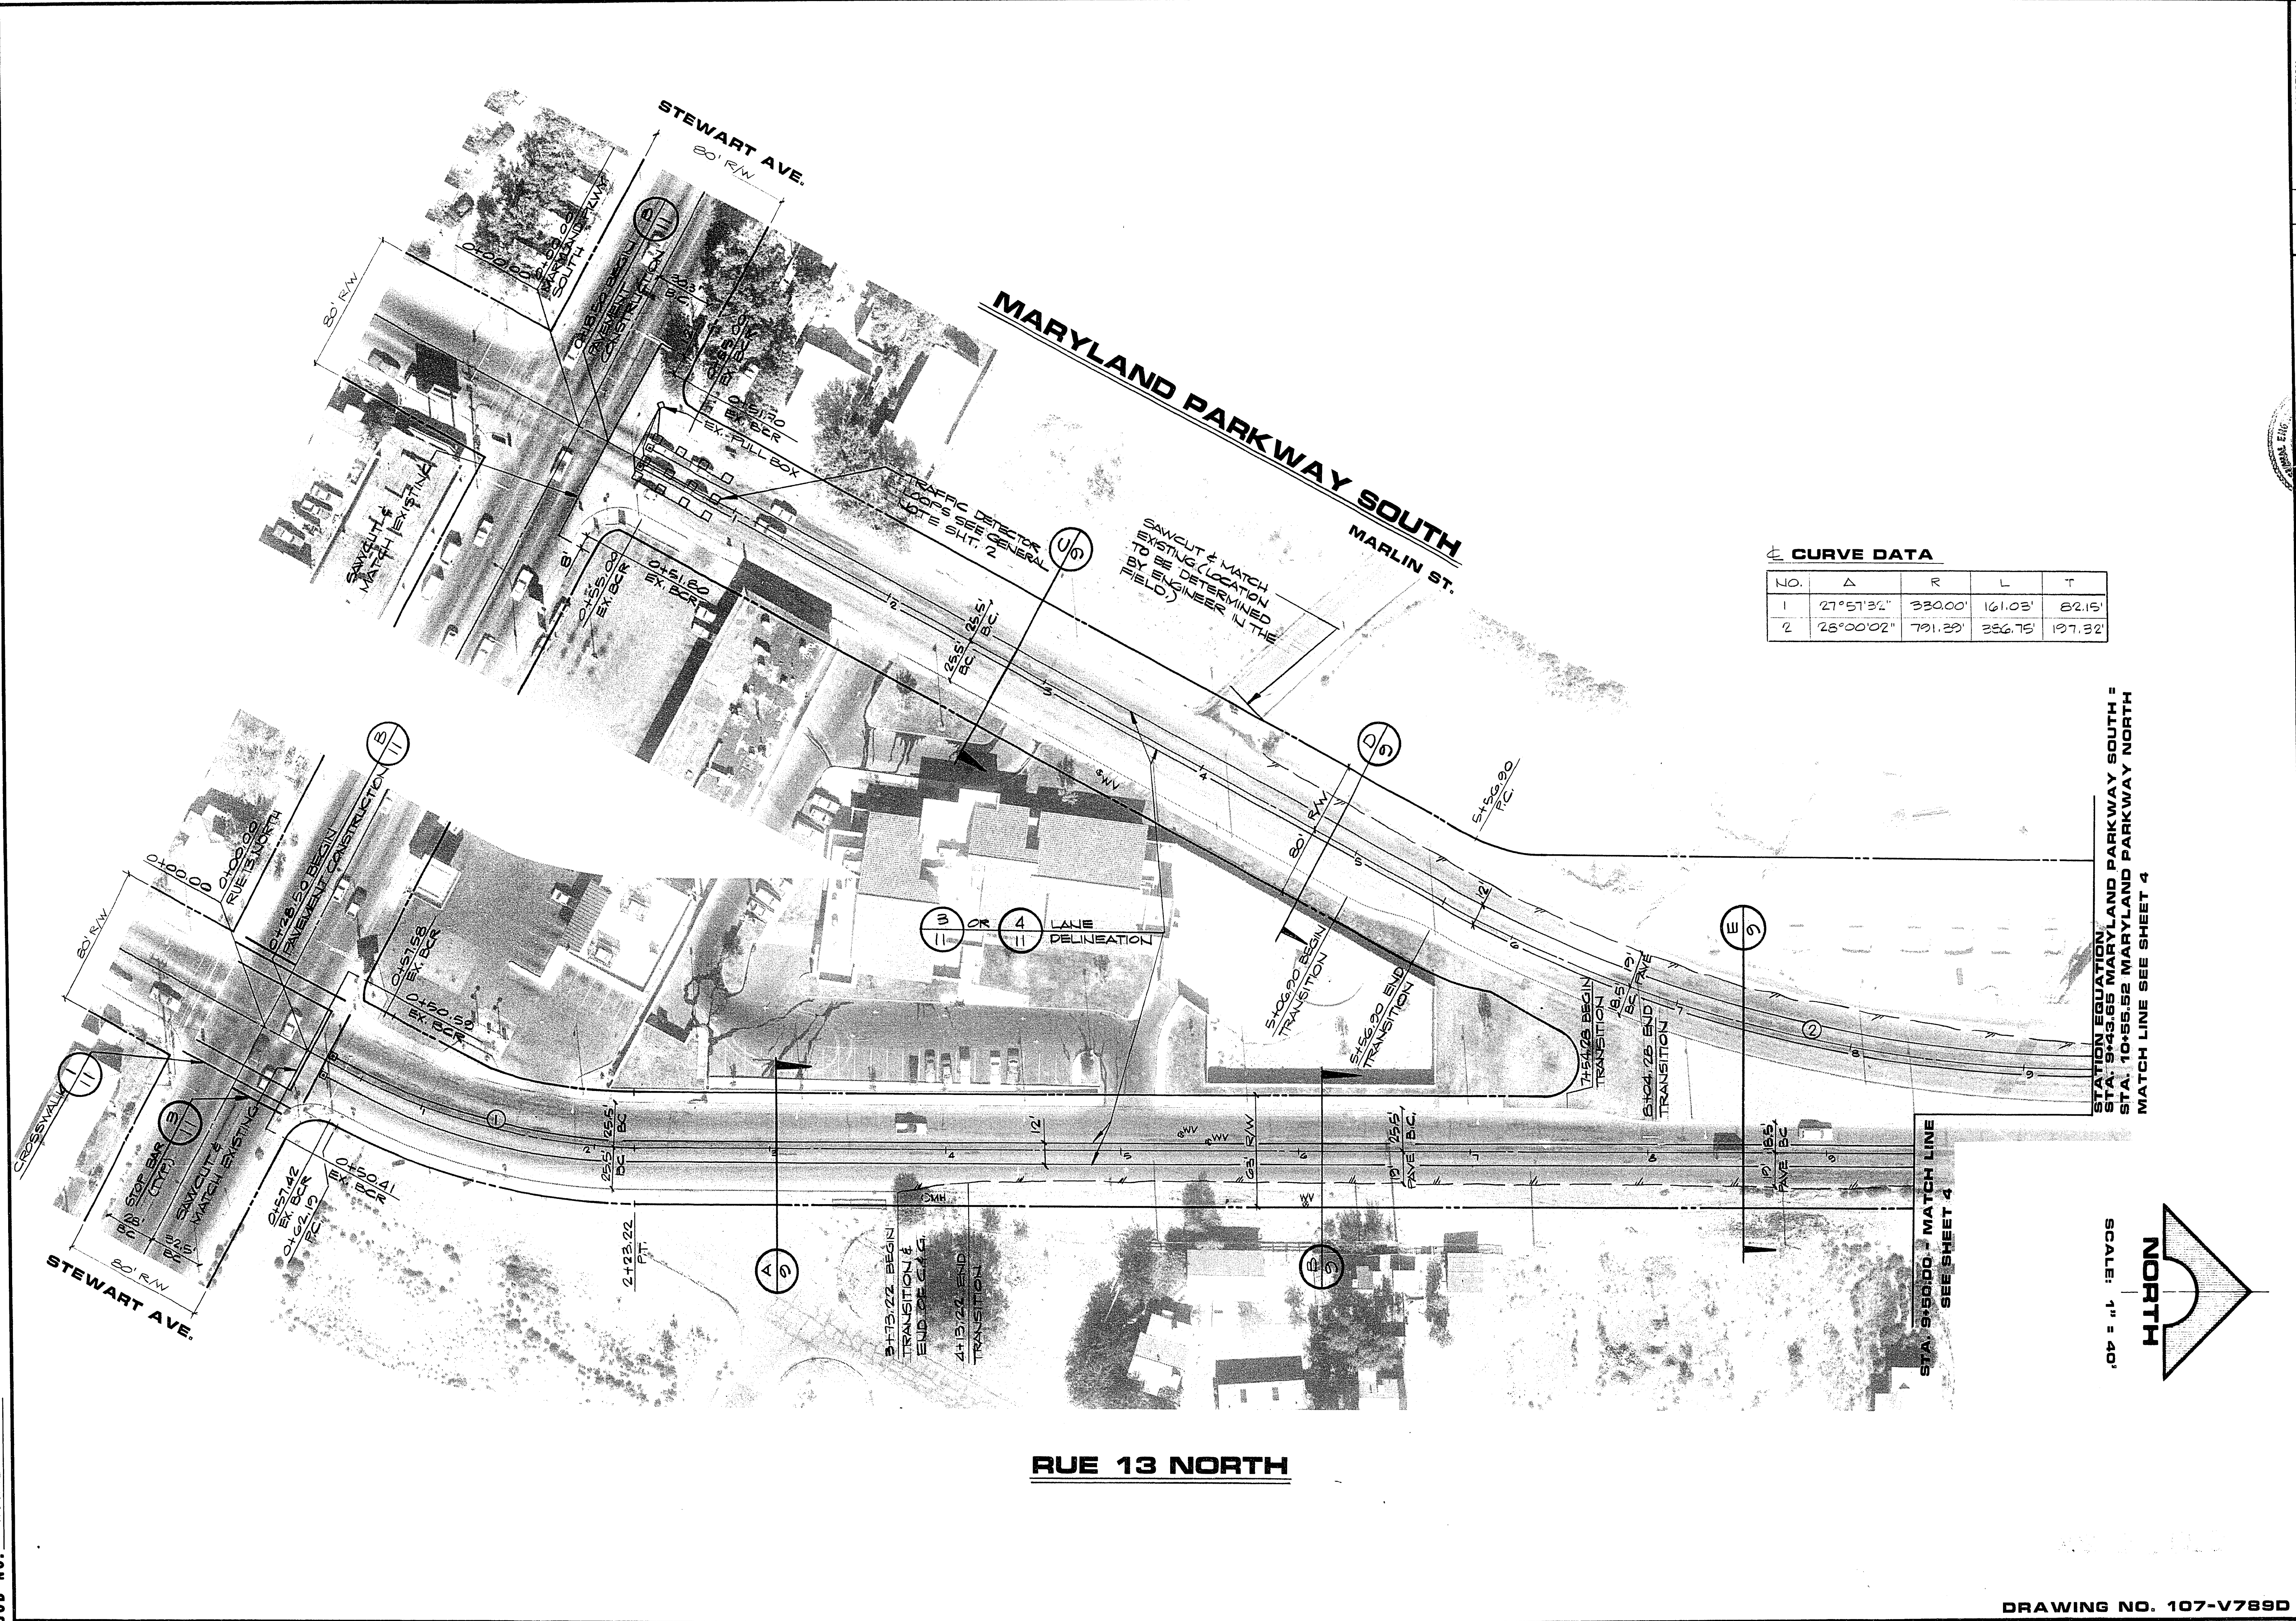

CURVE DATA

NO.	Δ	R	L	T
1	27°57'32"	930.00'	161.03'	82.15'
2	25°00'02"	791.29'	236.75'	197.32'

STATION EQUATION:
 STA. 9+50.00 = MARYLAND PARKWAY SOUTH =
 STA. 10+55.52 = MARYLAND PARKWAY NORTH =
 MATCH LINE SEE SHEET 4

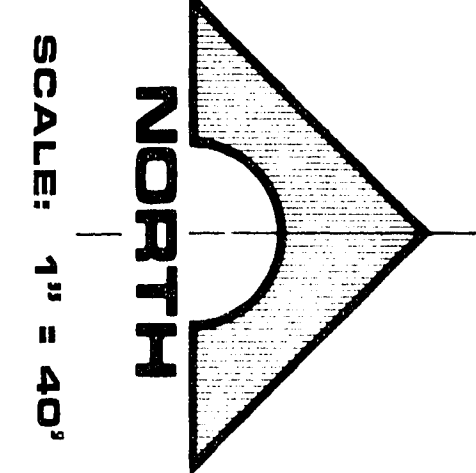

Department of Public Services
 MARYLAND PARKWAY
 PLAN STA. 0+18.50 TO STA. 9+43.65
 PLAN STA. 0+28.50 TO STA. 9+50.00



G. C. WALLACE
 Consulting Engineers, Inc.
 1100 East Sahara Ave. • Las Vegas, Nevada 89104 • 732-3330

RECOMMENDED
 REVISIONS
 DATE
 5/12/92
 10-12-92
 3343
 R.E. NO.
 DATE

DESCRIPTION
 AS BUILT
 NO REVISIONS

SHEET
3
 OF 11 SHEETS

DRAWING NO. 107-V7890

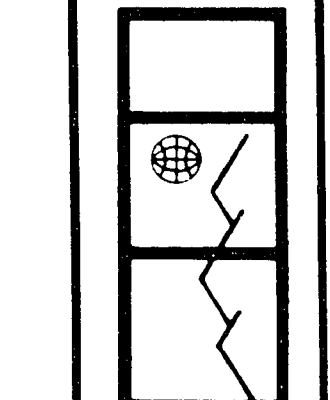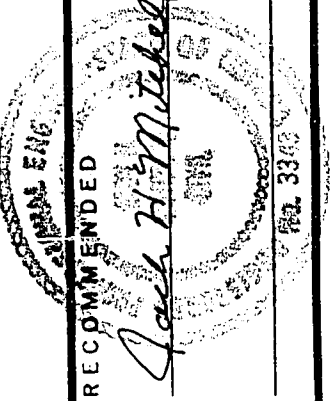

11.4.2.6