



TEMPORARY ACCESS ROAD

PROFILE

SCALE: HORIZ. 1" = 40'
VERT. 1" = 4'

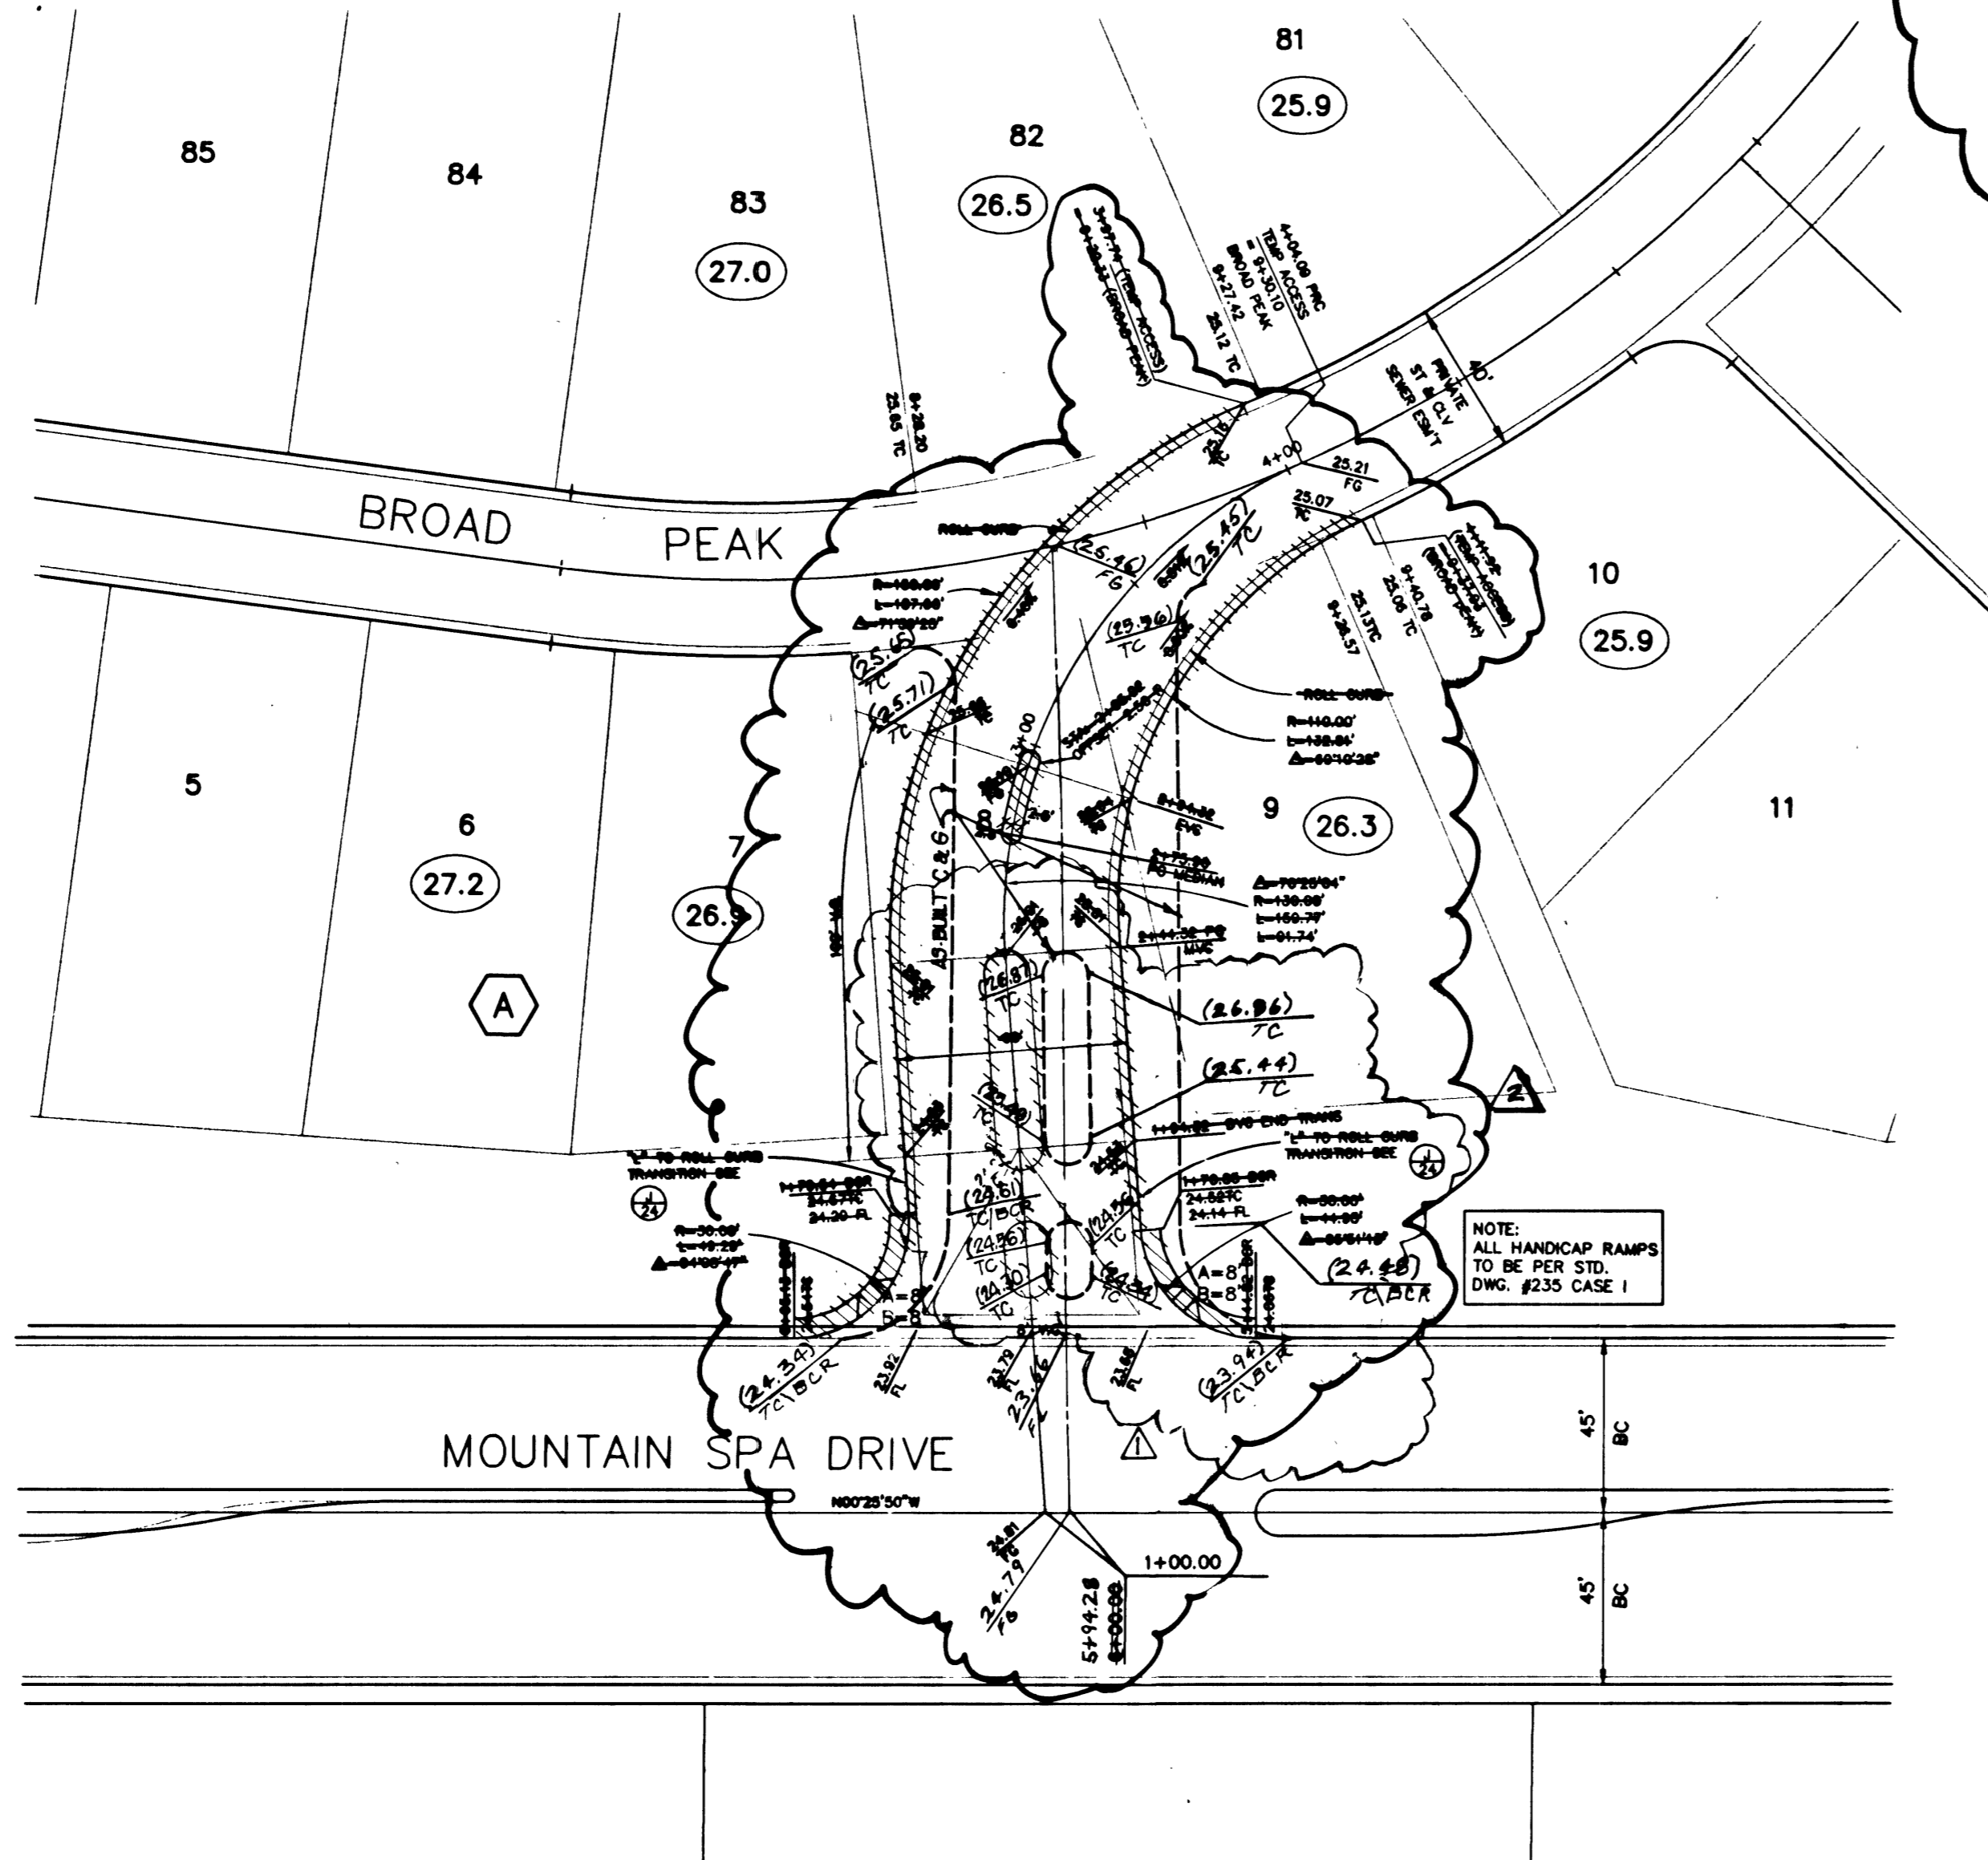

TEMPORARY ACCESS ROAD

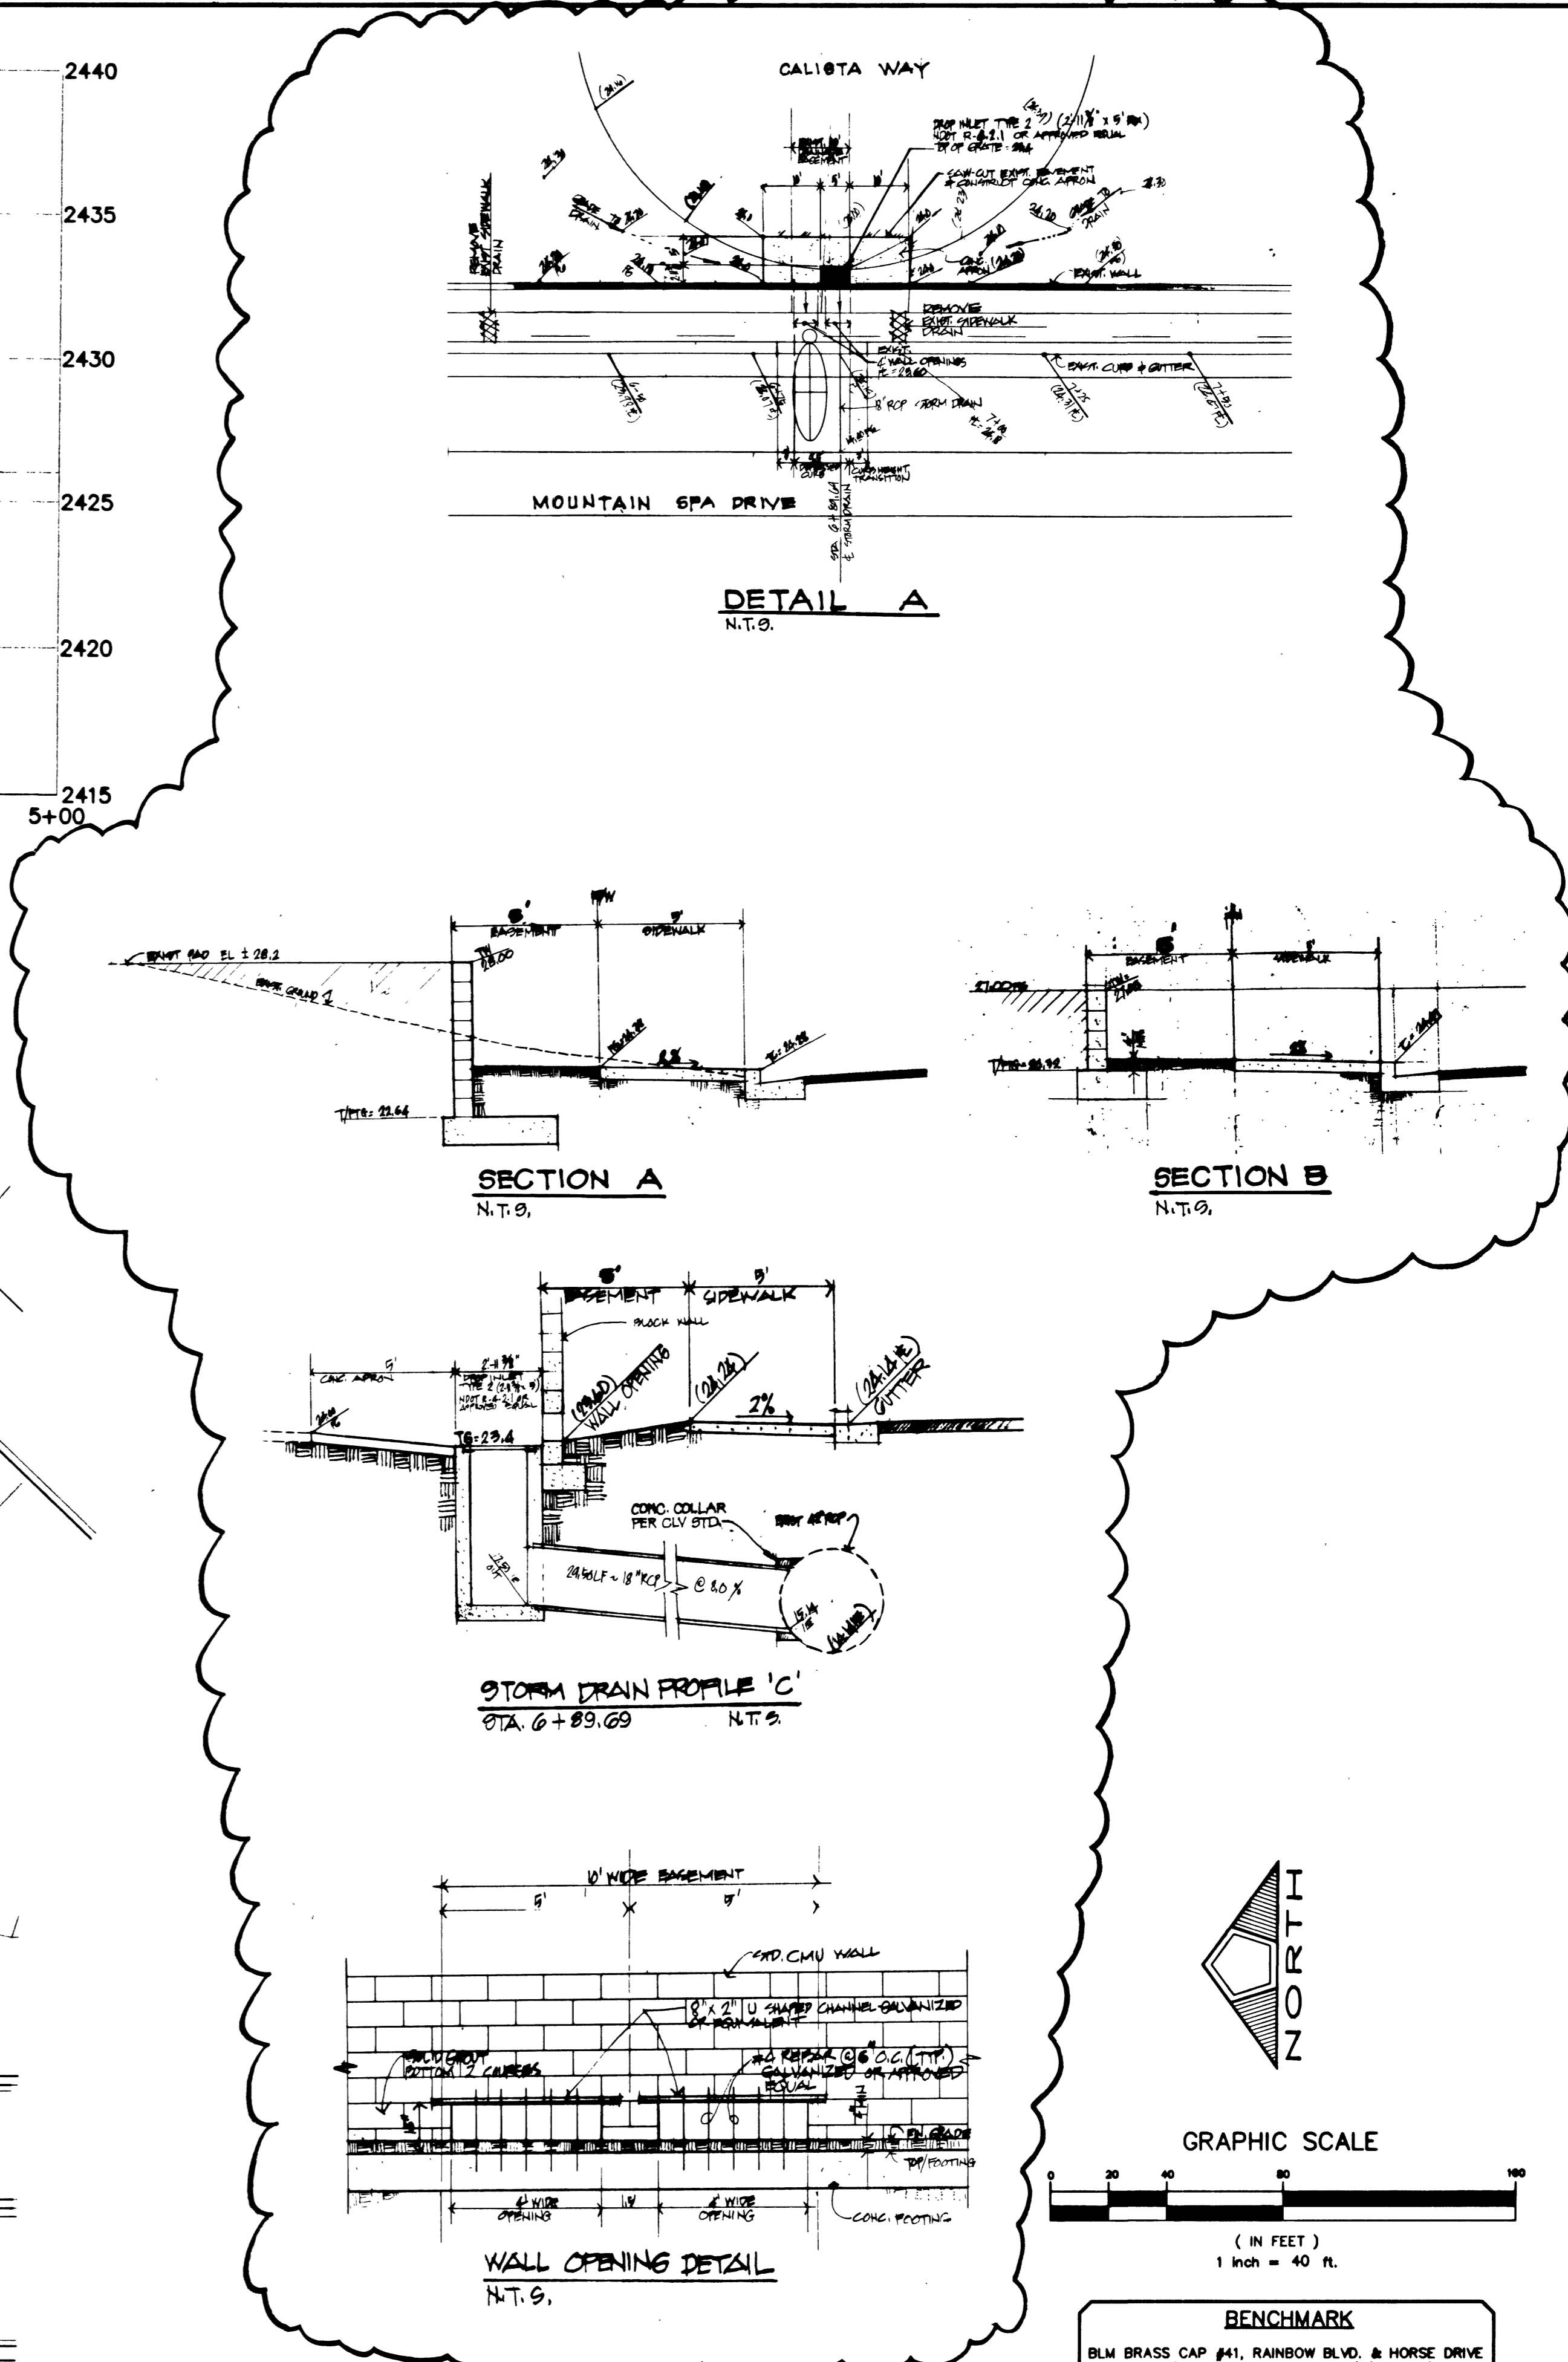

BENCHMARK
BLM BRASS CAP #41, RAINBOW BLVD. & HORSE DRIVE
BM #1LV90/11W4, ELEV. = 2396.994' (NGVD29) •
ELEV. = 731.3392 METERS/2399.402' (NAVD88)
• NGVD29 DATUM USED. ADD 2.41 FEET TO ALL ELEVATIONS TO CONVERT TO NAVD 88 DATUM.

NO.	DESCRIPTION	DATE	APP'D
1	REVISED MEDIAN CURB AT ENTRY	7/1/09	[Signature]
2	REVISED	2/1/09	[Signature]
3	ADD SECTIONS & DETAILS, REMOVE SIDEWALK DRAIN AND	7/3/01	[Signature]
4	ADDED 30' DEEPRESSED CURBS	4/16/06	[Signature]


MOUNTAIN SPA RESIDENTIAL DEVELOPMENT, LLC.
2810 WEST CHARLESTON BLVD., SUITE F-58
LAS VEGAS, NV 89102
(702) 870-1234

PENTACORE
CIVIL ENGINEERING - LAND SURVEYING - PLANNING
CONS. 5753 WEST CHARLESTON BOULEVARD
LAS VEGAS, NEVADA 89102 (702)258-0115

TEMPORARY ACCESS ROAD
DETAILS FOR THE OFF-SITE DRAINAGE INTO ON-SITE DRAINAGE SYSTEM

MOUNTAIN SPA
UNIT NO. 1

DATE:	JAN. 09
PM:	LENNARD
DRAWN BY:	[Signature]
DESIGNED BY:	[Signature]
ADA CHECKED BY:	[Signature]
JOB NO.:	0158.0200
SCALE:	1" = 40'

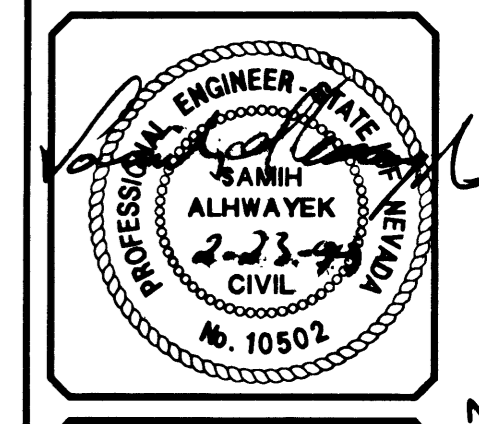

SHEET	26	OF 29
C.L.V. DWG.#		

0158 UNIT1 TEMP ACCESS DWG

14109 (S) 17339 (S) 20794 (S) 35281

AS-BUILT 1074-4344-1 98-4483