



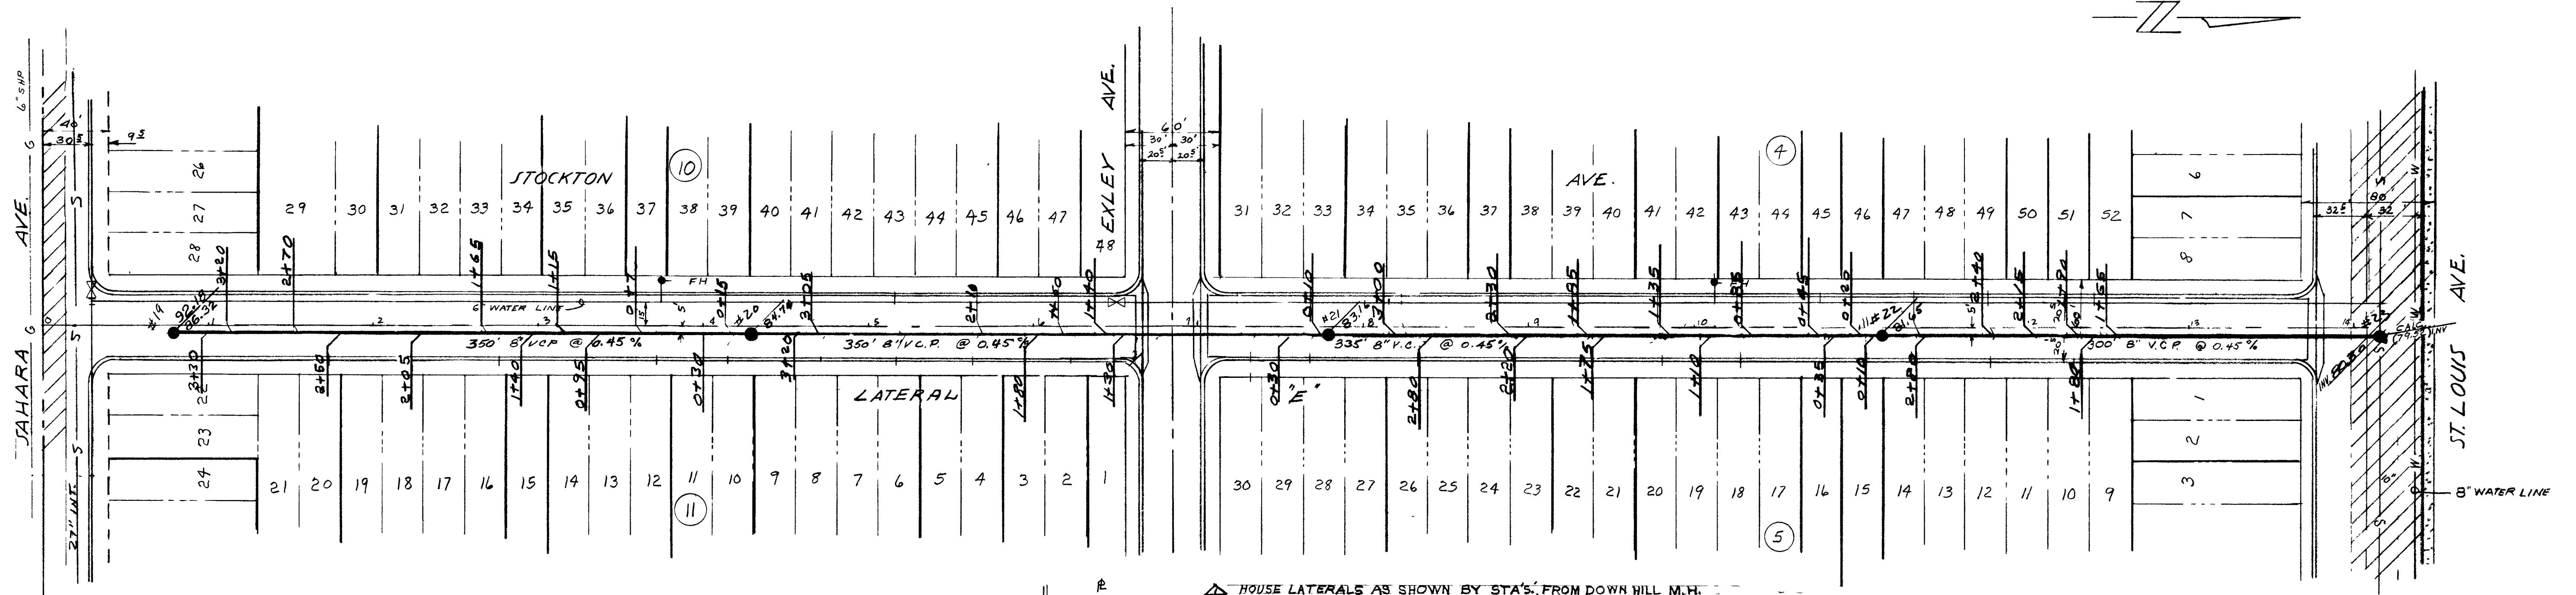

NOTE:
CONTRACTOR TO SUBMIT AS BUILT HOUSE LATERAL CONNECTIONS SHOWING DISTANCE FROM DOWNHILL MANHOLE, AS BUILT PLANS TO BE DELIVERED TO THE PERMIT SECTION OF THE P.W. DEPT.

HOUSE LATERAL DETAIL

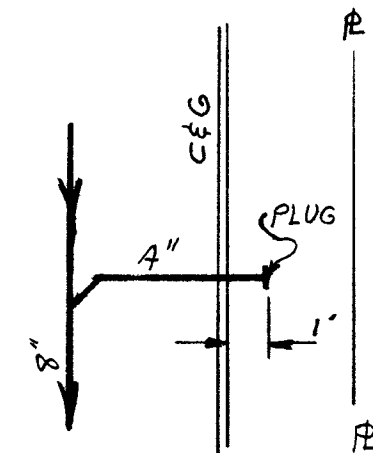


HOUSE LATERALS AS SHOWN BY STA'S, FROM DOWNHILL M.H. LATERALS SHALL TERMINATE AND BE CAPPED 1' FOOT BEHIND CURB WHERE NO RESIDENCE OR BUSINESS EXISTS. WHERE ANY EXISTS LOCATION TO BE DETERMINED IN FIELD SEE C.L.V. STD. PWG. 5-112 DETAIL TO LEFT

QUANTITIES
1 ea STD M.H.S
1 ea DRP M.H.
1335 LF 8\"/>

LEGEND

PROPOSED SEWERS
EXISTING SEWERS

APPROVED BY _____ Supt. Sanitation DATE _____

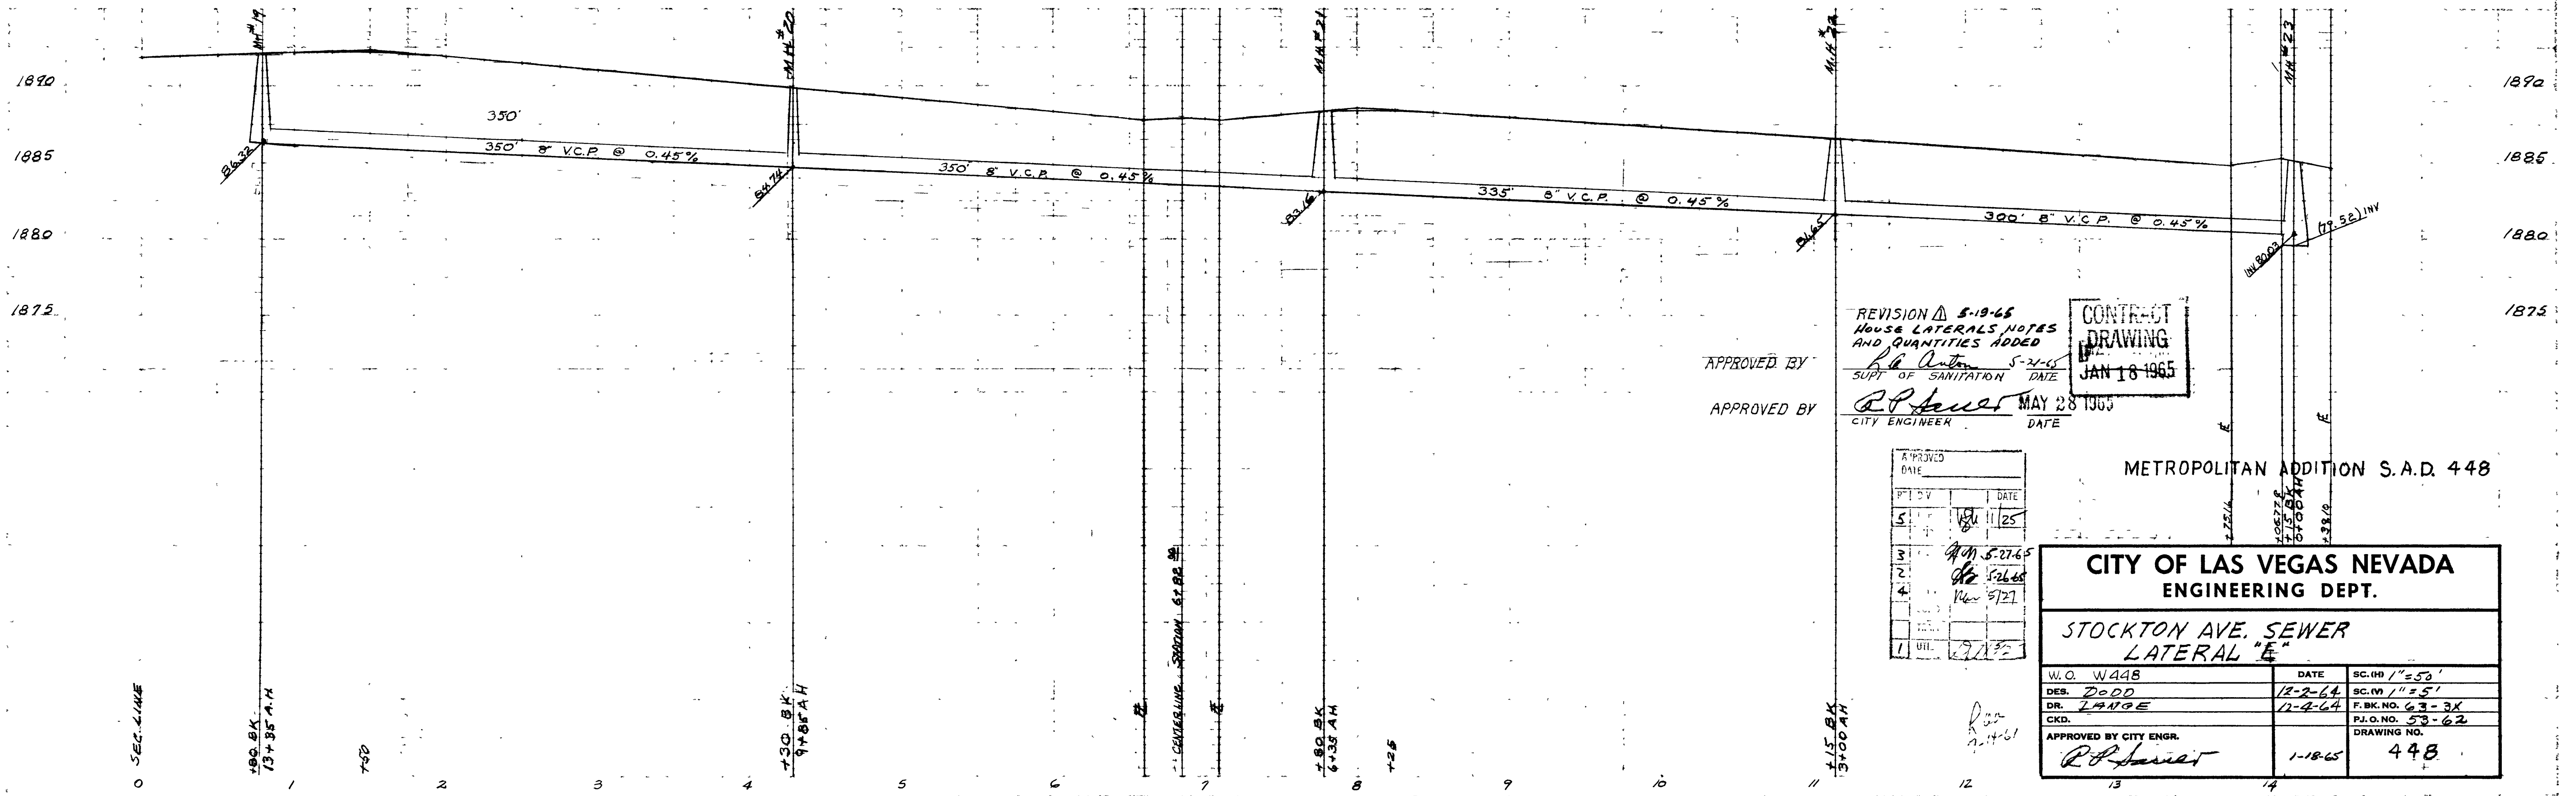

APPROVED BY _____
APPROVED BY _____

REVISION 5-19-65
HOUSE LATERALS NOTES
AND QUANTITIES ADDED
Supt. of Sanitation DATE 5-24-65
CITY ENGINEER DATE MAY 28 1965

CONTRACT
DRAWING
JAN 18 1965

METROPOLITAN ADDITION S.A.D. 448

CITY OF LAS VEGAS NEVADA
ENGINEERING DEPT.

STOCKTON AVE. SEWER
LATERAL "E"

W.O. W448	DATE	SC. (H) 1"=50'
DES. DODD	12-2-64	SC. (V) 1"=5'
DR. LANGE	12-4-64	F. BK. NO. 63-3X
CKD.		P.I.O. NO. 53-62
APPROVED BY CITY ENGR.		DRAWING NO.
1-18-65		448

BID GROUP II
ASSESSMENT UNIT NO. 3

SHT. 14 OF 21

107-V14