


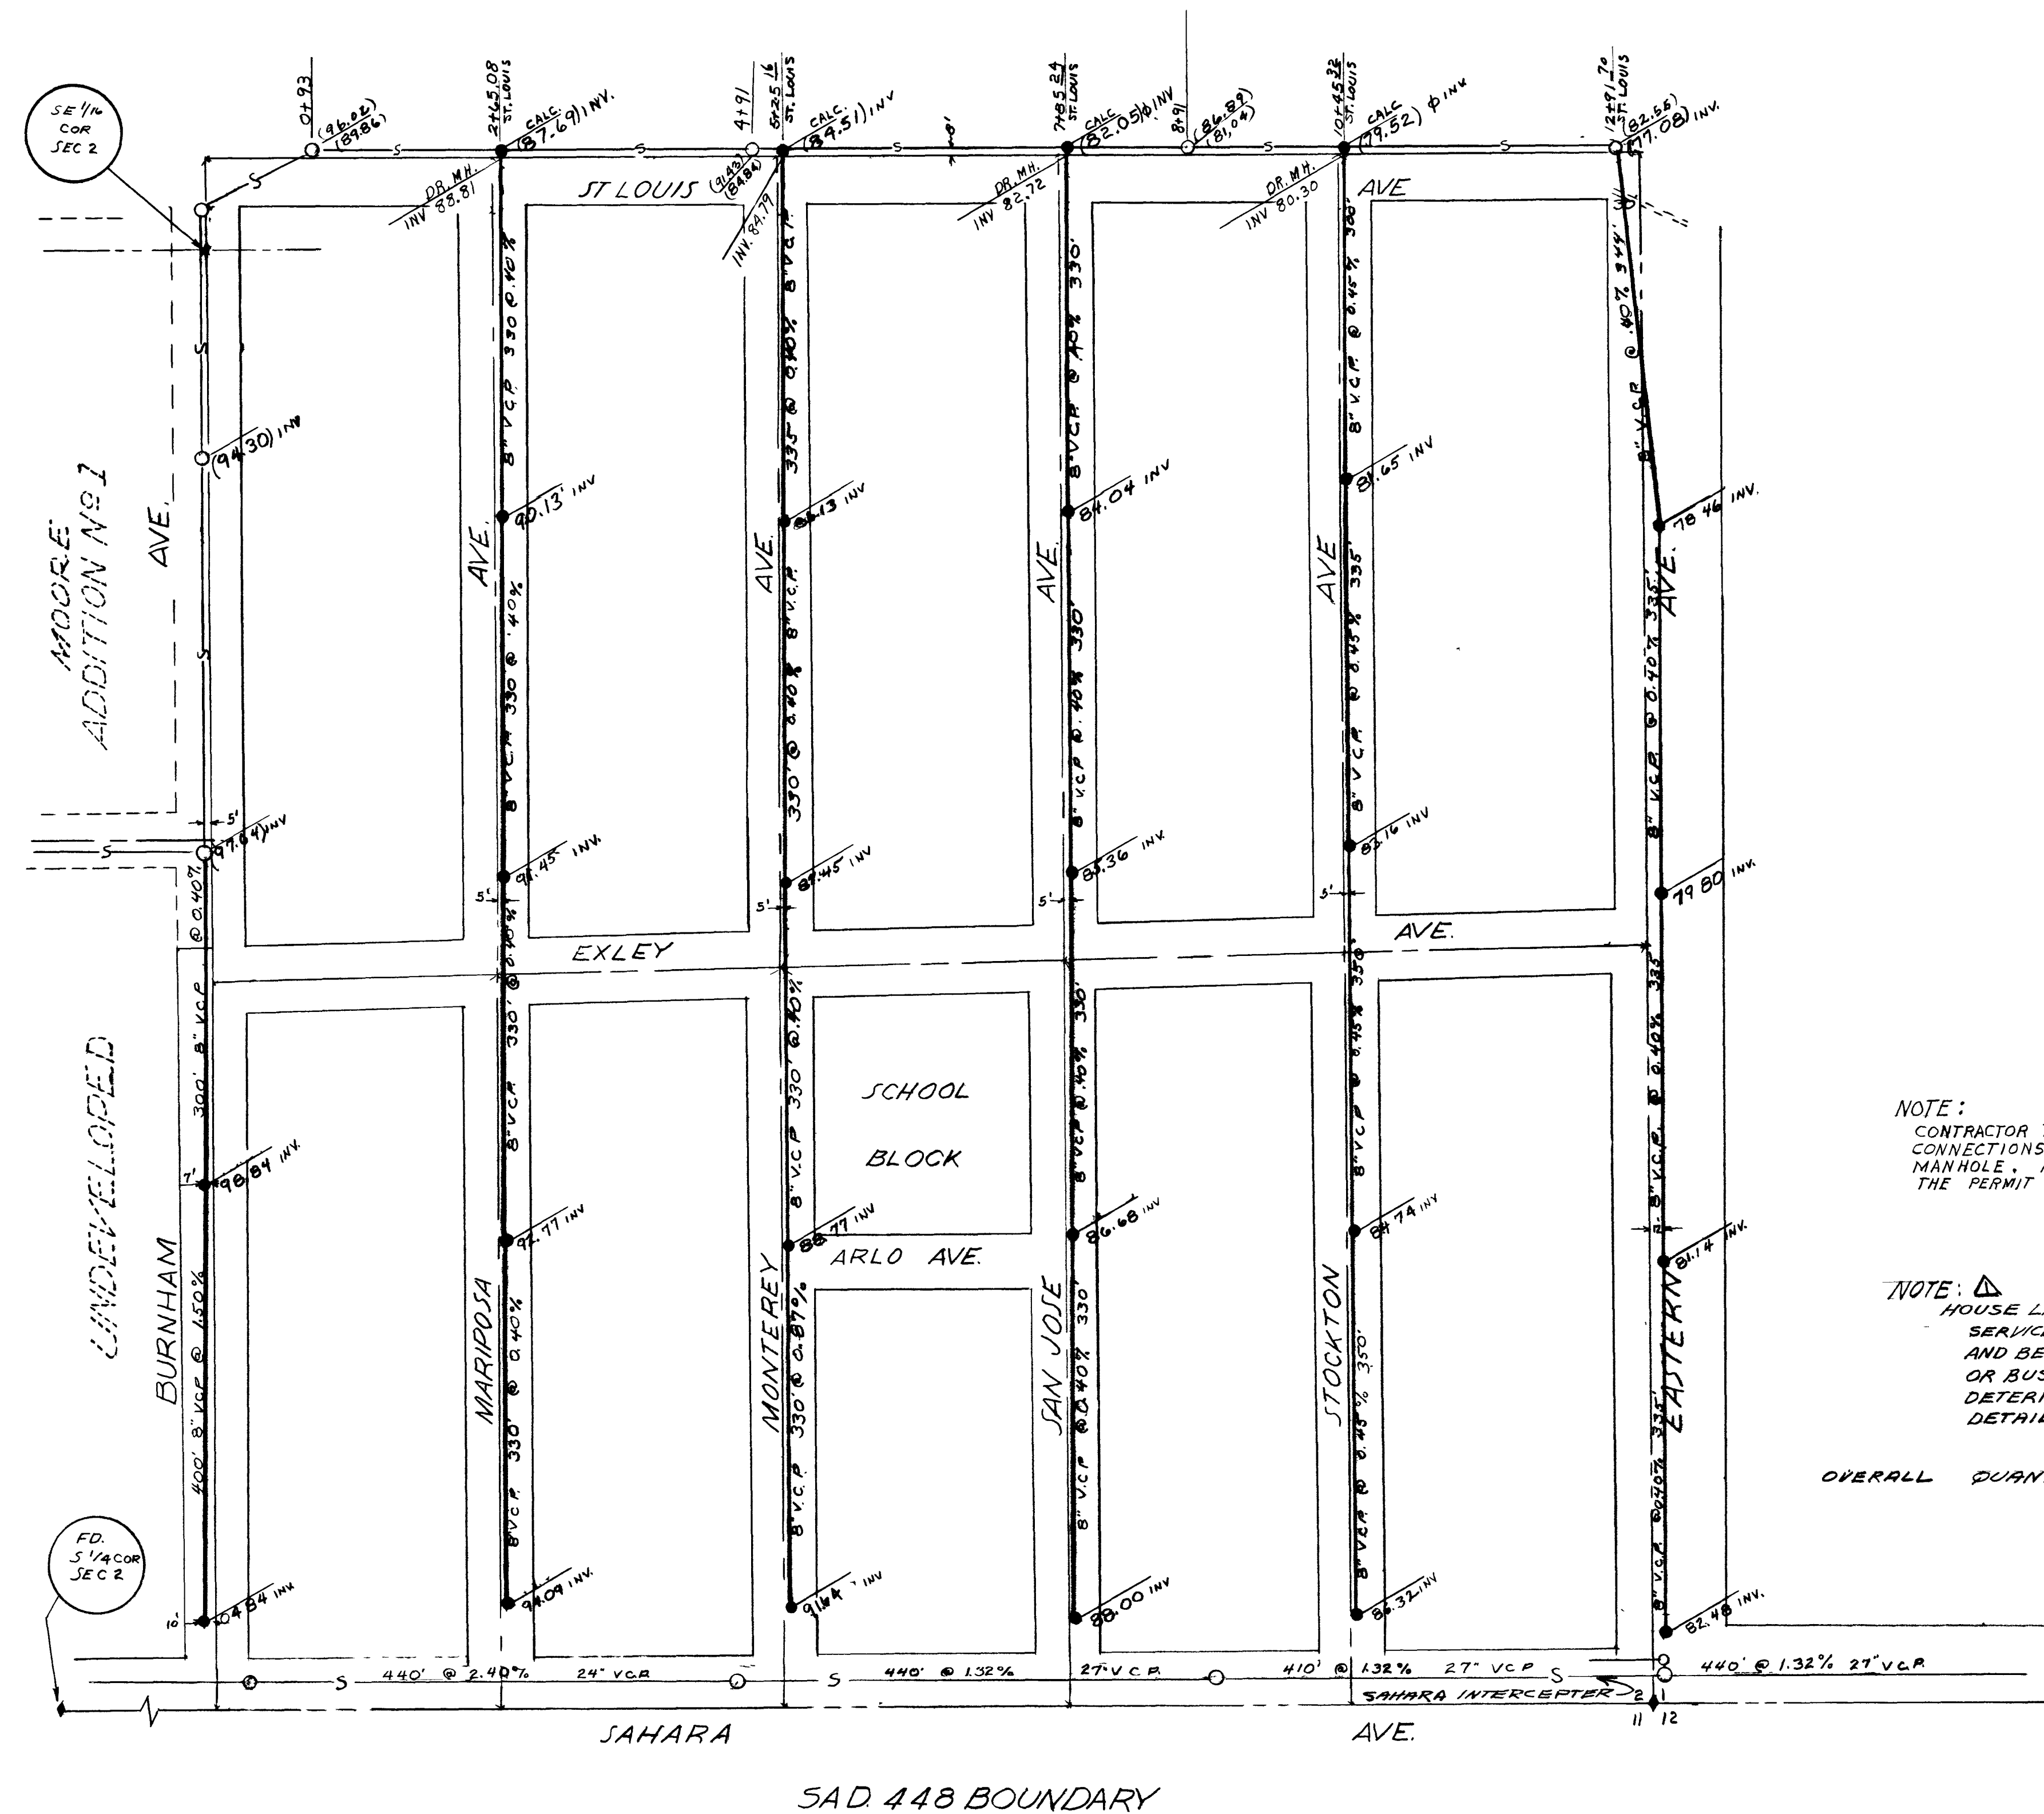


NOTE:
CONTRACTOR TO SUBMIT AS BUILT HOUSE LATERAL CONNECTIONS SHOWING DISTANCE FROM DOWNHILL MANHOLE, AS BUILT PLANS TO BE DELIVERED TO THE PERMIT SECTION OF THE P.W. DEPT.

NOTE: Δ
HOUSE LATERALS TO BE LOCATED EVERY 50' WHERE SERVICES ARE REQUIRED. LATERALS SHALL TERMINATE AND BE CAPPED 1' BEHIND CURB WHERE NO RESIDENCE OR BUSINESS EXISTS. ANY EXIST. LOCATION TO BE DETERMINED IN FIELD. SEE C.L.V. STD. DWG. S-112. DETAIL BELOW.

OVERALL QUANTITIES: Δ
2342 STD. M.H.S S-114
342 DROP M.H.S
7349 LF 8" VCP
5059 LF 4" VCP
2212 LF 22" VCP

LEGEND:

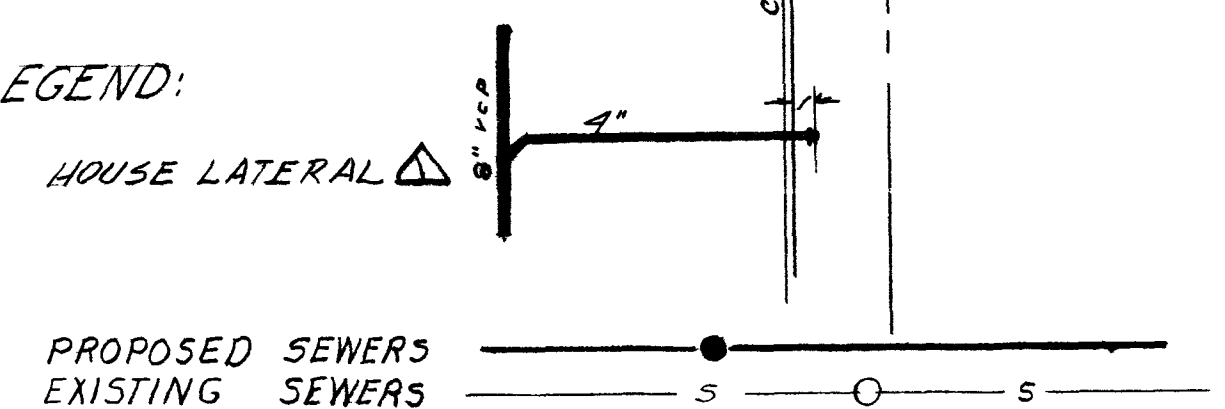

APPROVED BY: *R.A. Antea* 1-21-65
S.U.P.T. OF SANITATION DATE

NOTE:

REVISION Δ 5/19/65 HOUSE LATERALS, NOTES AND QUANTITIES ADDED.	CONF. TO DRAWING
APPROVED BY: <i>R.A. Antea</i> 5-21-65 CITY ENGINEER DATE	
APPROVED BY: <i>R.A. Antea</i> 5-21-65 S.U.P.T. OF SANITATION DATE	

BID GROUP II
ASSESSMENT UNIT NO. 3

SAD 448
CITY OF LAS VEGAS NEVADA
ENGINEERING DEPT.

METROPOLITAN ADDITION S.A.D.
OVERALL SEWER PLAN

DES.	DATE	SC. (H)
DR. DODD	11-17-64	SC. (V)
DR. LANGE	12-4-64	F.B.K. NO.
CKD.		P.L.O. NO.
APPROVED BY CITY ENGR.	1-18-65	DRAWING NO.
		448

107-V14 SHT. 10 OF 27 SHTS

