
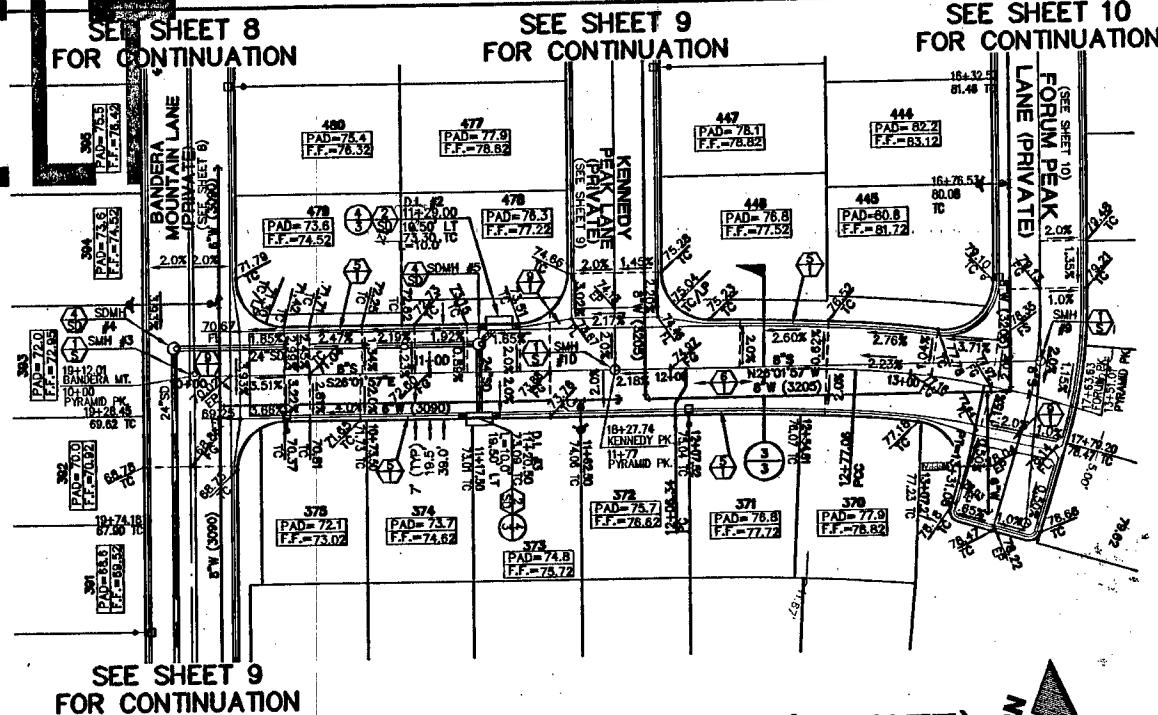
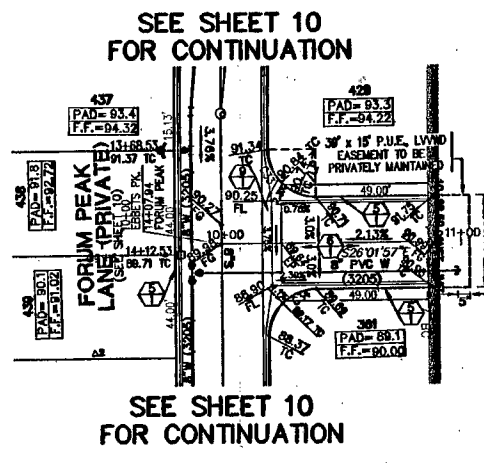


AS BUILT

FOR EX. SHAUMBER ROAD IMPROVEMENTS SEE CLIFFS EDGE / PROVIDENCE SHAUMBER ROAD CENTENAL TO GRAN TERRACE BY VTN, CLV #1074-4816-01, 1074-4816-02, 1074-4816-03, 1074-4816-04, 1074-4816-99, 1074-4816-100

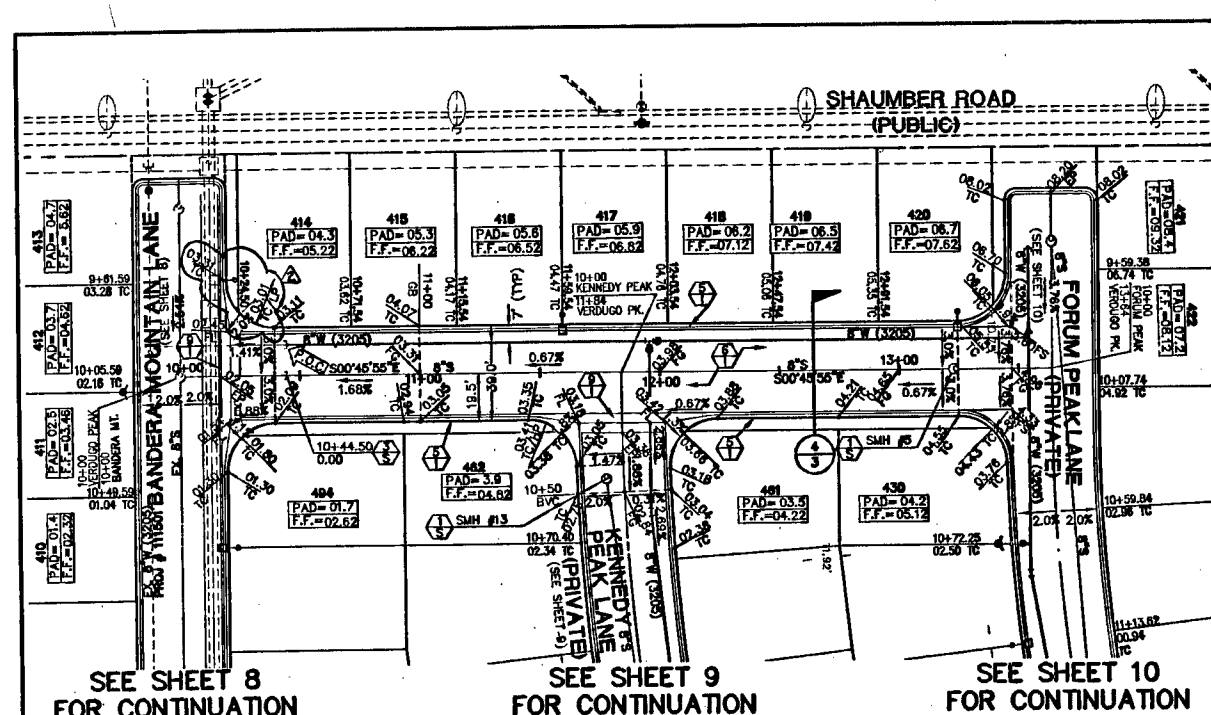

SEE SHEET 8 FOR CONTINUATION

SEE SHEET 9 FOR CONTINUATION

SEE SHEET 10 FOR CONTINUATION

SEE SHEET 10 FOR CONTINUATION

SEE SHEET 9 FOR CONTINUATION

SEE SHEET 9 FOR CONTINUATION




SEE SHEET 10 FOR CONTINUATION

FOR EXISTING IMPROVEMENTS SEE NORTHERN TERRACE UNIT 1 IMPROVEMENT PLANS by GCW WALLACE, INC JOB NO. 819.002.X08 CLV DWG NO. 10744891-1

VERDUGO PEAK STREET (PRIVATE)

EBBETS PEAK STREET (PRIVATE)

PYRAMID PEAK STREET (PRIVATE)

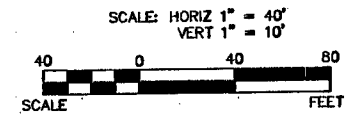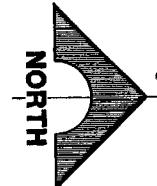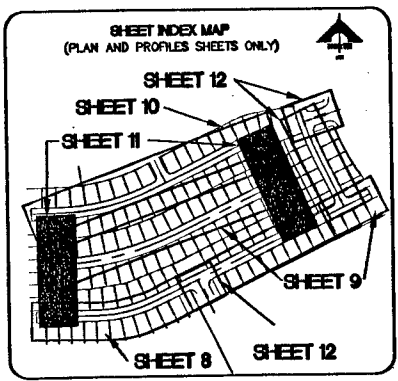

BASIS OF BEARINGS
N 88°21'10\"/>

DESC.	NAVD 88 DATUM	NAVD 83 DATUM
BV08 13E4 Rivet and Plate in Concrete Cylinder at the Northwest Corner of Hualapai Way and Farm Road.	2860.79 (FEET)	871.971 (METERS)




NOTE:
ALL PRIVATE STREETS ARE P.U.E., PUBLIC SEWER EASEMENTS, AND PUBLIC DRAINAGE EASEMENTS TO BE PRIVATELY MAINTAINED BY THE HOMEOWNERS ASSOCIATION.

Call before you Dig.
1-702-455-7511
1-702-229-6611

Call before you Dig.
1-800-227-2600

Call before you Dig.
1-702-227-2929

APPROVED FOR CONSTRUCTION
6-15-06
LAS VEGAS VALLEY WATER DISTRICT
PROJ # 111607

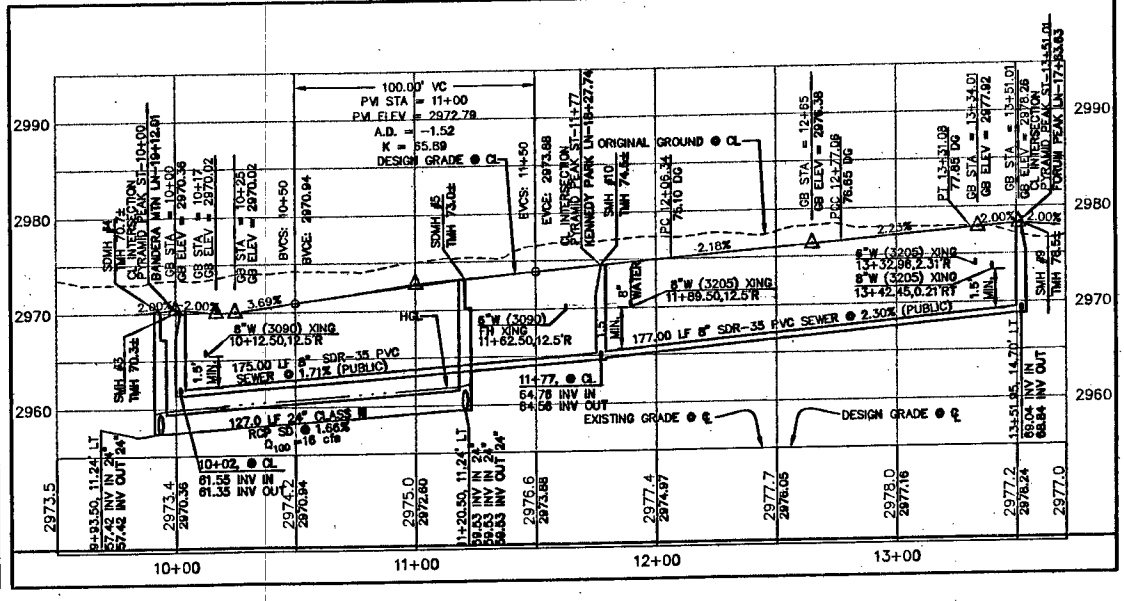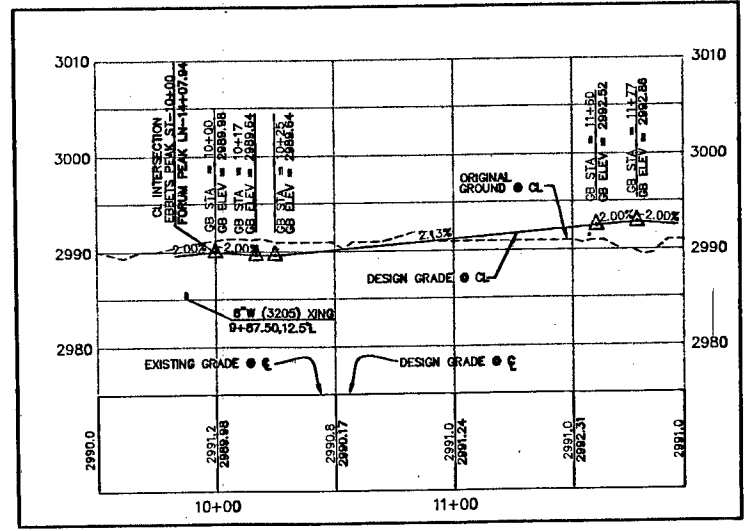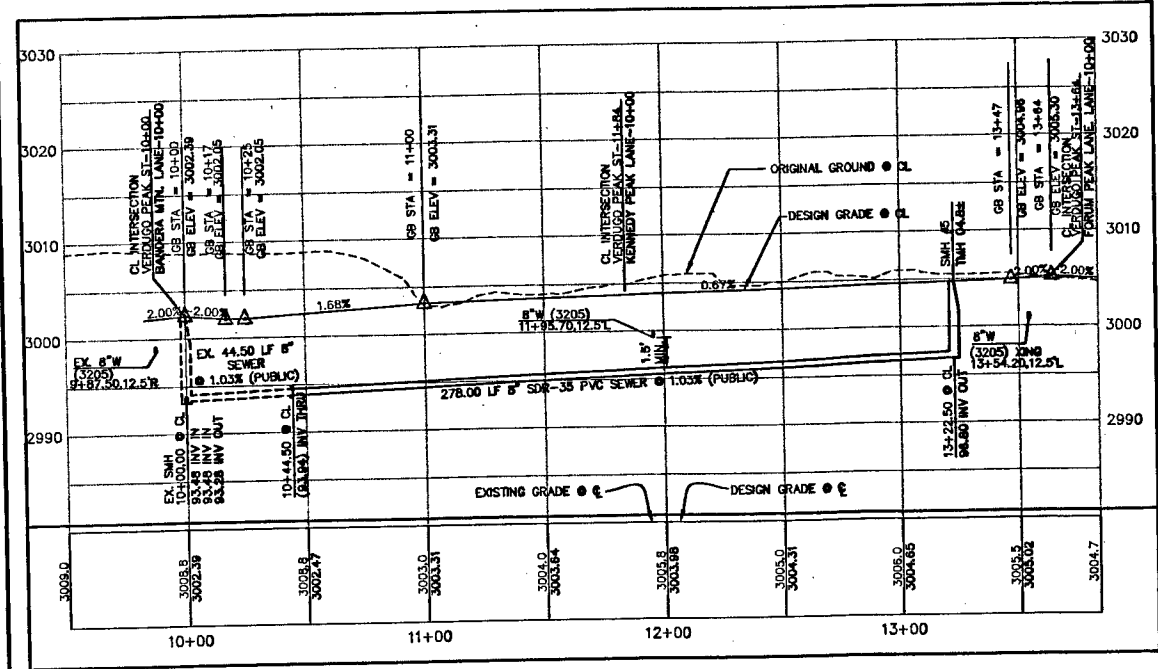

AS BUILT

DATE: 11/21/06
PLOT DATE: 08/29/06
PLOT TIME: 08:09:50

DESIGN: G.C. WALLACE, INC.
CHECK: J. WALLACE
ISSUE DATE: 6-15-06
PLOT DATE: 08-29-06
PLOT TIME: 08:09:50

G.C. WALLACE, INC.
Engineers/Planners/Surveyors
1555 SOUTH RAINBOW BLVD., LAS VEGAS, NEVADA 89146
TELEPHONE: (702) 804-2000 • FAX: (702) 804-2286
11 Northern Terrace, Santa Vepa, NV 89145

MERTAGE CORPORATION
NORTHERN TERRACE - UNIT 4
VERDUGO PEAK STREET, EBBETS PEAK STREET
AND PYRAMID PEAK STREET PLAN AND PROFILE
DRAWING
C-11
JOB NO. 819.002.X1
11 OF 15 SHEETS

CLV DRAWING NO. 10744891-4