



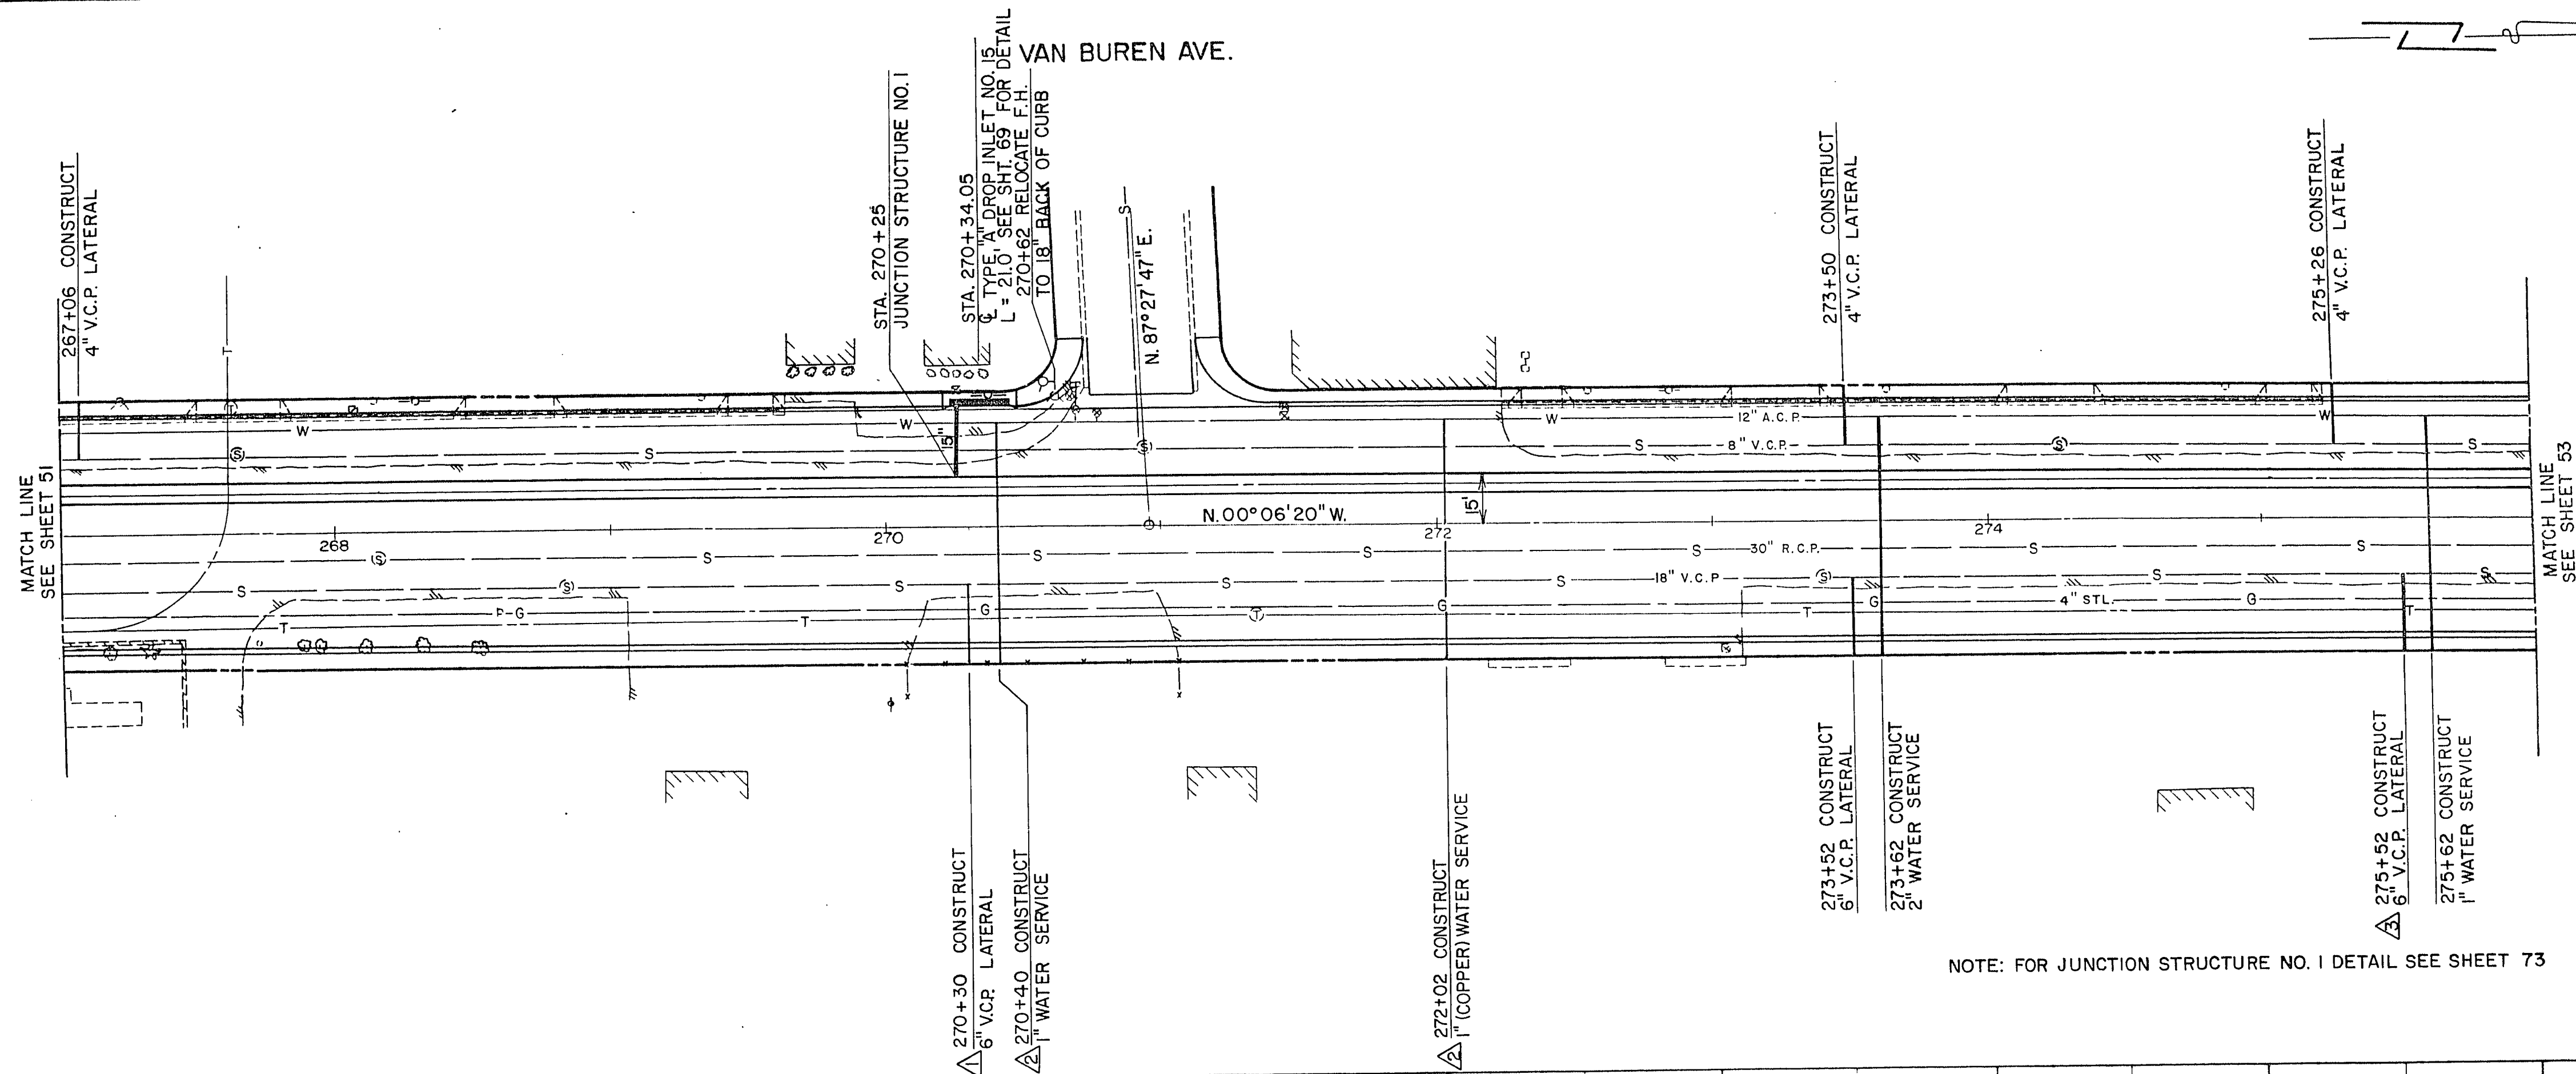

AS-BUILT
4-18-86
(P. 1 of 1)

NOTE: FOR JUNCTION STRUCTURE NO. 1 DETAIL SEE SHEET 73

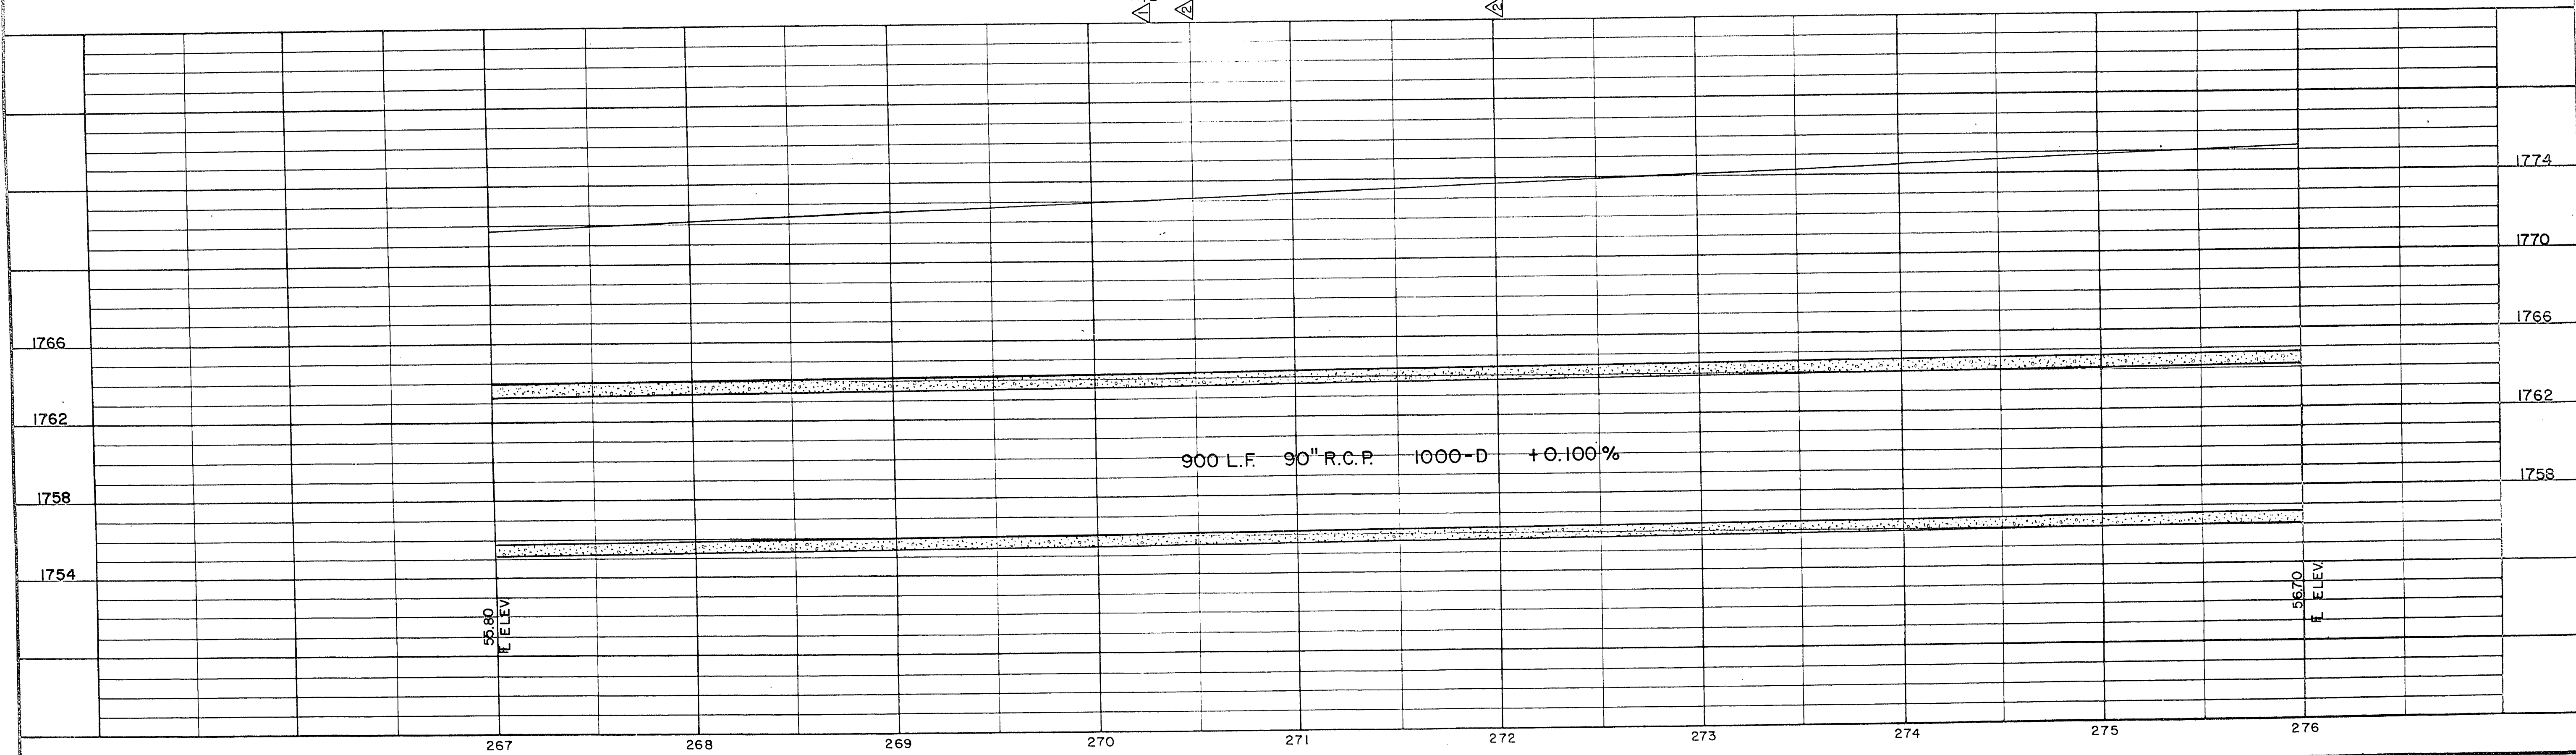

DESIGNED BY: <i>Paul B. Anderson</i> DRAWN BY: <i>ges</i> CHECKED BY: <i>Redding</i>		CLARK COUNTY NEVADA DEPARTMENT OF PUBLIC WORKS		NELLIS BOULEVARD STORM DRAIN PLAN STA. 267+00 TO STA. 276+00		SCALE: HORZ.: 1" = 40' VERT.: 1" = 4' PROJECT NO.: B810563 8810233		DRAWING NO. L-1017 SHT. 52 of 92	
REV. NO.	DATE	DESCRIPTION	APPROVED						
1	3/28/86	CHANGED DIAMETER OF SEWER LATERAL							
2	3/28/86	ADDED WATER SERVICE'S							
3	3/28/86	ADDED SEWER LATERAL							

10-1-VF189
91-3-44