


AS-BUILT

C CURVE DATA			
NO.	Δ	RADIUS	LENGTH
①	27° 39' 46"	2,818.52'	1,360.80'
②	18° 28' 11"	1,500.00'	483.54'
③	18° 00' 43"	3,411.12'	1,072.35'

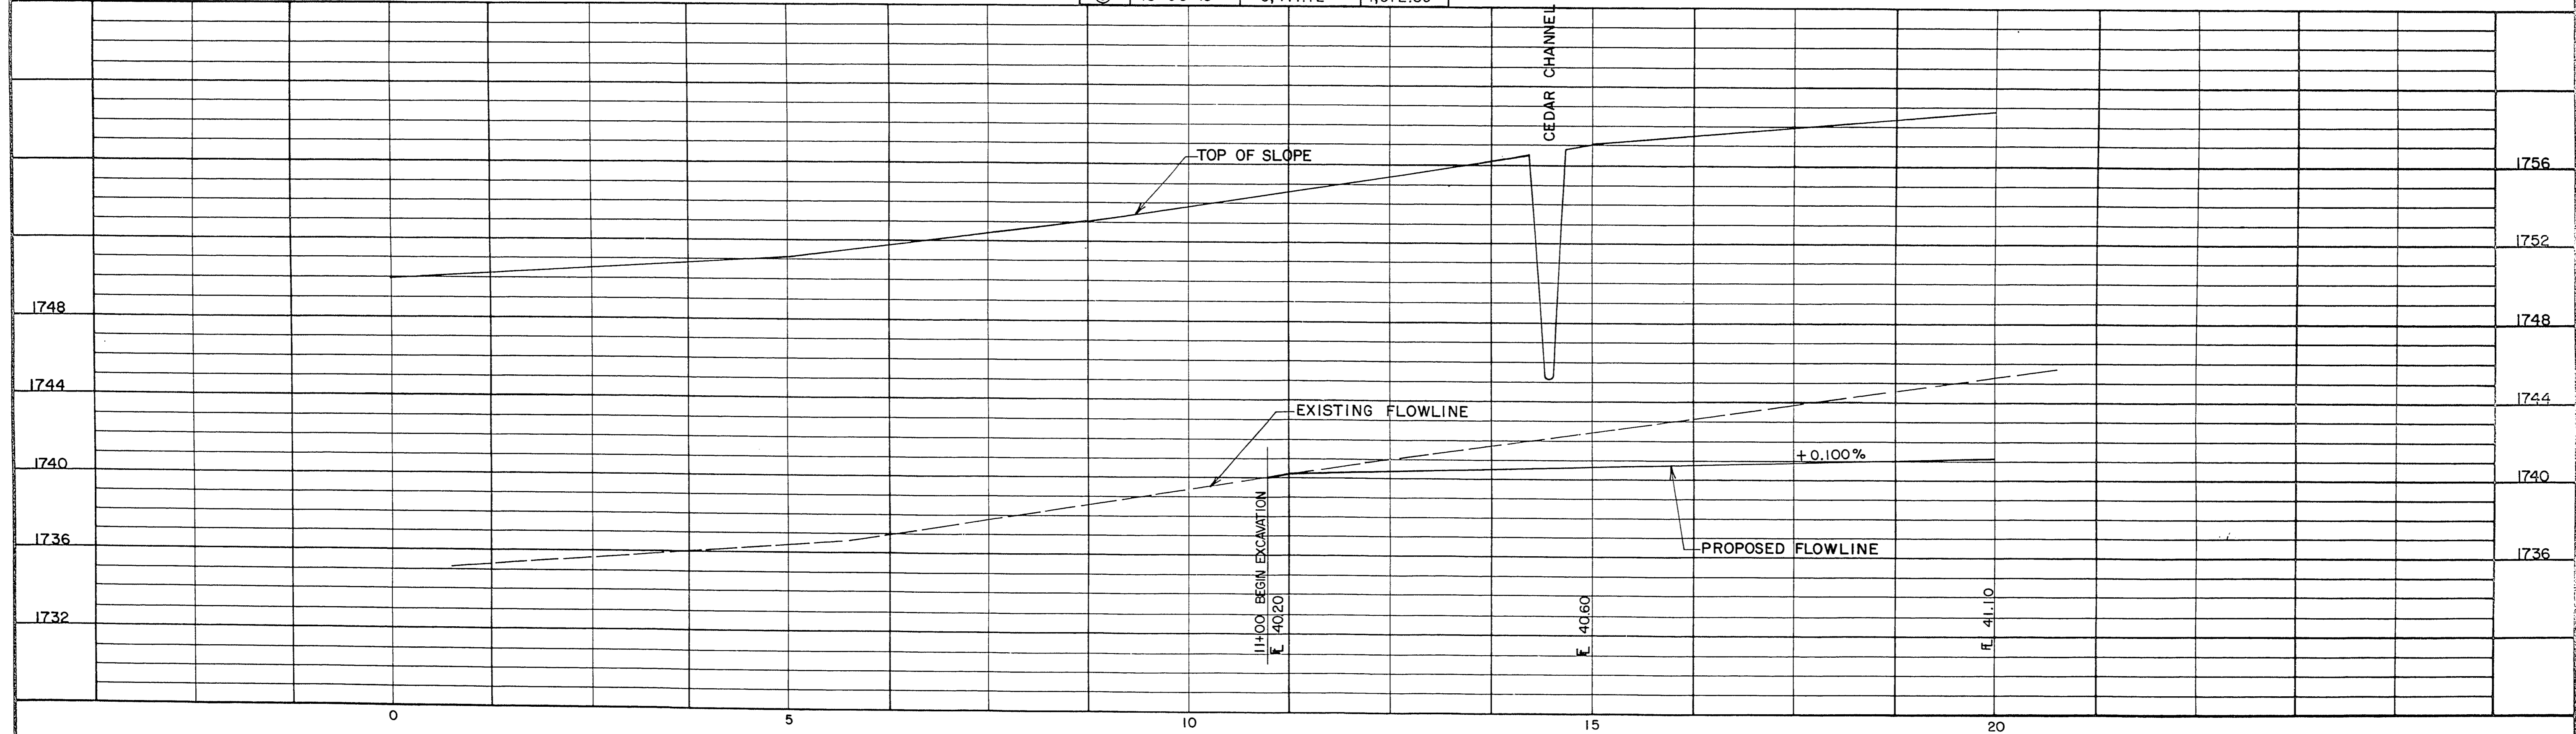

DESIGNED BY: *Ant B Anderson*
 DRAWN BY: *gpc*
 CHECKED BY: *M. [Signature]*

CLARK COUNTY NEVADA
 DEPARTMENT OF PUBLIC WORKS

NELLIS BOULEVARD
 LAS VEGAS WASH
 PLAN & PROFILE

SCALE: HORZ.: 1"=100'
 VERT.: 1"=4'
 PROJECT NO.: B.810563
 DRAWING NO. L-1017
 SHT. 65 OF 92

107-11789
 21-3-11