



PLAN
SCALE: 1" = 10'

CURVE DATA			
Δ	RADIUS	TANGENT	LENGTH
2°14'02"	3,411.12'	66.51'	133.00'

PORTION OF LAS VEGAS WASH CURVE ③
SEE SHEET NO. 66

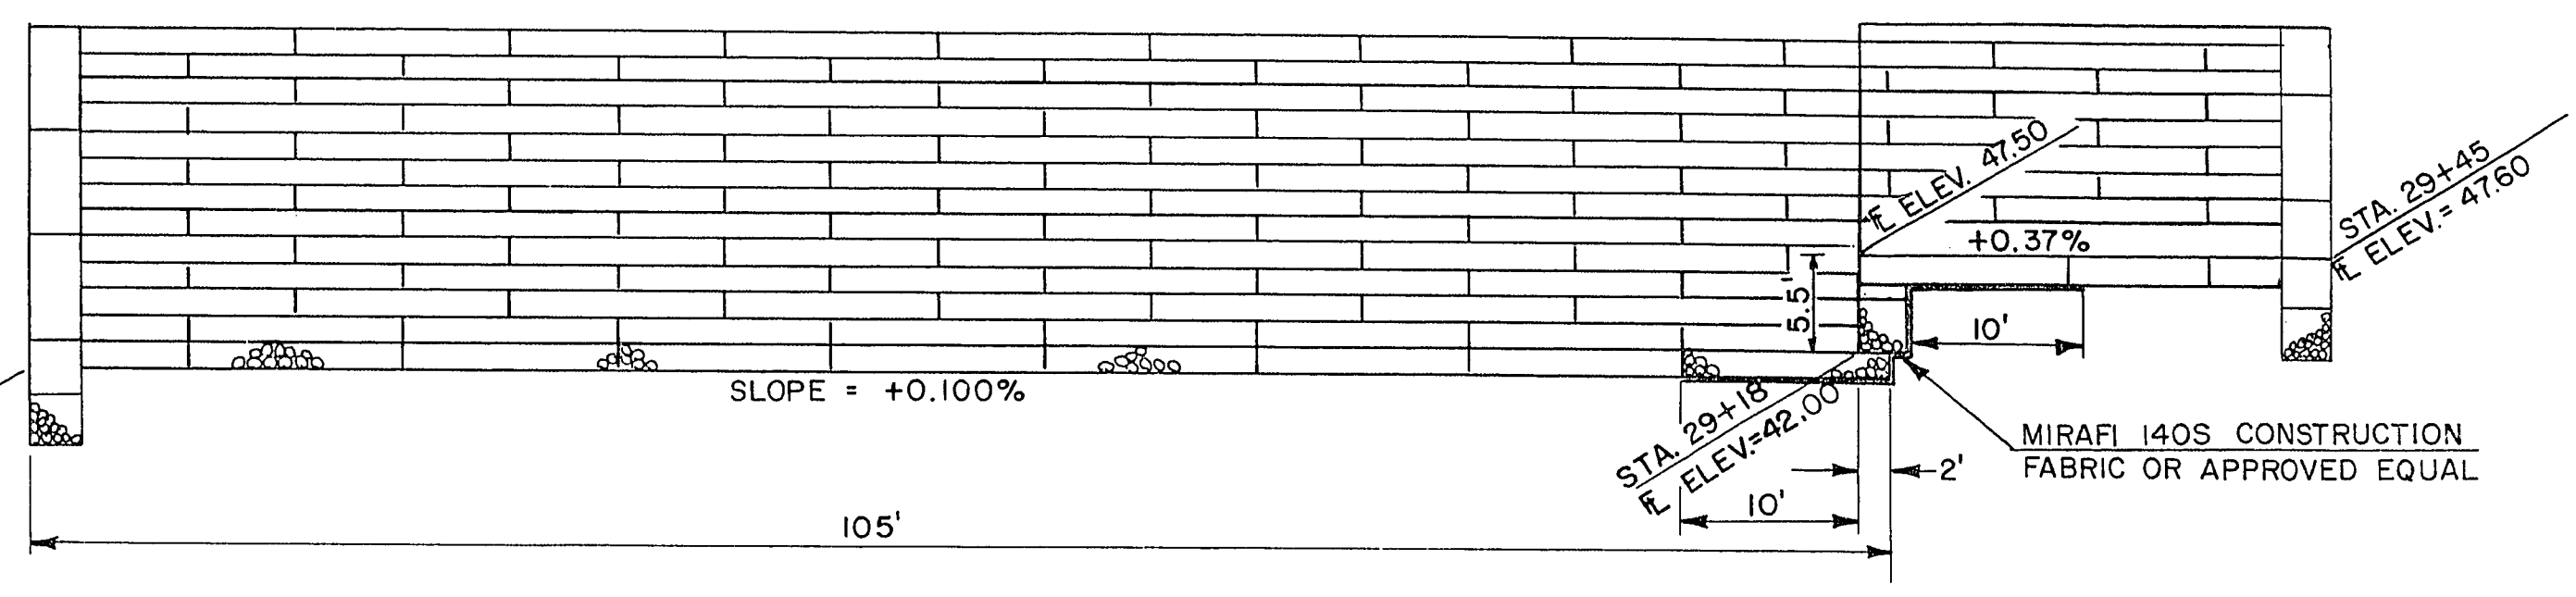

SECTION AA
SCALE: 1" = 10'

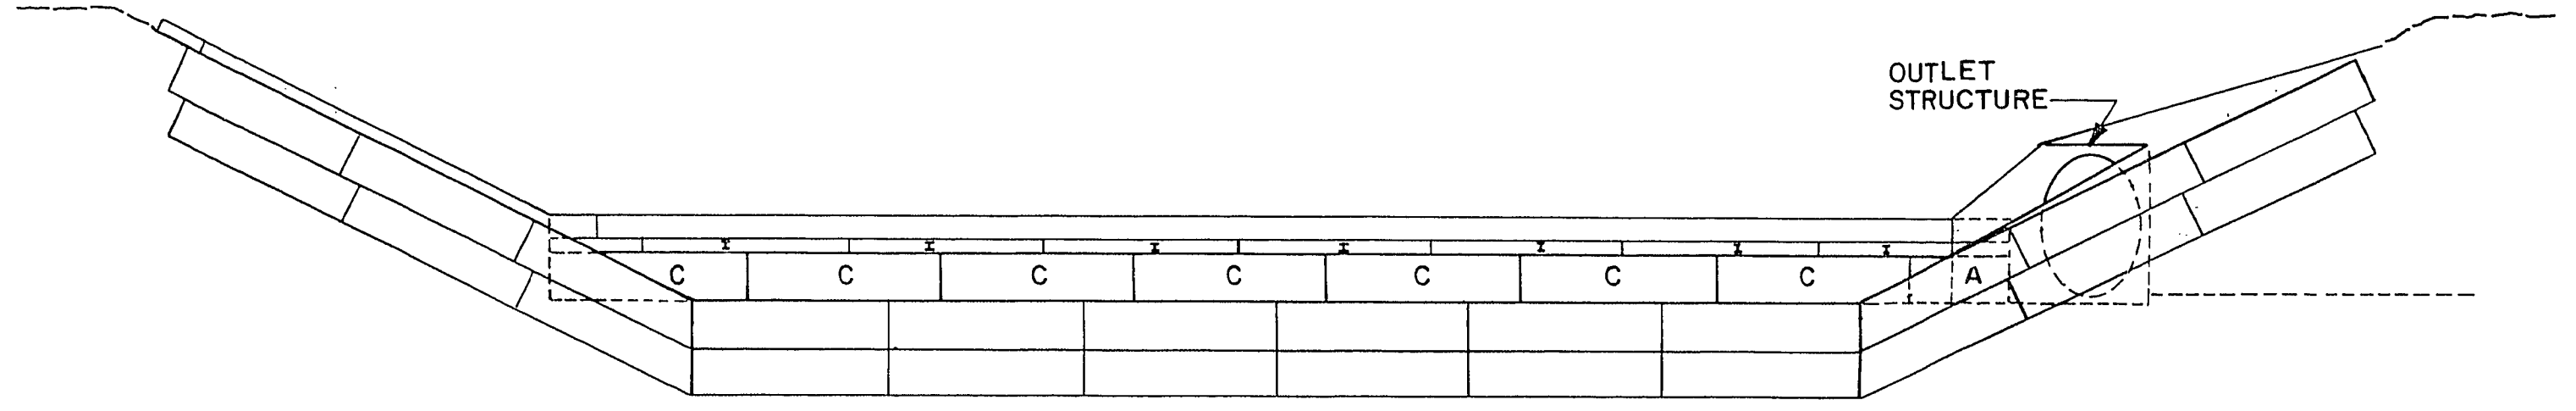

SECTION BB
SCALE: 1" = 10'

GABION BASKET SIZE				
LETTER	LENGTH	WIDTH	DEPTH	QUANTITY
A	6'	3'	3'	7
C	12'	3'	3'	53
D	6'	3'	1.5'	53
F	12'	3'	1.5'	242
G	6'	3'	1'	33
I	12'	3'	1'	221

AS BUILT
4-18-86

OUTLET SLOPE PROTECTION

REV. NO.	DATE	DESCRIPTION	APPROVED

DESIGNED BY: *And. B. Anderson*
 DRAWN BY: *Gas*
 CHECKED BY: *M. [Signature]*

CLARK COUNTY NEVADA
DEPARTMENT OF PUBLIC WORKS

NELLIS BOULEVARD
STORM DRAIN DETAILS

SCALE	HORIZ.: AS NOTED	DRAWING NO.
	VERT.: AS NOTED	L-1017
FIELD BOOK	PROJECT NO.: B810563	SHT. 67 OF 92

107-V1789

21-3-48