

EXISTING CURB & GUTTER TO REMAIN IN PLACE

STA. 217 + 15.00 TO STA. 222 + 10.79 (45' B.C.)
STA. 302 + 54.70 TO STA. 303 + 78.90 (44' B.C.)

SOUTHBOUND LANES

STA. 217 + 15.00 TO STA. 224 + 46.20 ① = 13 1/2" ② = 20 1/2"
STA. 277 + 78.41 TO STA. 306 + 81.34 ① = 12 1/2" ② = 19"
STA. 306 + 81.34 TO STA. 386 + 05.00 ① = 11" ② = 17 1/2"


NORTHBOUND LANES

STA. 216 + 43.50 TO STA. 224 + 46.20 ① = 13 1/2" ② = 20 1/2"
STA. 224 + 80.07 TO STA. 305 + 56.04 ① = 12 1/2" ② = 19"
STA. 305 + 56.04 TO STA. 385 + 57.44 ① = 11" ② = 17 1/2"

EXISTING CURB & GUTTER TO REMAIN IN PLACE

STA. 222 + 56.50 TO STA. 227 + 44.00 (44' B.C.)
STA. 302 + 55.76 TO STA. 308 + 18.00 (44' B.C.)
STA. 351 + 72.30 TO STA. 353 + 41.60 (45' B.C.)

TYPICAL SECTION (ALTERNATE 1)

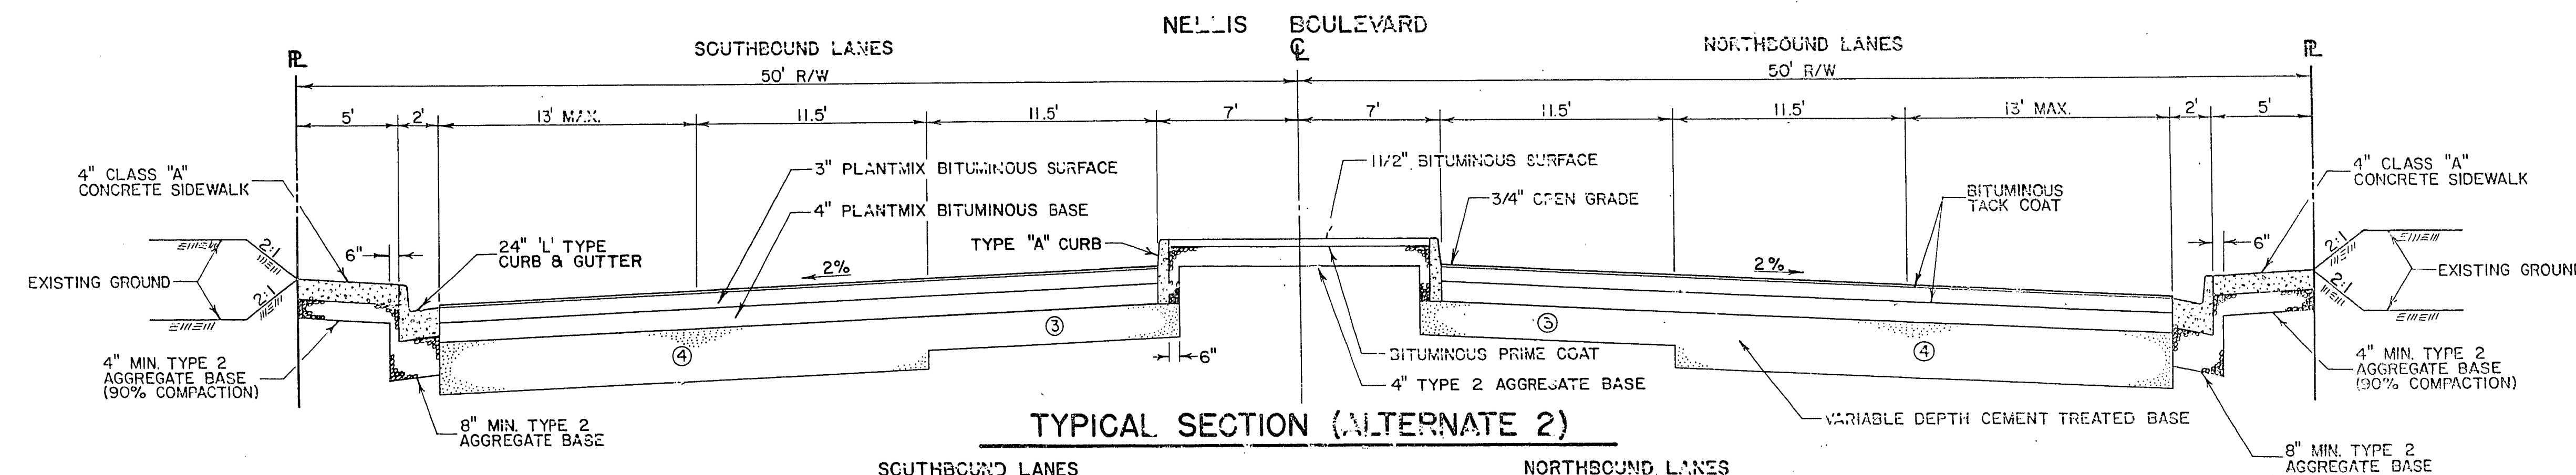

NOTE: WEST SIDE OF NELLIS BLVD. FROM BONANZA RD. TO OWENS AVE. USE 5" MIN. DEPTH TYPE 2 AGGREGATE UNDER CONCRETE SIDEWALK. (APPLIES TO BOTH ALTERNATES)


SOUTHBOUND LANES

STA. 217 + 15.00 TO STA. 224 + 46.20 ③ = 9" ④ = 13 1/2"
STA. 277 + 78.41 TO STA. 306 + 81.34 ③ = 8" ④ = 12 1/2"
STA. 306 + 81.34 TO STA. 386 + 05.00 ③ = 7" ④ = 11 1/2"

NORTHBOUND LANES


STA. 213 + 67.50 TO STA. 224 + 80.07 ③ = 5" ④ = 13 1/2"
STA. 224 + 80.07 TO STA. 305 + 56.04 ③ = 8" ④ = 12 1/2"
STA. 305 + 56.04 TO STA. 385 + 57.44 ③ = 7" ④ = 11 1/2"

TYPICAL SECTION (ALTERNATE 2)

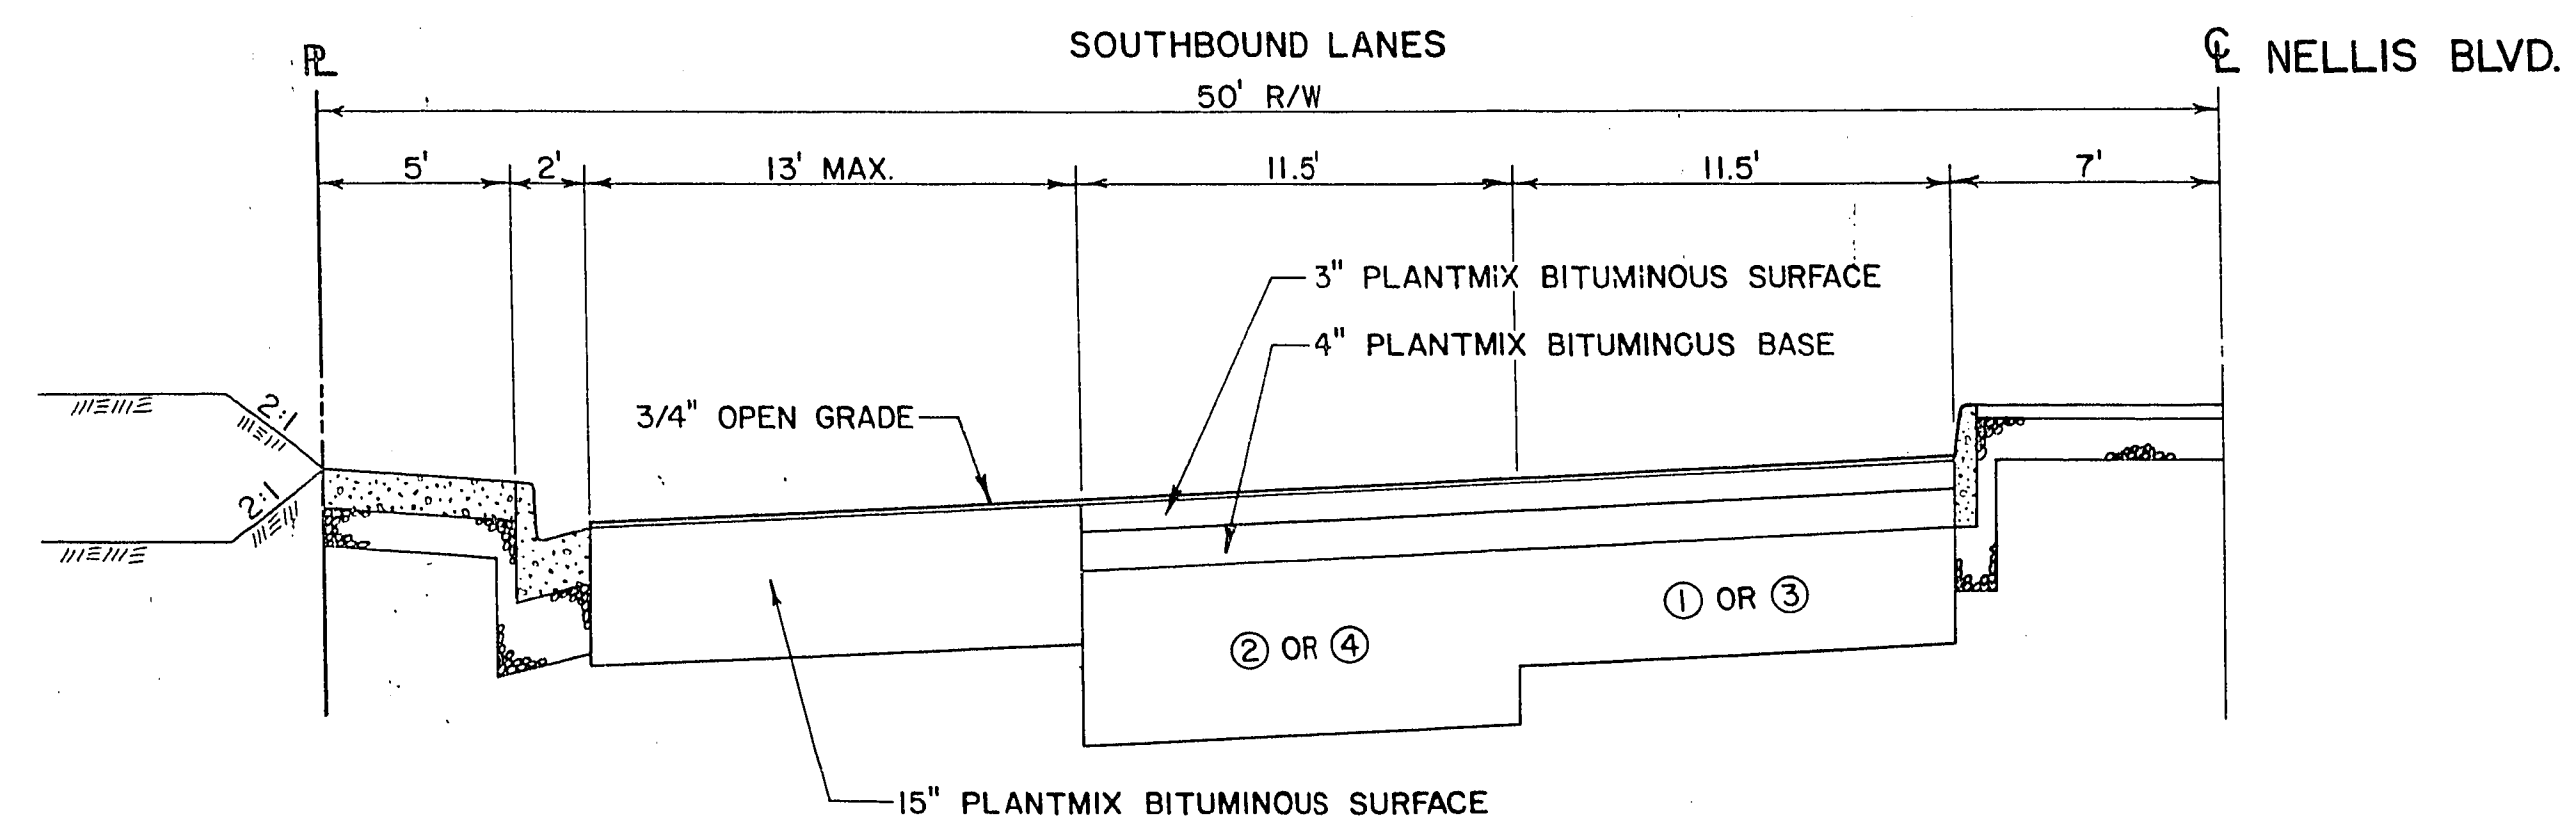


SOUTHBOUND LANES

ALTERNATE 1 STA. 224 + 46.20 TO STA. 226 + 04.78 ① = 13 1/2" ② = 20 1/2"
STA. 226 + 04.78 TO STA. 277 + 78.41 ① = 12 1/2" ② = 19"
ALTERNATE 2 STA. 224 + 46.20 TO STA. 226 + 04.78 ③ = 9" ④ = 13 1/2"
STA. 226 + 04.78 TO STA. 277 + 78.41 ③ = 8" ④ = 12 1/2"

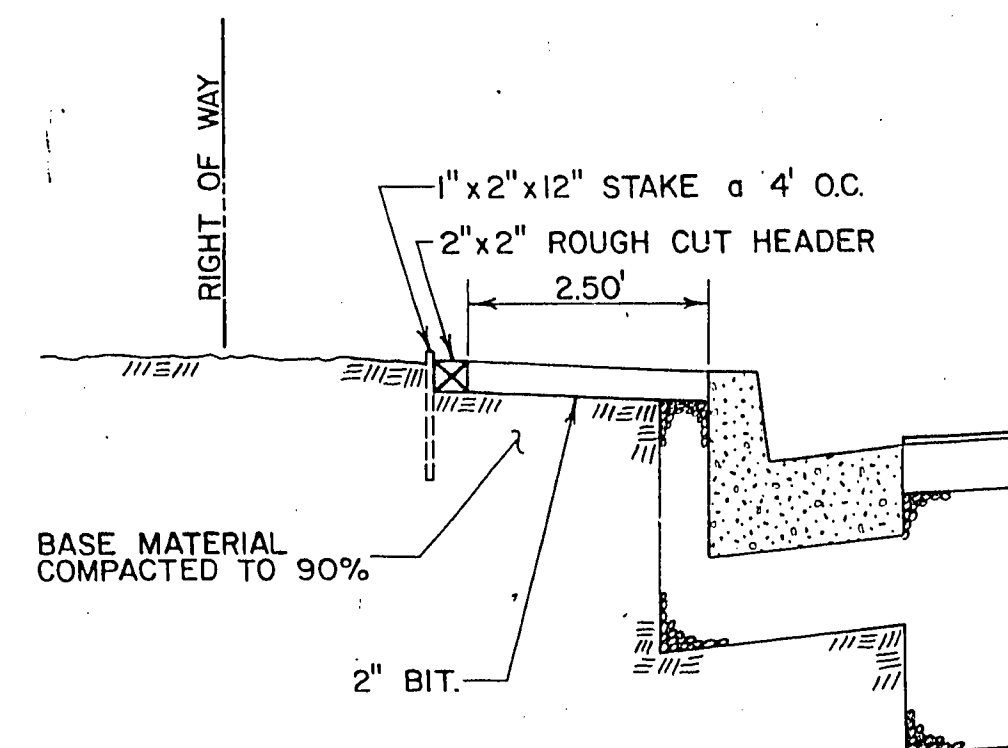

DETAIL OF BITUMINOUS SIDEWALK

FOR BITUMINOUS SIDEWALK LOCATIONS, SEE NELLIS BOULEVARD PLAN SHEETS.

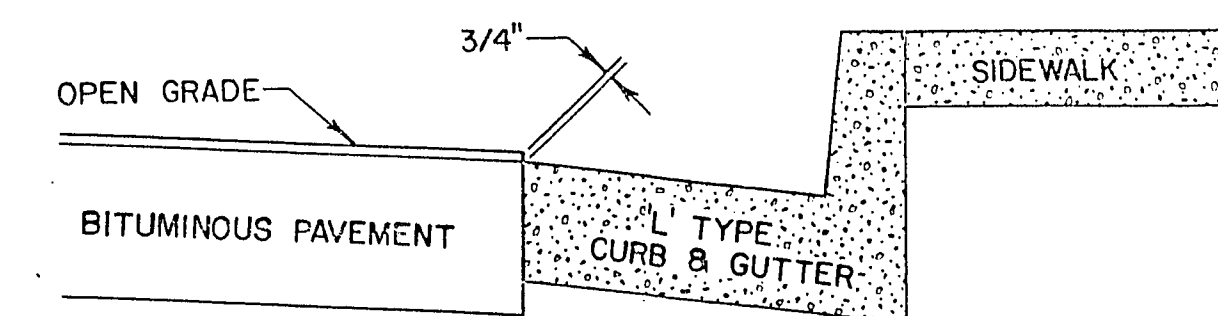

DETAIL AT LIP OF GUTTER

NELLIS BOULEVARD
BONANZA ROAD
LAKE MEAD BOULEVARD

AS-BUILT

4-18-86
(Date)

REV. NO.	DATE	DESCRIPTION	APPROVED

DESIGNED BY: _____
DRAWN BY: *Sal*
CHECKED BY: _____

CLARK COUNTY NEVADA
DEPARTMENT OF PUBLIC WORKS

NELLIS BOULEVARD
TYPICAL SECTIONS
NELLIS BOULEVARD

SCALE	HORIZ.: NONE VERT.: NONE	DRAWING NO.
PROJECT NO.	B810233	L-1017
FIELD BOOK		SHT. 4 OF 92

107-V1789

21-3-11