




LIGHT FIXTURE	HEAD TYPE	SOCKET	PATTERN
4, 12, 15, 16, 17, 99, 100	A-14	N.P. 41-VOLT D.P. INT. VOLT. MEO. BULB	A-30221C'S L.E.S. TYPE II 4 WAY A-30221C'S

**NOTES:**

1. PULL BOXES TO BE 2" x 4" (OR APPROVED EQUAL) T. & B. CAST IRON WATER PROOF FINISHED TYPE FOR 1/2" CONDUIT - SIZE C-4-71.  
 2. MAINLINE TO BE LINE MATERIAL CO. (OR APPROVED EQUAL) 1/2" POLYCARBONATE 10.0 V. BAND 4-10000 VOLT TYPE A METAL HEAD COMPLETE WITH 2500 LUMEN G.S. 6X8 LAMP & GLASS.

**~ LEGEND ~**

⊗ STEEL POLE  
 ⊠ METAL PULL BOX  
 — 5 KV WIRE IN 1/2" CONDUIT

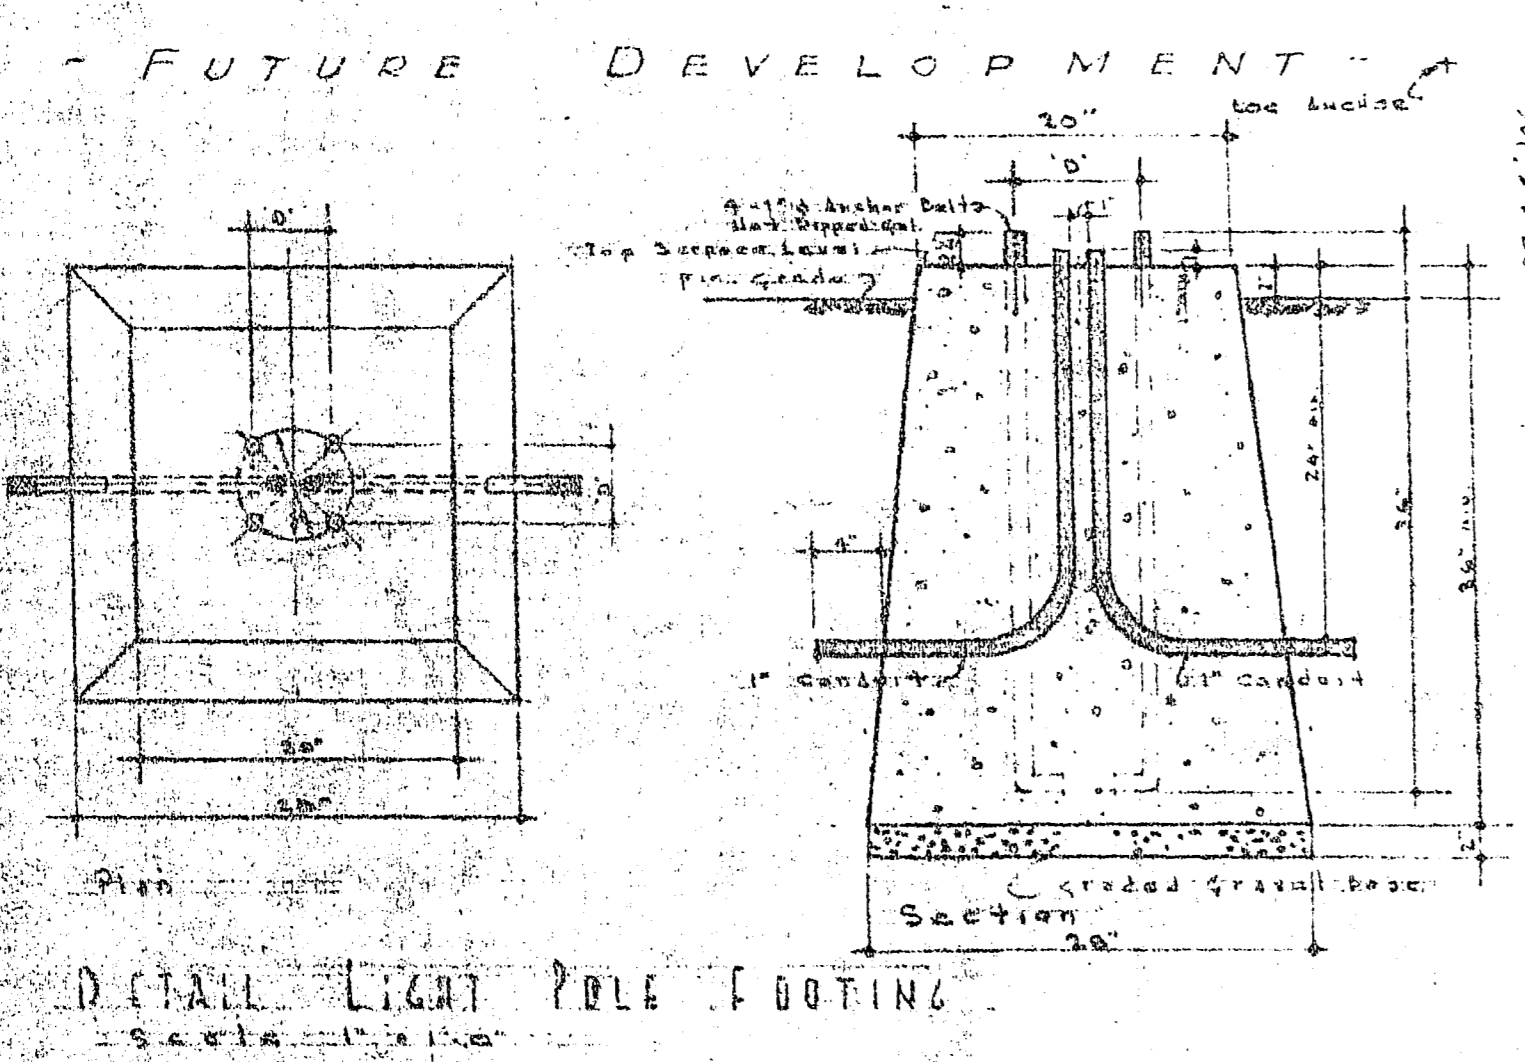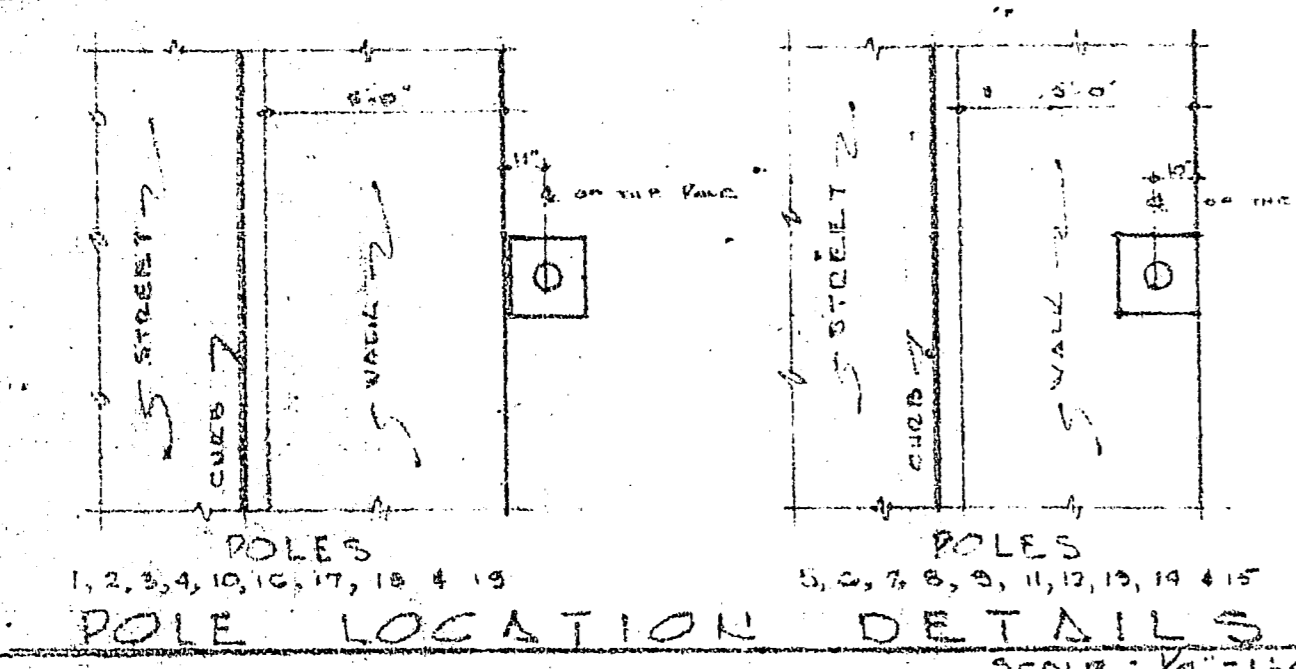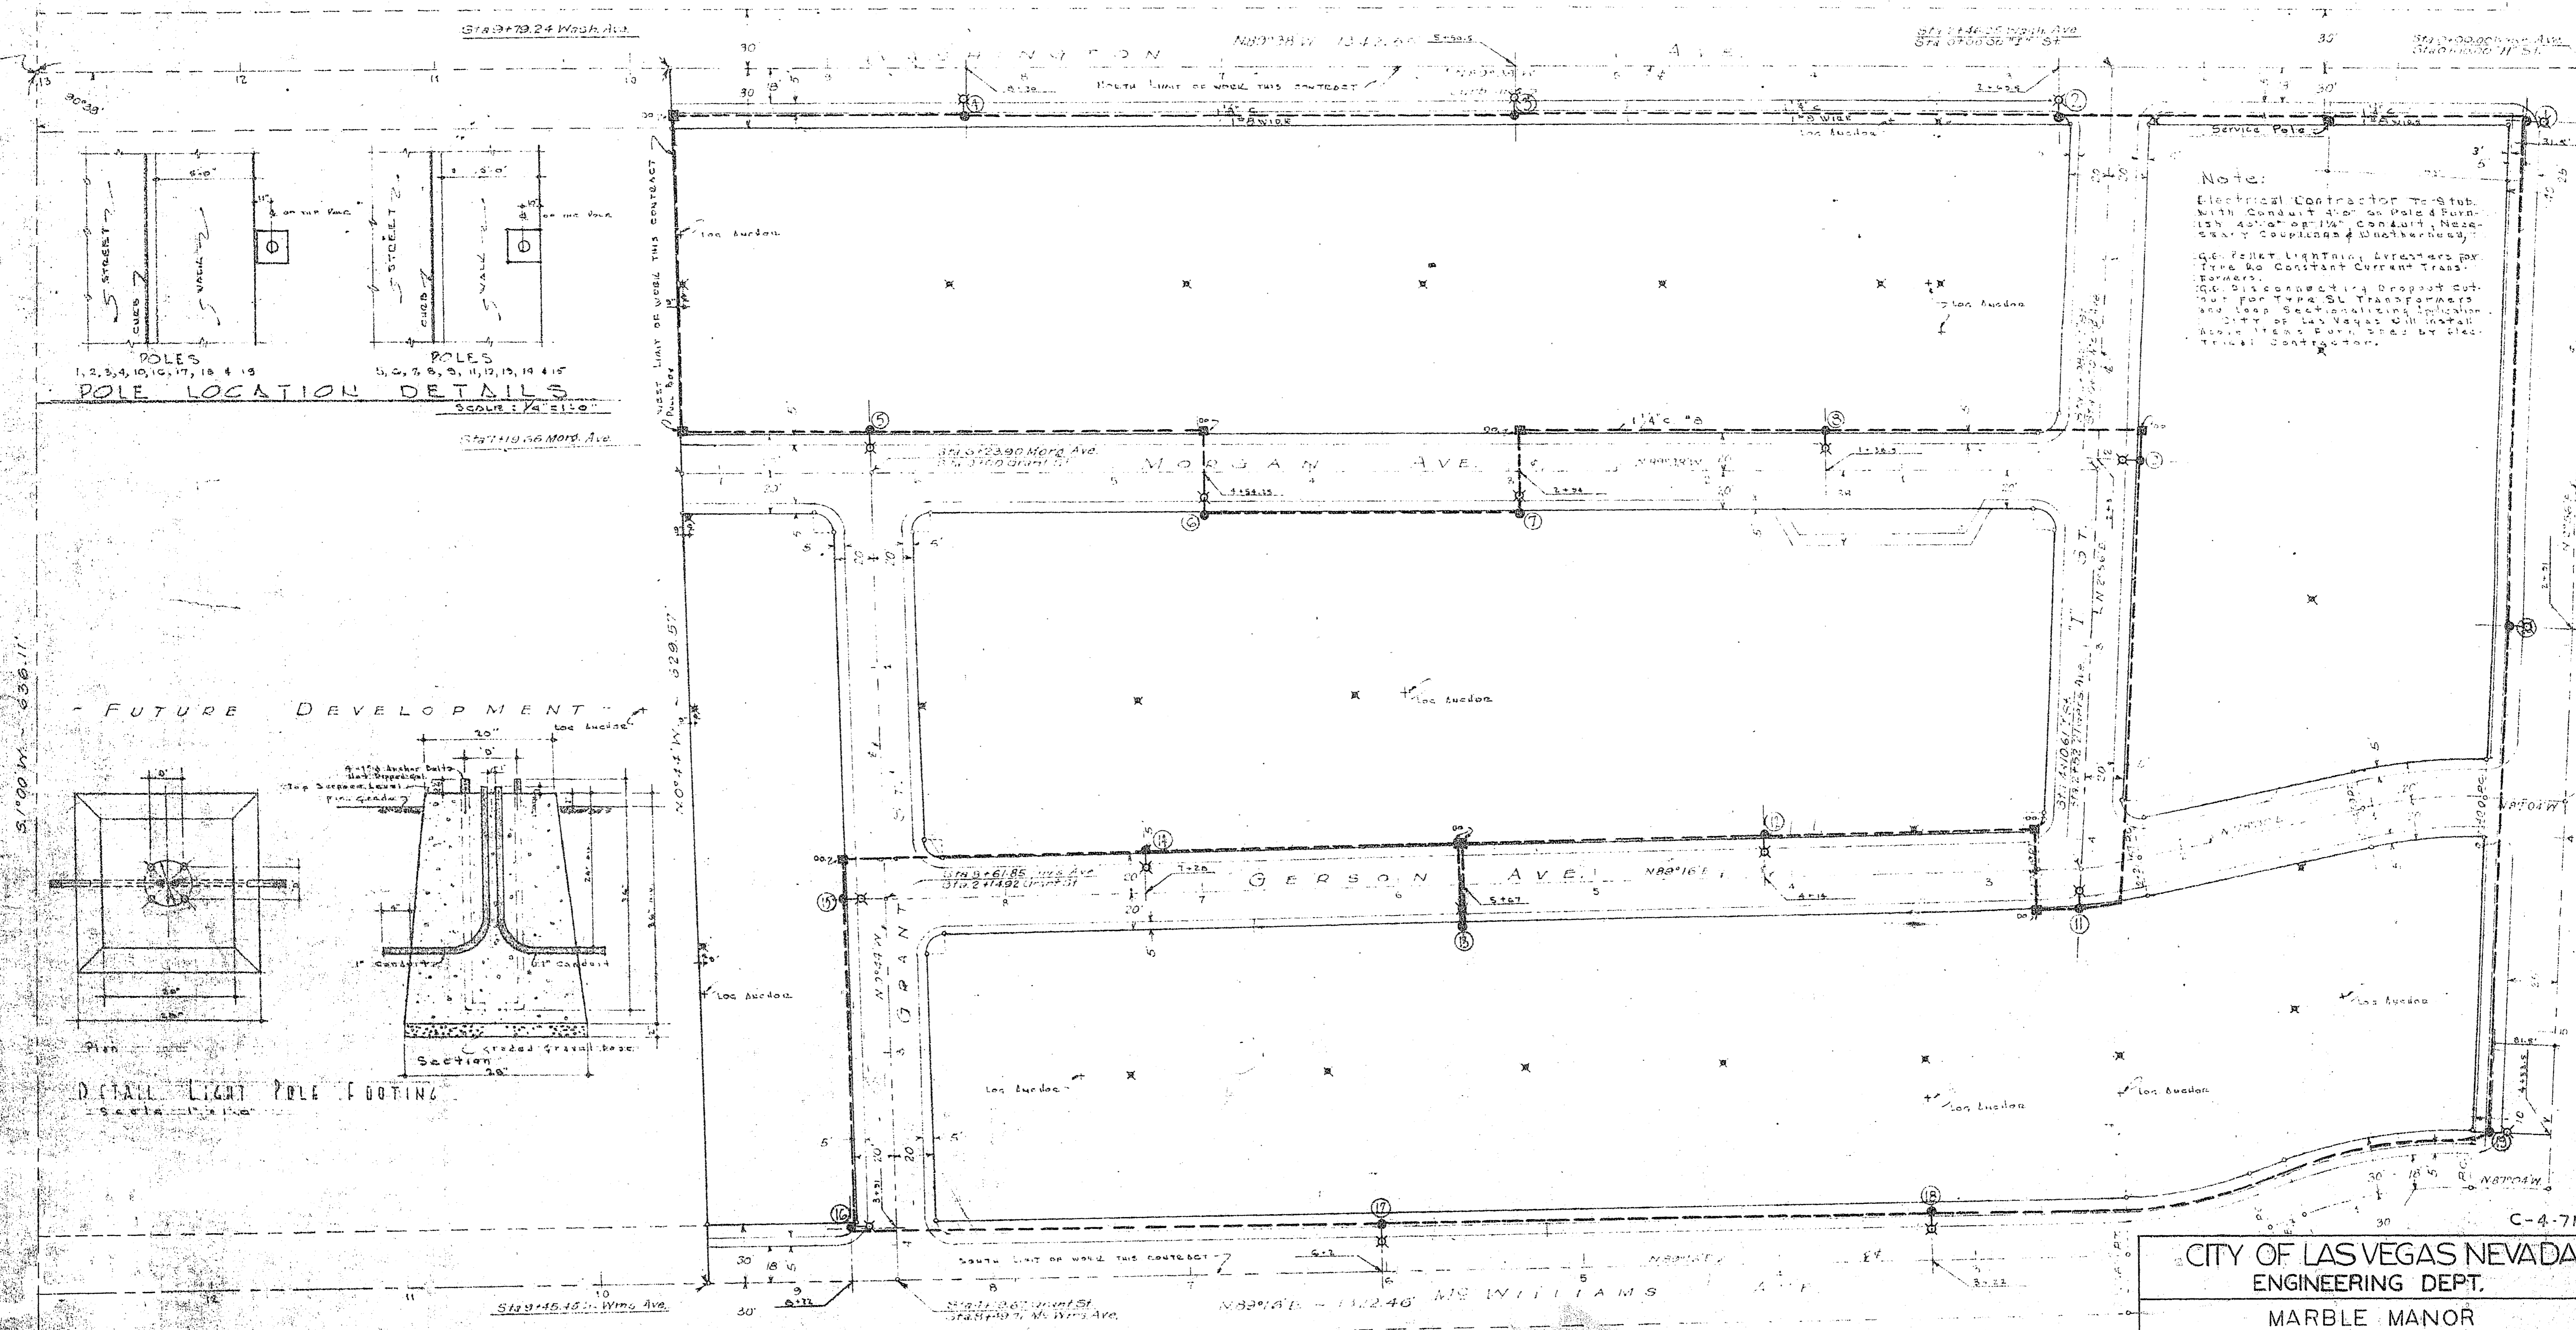

**Note:**  
 Electrical Contractor To-Sub. With Conduit also on Pole & Furnish 40' x 40' x 1/2" Conduit, Necessary Couplings & Weatherheads.  
 40' Pole Light Fixture, Lenses per Type No Constant Current Trans. Formers.  
 100' 5/8" dia. 40' x 40' x 1/2" Dropout Cut-out for Type SL Transformers and Loop Sectionalizing Impedance Controller for Las Vegas City Install Above 11.0 kV & 13.8 kV by Electrical Contractor.

DESIGN NO.	AMOUNTING HGT. FT.	DRYLET SIZE" DIA.	LENGTH C"	STREET WIDTH
SL 1000-1A	21'-0"	8" x 4"	12'-0"	5'-0" OR LESS
SL 1000-1B	26'-0"	8" x 4"	15'-0"	37' TO 50'

**NOTE:**  
 DENOTES POWER POLE. NOT IN THIS CONTRACT. AVILITY CO. TO FURNISH AND INSTALL POWER POLES AND LOS ANCHORS.

REVISIONS	DATE	SCALE 1" = 40'
REVISED TO AS BUILT	By BGG 2-17-55	

**CITY OF LAS VEGAS NEVADA**  
**ENGINEERING DEPT.**  
**MARBLE MANOR**  
**STREET LIGHTING**

DESIGNED BY  
 DRAWN BY  
 CHECKED BY  
 APPROVED  
 CITY ENGR

FIELD BOOK NO.  
 WORK ORDER NO.  
 DRAWING NO.  
**207Y-2040-1**

**BUILT**

267-120