


2-88-95

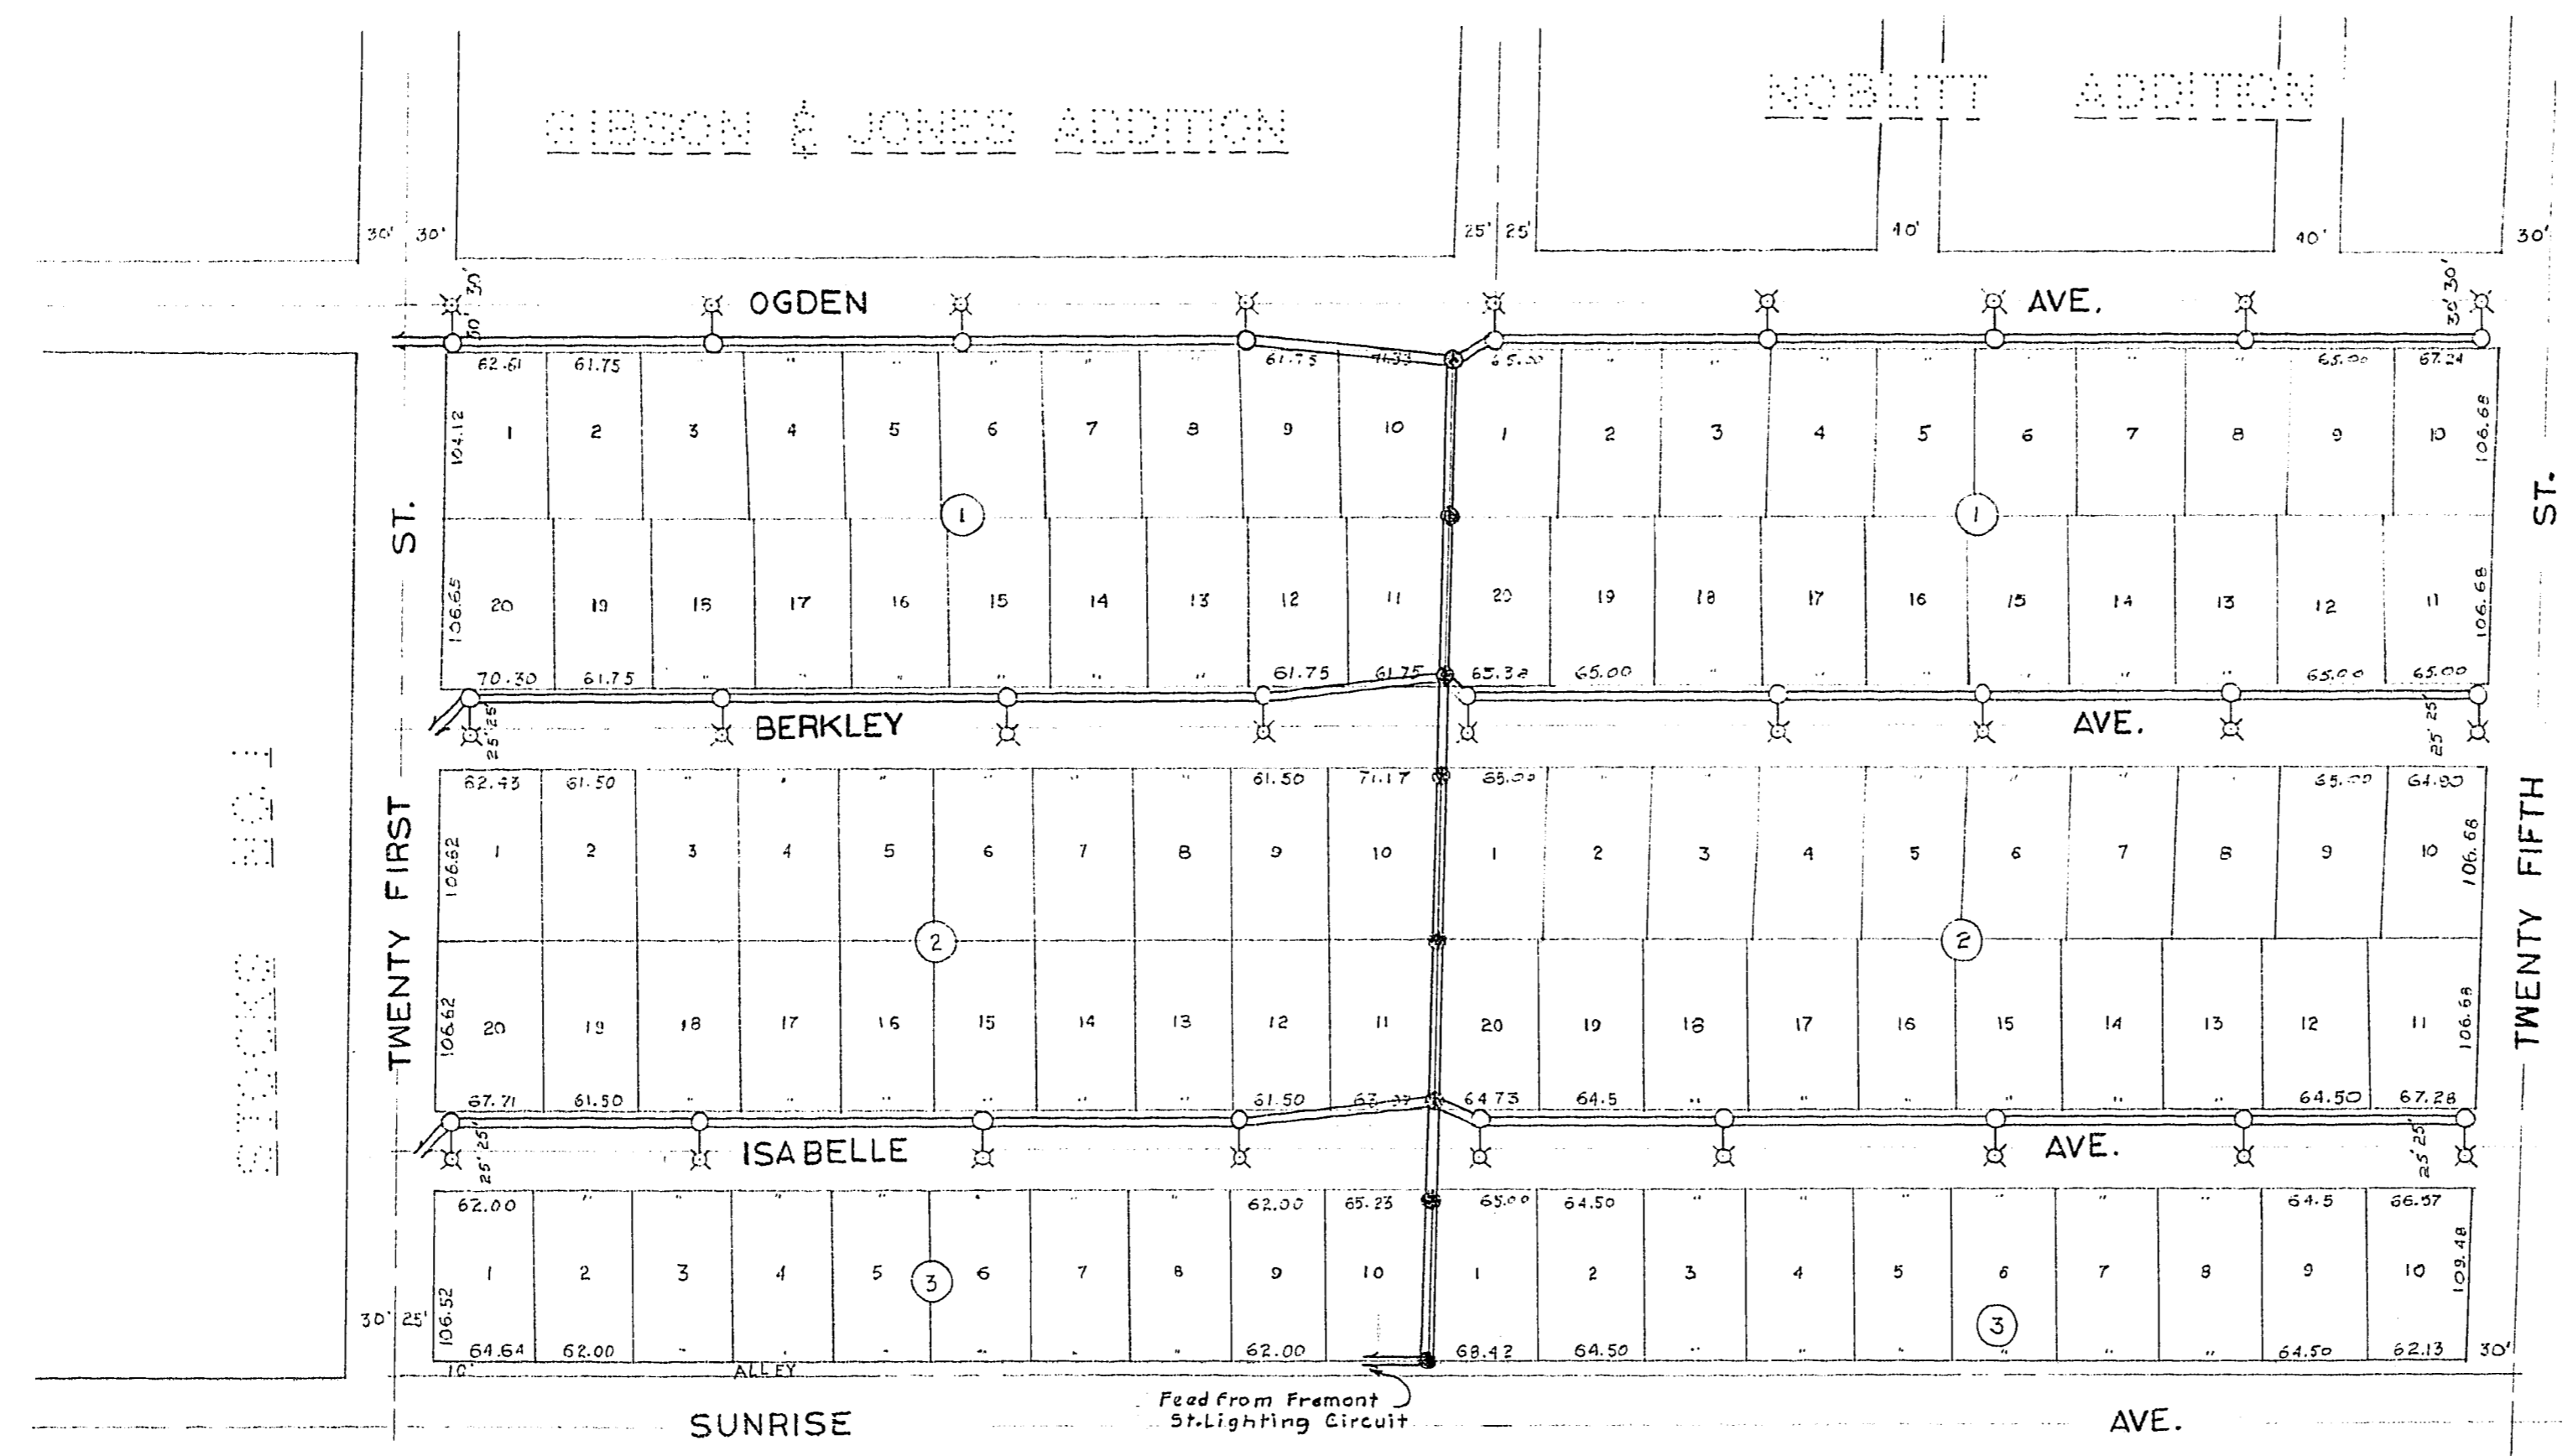

~ LEGEND ~
 X-O 11 GAUGE POLE - - - 27
 ● WOOD POWER CO. POLE
 — OVERHEAD LINE 2700
 + FEED TO ADJOINING TRACT

AS BUILT

C-4-52

CITY OF LAS VEGAS NEVADA	
ENGINEERING DEPT.	
MOSS TRACTS 2 & 3	
STREET LIGHTING	
DESIGNED BY	DATE
DRAWN BY EGE	1-11-53
CHECKED BY	
APPROVED	
CITY ENGR.	
SCALE 1" = 100'	FIELD BOOK NO.
WORK ORDER NO.	DRAWING NO.
	2074-2220-243

REVISIONS		
NO.	BY	DATE

2897