


DISK # MAINS19.DWG

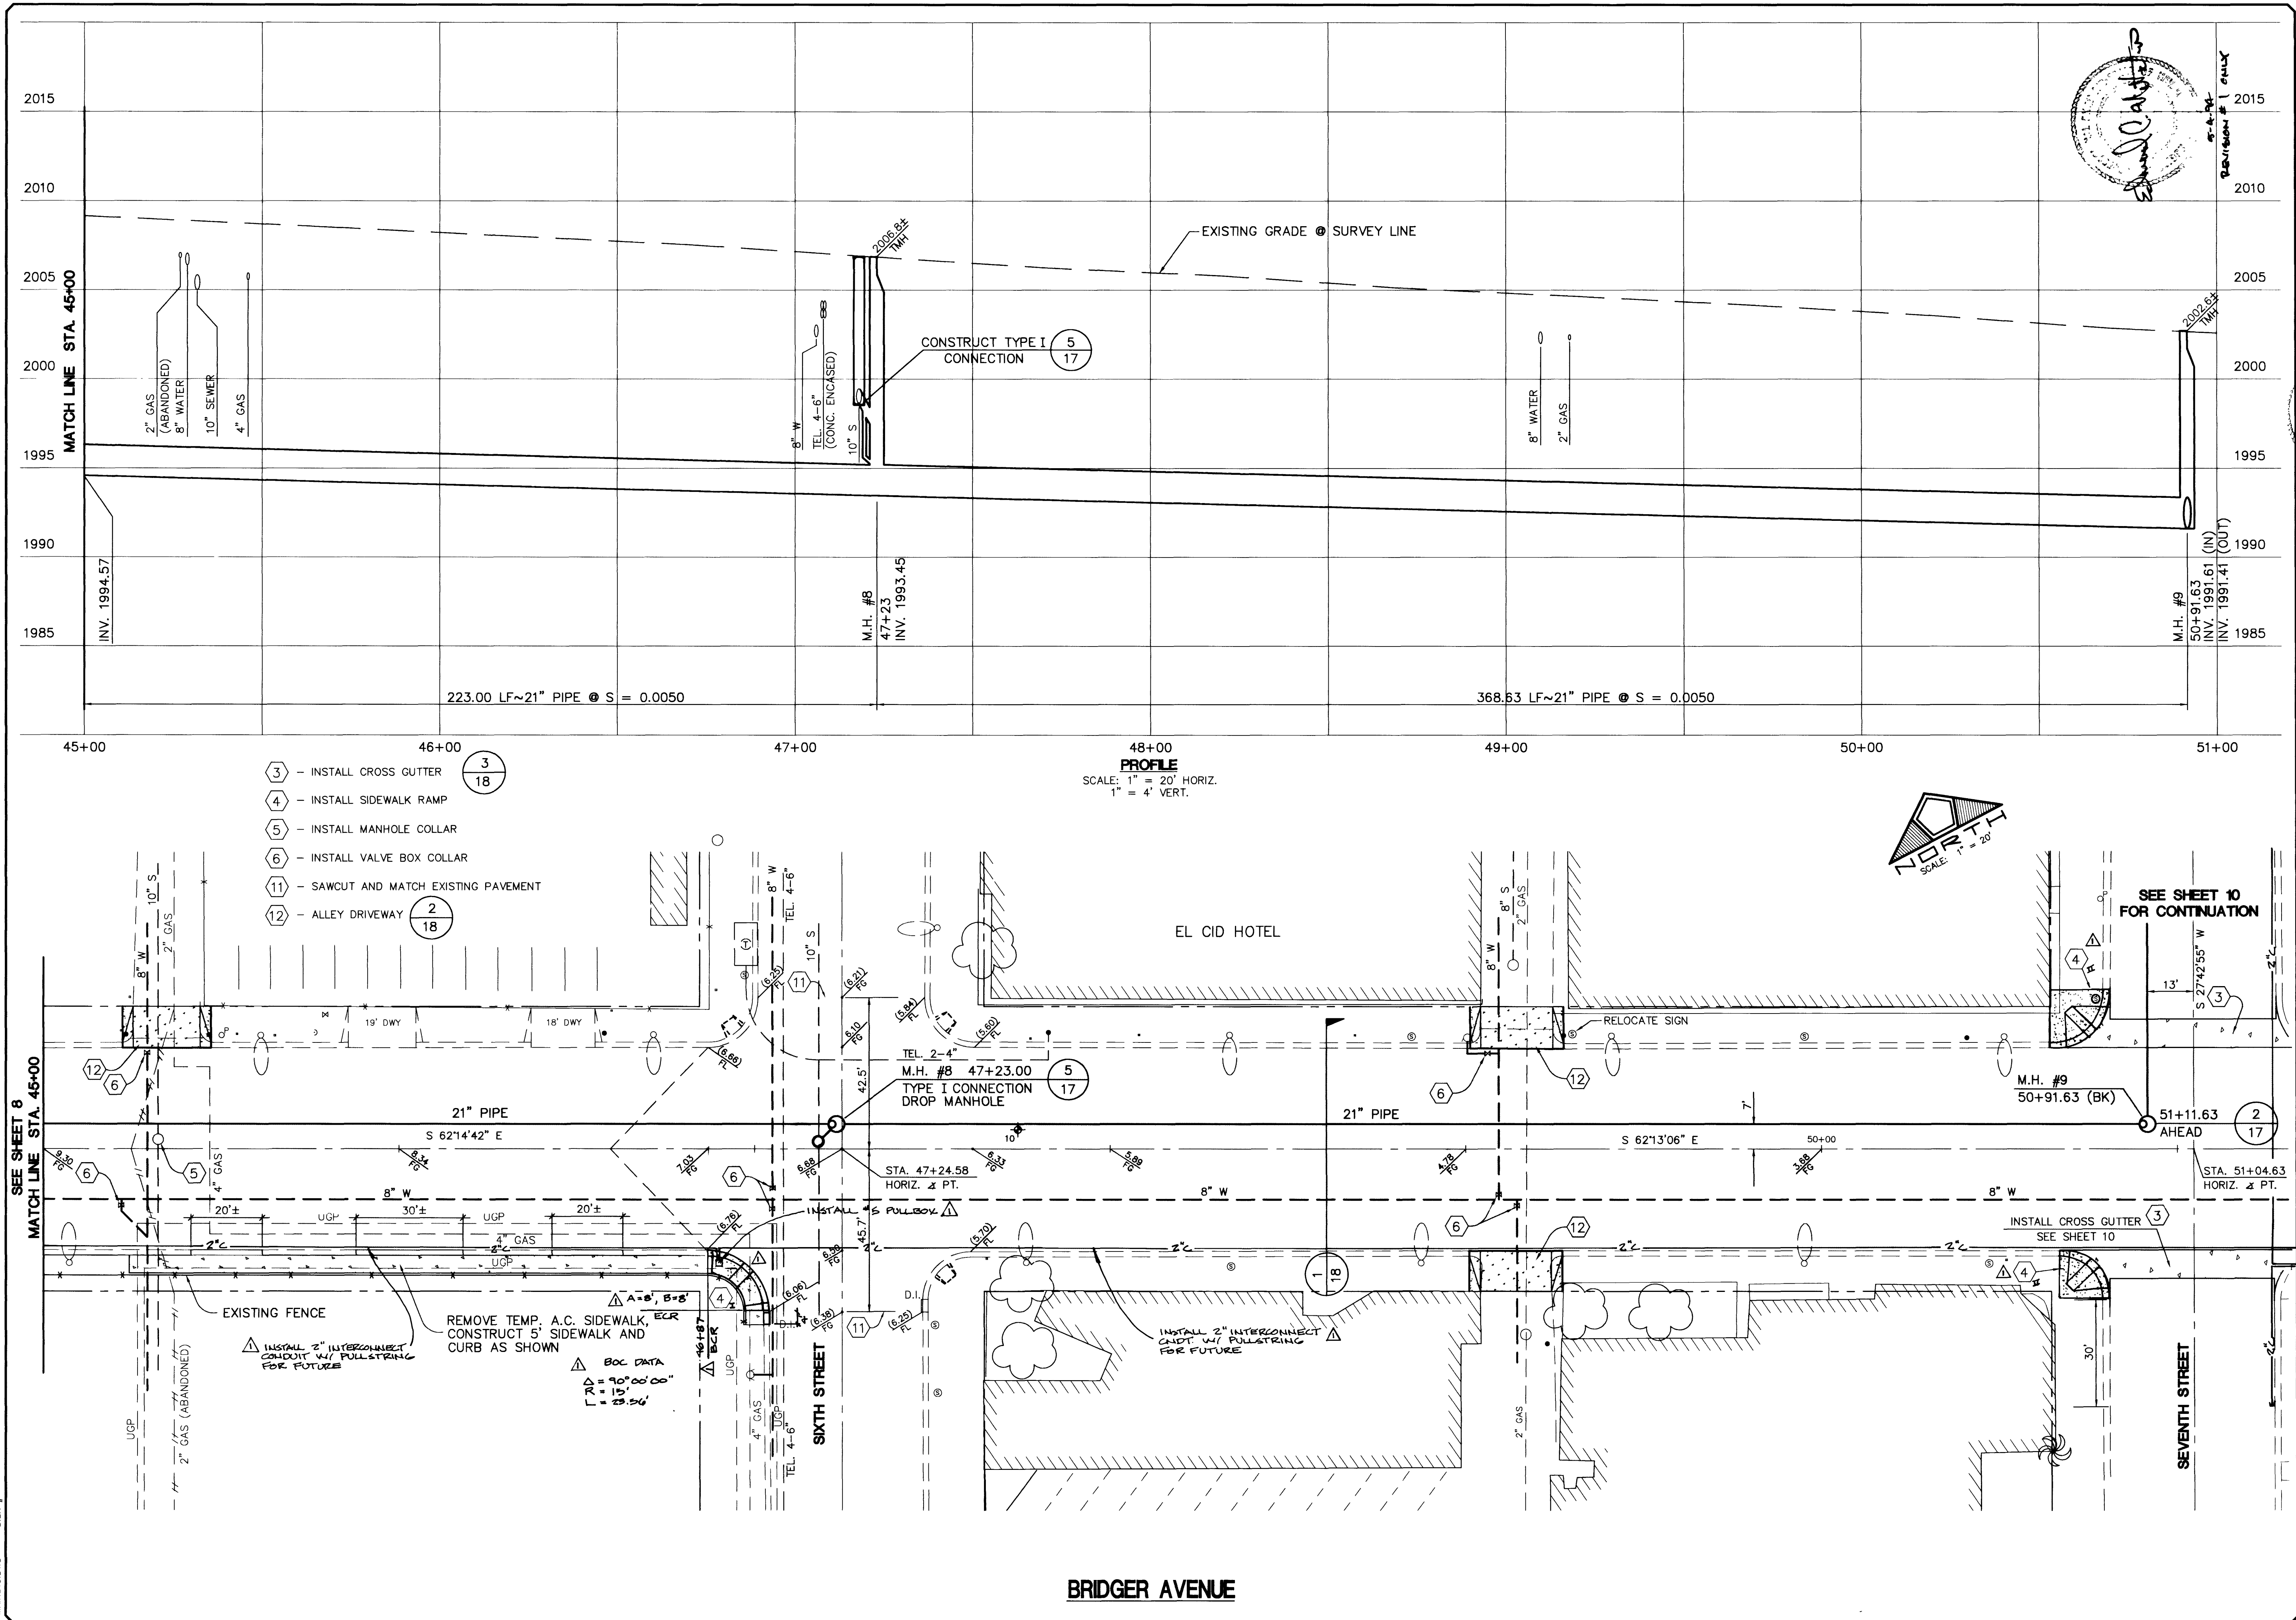


2015
2010
2005
2000
1995
1990
1985

MATCH LINE STA. 45+00

45+00 46+00 47+00 48+00 49+00 50+00 51+00

- 3 - INSTALL CROSS GUTTER
- 4 - INSTALL SIDEWALK RAMP
- 5 - INSTALL MANHOLE COLLAR
- 6 - INSTALL VALVE BOX COLLAR
- 11 - SAWCUT AND MATCH EXISTING PAVEMENT
- 12 - ALLEY DRIVEWAY

PROFILE
SCALE: 1" = 20' HORIZ.
1" = 4' VERT.

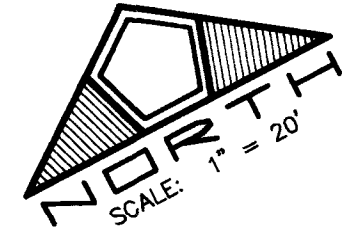

DATE: 04/22/94	DRAWN BY: M.G.	DESIGNED BY: M.W.	CHECKED BY: D.R.	JOB NO.: 133.0100	SCALE: 1" = 20'
RECOMMENDED BY: M. G. MALIN	APPROVED BY: M. G. MALIN	DATE: 4-24-94	DESCRIPTION: REVISION #1	NO.	DATE

PENTACORE
Engineering, Inc.
6763 West Charleston Boulevard
Las Vegas, Nevada 89102
(702) 258-0115

CITY OF LAS VEGAS
MAIN STREET SEWER COLLECTOR
BRIDGER AVENUE
STA. 45+00 TO STA. 51+00

SHEET 9 OF 19
307-V704

26 1-145

