
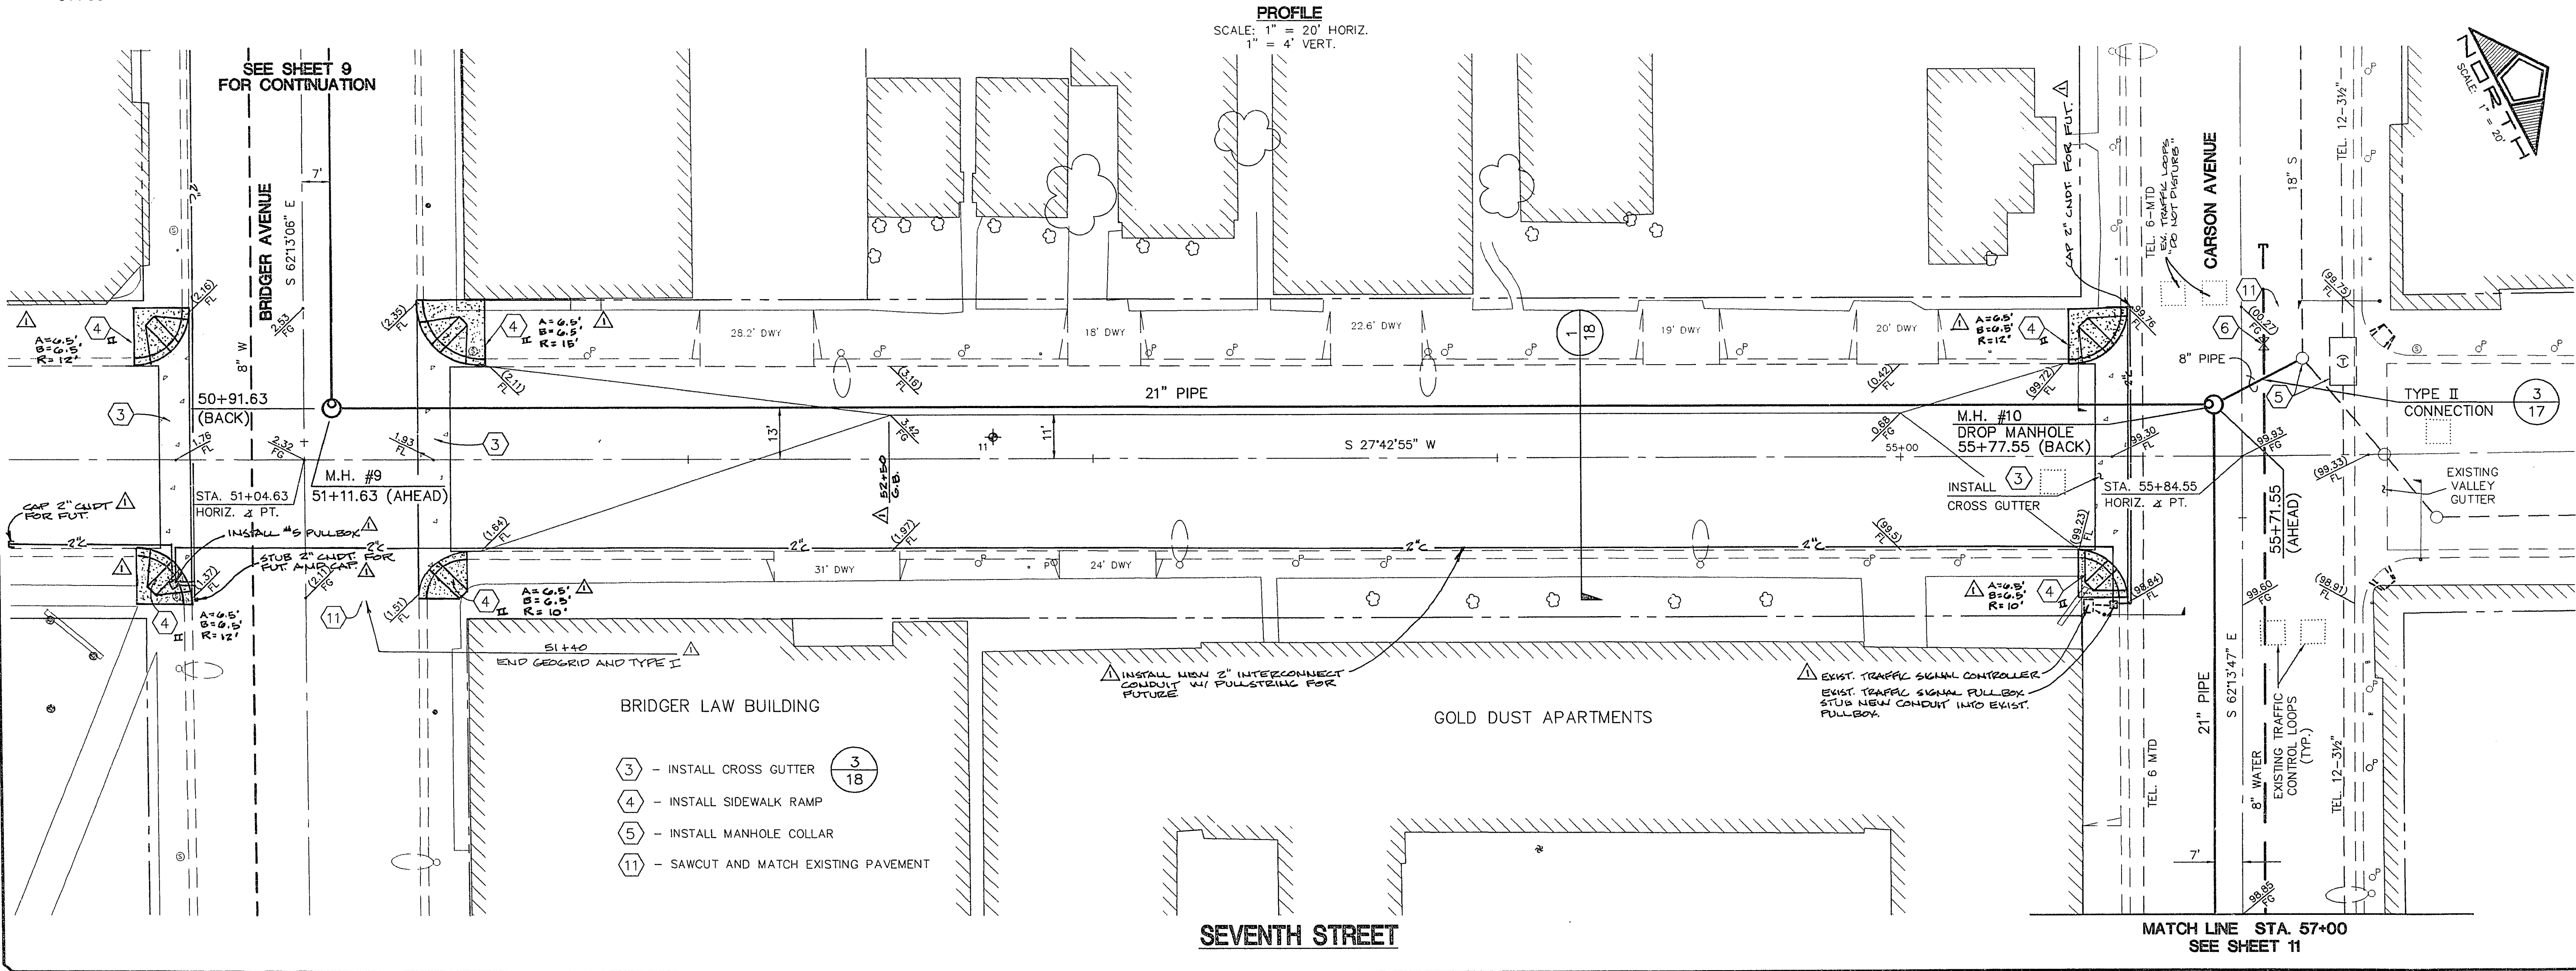


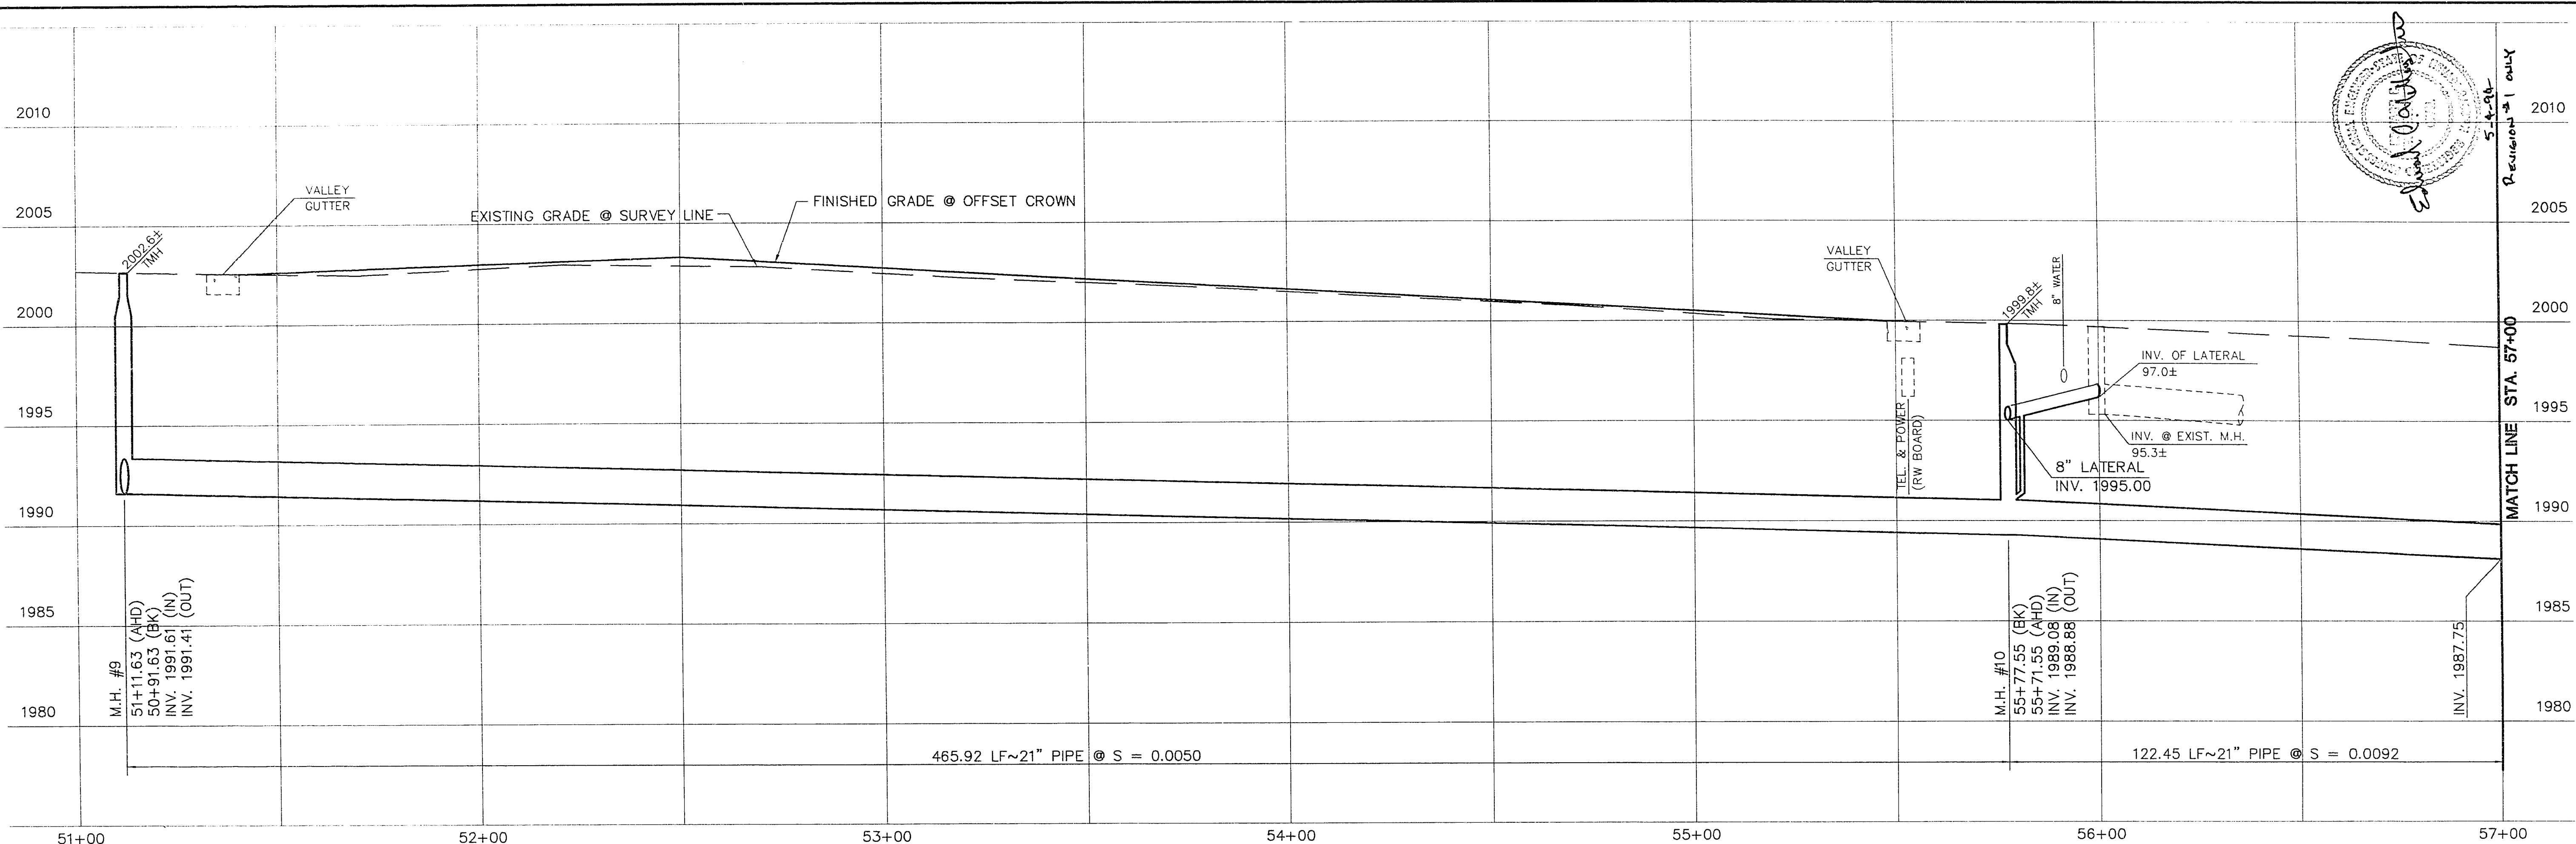

DATE: 04/22/94
DRAWN BY: M.W.
CHECKED BY: D.E.
JOB NO.: 133.000
SCALE: 1" = 20'

REVISION: 5-4-98
NO. DESCRIPTION
DATE APP'D

PENTACORE
Engineering, Inc.
6763 West Charleston Boulevard
Las Vegas, Nevada 89102
(702) 258-0115

CITY OF LAS VEGAS
MAIN STREET SEWER COLLECTOR
SEVENTH STREET
STA. 51+00 TO STA. 57+00

SHEET 10 OF 19
307-V704

STA. 51+00 TO STA. 57+00

26-1-146