
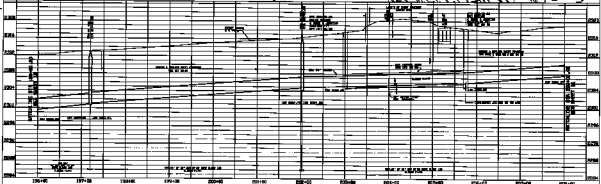


CITY OF LAS VEGAS DEPARTMENT OF PUBLIC WORKS MONTE CRISTO/CHEYENNE SEWER INTERCEPTOR		RECORD DRAWING <small>THESE RECORD DRAWINGS HAVE BEEN PREPARED BASED ON INFORMATION PROVIDED BY OTHERS. THE ENGINEER HAS NOT VERIFIED THE ACCURACY OF SUCH INFORMATION AND SHALL NOT BE RESPONSIBLE FOR ANY ERRORS OR OMISSIONS WHICH MAY BE INCORPORATED HEREIN AS A RESULT. THE DOCUMENTS WERE SEALED ON 10/17/95 BY PATRICK J. ROMAN, LICENSE NO. 11540</small>	DRAWING NO. 307-V739 SHEET 20 OF 26
PLAN AND PROFILE STA 196+00.00 TO STA 208+00.00		DESIGNED: PAT DETAILED: PAT CHECKED: P.JR./JBV APPROVED: [Signature] DATE:	
Black & Veatch Las Vegas, Nevada		DATE: _____ REVISIONS AND RECORD OF ISSUE: _____ NO. BY CK APP	

58-1073
 C6600000
 F0600000

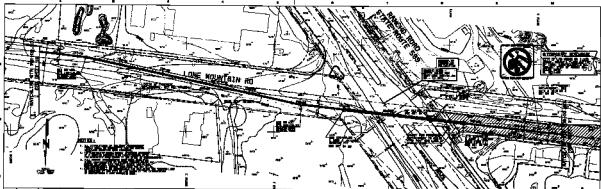

CITY OF LAS VEGAS DEPARTMENT OF PUBLIC WORKS SEWER CONSTRUCTION DIVISION		PROJECT NO. 202-1700 DATE 05/26/03	
PLAN AND PROFILE STA 158+00.00 TO STA 208+00.00			
PROJECT: 202-1700 LOCATION: GRAND BLVD & LONE MOUNTAIN RD SHEET: 202-1700-03		DRAWN BY: [Name] CHECKED BY: [Name]	