

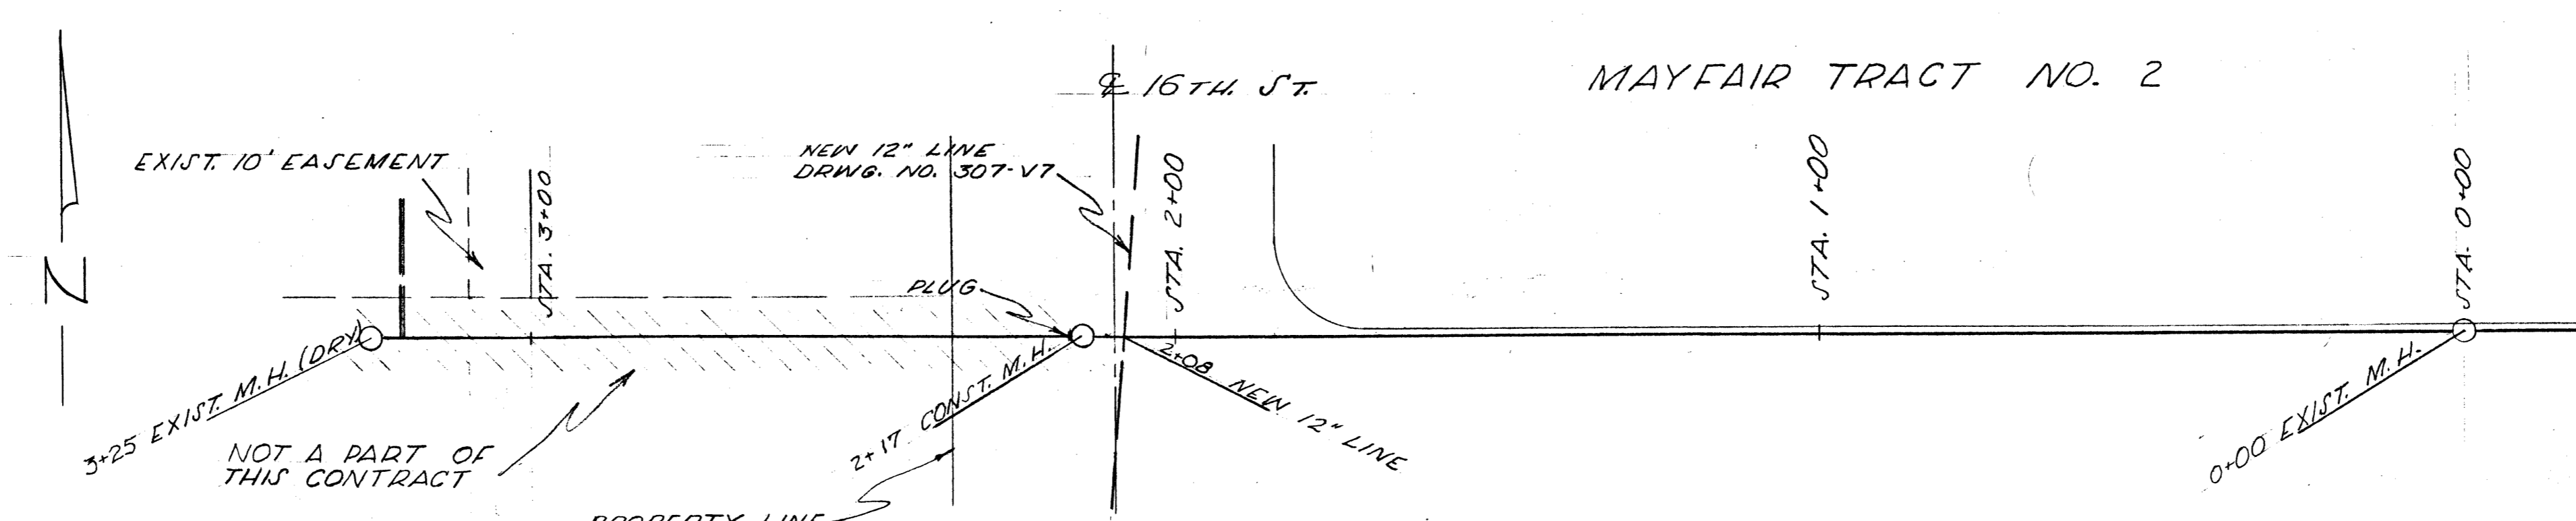


SCALE:  
HORIZONTAL - 1" = 20'  
VERTICAL - 1" = 2'  
B.M. NO. 127 C.L.V. DATUM

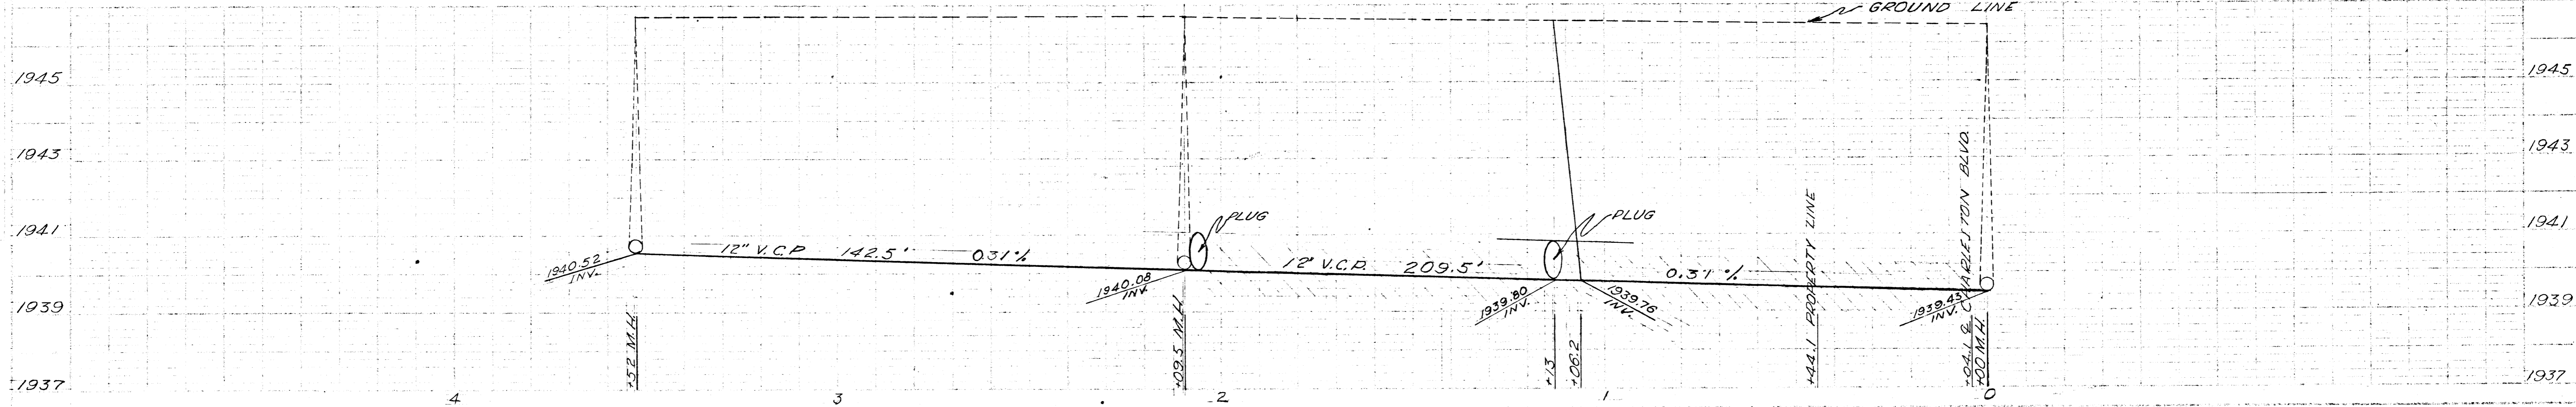

SCALE:  
HORIZONTAL - 1" = 20'  
VERTICAL - 1" = 4'  
B.M. # 127

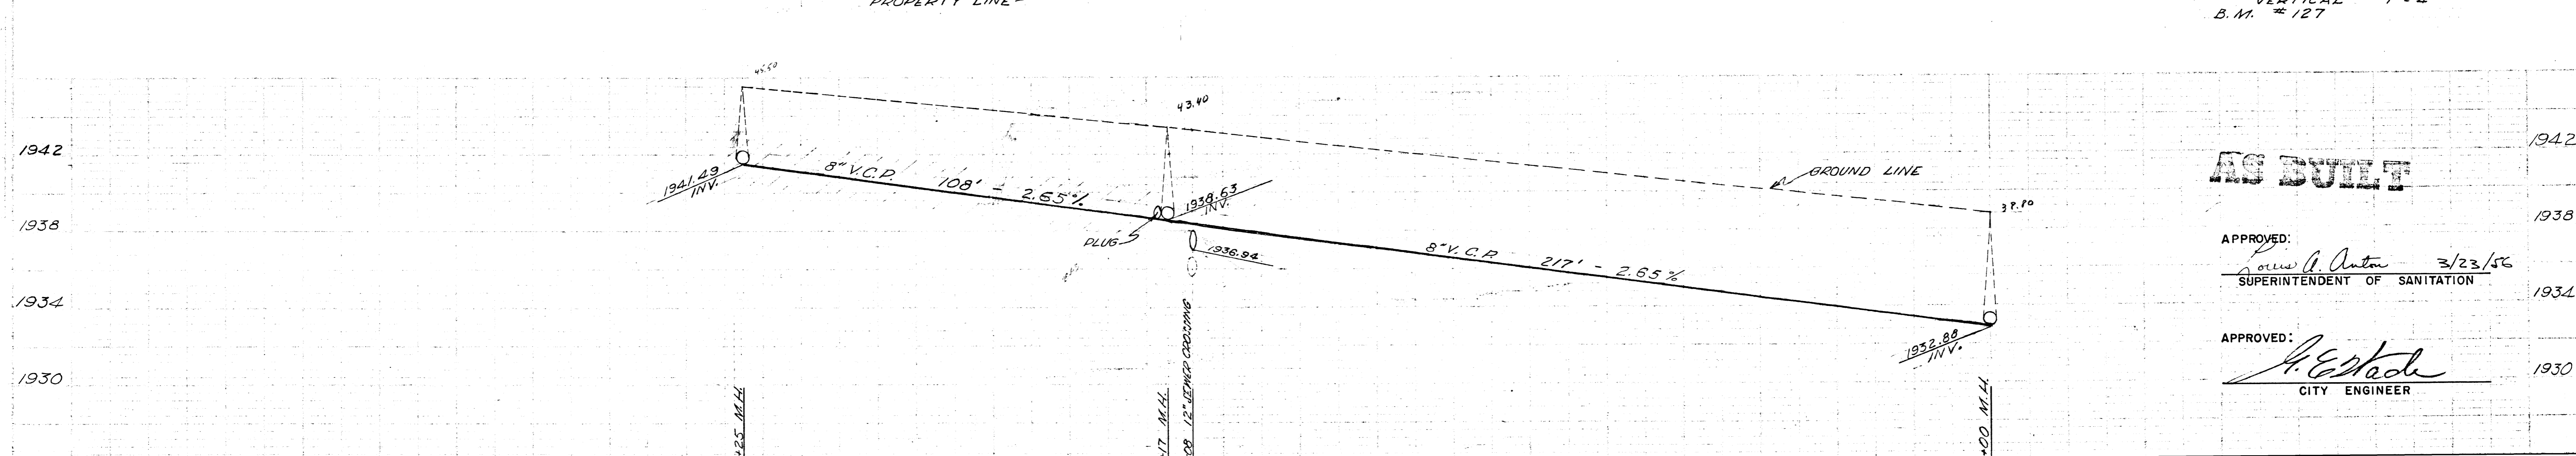

**AS BUILT**

APPROVED:  
*Oliver A. Anton* 3/23/56  
SUPERINTENDENT OF SANITATION

APPROVED:  
*H. E. Stebbins*  
CITY ENGINEER

NEW MANHOLES & PLUGS  
IN EXISTING LINES - VICINITY 16TH & CHARLESTON  
307-V'8  
311 H.41

DITTMER 12-20-55/12-23-56  
STANLEY  
12-23-56

34-52

DITTMER 12-23-55/12-23-56  
STANLEY  
12-23-56

55-12