

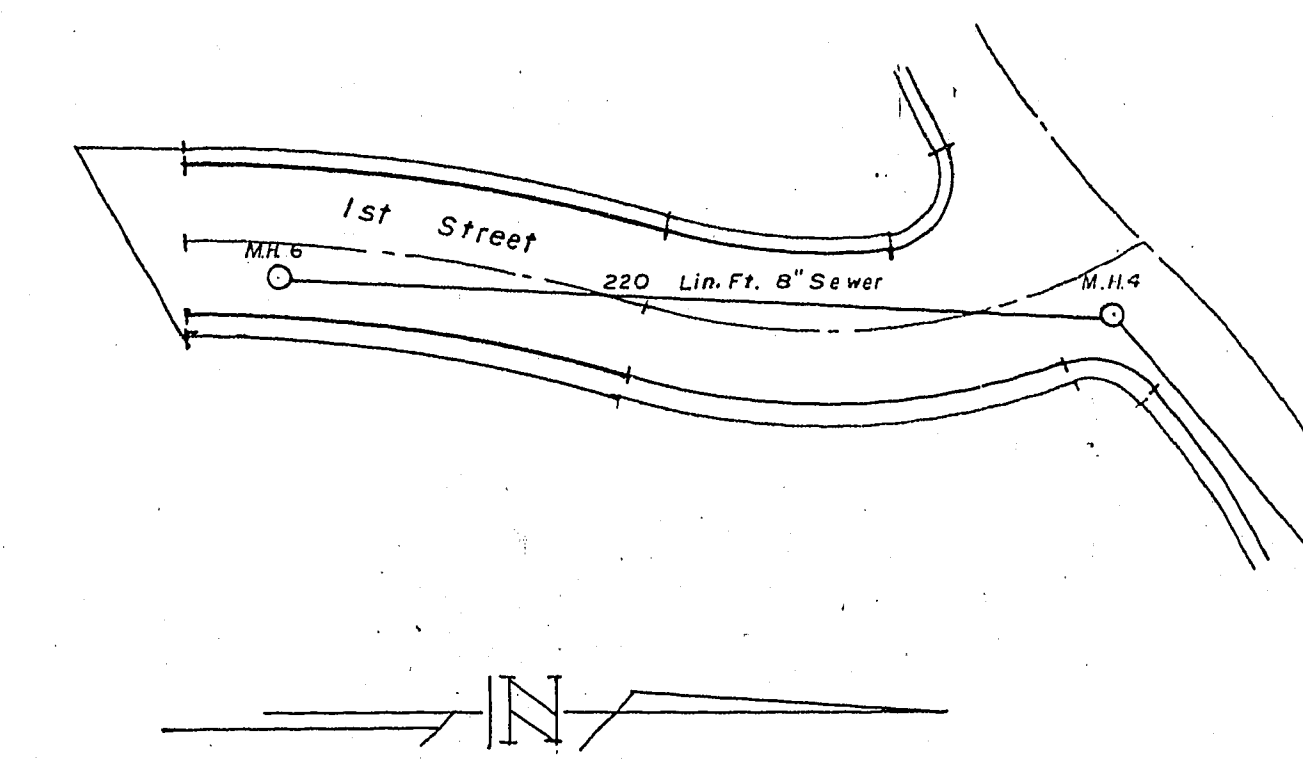
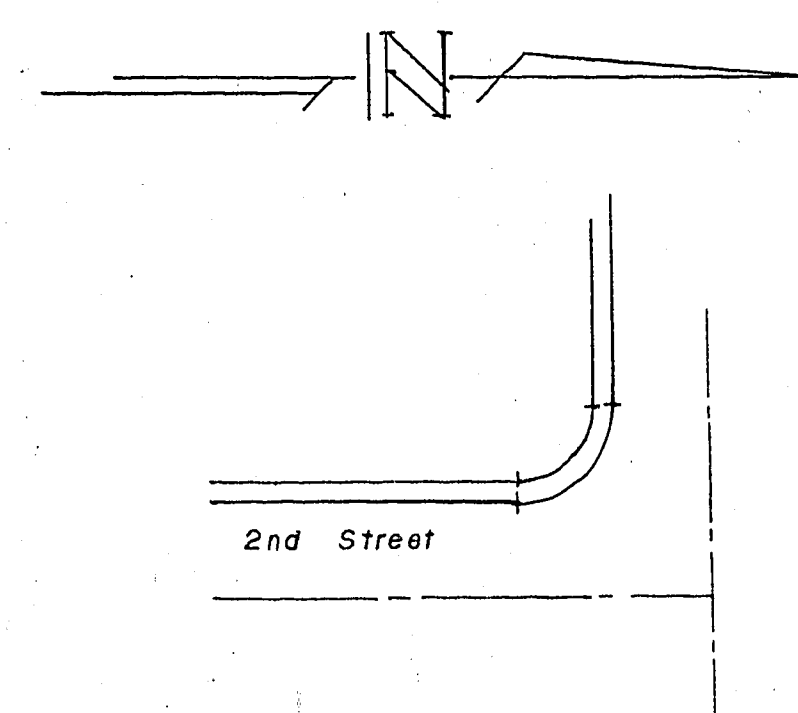
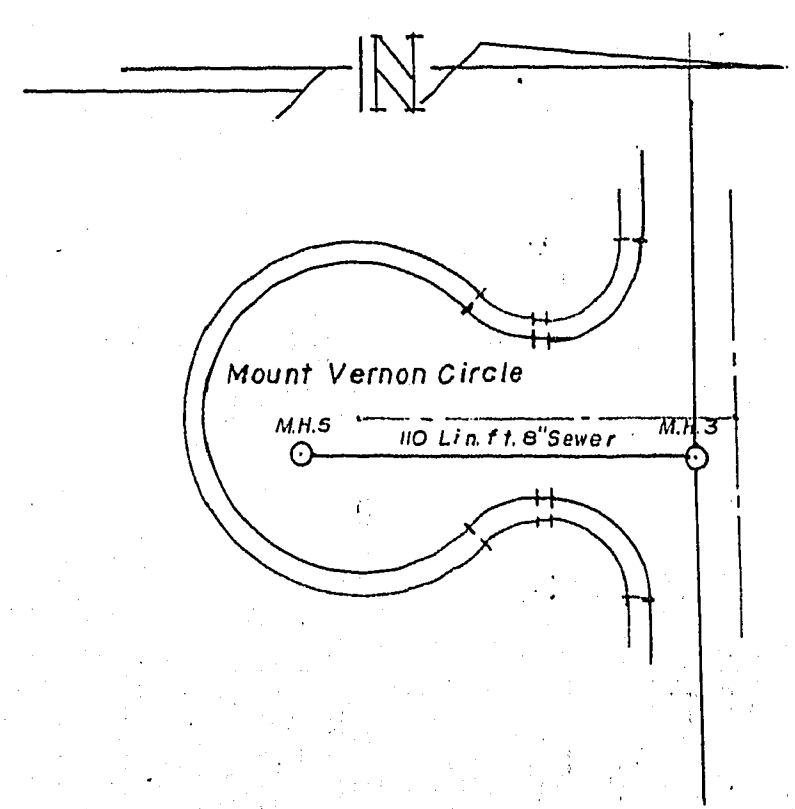
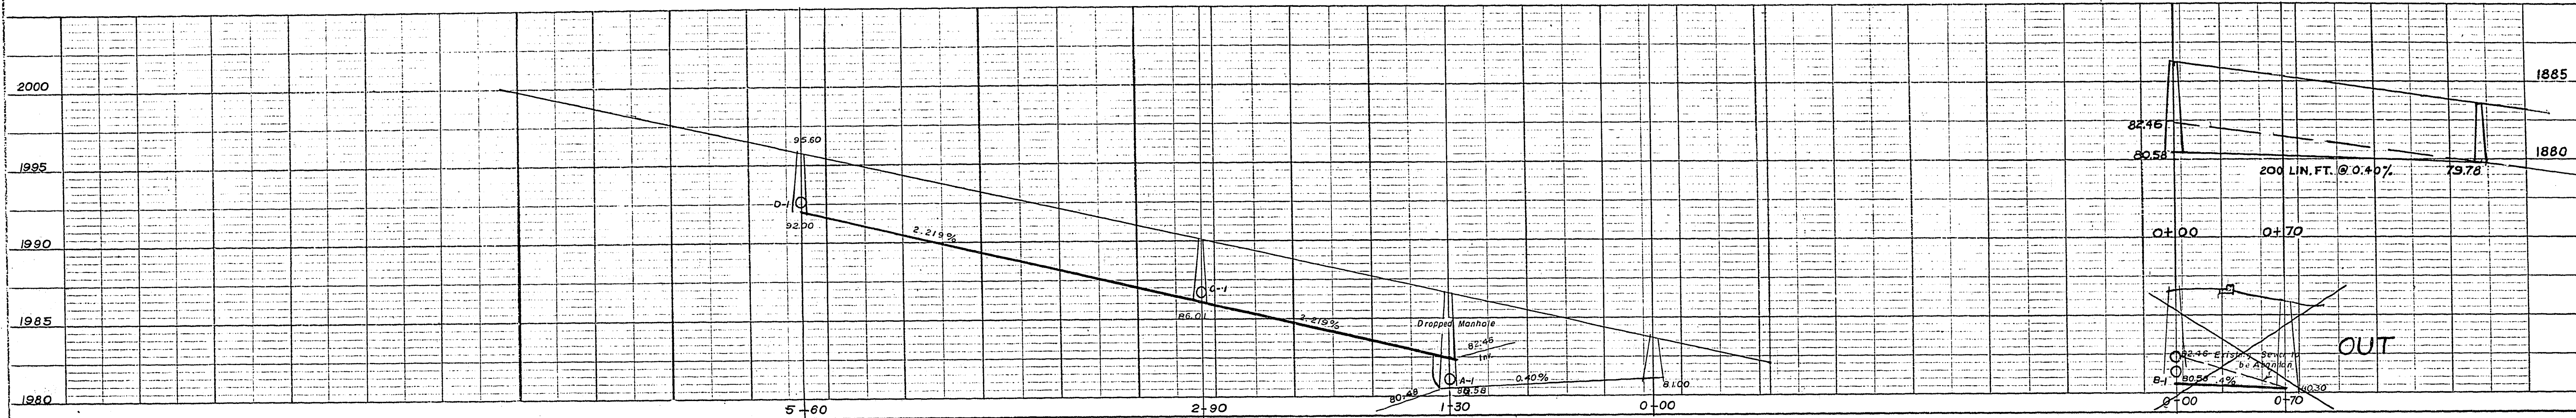


2-8-81

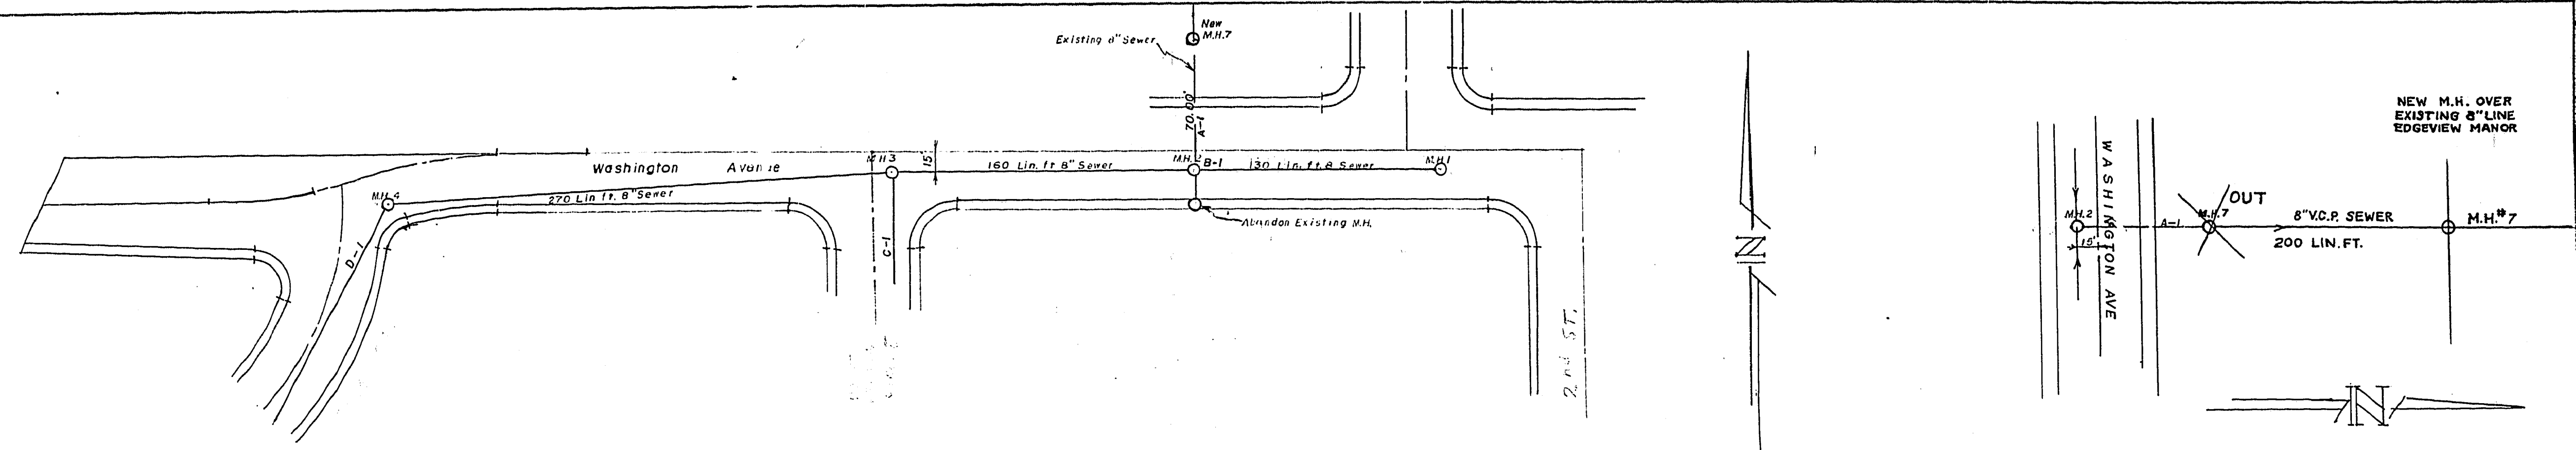

HORIZONTAL SCALE 1"=50'
VERTICAL SCALE 1"=5'

AS CONSTRUCTED

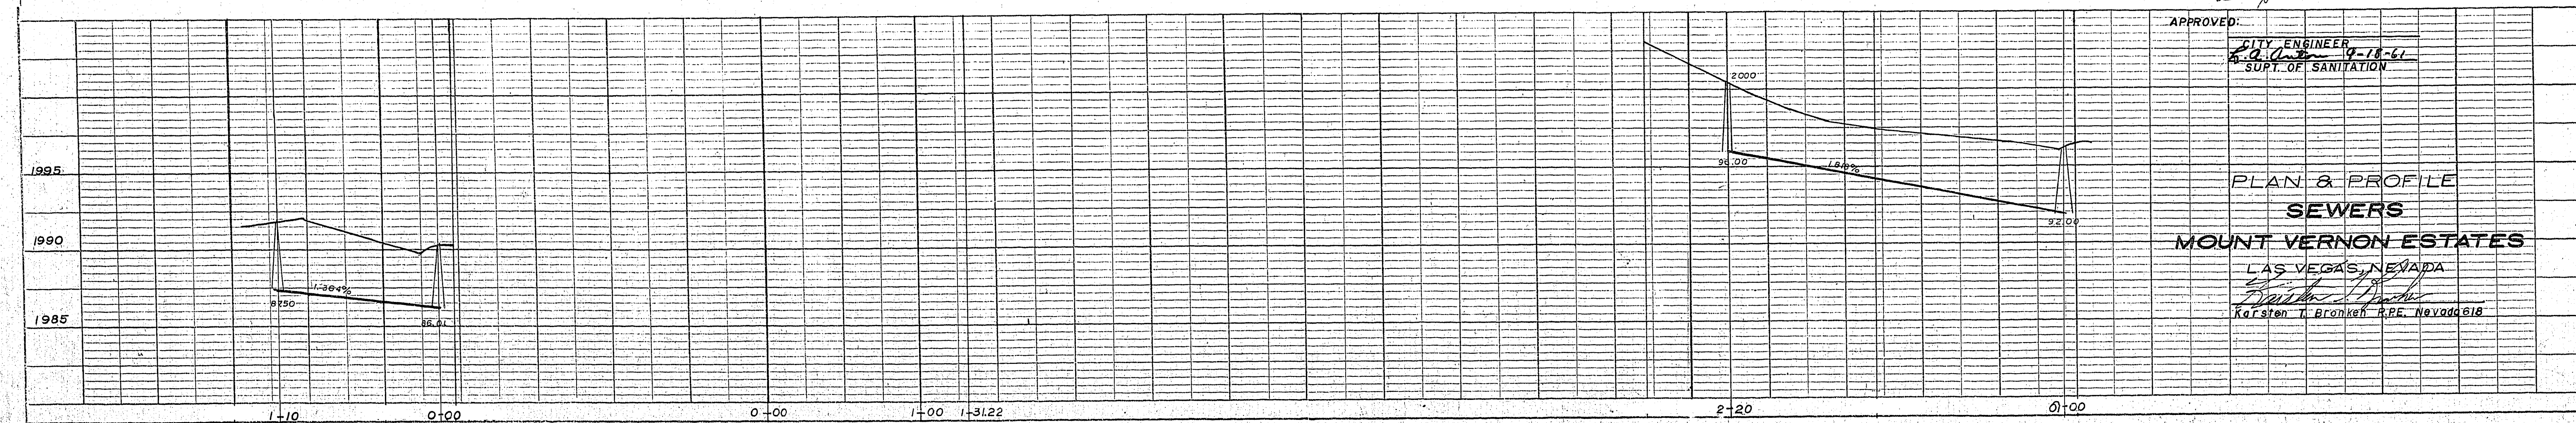

APPROVED: *[Signature]* 9-27-61
CITY ENGINEER
S.U.P.T. OF SANITATION

PLAN & PROFILE
SEWERS
MOUNT VERNON ESTATES
LAS VEGAS, NEVADA
[Signature]
Karsten T. Bronken R.R. Nevada 618

NO.	DATE	BY	TYPE
10			
11			
12			
13			
14			
15			
16			
17			
18			
19			
20			

NO.	DATE	BY	TYPE
10			
11			
12			
13			
14			
15			
16			
17			
18			
19			
20			

2843 3074 2235-1