

LEGEND

- EXISTING CONTOUR
- PROPERTY LINE
- STREET CENTER LINE
- LOT LINE
- IS INFLUENT SEWER
- PW POTABLE WATER
- ROW RIGHT OF WAY

NOTES:

1. FOR GOWAN ROAD INTERCEPTOR TO WRC, SEE MANHOLE SCHEDULE, DRAWING G14, AND PROFILE, DRAWING G20.


FILE: 121UG11R 1:1 07/03/01 15:28 GH-A

GREELEY AND HANSEN
ENGINEERS
4625 SOUTH POLARIS AVENUE, SUITE 210
LAS VEGAS, NV 89103 (702) 736-7082

DESIGNED JSC
DRAWN RJS
CHECKED JWW

APPROVED
ABANDON IN PLACE
SEE DRAWING G12 FOR ADDITIONAL YARD PIPING INFORMATION

1	7/3/01	JWW	CO #15
NO.	DATE	APPD	REVISION

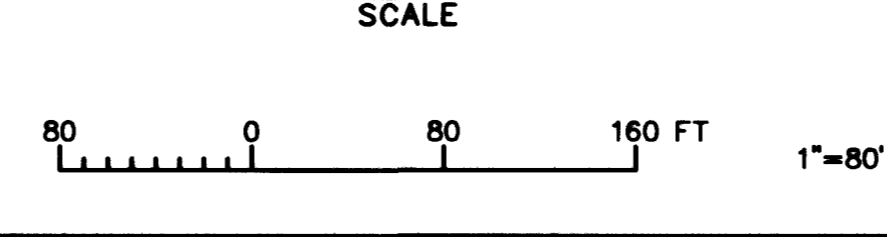

CITY OF LAS VEGAS, NEVADA
DEPARTMENT OF PUBLIC WORKS
NORTHWEST WATER RESOURCE CENTER (WRC)

GENERAL PIPING PLAN
100 ACRE SITE - SOUTH

PROJ NO.	1215
DWG	G11
SHEET	11 OF 218
DATE	OCTOBER 1998
REV	0

RECORD DRAWING