


NOTES:
1. NOT ALL PENETRATIONS ARE SHOWN ON THESE DRAWINGS, COORDINATE WITH MECHANICAL, ELECTRICAL DRAWINGS FOR SIZE, TYPE, INVERT ELEVATIONS AND FINAL LOCATION OF ADDITIONAL OPENINGS.
2. WHEN AN "*" APPEARS, THE DIMENSIONS MAY HAVE TO BE ADJUSTED BASED ON THE APPROVED EQUIPMENT. CHANGES TO THE STRUCTURE BASED ON THESE ADJUSTMENTS SHALL BE PERFORMED BY THE CONTRACTOR AT NO ADDITIONAL COST TO THE OWNER.

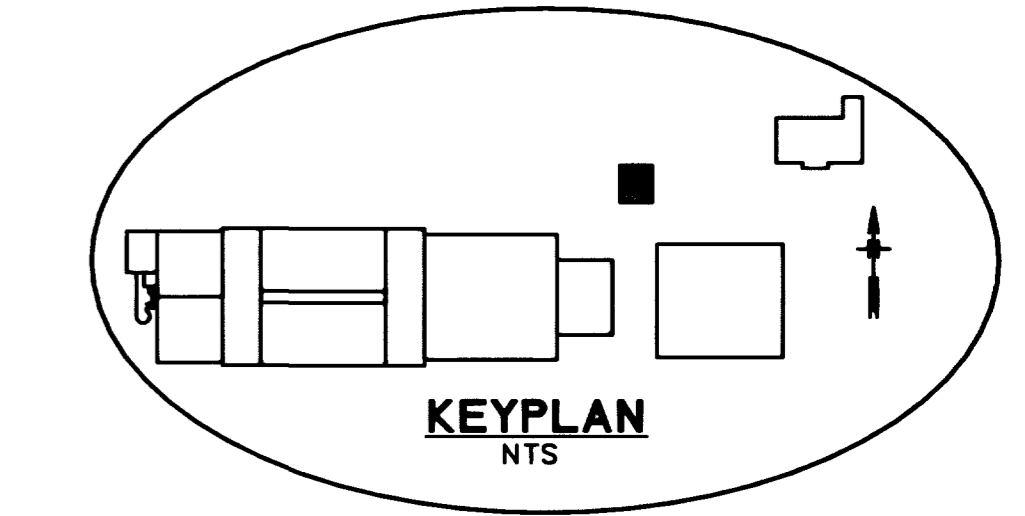


POGGEMEYER DESIGN GROUP
ENGINEERS + PLANNERS + SURVEYORS
2601 NORTH TENAYA WAY
LAS VEGAS, NV 89128 (702) 255-8100

GREELEY AND HANSEN
ENGINEERS
4625 SOUTH POLARIS AVENUE, SUITE 210
LAS VEGAS, NV 89103 (702) 736-7062

| | | | |
|----------|-----|----------|--|
| DESIGNED | MSZ | APPROVED | |
| DRAWN | SSG | | |
| CHECKED | MSZ | | |

| | | | |
|-----|---------|------|----------------|
| NO. | DATE | APPD | REVISION |
| 1 | 8/17/01 | JWW | RECORD DRAWING |

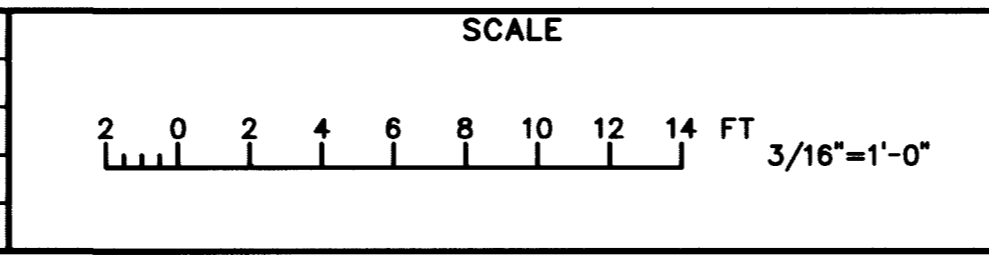

CITY OF LAS VEGAS, NEVADA
DEPARTMENT OF PUBLIC WORKS
NORTHWEST WATER RESOURCE CENTER

STRUCTURAL
INFLUENT PUMP STATION
PLANS

| | |
|----------|----------------------|
| PROJ NO. | 6430002 |
| DWG | S9 |
| SHEET | 46 OF 218 |
| DATE | SEPTEMBER 1998 REV 0 |

RECORD DRAWING

FILE: S09psr 1:1 08/17/01 16:05 GH-A