


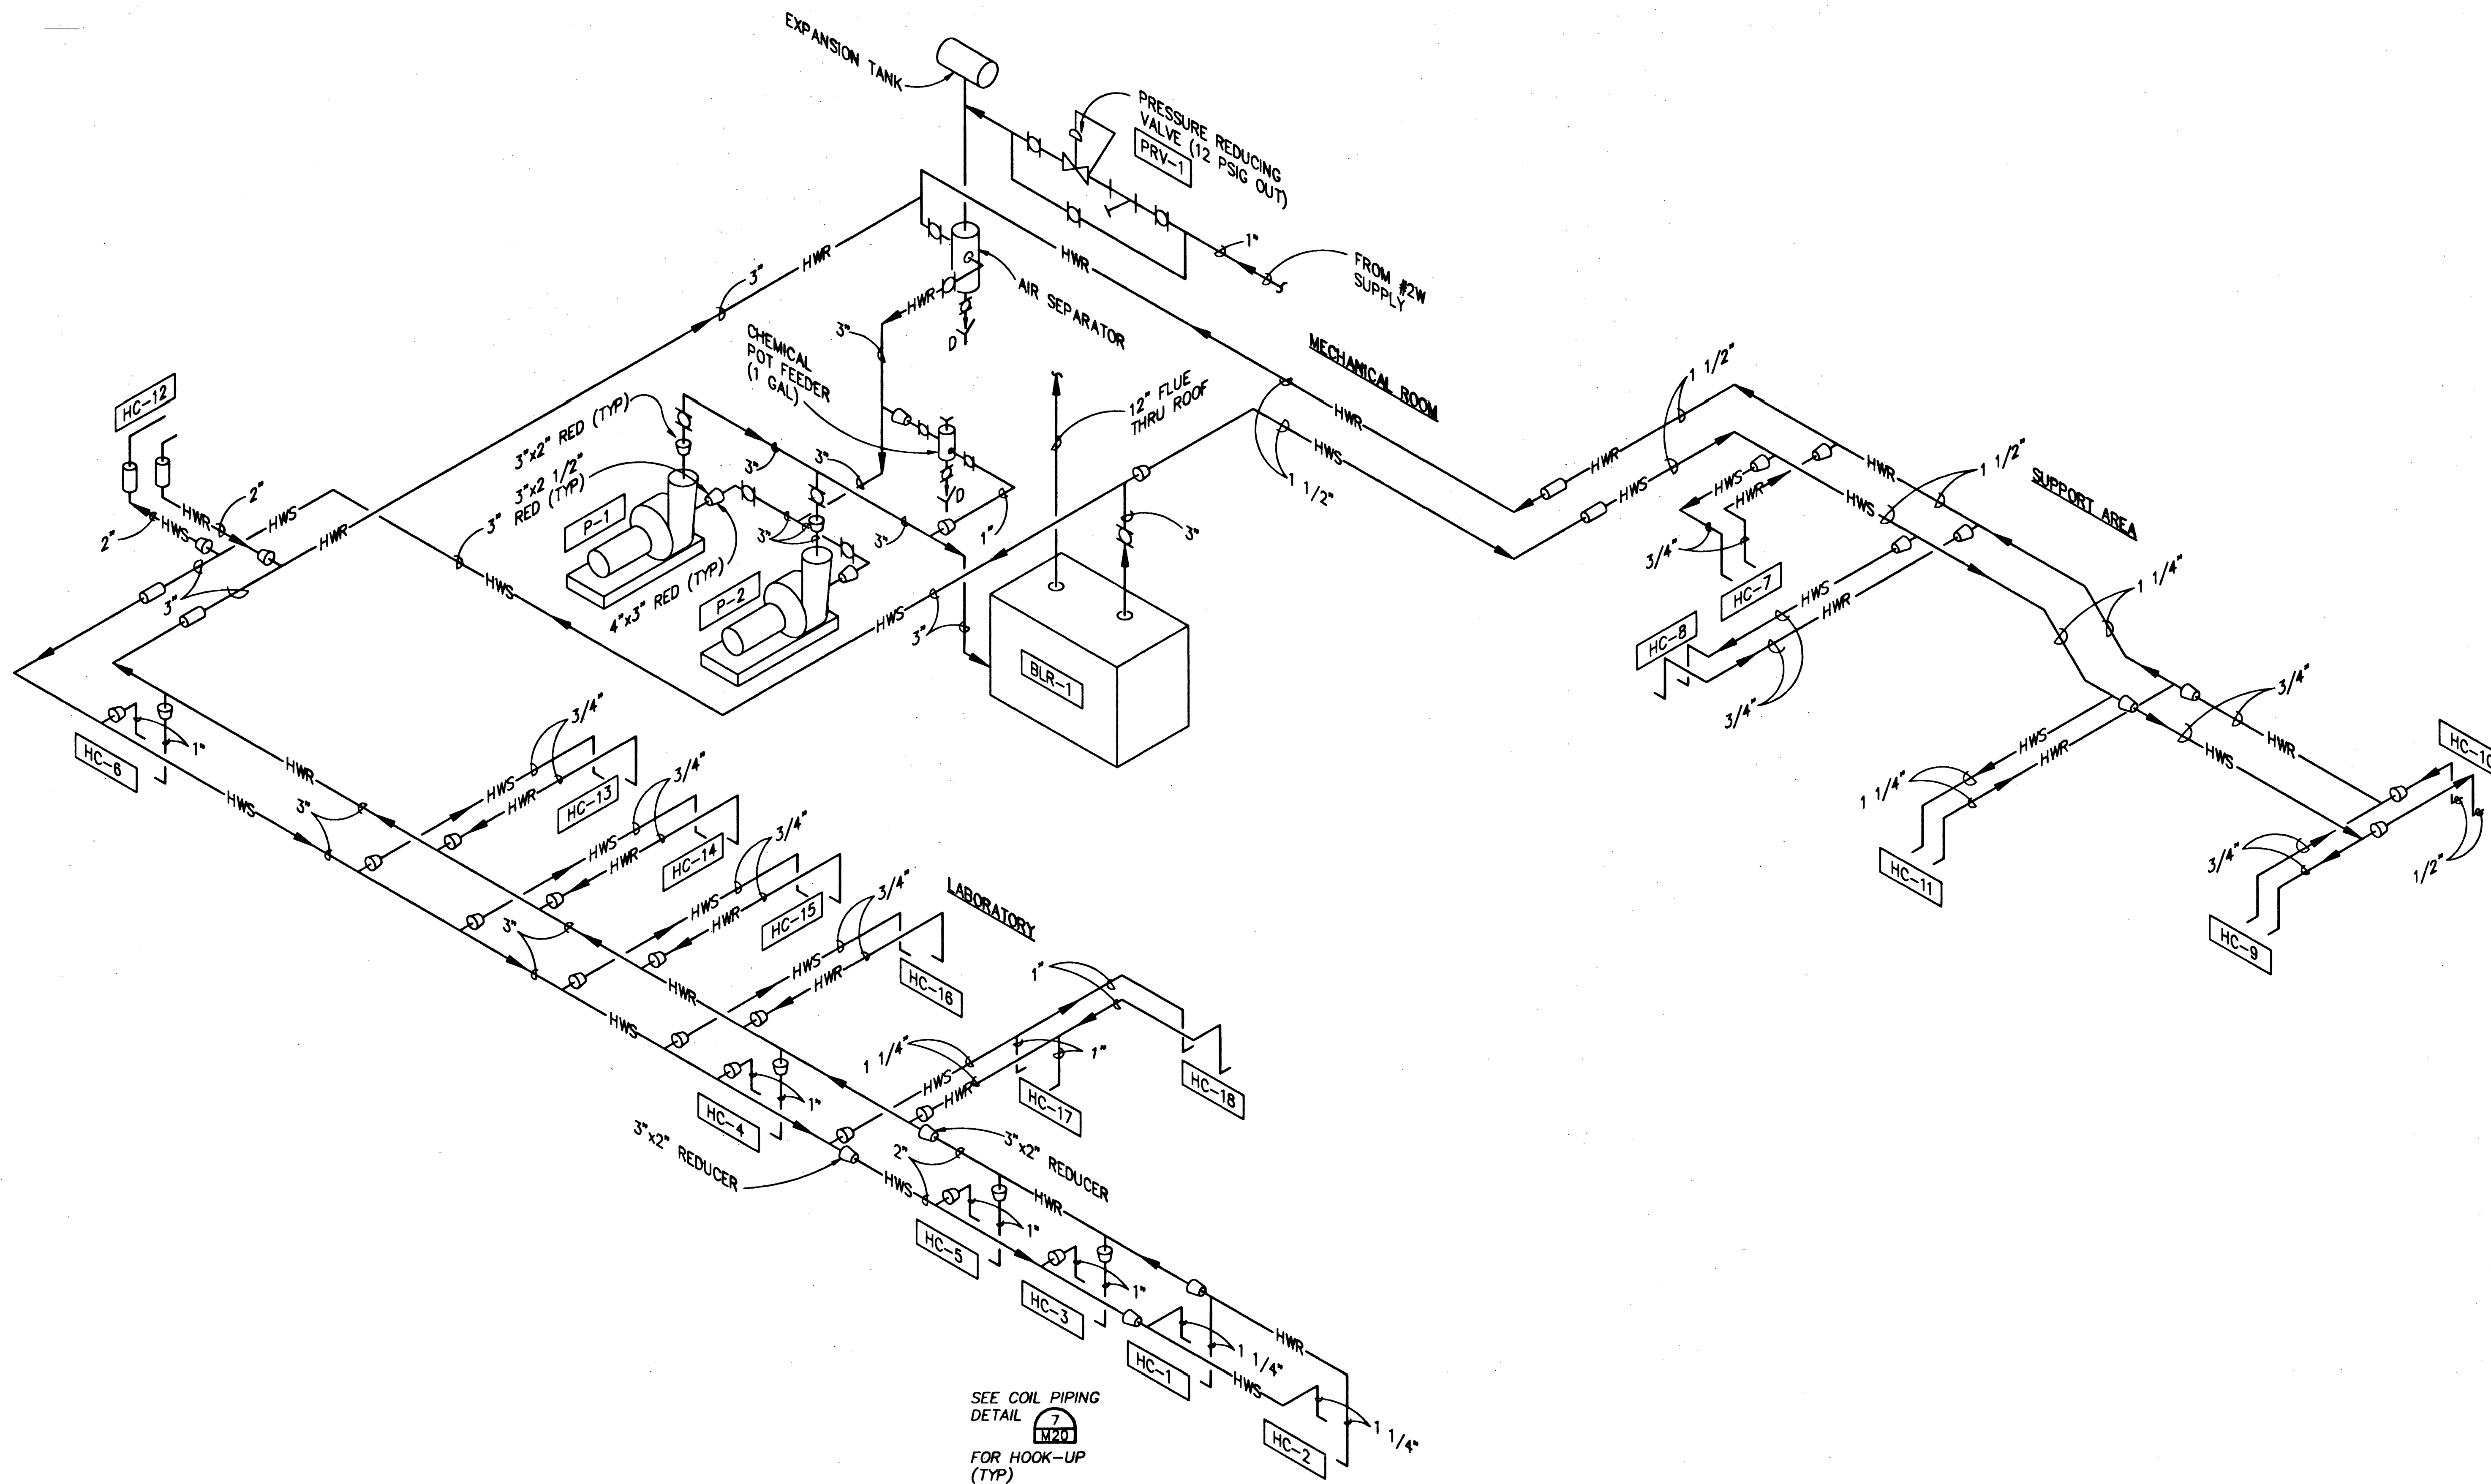

BOILER, HOT WATER SCHEMATIC (HWS, HWR)



HDR Engineering, Inc.

Issue No.	Description	Date	Drawn	Checked	Reviewed	Approved
8	CORRECTED ACCORDING TO RECORD DRAWINGS	10/2/92				
7	ISSUED FOR CONSTRUCTION	11/27/91	RL	MJH	PSC	DAP

Project Manager DAVID A. PIVETTI	Architect TK/PSC
Civil TK/PSC	Mechanical TK/PSC
Electrical TK/PSC	Structural TK/PSC
Drawn By R. LIVINGSTON	

City of Las Vegas
**Water Pollution Control Facility
 Nitrification / Filtration Facilities**
**Contract 14
 LABORATORY**

**LABORATORY
 PLUMBING SCHEMATICS**

Date OCTOBER 1992	Project No. 00120-081-141	Drawing No. M-12 3/11/95	Issue 8
Scale NONE			

30697

