


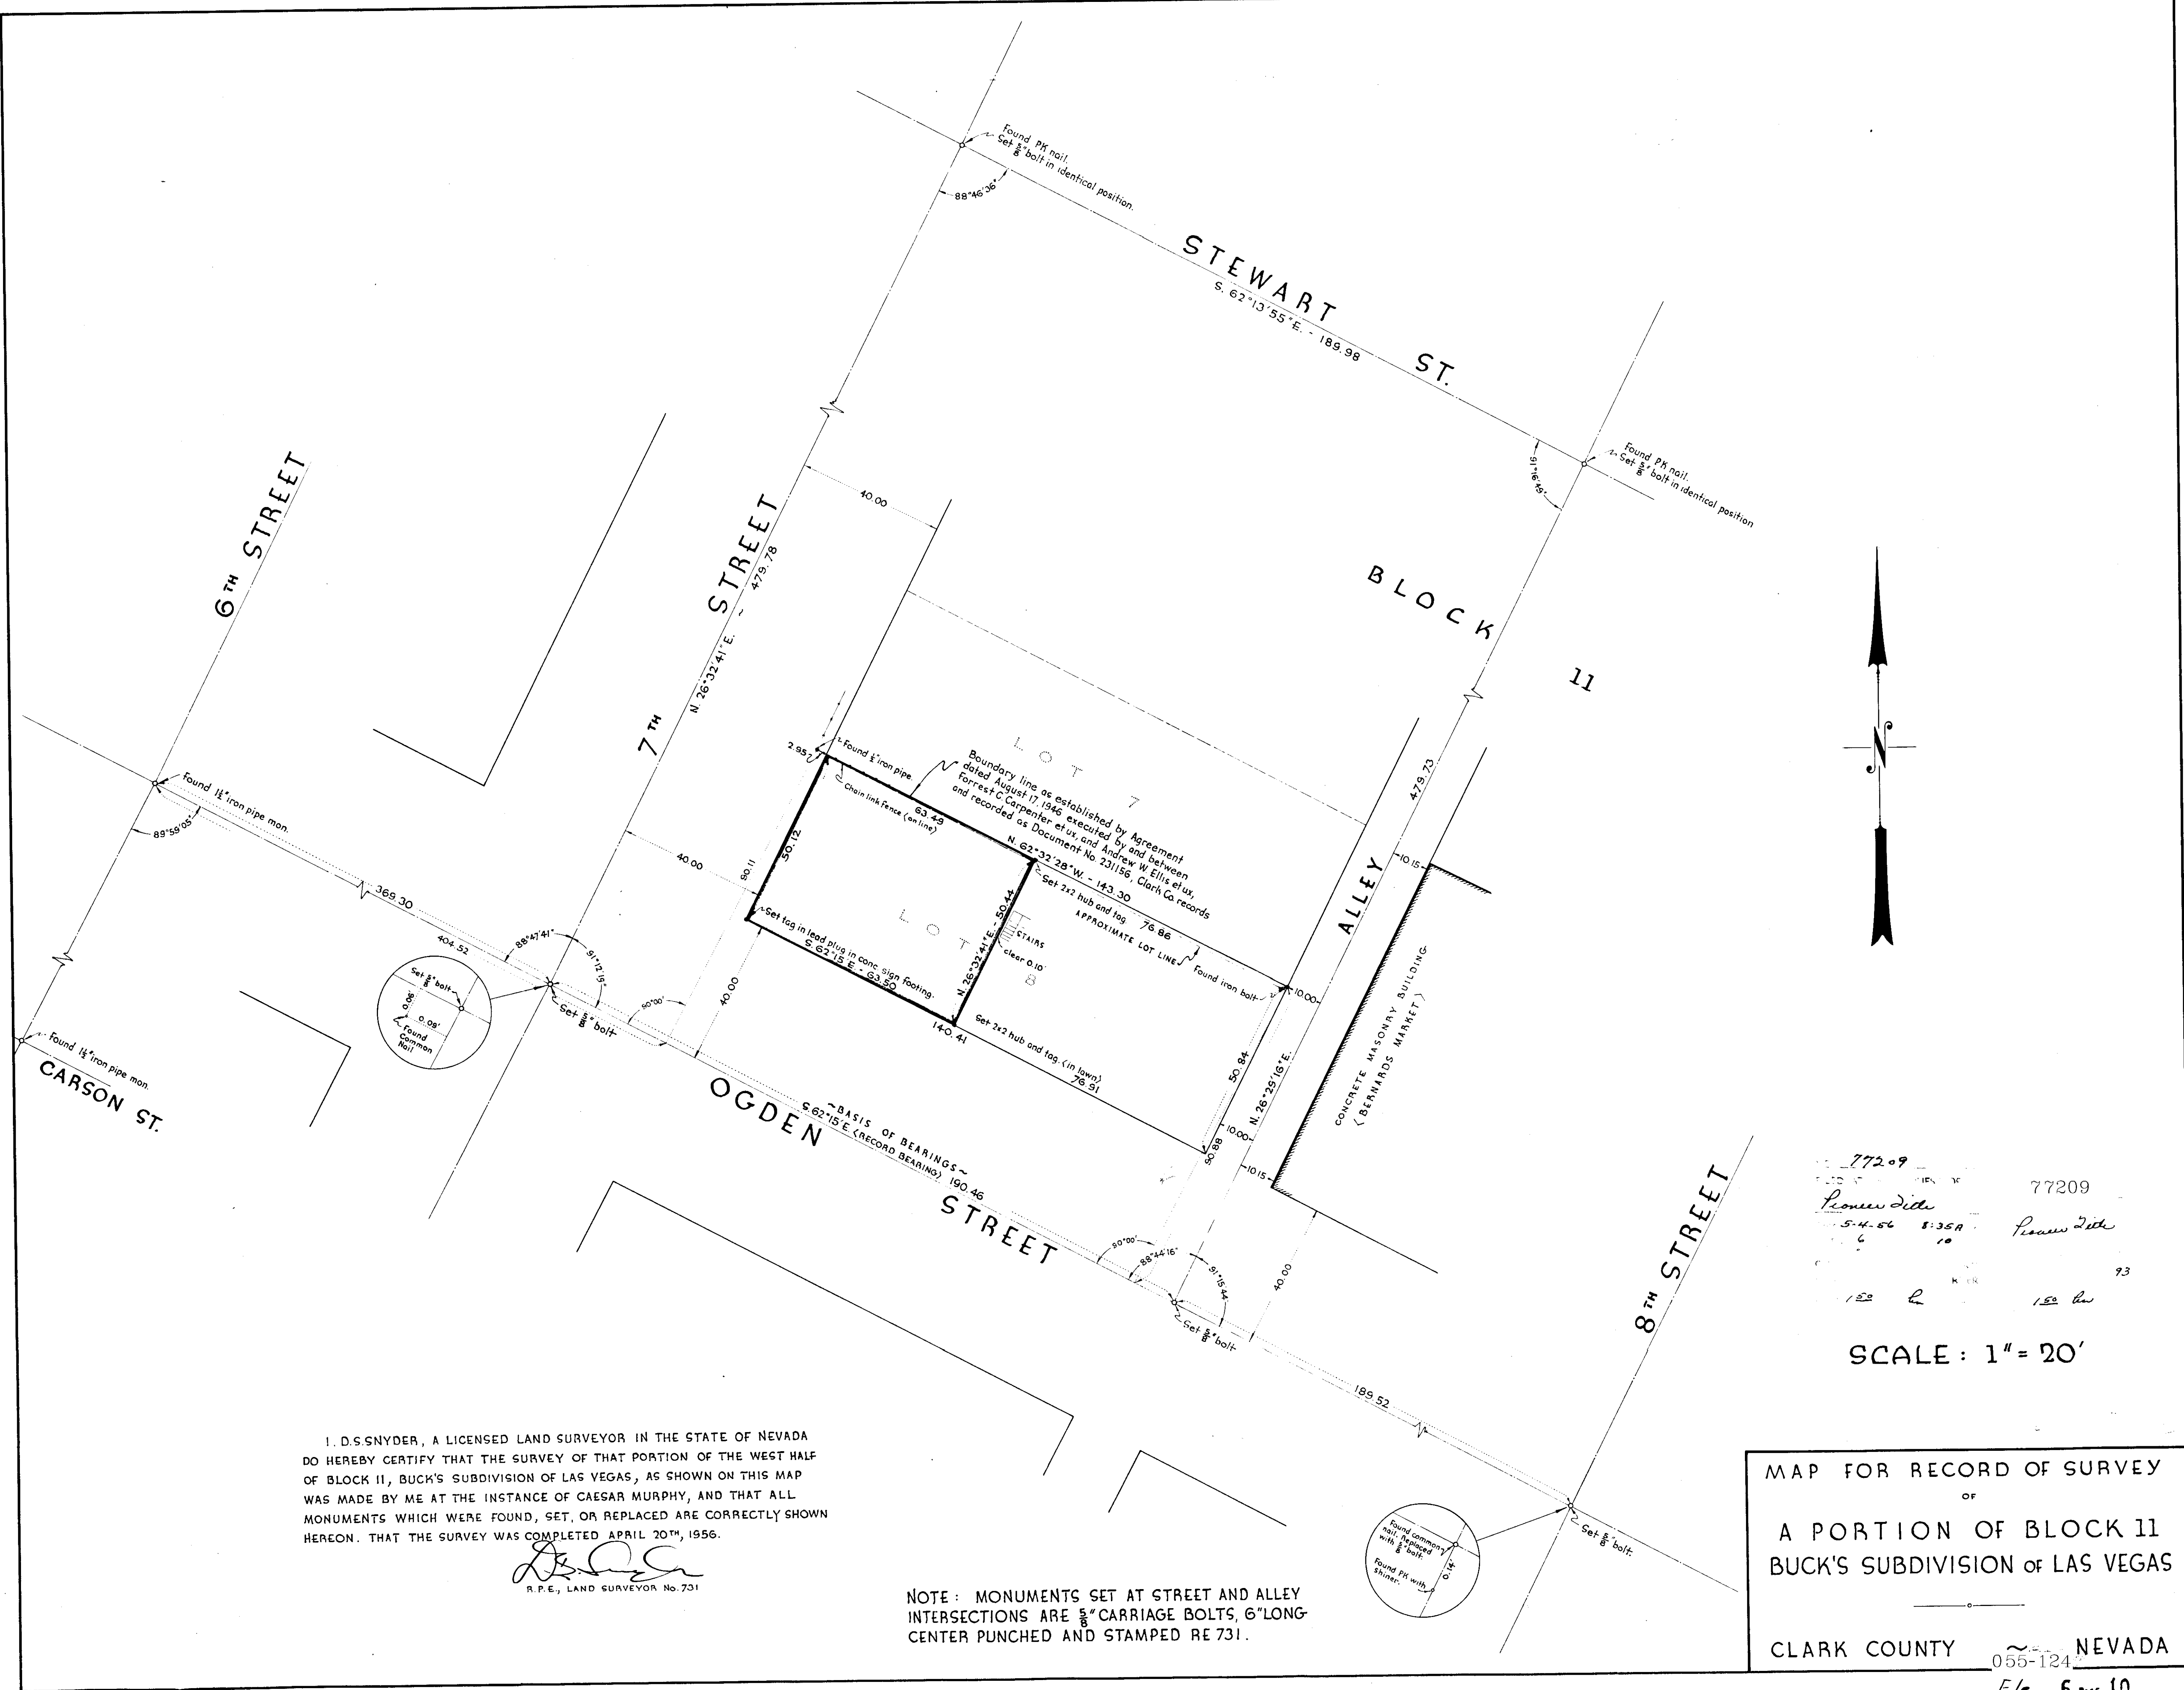

I, D.S. SNYDER, A LICENSED LAND SURVEYOR IN THE STATE OF NEVADA DO HEREBY CERTIFY THAT THE SURVEY OF THAT PORTION OF THE WEST HALF OF BLOCK 11, BUCK'S SUBDIVISION OF LAS VEGAS, AS SHOWN ON THIS MAP WAS MADE BY ME AT THE INSTANCE OF CAESAR MURPHY, AND THAT ALL MONUMENTS WHICH WERE FOUND, SET, OR REPLACED ARE CORRECTLY SHOWN HEREON. THAT THE SURVEY WAS COMPLETED APRIL 20TH, 1956.

[Signature]
R.P.E., LAND SURVEYOR No. 731

NOTE: MONUMENTS SET AT STREET AND ALLEY INTERSECTIONS ARE 5/8" CARRIAGE BOLTS, 6" LONG-CENTER PUNCHED AND STAMPED RE 731.

77209
77209
5-4-56 8:35A
10
150
150

SCALE: 1" = 20'

MAP FOR RECORD OF SURVEY
OF
A PORTION OF BLOCK 11
BUCK'S SUBDIVISION OF LAS VEGAS

CLARK COUNTY NEVADA
055-124
F/e 6 PAGE 10