


TOP LEVEL PLAN  
SCALE 1/16" = 1'-0"

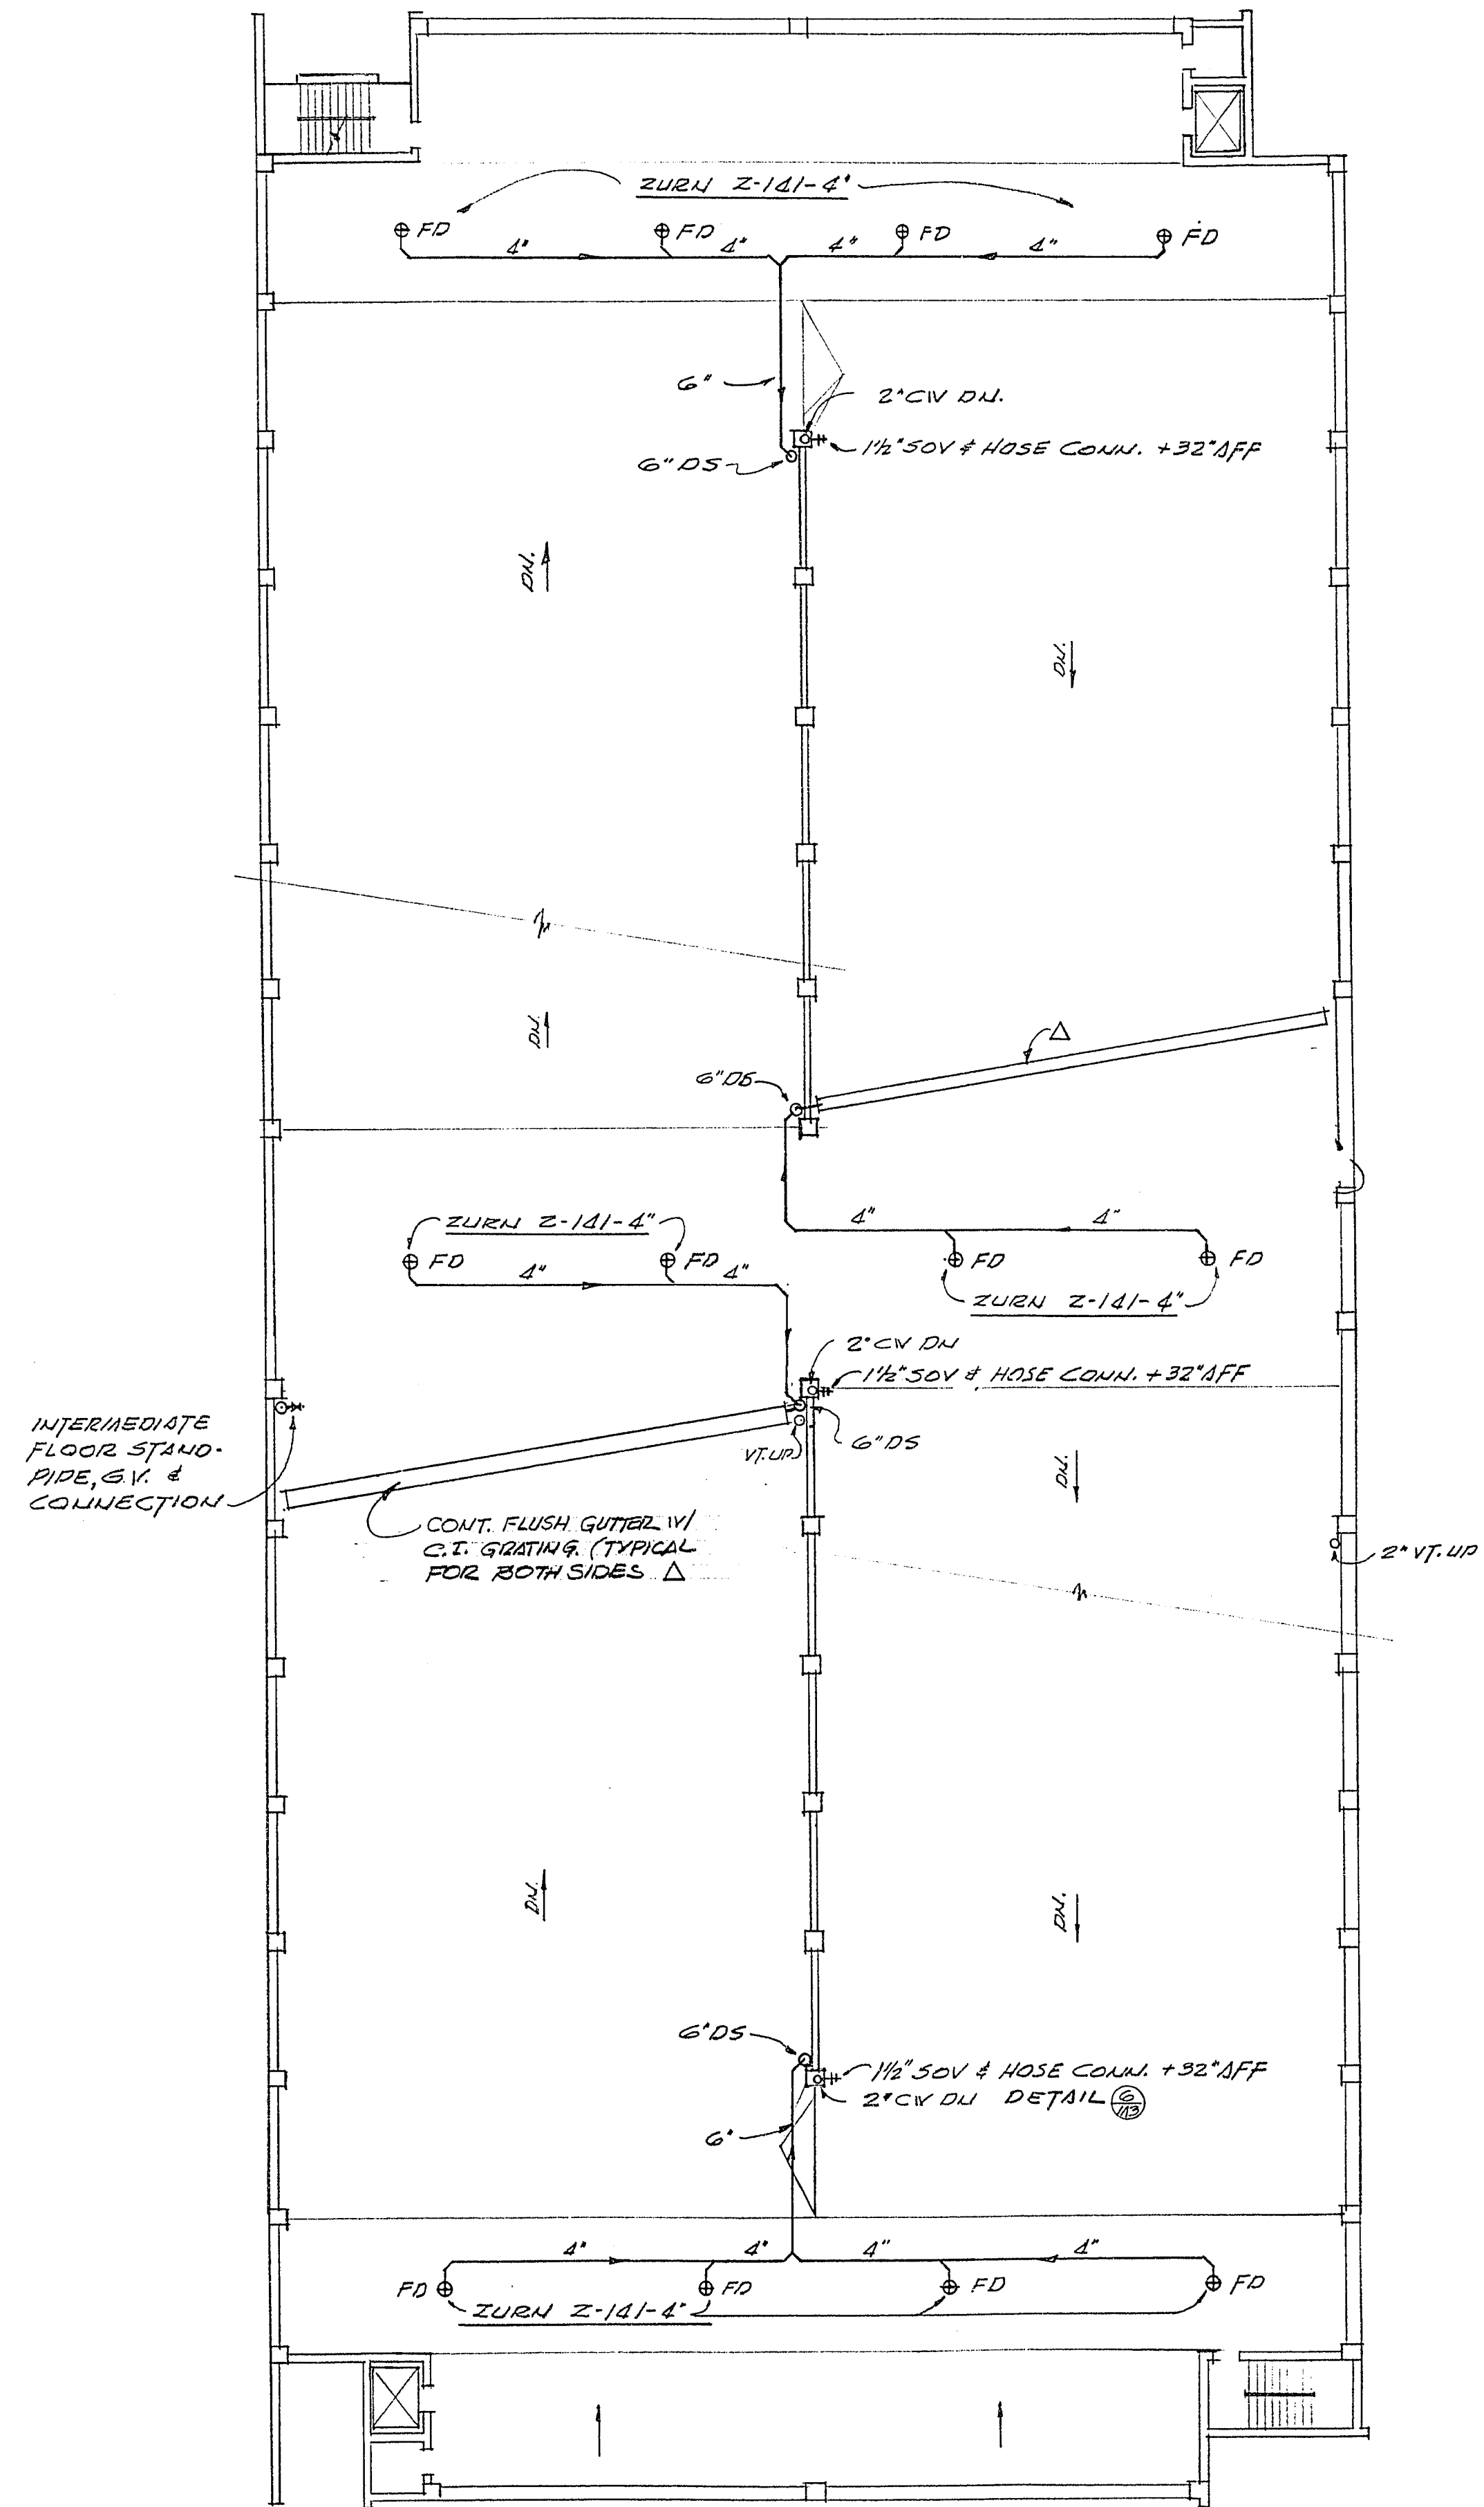

ROOF LEVELS PLAN  
SCALE 1/16" = 1'-0"

THE DESIGNS AND IDEAS INDICATED BY THESE DRAWINGS WERE CREATED FOR USE ON THIS PROJECT ONLY AND ARE THE PROPERTY OF EDWARD B. HENDRICKS ASSOC. THEY MAY NOT BE USED FOR ANY OTHER PURPOSE WHATSOEVER WITHOUT THE WRITTEN PERMISSION OF THE OFFICE OF EDWARD B. HENDRICKS ASSOCIATES.

**EDWARD B. HENDRICKS ASSOCIATES**  
ARCHITECTURE • PLANNING • ENGINEERING  
E. B. HENDRICKS A.I.A.  
FRED L. KENNEDY  
G. L. JACOBSON

537 E. SAHARA AVE.  
LAS VEGAS, NEVADA  
PHONE • 735-0902

**MUNICIPAL PARKING GARAGES**  
CITY OF LAS VEGAS  
NEVADA  
CARSON SITE

*Richard H. ...*  
DIRECTOR OF PUBLIC WORKS

TOP LEVEL PLAN &  
ROOF LEVELS PLAN

DATE 9-5-66  
JOB NO.  
DRAWN BY R.H.

SHEET M  
2

OF 4  
I.D. 25

DATE	BY	REVISIONS
2/2/67	G.J.	AS BUILT REVISIONS