

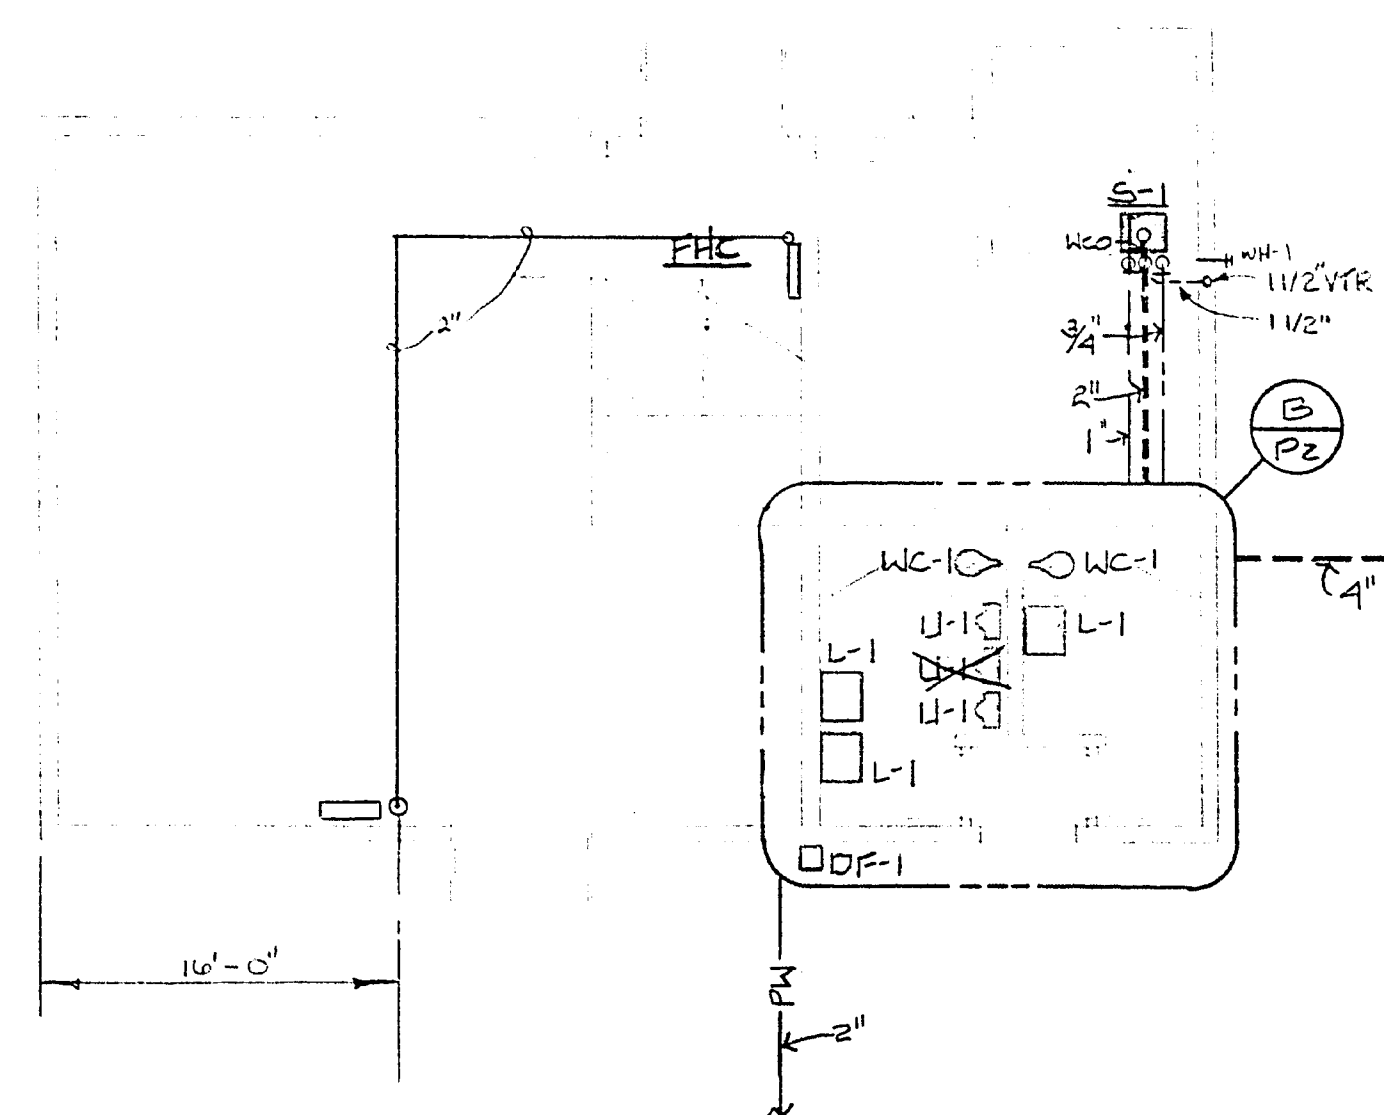


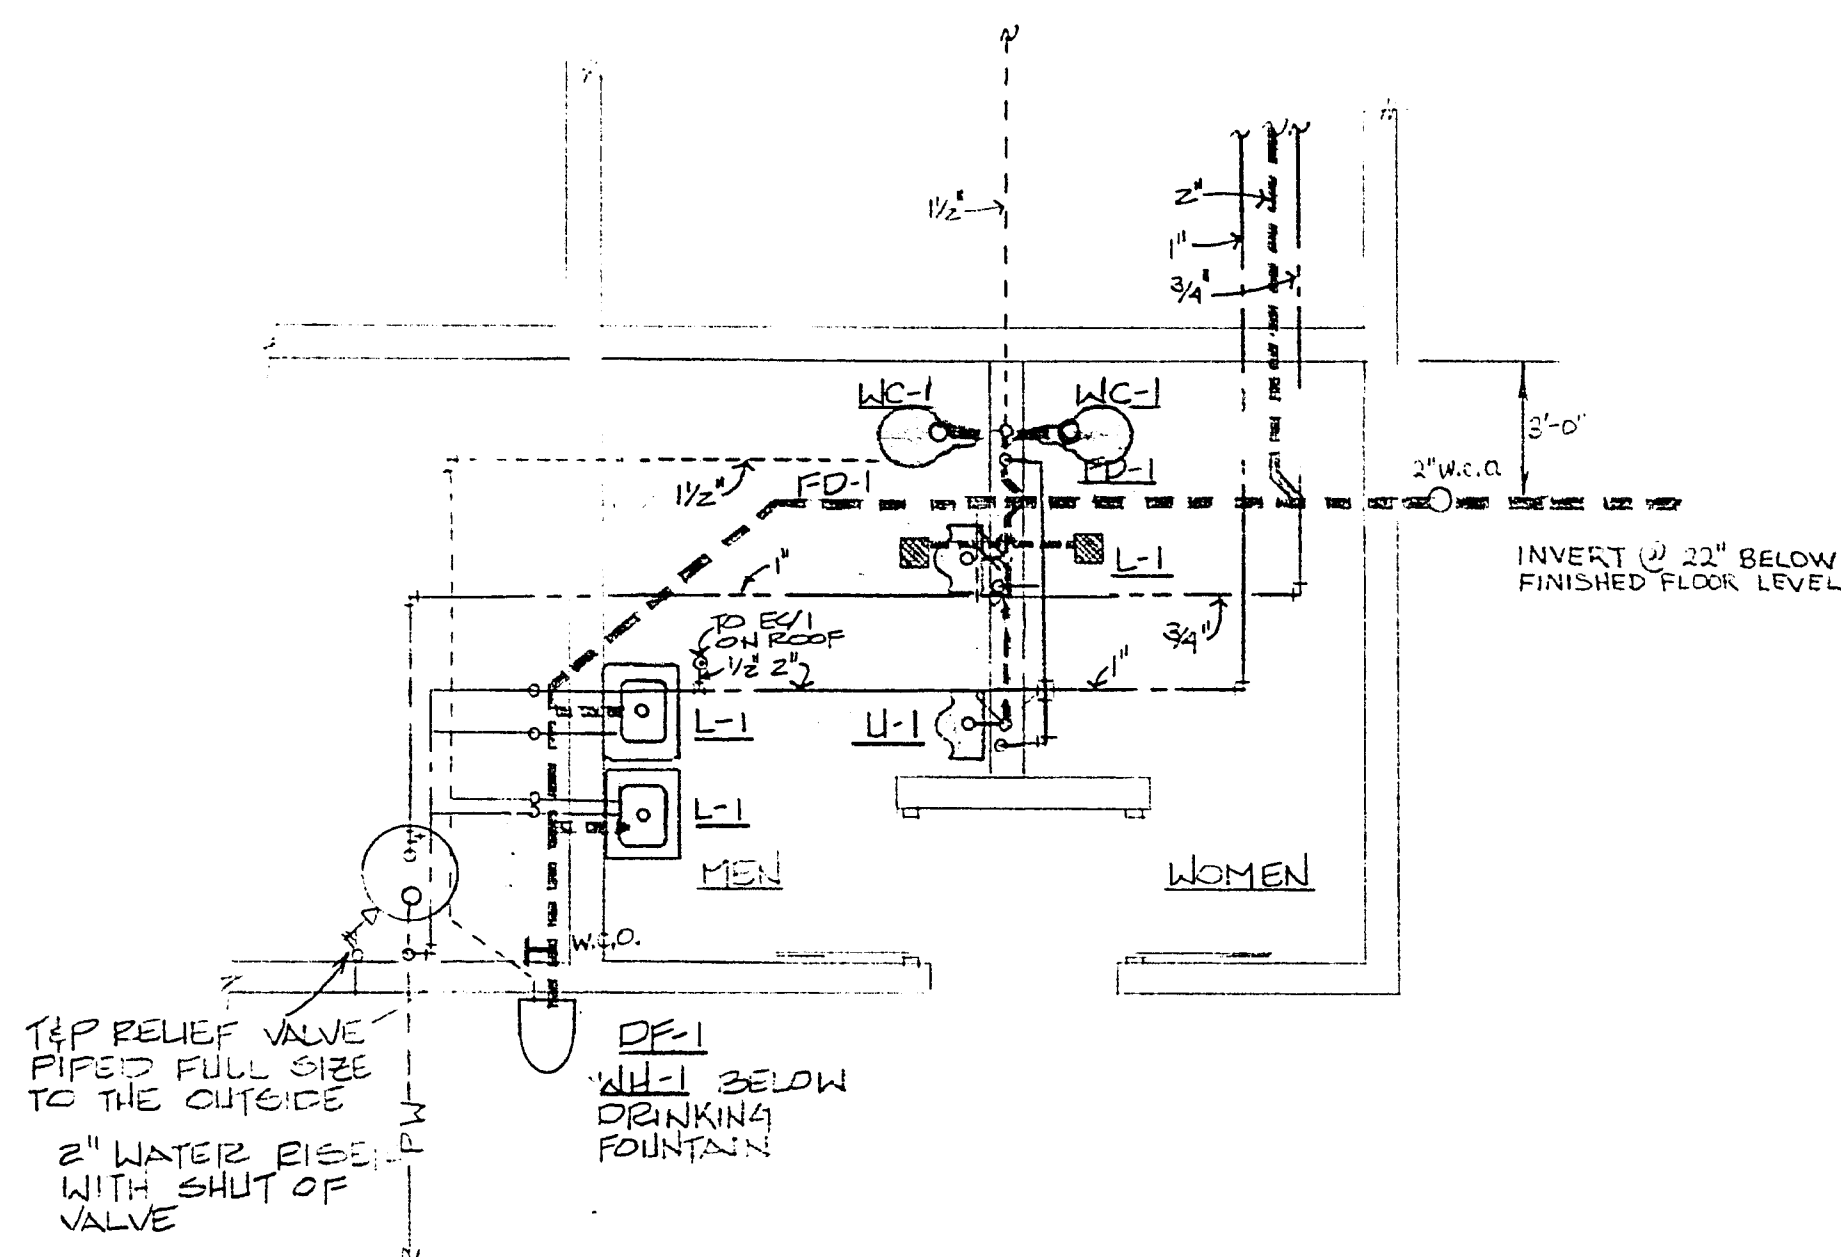



DETAIL
 $1/4" = 1'-0"$

FIRST FLOOR PLUMBING PLAN

DESIG	TYPE	MANUFACTURERS NO.	CONNECTIONS			
			C.W.	H.W.	WASTE	VENT
<u>WC-1</u>	FLOOR MOUNTED FLUSH VALVE WATER CLOSET	KOHLER "HIGHCLIFF" #K-4268-ET VITREOUS CHINA SIPHON JET ELONGATED TOILET COM- PLETE WITH K-4650 OPEN FRONT SEAT, K-4562 BOLT CAPS, SLOAN 110-3 FLUSH VALVE.	1"	--	4"	4"
<u>U-1</u>	WALL MOUNTED FLUSH VALVE URINAL	KOHLER "STANWELL" #K-4970-T VITREOUS CHINA BLOWOUT ACTION URINAL COMPLETE WITH SLOAN 180 FLUSH VALVE, J.R. SMITH FIG. 637 SUPPORT.	3/4"	--	1-1/2"	1-1/2"
<u>L-1</u>	20" X 18" WALL MTD. LAVATORY	KOHLER "GREENWICH" #K-2032 VITREOUS CHINA LAVATORY COMPLETE WITH K-7408-T "TRITON II" FAUCET, K-7607 ANGLE SUPPLY, K-9000 P-TRAP. J.R. SMITH FIG. 700 SUPPORT.	1/2"	1/2"	1-1/2"	1-1/2"
<u>DF-1</u>	WALL MOUNTED HANDICAPPED DRINKING FOUNTAIN	HAWS MODEL #1118 STAINLESS STEEL DRINKING FOUNTAIN COMPLETE WITH SCREWDRIVER STOP; TWO LEVER HANDLES.	1/2"	--	1-1/2"	1-1/2"
<u>S-1</u>	19-1/2" X 16" WALL MOUNTED STAINLESS STEEL SINK	ELKAY #CHS-1916 WASH-UP SINK COMPLETE WITH LK-66-C FAUCET WITH VACUUM BREAKER, LK-272 WASTE FITTING WITH STOPPER.	3/4"	3/4"	1-1/2"	1-1/2"
<u>WH-1</u>	FREEZELESS WALL HYDRANT	WOODFORD MODEL 20.	3/4"	--	--	--
<u>FD-1</u>	FLOOR DRAIN W/TRAP PRIMER	J.R. SMITH #2010-B WITH 2695 INLET FITTING, 2699 TRAP PRIMER	1/2"	--	2"	1-1/2"
<u>FHC</u>	SURFACE MTD. FIRE HOSE CABINET	POTTER ROEMER #1052 HOSE CABINET COM- PLETE WITH 100 FT. 1-1/2" LINEN HOSE FIG. 2960 PLASTIC NOZZLE.	2"	--	--	--
<u>HHW</u>	20 GALLON ELECTRIC WTR. HEATER	LOCHINVAR "KNIGHT SERIES" #KTA020K 1500 WATT ELEMENT, 120V/1Ø/60HZ, 6.15 GPH RECOVER AT 100 DEGREES F RISE.	1"	1"	--	--

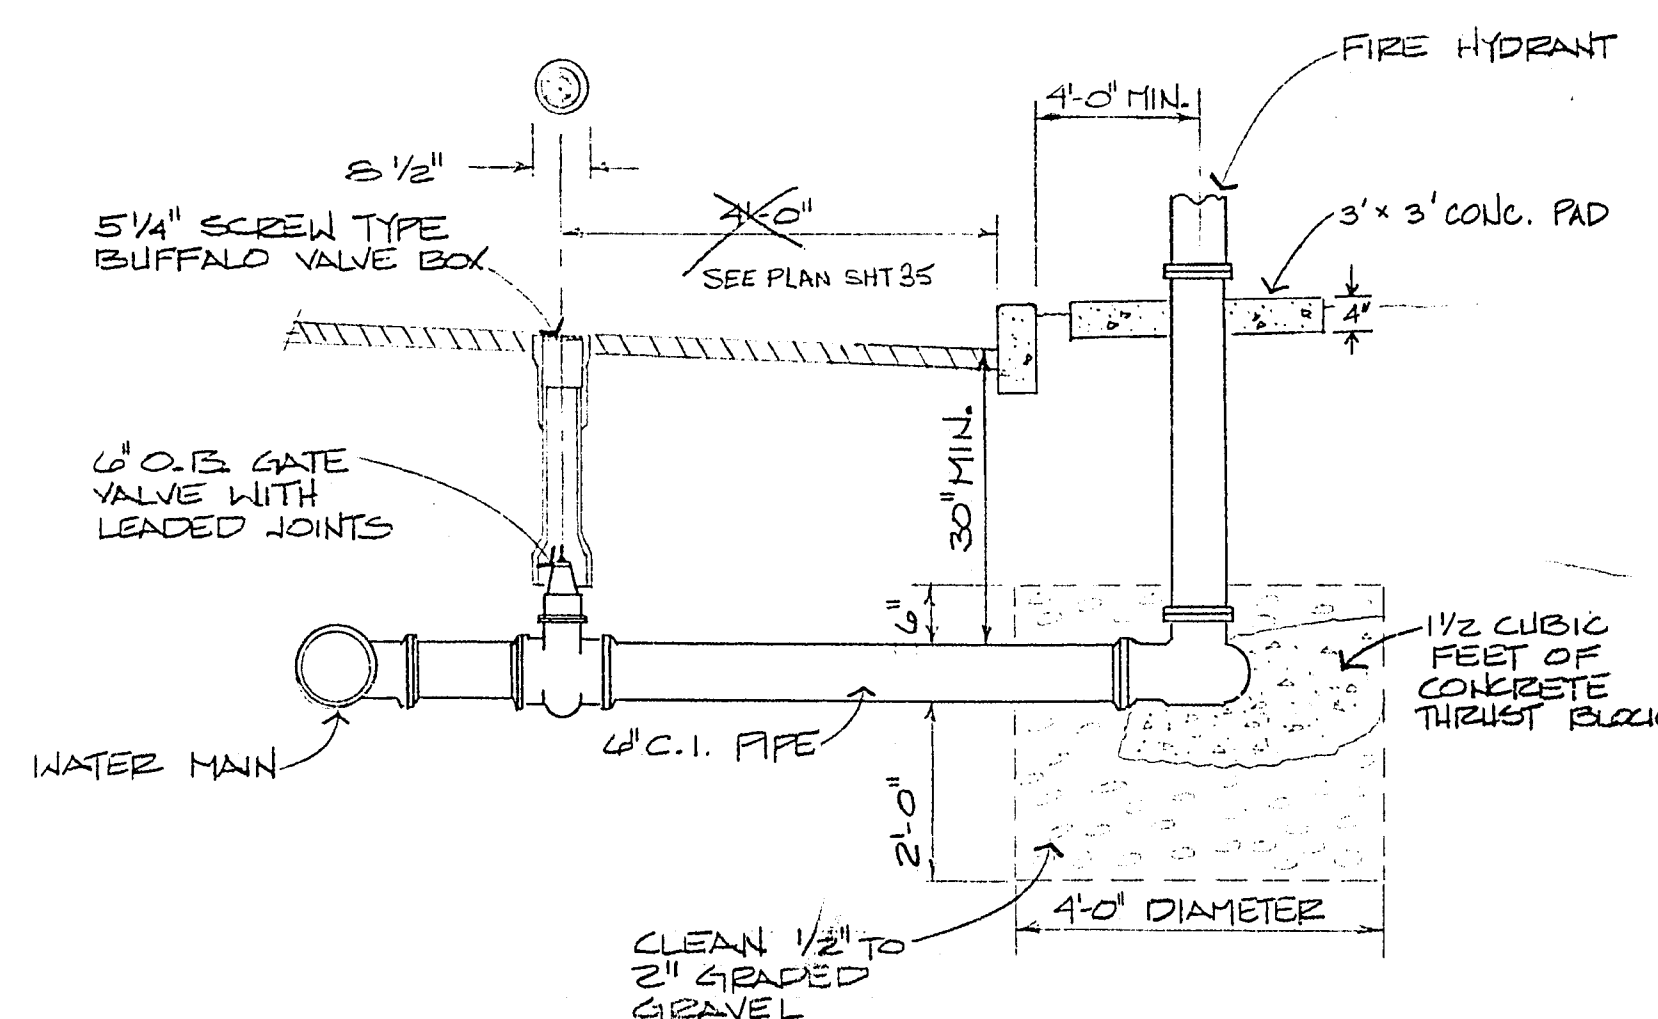

FIRE HYDRANT DETAIL

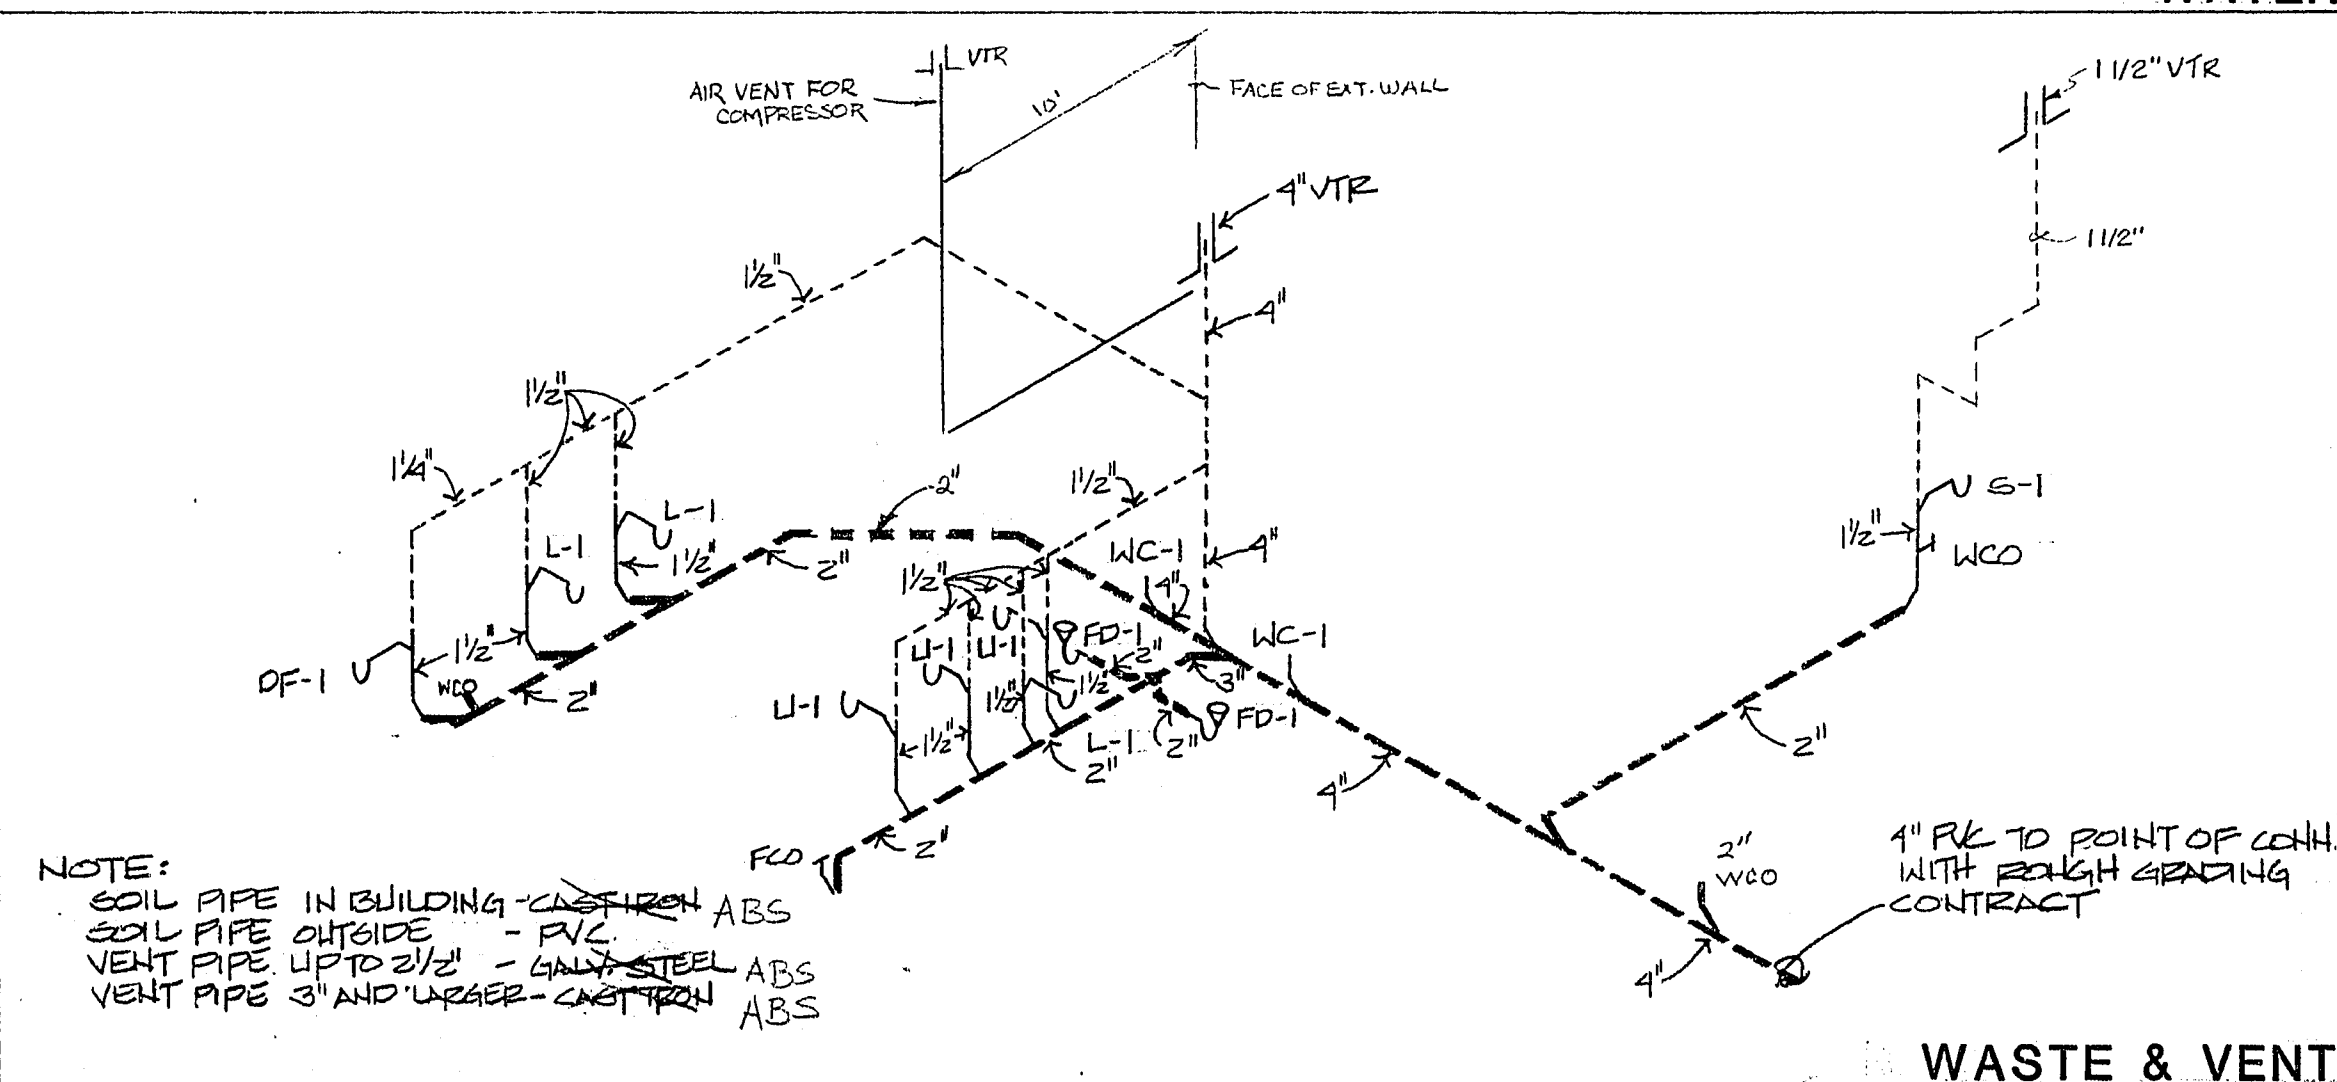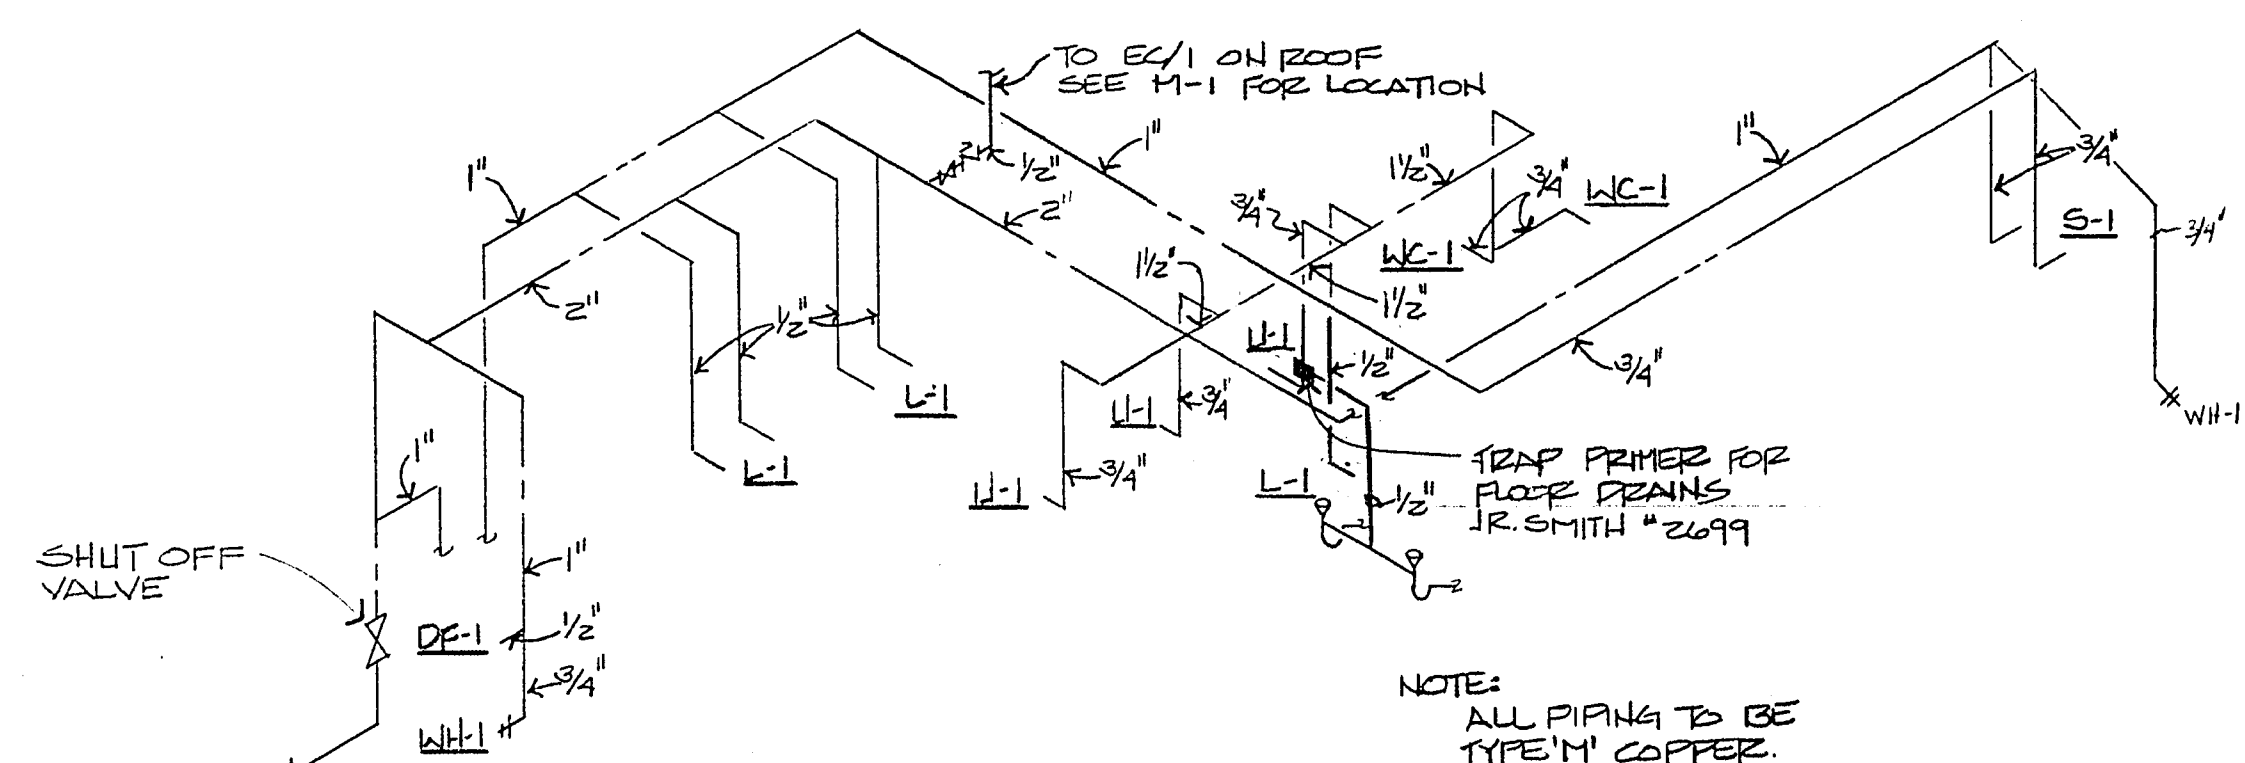

PLUMBING RISER DIAGRAMS