


HORIZONTAL SCALE 1" = 50.00'  
VERTICAL SCALE 1" = 5.00'

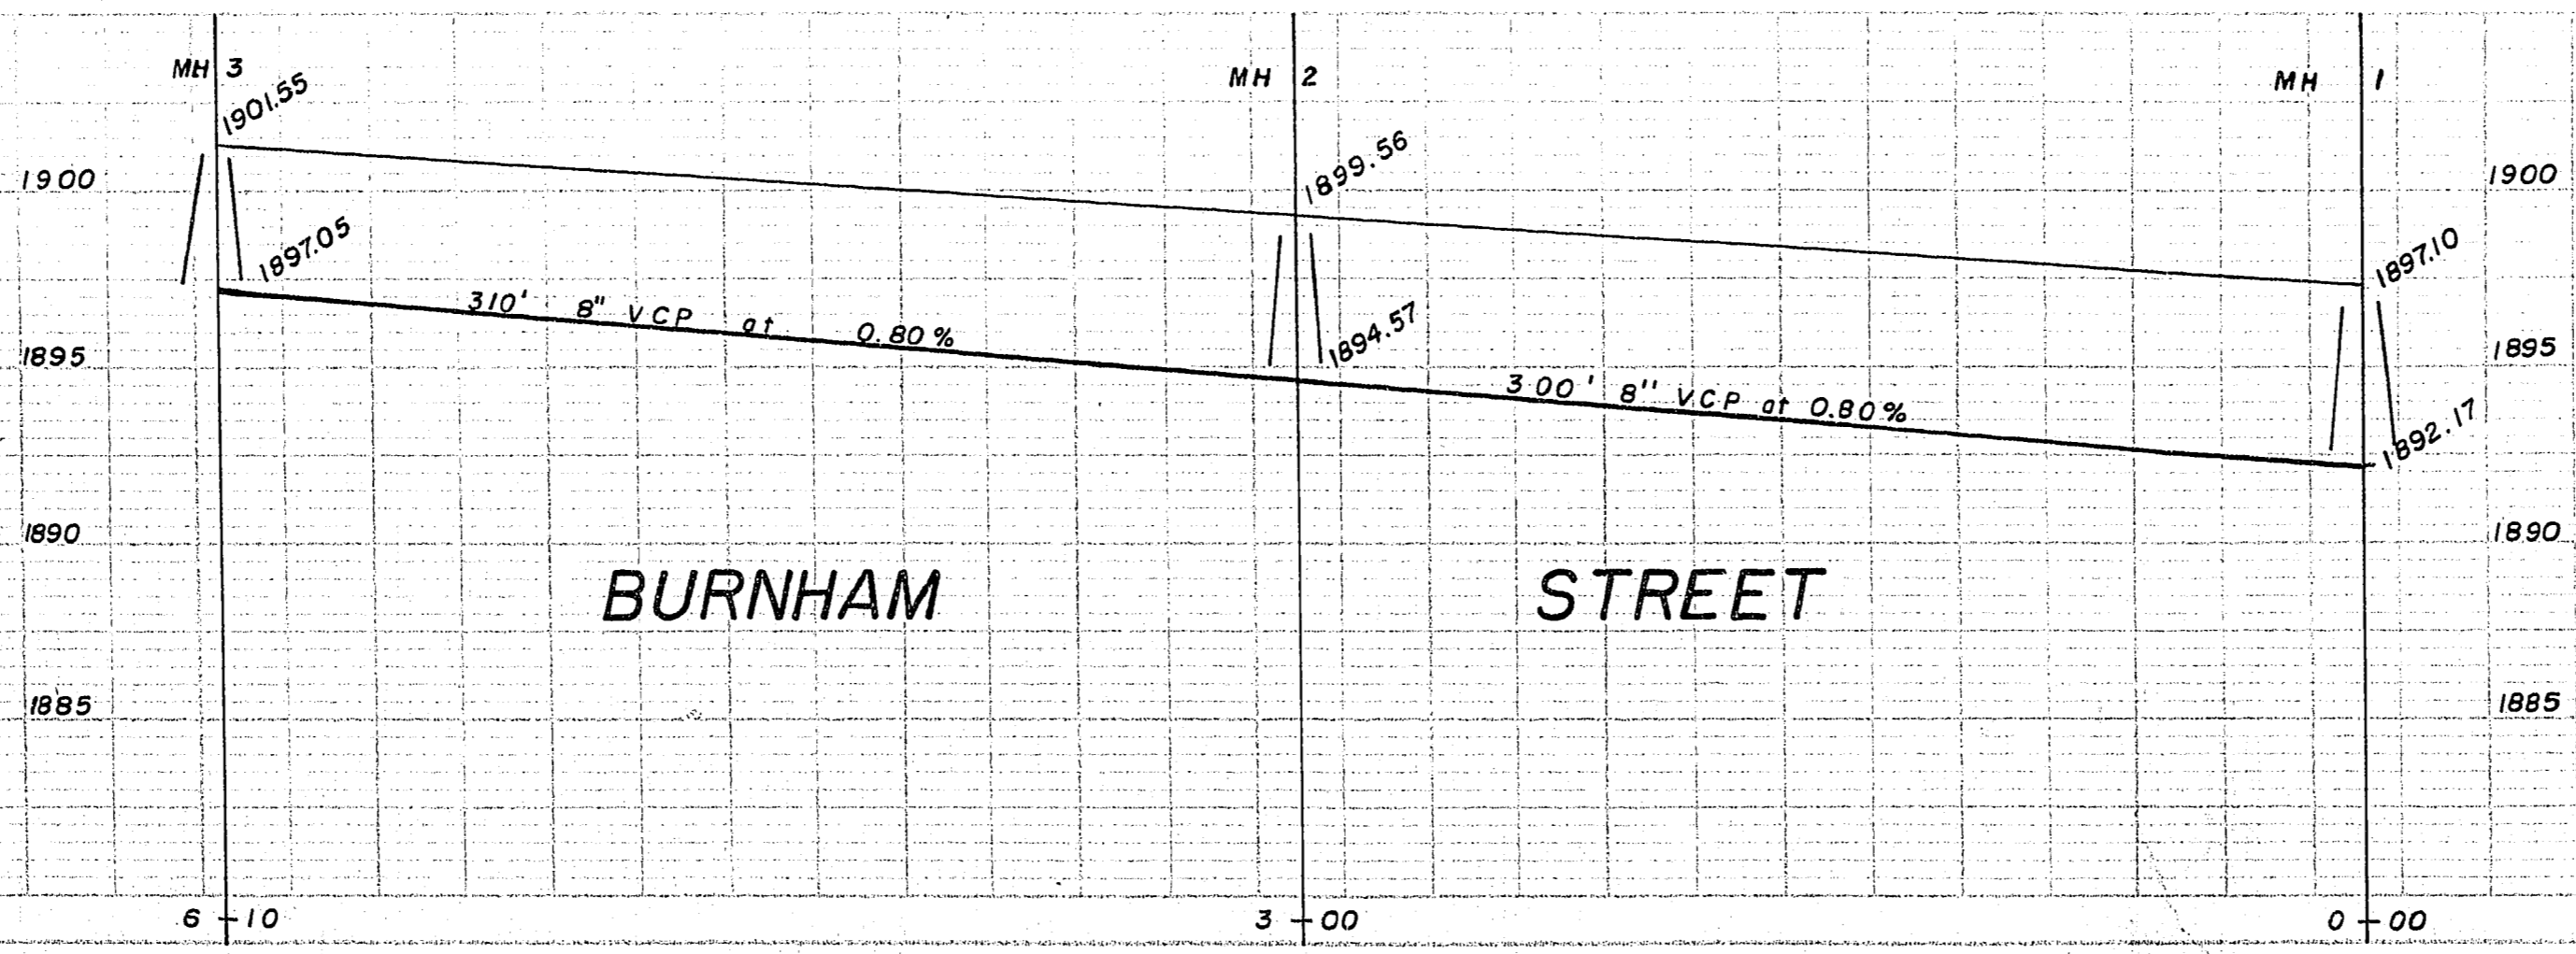

AS CONSTRUCTED SEWERS  
MOORE ADDITION  
NO. 1