
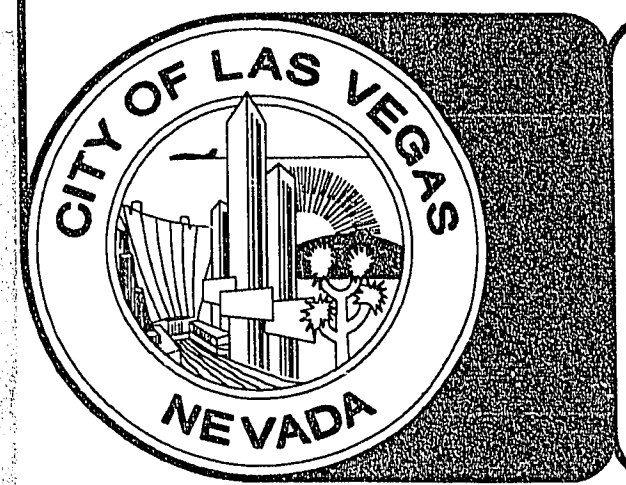



agency	approved	date
Deputy City Manager		
Director of Design & Development		
City Engineer		
Chief of Civil Engineering		
Chief of Traffic Engineering		
City Project Administrator		
Chief of Project Control		
Chief of Construction Services		
Director of General Services		
Chief of Maintenance		
Director of Parks, Recreation & Senior Activities		
Director of Public Services		
Chief of Electrical Services		
Director of Community Planning & Development		
Director of Building & Safety		
Regional Transportation Commission		
Nevada State Department of Transportation		
Central Telephone Company		
Las Vegas Valley Water District		
Nevada Power Company		
Southwest Gas		
Cable Television		

revisions				
1	AS BUILT		JAN 1995	
0	ISSUED FOR CONSTRUCTION		5/20/92	
no.	description	by	date	app.

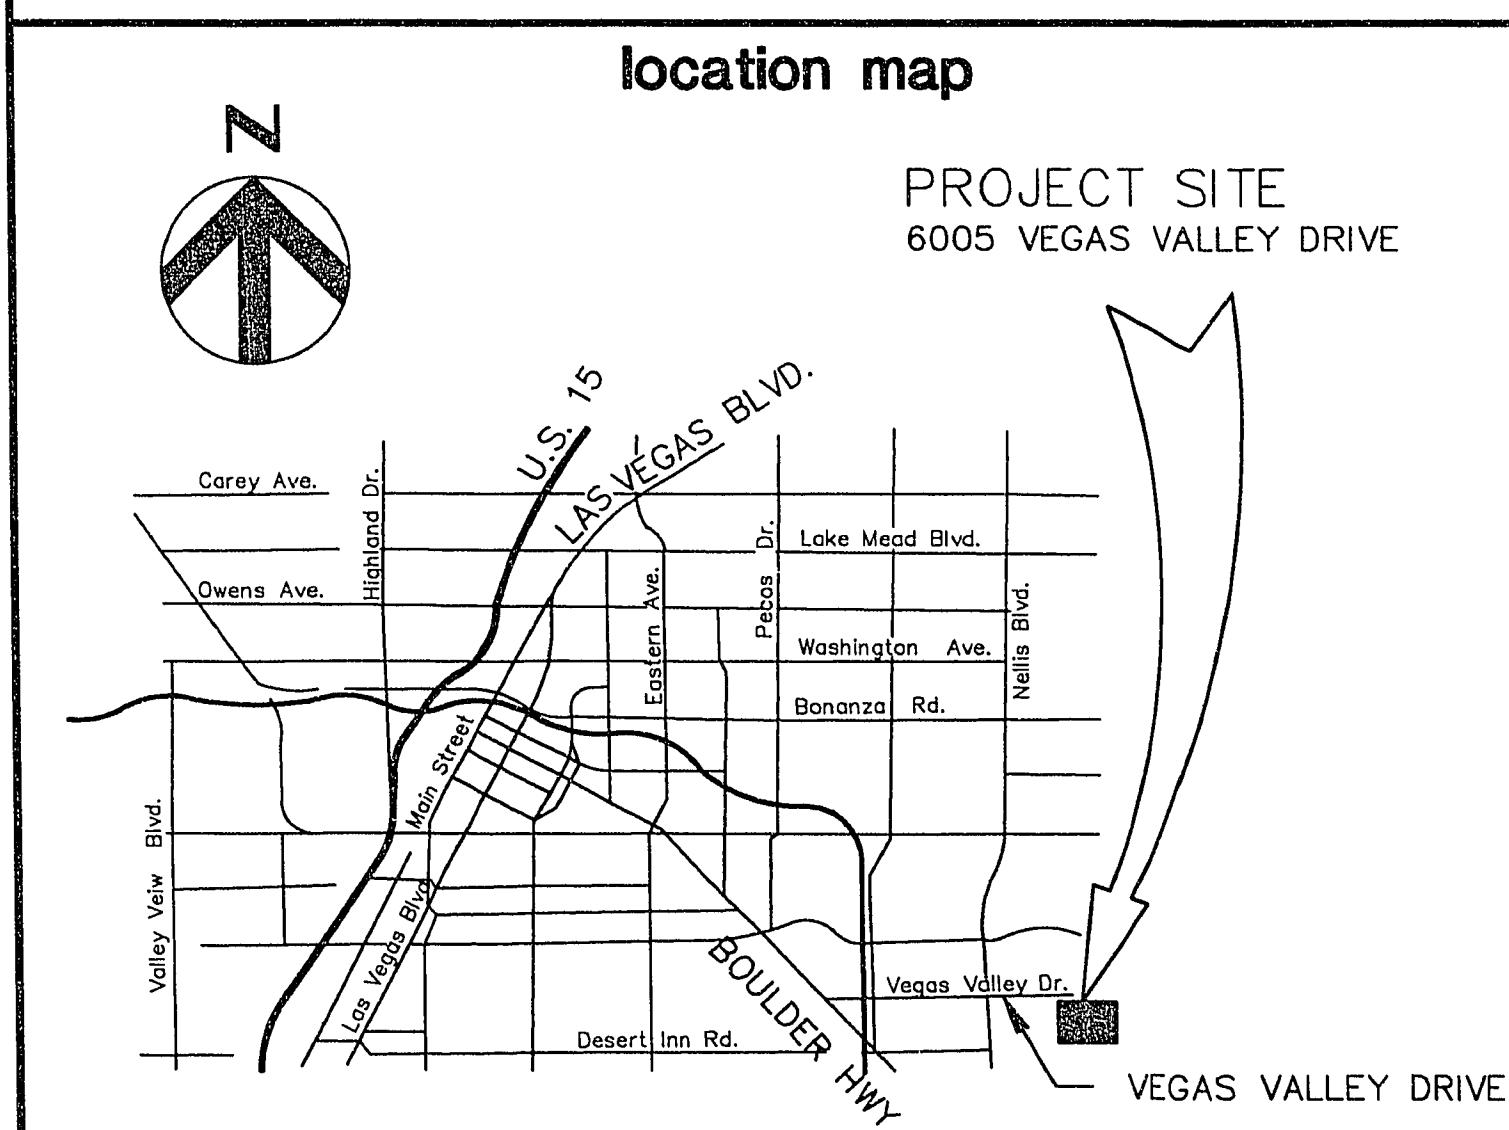

CONTRACT 17
NITRIFICATION COMPLEX

BID NO. 92.7254.17

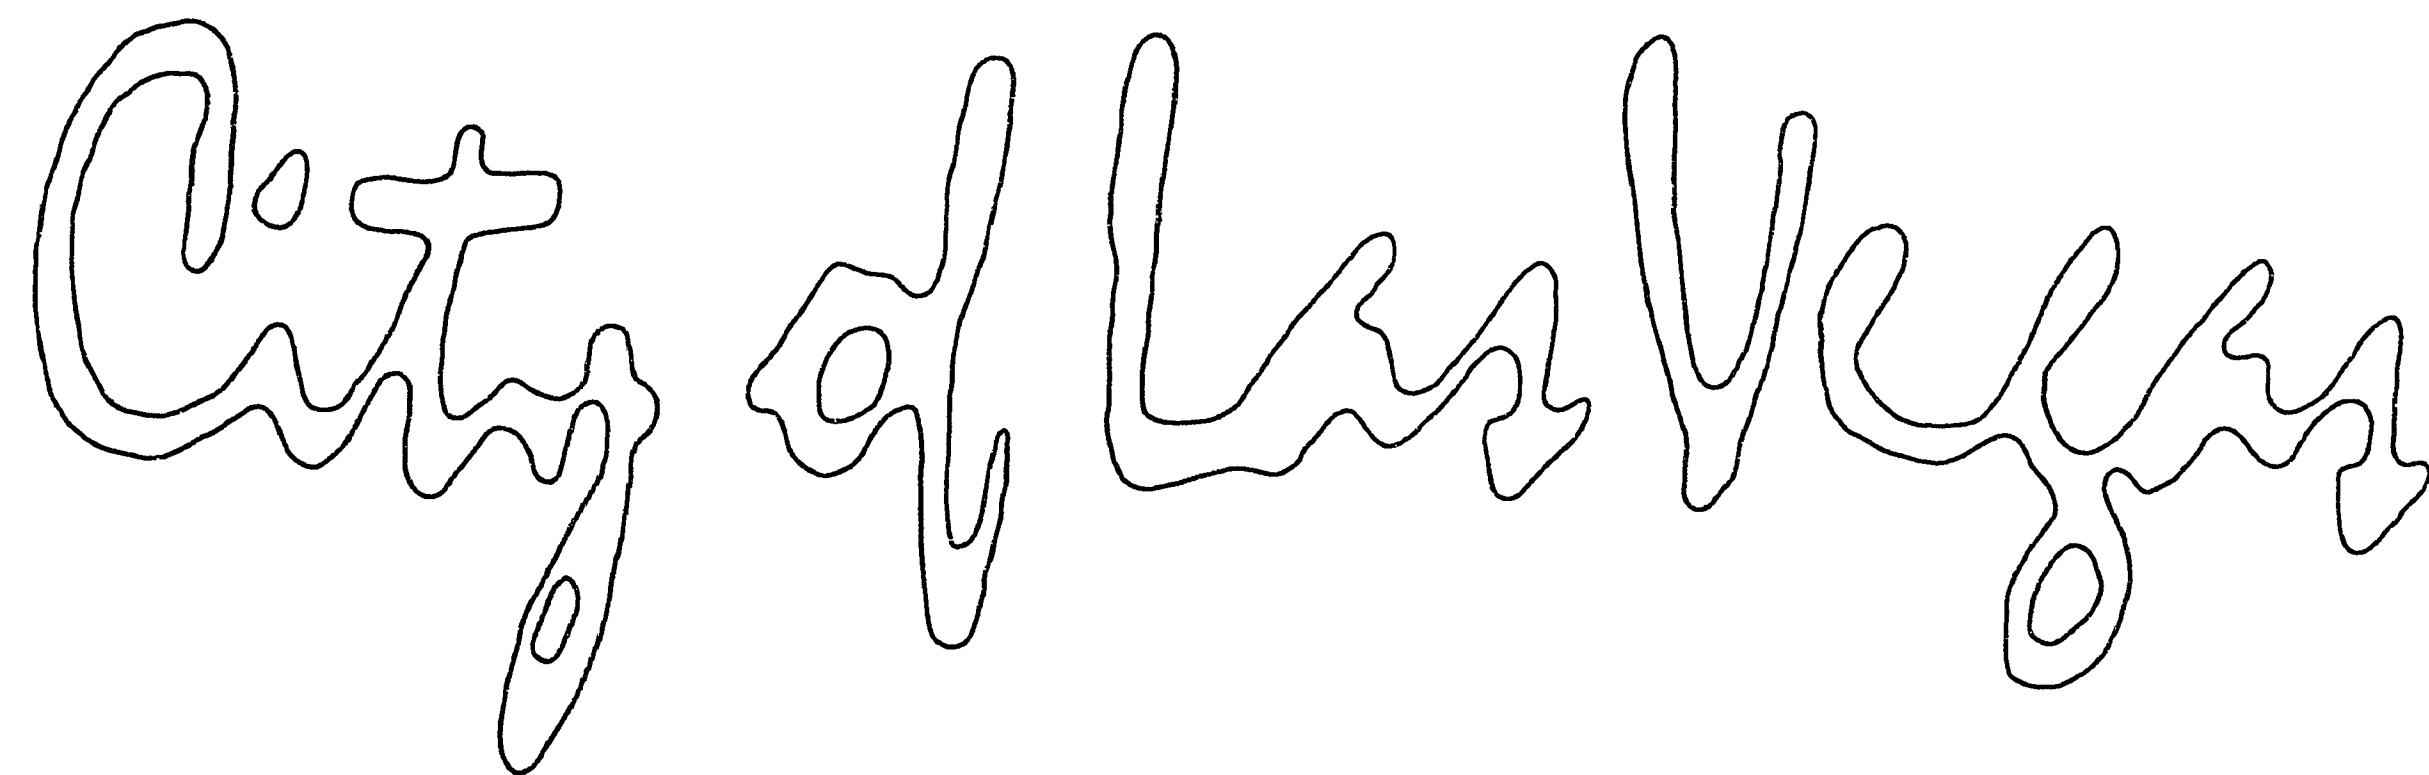

Water Pollution Control Facility

NITRIFICATION / FILTRATION FACILITIES

HDR

HDR ENGINEERING, INC.

VOLUME 2

JANUARY 1995

mayor:

Jan Laverty Jones

council members:

Arnie Adamsen
Scott Higginson
Frank Hawkins
Bob Nolen

"AS BUILT"

These drawing were corrected according to construction records.

city manager:

William Noonan

director of public works:

Richard D. Goecke

