


Revit Projects 1808001 Neon-CV-1808001 Neon Museum 2007-07-09 adam-07-13-07.mxd
7/13/2007 8:45:25 AM

126622
1E OVERALL SITE PLAN.
1" = 30'-0"

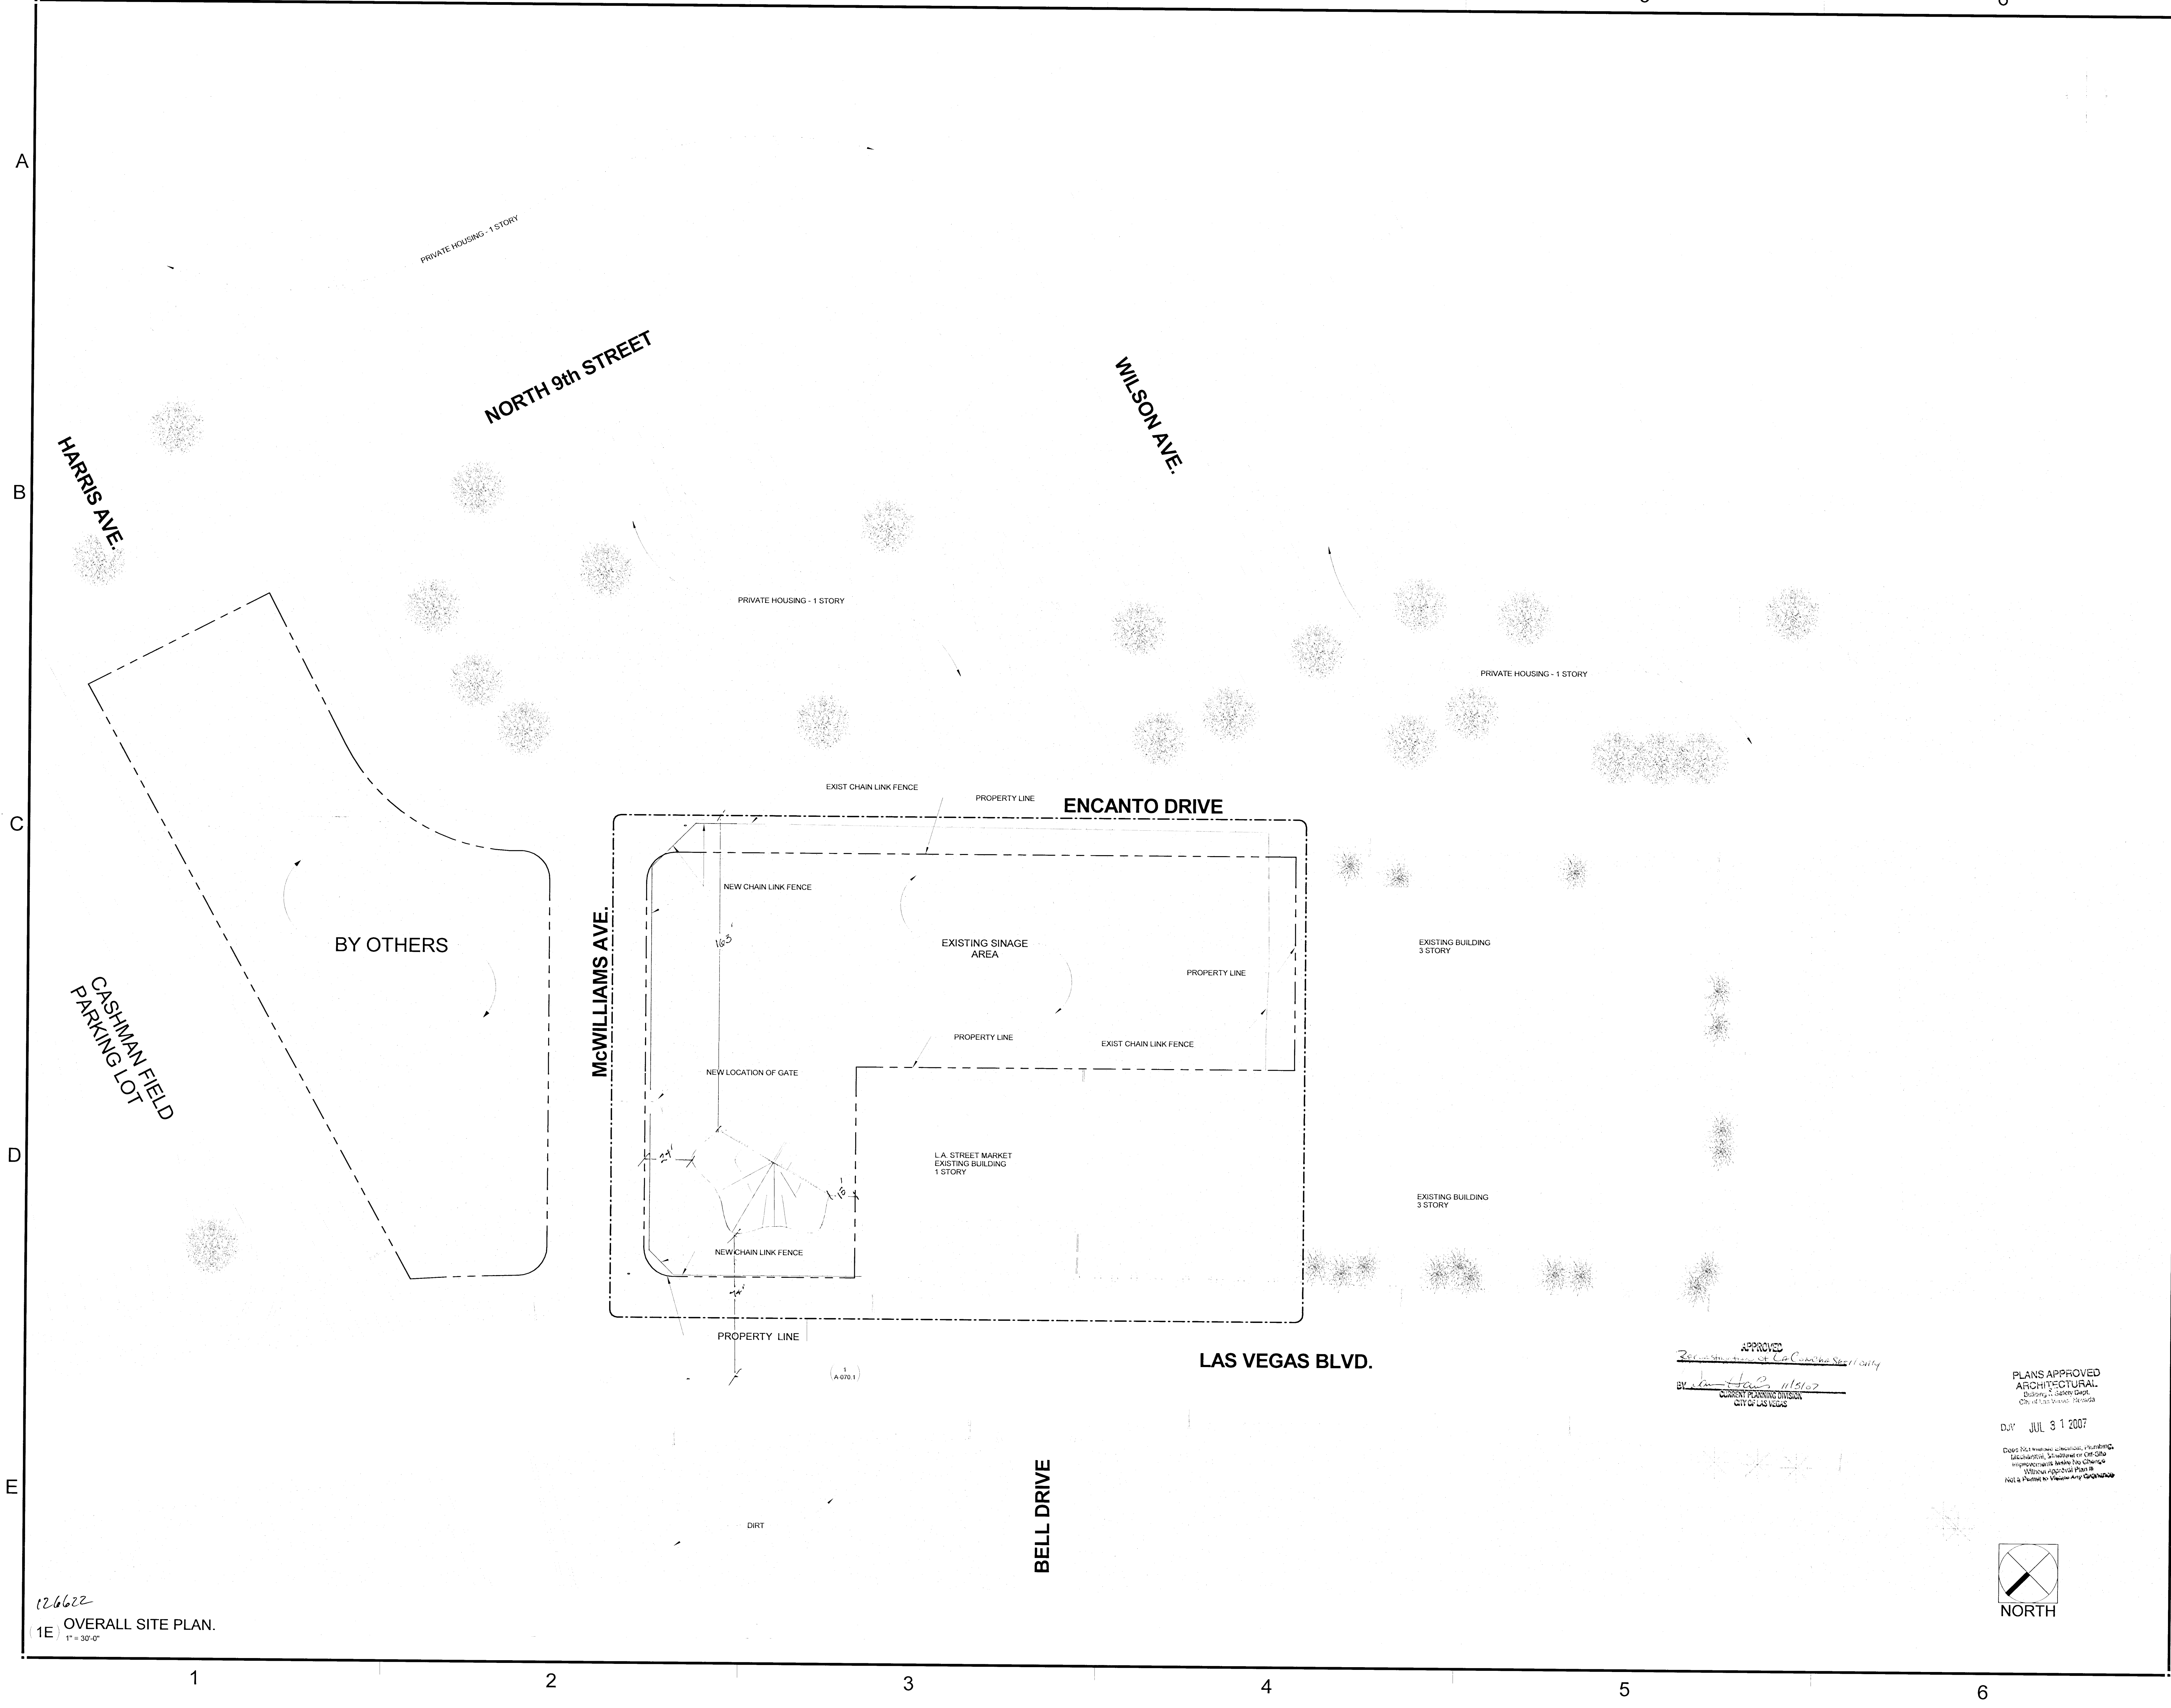

DATE	DESCRIPTION
07-13-2007	ISSUE FOR PLAN CHECK

FRIEDMUTTER GROUP
ARCHITECTURAL & DESIGN STUDIOS
HOTELS • CASINOS • RESTAURANTS • ENTERTAINMENT
1000 S. LAS VEGAS BLVD., SUITE 200
LAS VEGAS, NV 89101
TEL: 702.735.1111 FAX: 702.735.1112
WWW.FRIEDMUTTERGROUP.COM

PLANS APPROVED
ARCHITECTURAL
Drawing is hereby approved for the City of Las Vegas
CITY OF LAS VEGAS
JUL 31 2007

NEON MUSEUM and BONEYARD
770 NORTH LAS VEGAS BLVD.
LAS VEGAS, NEVADA 89101

OVERALL SITE PLAN
SHEET NUMBER
A-070.0