


DRAWING BY: COLUMBIA RIVER CADD 07-007 250 S. 4200, A.E. PORTLAND, OR 97206 503-277-6649
400 N. WHEELER, TREATMENT STATION, PORTLAND, OR 97207 503-277-1253

126632

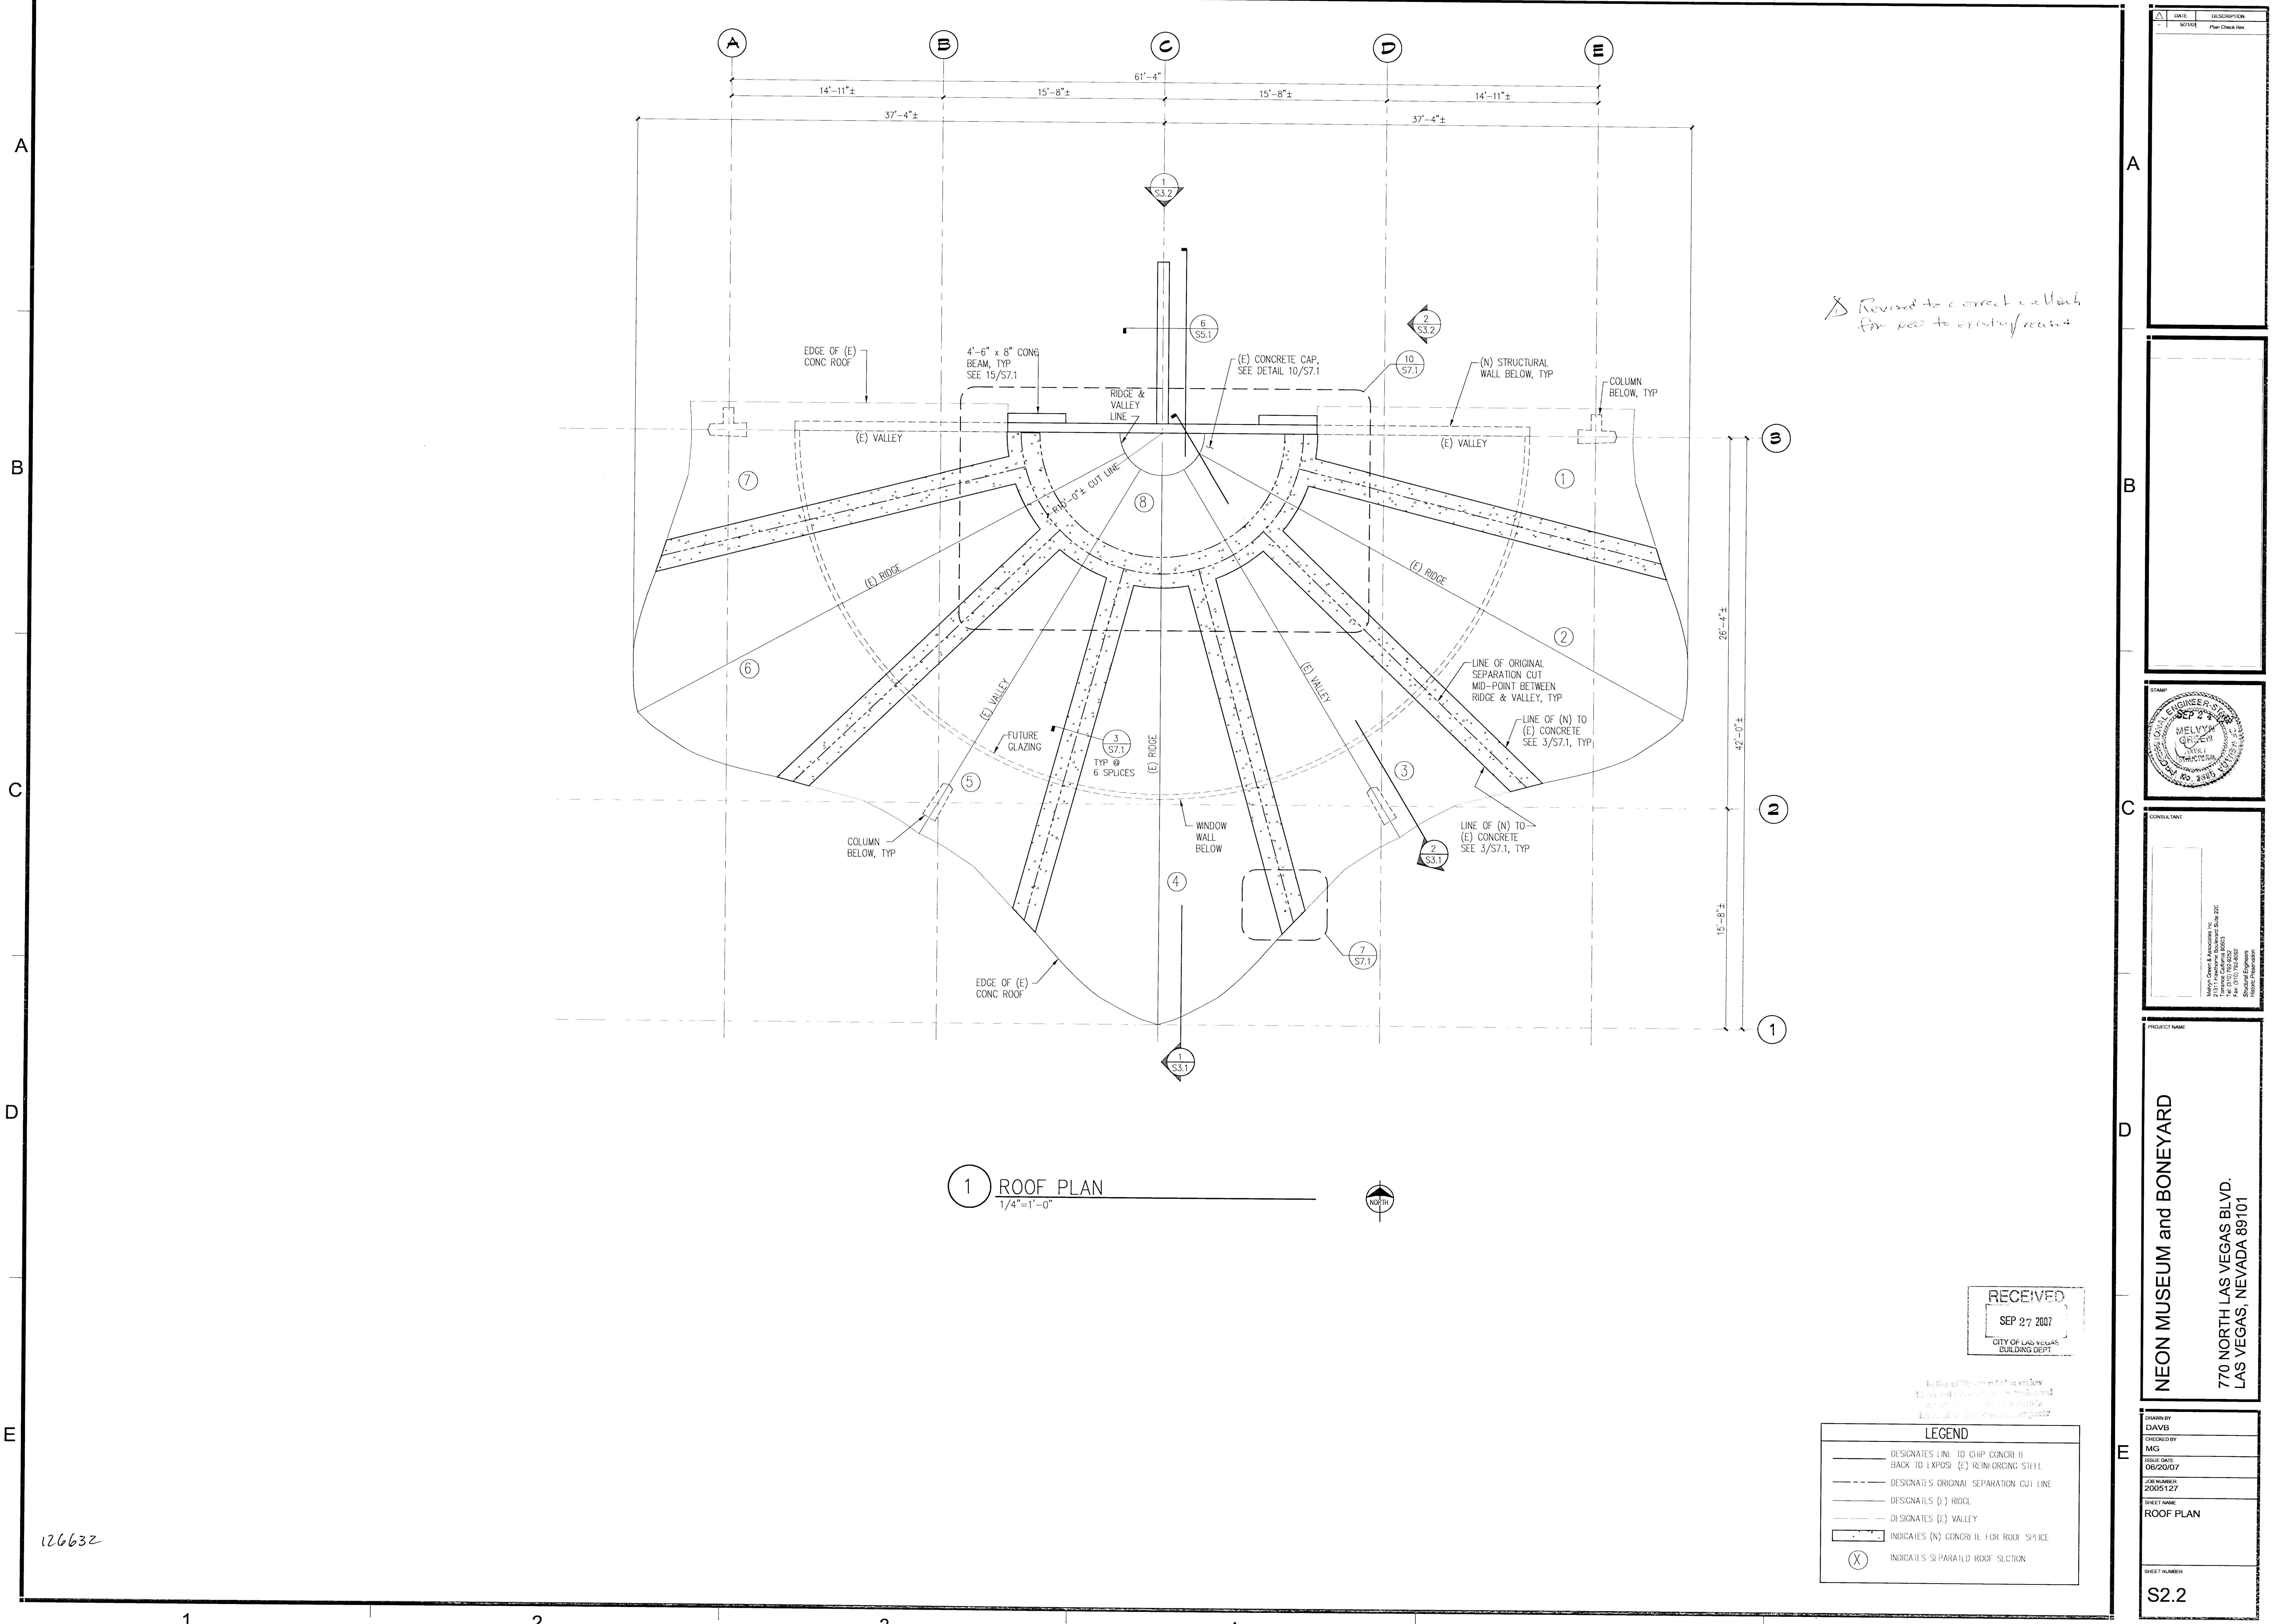

Revised to correct a block for per to existing ground

1 ROOF PLAN
1/4"=1'-0"



RECEIVED
SEP 27 2007
CITY OF LAS VEGAS
BUILDING DEPT

LEGEND	
	DESIGNATES LINE TO CHIP CONCRETE BACK TO EXPOSE (E) REINFORCING STEEL
	DESIGNATES ORIGINAL SEPARATION CUT LINE
	DESIGNATES (E) RIDGE
	DESIGNATES (E) VALLEY
	INDICATES (N) CONCRETE FOR ROOF SPICE
	INDICATES SEPARATED ROOF SECTION

DATE 9/20/07	DESCRIPTION Plan Check Rev
STAMP SEP 27 2007 MELVYN GREEN REGISTERED PROFESSIONAL ENGINEER No. 28903	
CONSULTANT DAVIS 21011 Parkway Boulevard, Suite 220 Las Vegas, NV 89119 Tel: (702) 735-6252 Fax: (702) 735-6252 www.davis-engineers.com	
PROJECT NAME NEON MUSEUM and BONEYARD 770 NORTH LAS VEGAS BLVD. LAS VEGAS, NEVADA 89101	
DRAWN BY DAVIS	CHECKED BY MG
ISSUE DATE 06/20/07	JOB NUMBER 20061127
SHEET NAME ROOF PLAN	
SHEET NUMBER S2.2	