



DRAWING BY: COLUMBIA RIVER CADD 07-007 3530 SE 52ND AVE. PORTLAND, OR 97206 503-771-8849
407 W. INFERRAL HIGHWAY SUITE H-428 BREA, CA 92821 714-297-1283

1 WALL ELEVATION
3/8"=1'-0"

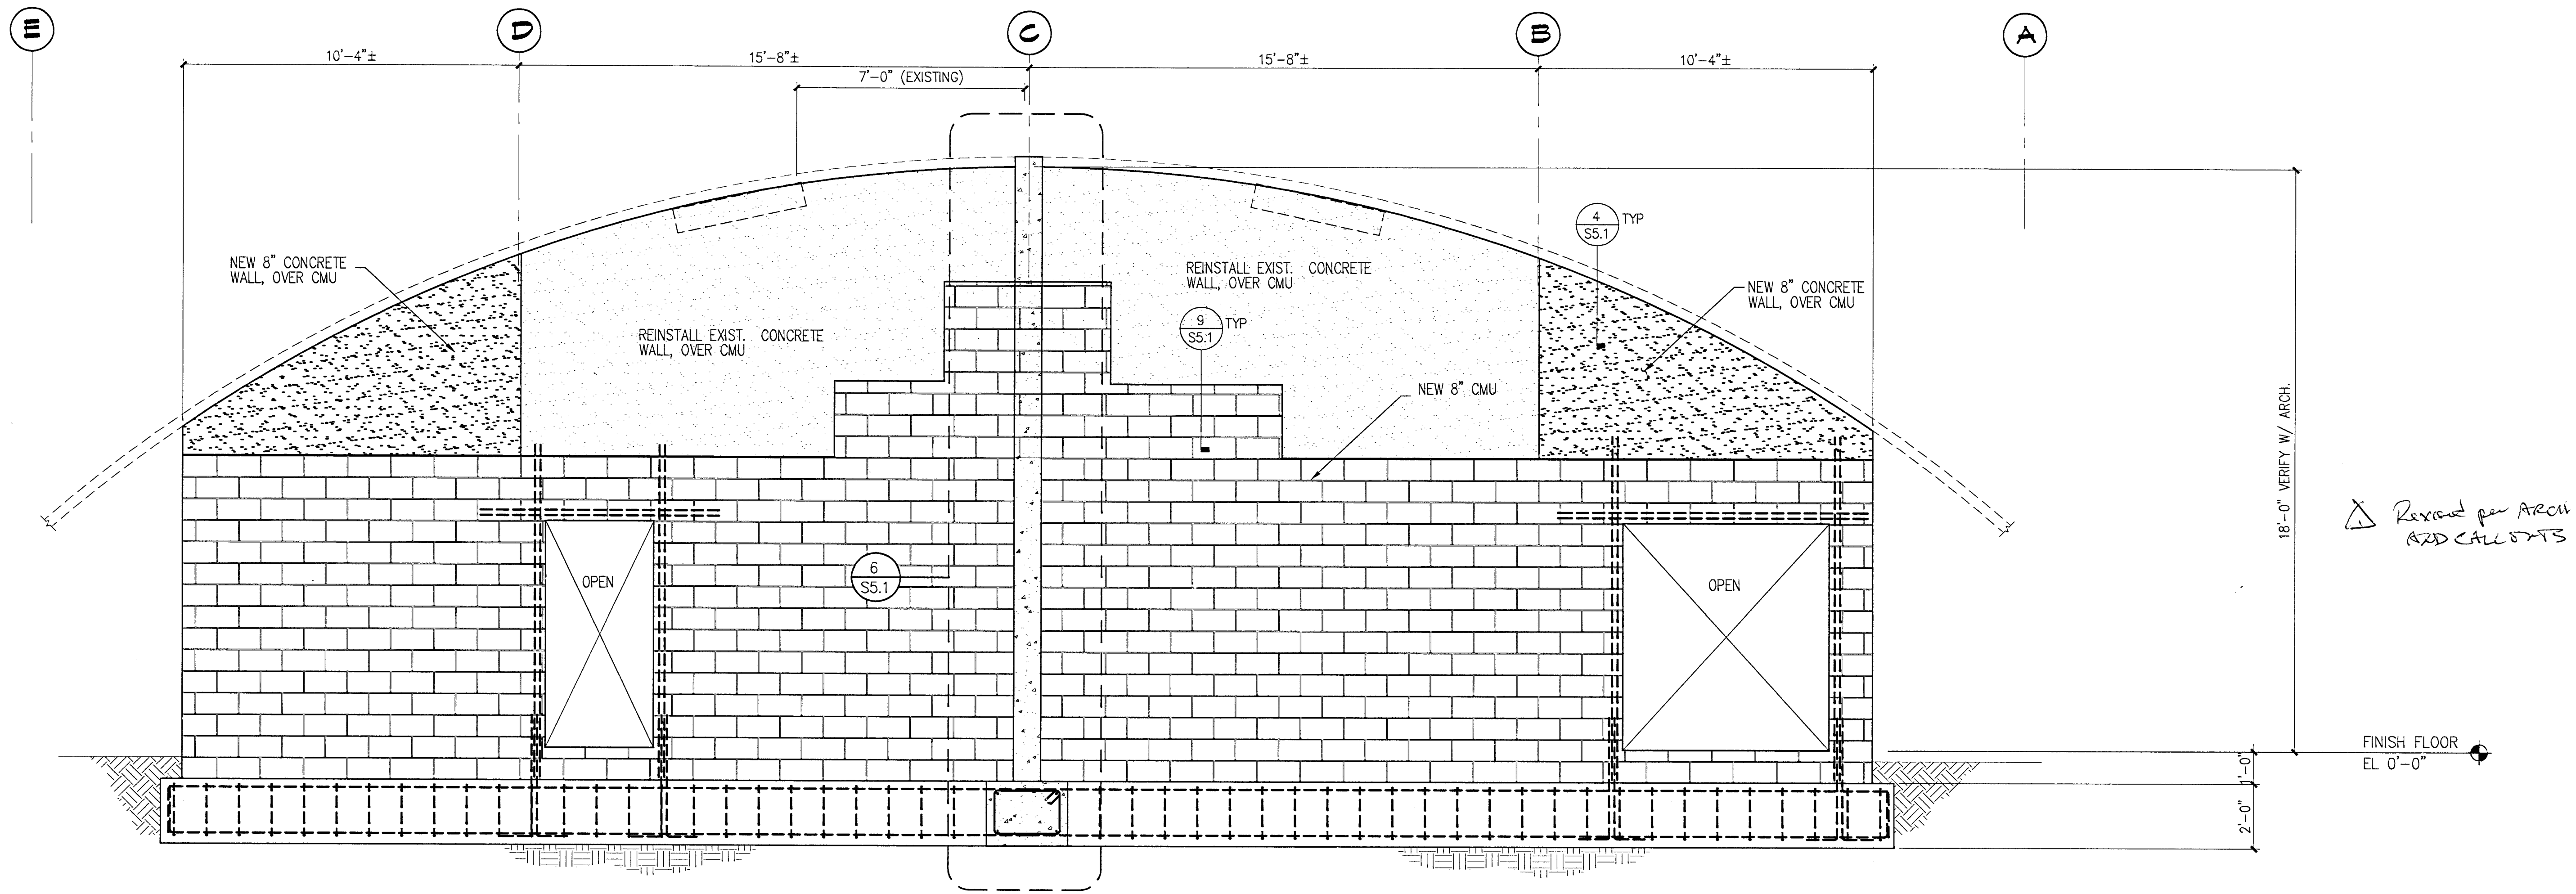


126634

2 WALL ELEVATION
3/8"=1'-0"

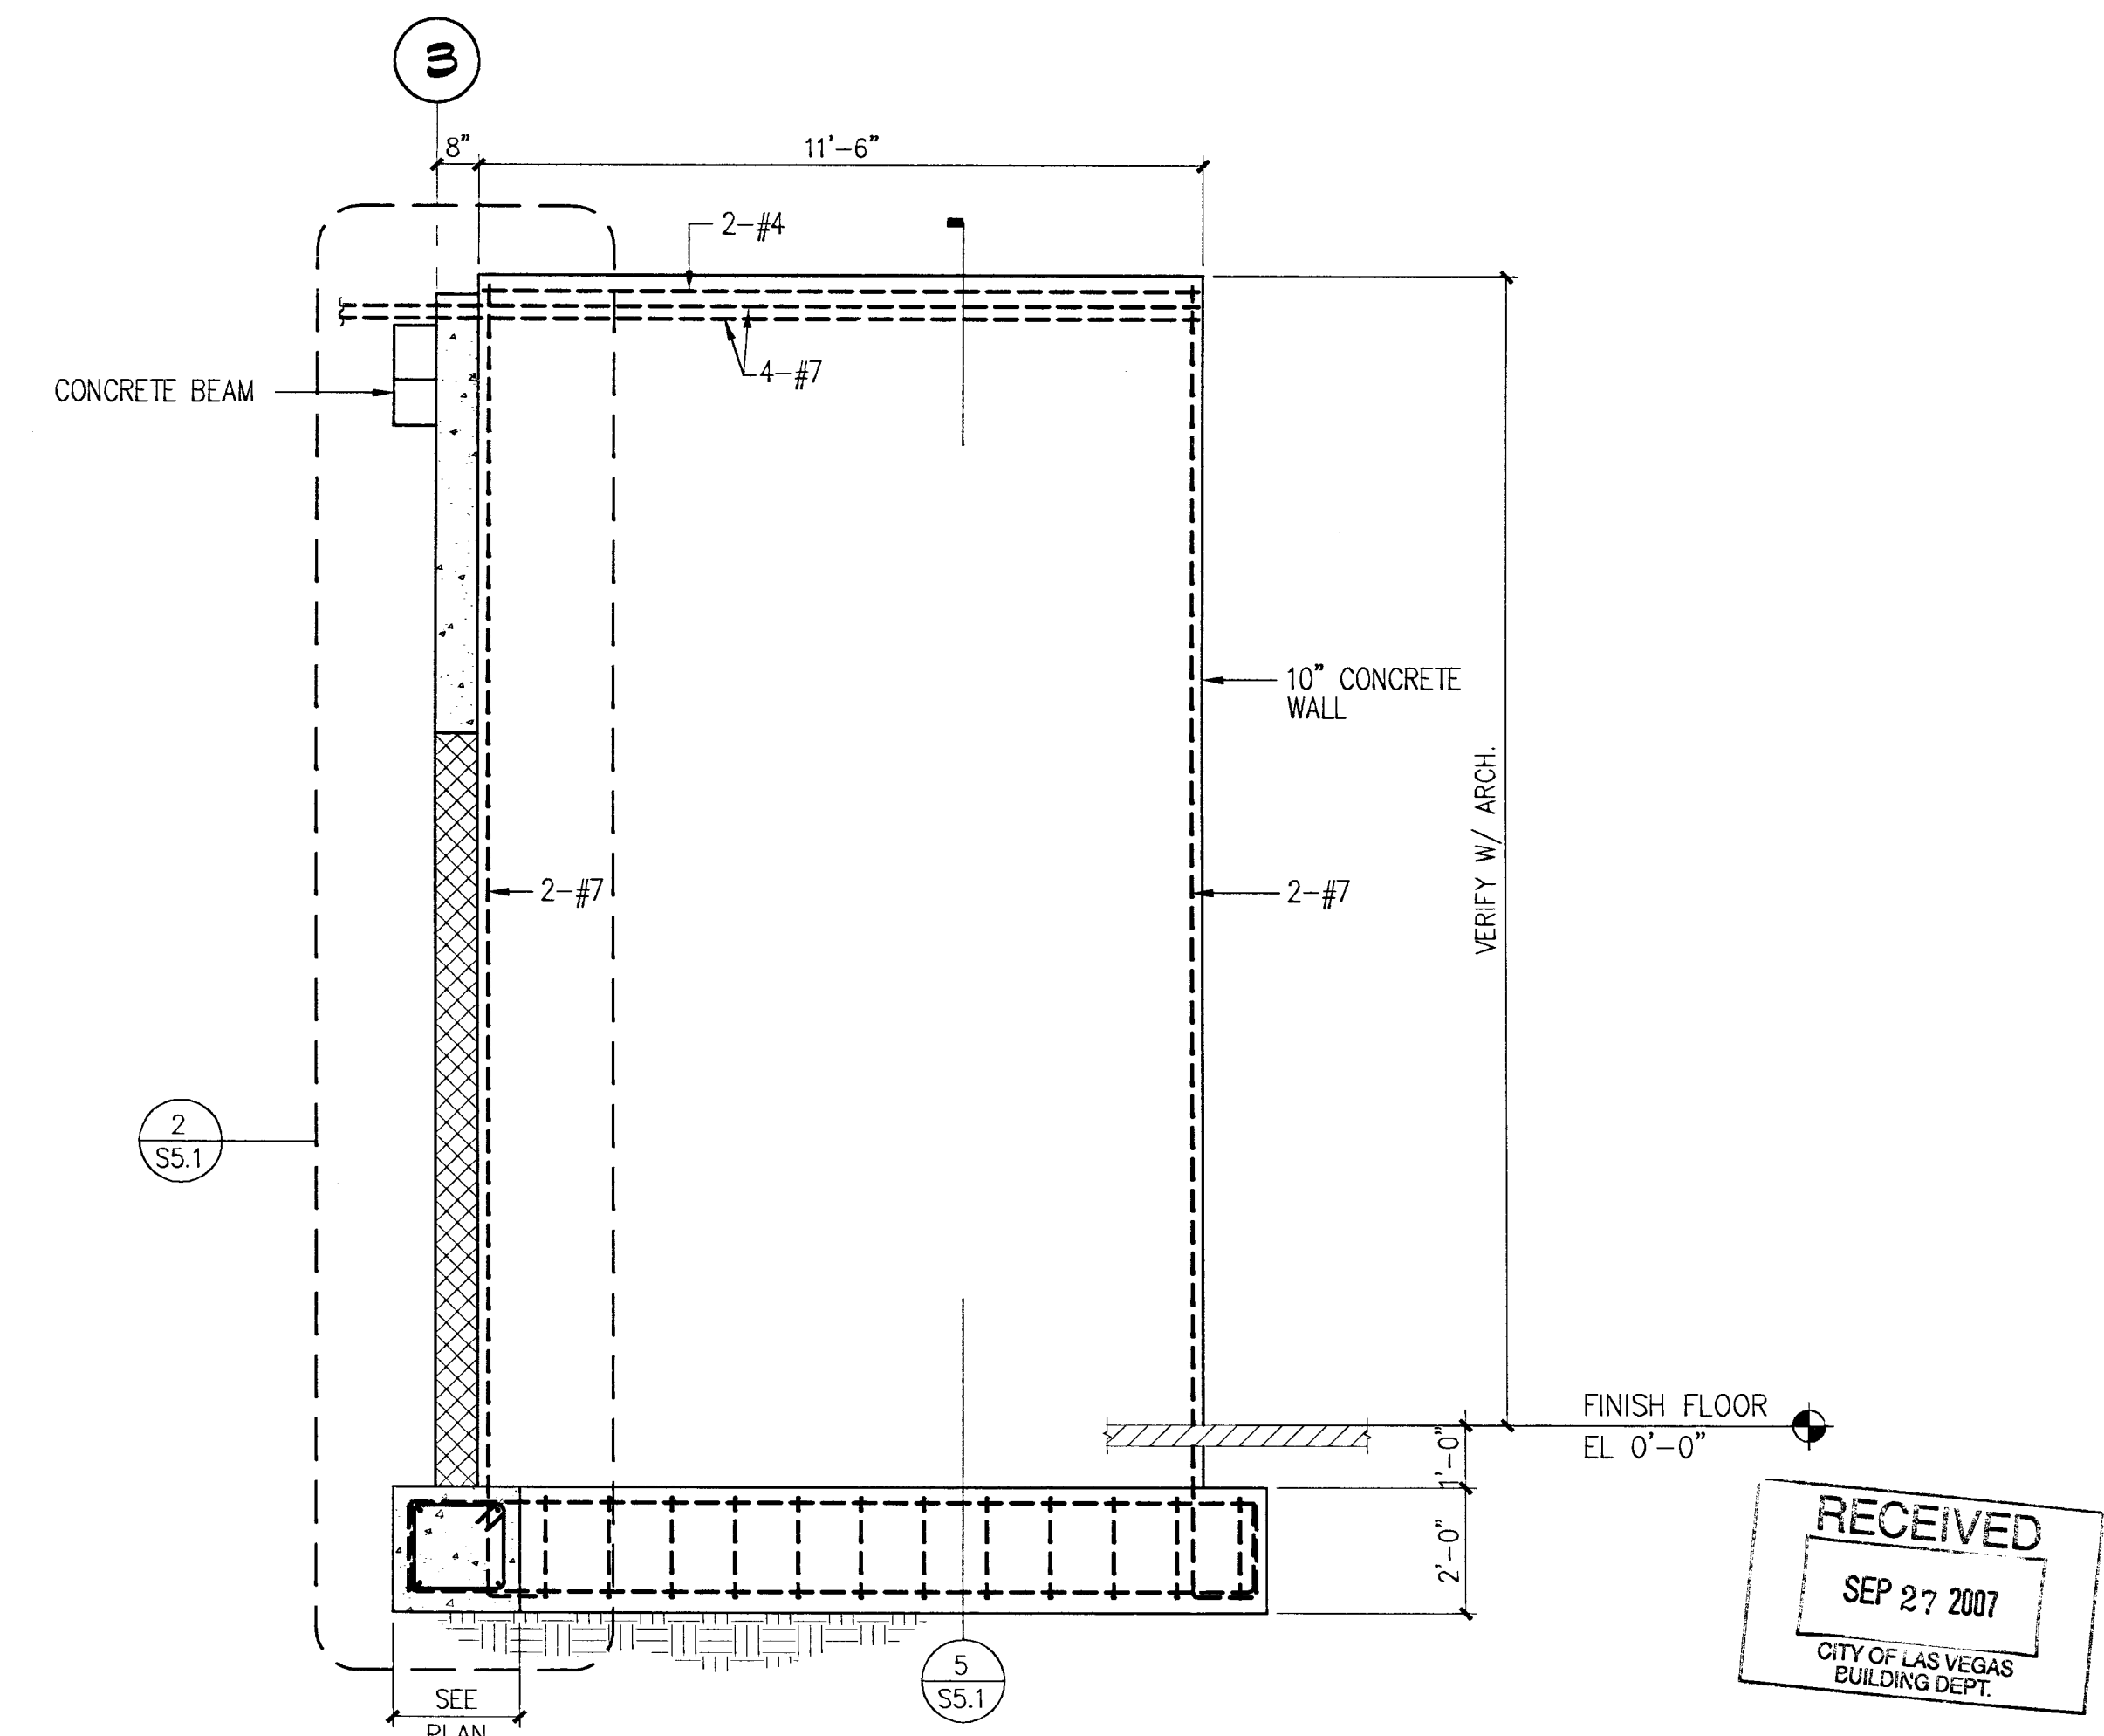

In lieu of Structural plan review
Plans and calculations will be deemed
acceptable if sealed by a Nevada
Licensed civil or structural engineer

DATE	DESCRIPTION
02/16/07	Plan Check Rev.

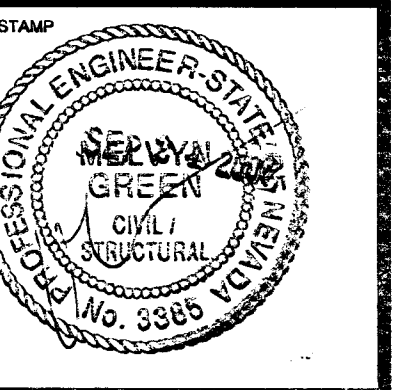

CONSULTANT
Steven Green & Associates Inc.
10000 Las Vegas Blvd. S. #200
Las Vegas, NV 89123
Tel: (702) 792-8800
Fax: (702) 792-8802
www.sgreen.com

PROJECT NAME
NEON MUSEUM and BONEYARD
770 NORTH LAS VEGAS BLVD.
LAS VEGAS, NEVADA 89101

DRAWN BY
DAVB
CHECKED BY
MG
DATE
06/20/07
JOB NUMBER
2005127
SHEET NAME
WALL
ELEVATIONS

SHEET NUMBER
S3.2