


"As-Built"

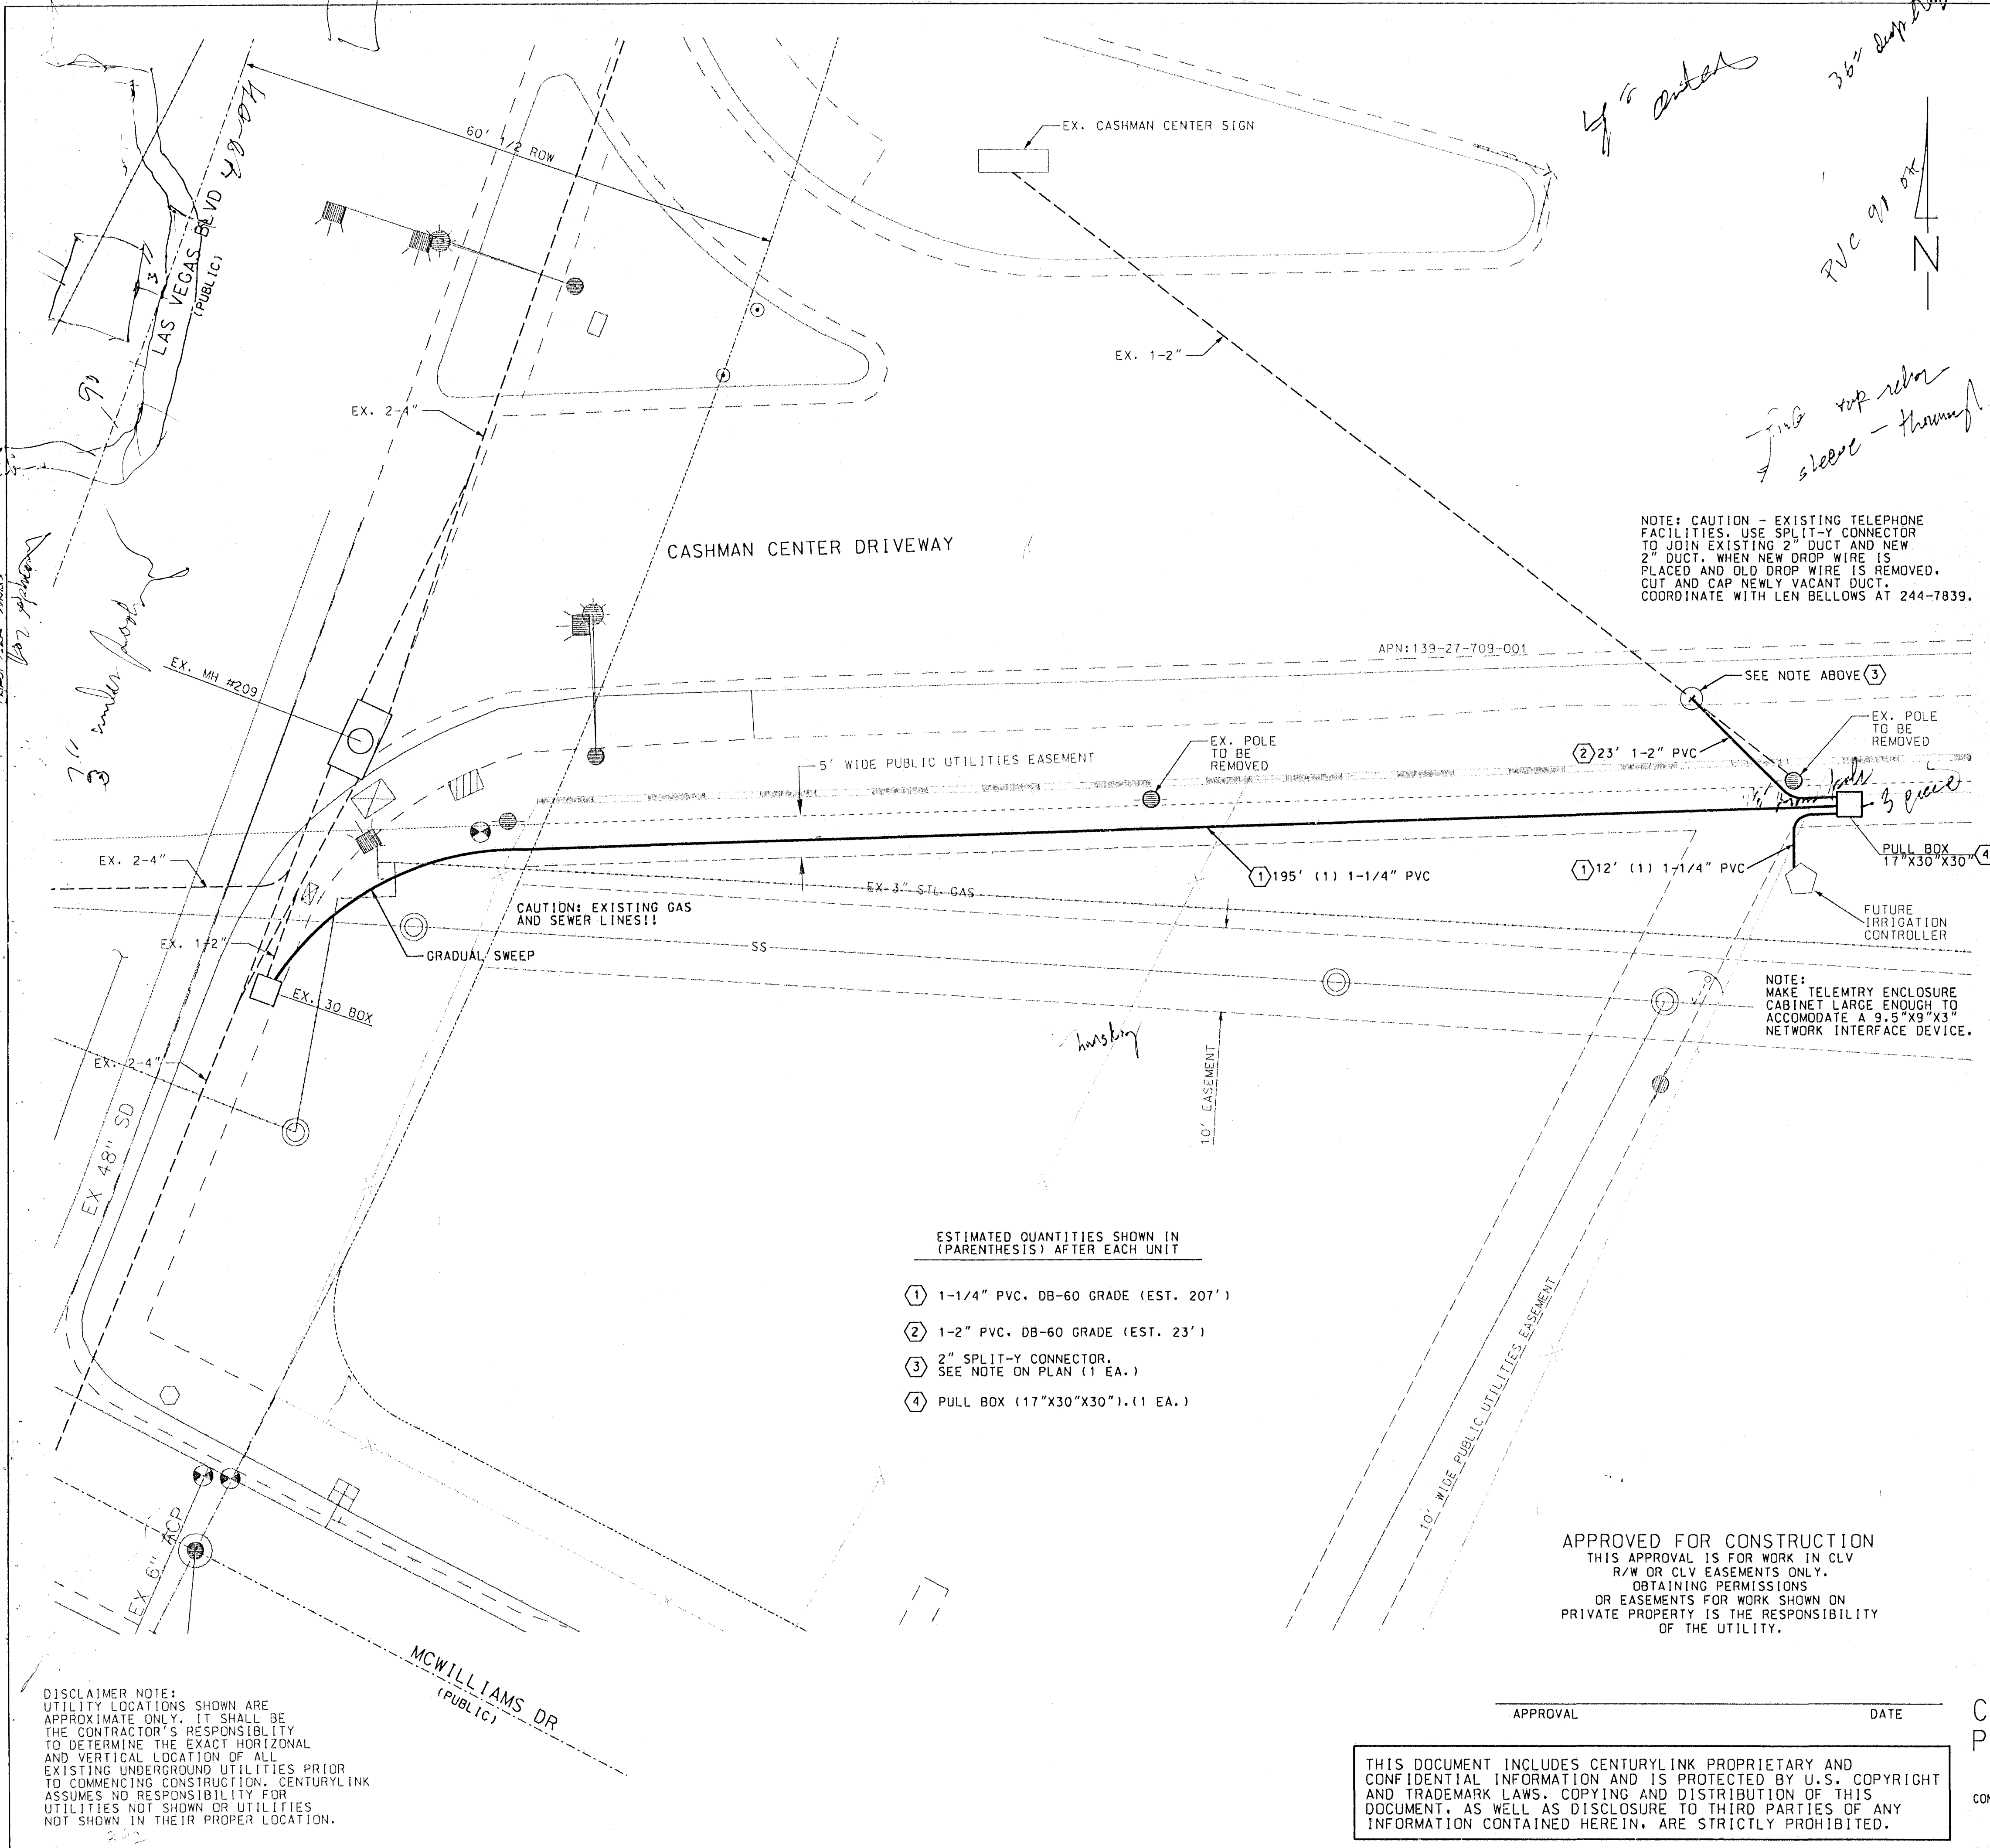

LEGEND

— PROPOSED CONDUIT
--- EXISTING CONDUIT

MANHOLE (SEE DRAWING FOR SIZE)

400 PULL BOX
3'-0" x 5'-0" x 4'-0"

200 PULL BOX
2'-6" x 4'-0" x 4'-0"

30 PULL BOX
17" x 30" x 30"

18 HAND HOLE
9" x 14"

TELEPHONE TERMINAL CABINET
48" x 48" x 8" (100 PAIR)

TELEPHONE TERMINAL CABINET
36" x 36" x 5" (25 to 50 PAIR)

1/2" PLYWOOD BACKBOARD

6 GROUND WIRE

P.V.C. - D.B. (DIRECT BURIAL) GRADE
D.B. 60 FOR 1", 2", & 3"
D.B. 500 FOR 4"

90° SWEEPS - 36" RADIUS FOR 1", 2", & 3"
48" RADIUS FOR 4"
SCHEDULE 40 PVC (TYPICAL) OR
RIGID GALVANIZED STEEL WITH
DOUBLE-WRAPPED 10 MIL
CORROSION PROTECTION TAPE.
(AS SHOWN)

TELEPHONE PULL BOX WITH TWO (2) HINGED
ALUMINUM TORSION-ASSISTED TRAFFIC RATED
LIDS MARKED "TELECOM" GALVANIZED STEEL
ADJUSTING FRAME AND 4-18 HOLE CABLE
RACKS (2 EA. SIDE).

UNDERWRITER LABORATORY APPROVED, RAIN-TIGHT
SMALLER ON ALL SIDES, CENTERED IN CABINET
SECURED WITH RECESSED MOUNTING HARDWARE AND
A #6 GROUND WIRE CONNECTED TO AN APPROVED
GROUND SOURCE (SEE GROUND NOTE BELOW)

TELEPHONE TERMINAL BACKBOARD (T.T.B.) -
TREATED WITH FIRE RETARDANT PAINT OR
SEALER. BACKBOARDS SMALLER THAN 4' x 8'
(e.g. 2' x 2' & 4' x 4') SHOULD BE MOUNTED
40" ABOVE THE FLOOR.

CONNECT TO THE: APPROVED COMMUNICATION
GROUNDING SOURCE AS DETERMINED BY THE
ELECTRICAL ENGINEER FOR THIS BUILDING OR
DEVELOPMENT.

VICINITY MAP
T 20S R 61E SEC: 27

POLYETHYLENE DUCT PLUG(S)

SELECT BACKFILL

FINISHED GRADE

CENTURYLINK MARKING TAPE

PVC CONDUIT

TRENCH SAND OR CONCRETE
AS SPECIFIED PER JOB DRAWING.

CENTURYLINK owned conduit
2-4" rigid galvanized steel, 48" radius
flange ends with double wrapped, 10 mil
corrosion protective tape or 2-4"
Sch. 40 PVC conduit. (See plan for type)

RISER DETAIL
(TYPICAL)

CONSTRUCTION NOTES

- ALL CONSTRUCTION SHALL CONFORM TO THE LATEST ISSUE OF THE CENTURYLINK UNDERGROUND SPECIFICATIONS.
- ALL CONDUIT, TRENCHING, BACKFILLING AND SUBSTRUCTURES ARE TO BE PROVIDED BY THE DEVELOPER AND CONFORM WITH CENTURYLINK STANDARDS UNLESS OTHERWISE SPECIFIED.
- TRENCHING AND TELEPHONE SUBSTRUCTURES ARE TO BE PLACED IN THE SIDEWALK AREA WHENEVER POSSIBLE. ALL TRENCHING WILL BE OF A MINIMUM DEPTH TO MAINTAIN 36" OF COVER OVER UNDERGROUND TELEPHONE FACILITIES AND 12" MINIMUM SEPARATION FROM FOREIGN UTILITIES. NEW AND EXISTING BOXES WILL BE ESTABLISHED TO FINISHED GRADE.
- ALL PULL BOXES (12'-6" x 4'-0" AND LARGER) AND MANHOLES ARE TO BE GROUNDED WITH A 3/8" x 1/8" TINNED SOFT COPPER BONDING RIBBON PLACED VERTICALLY AROUND THE BOTTOM OF THE BOX WITH 3" ENDS STUBBED INSIDE.
- WHEN EXISTING TELEPHONE FACILITIES (e.g. POLES, MANHOLES, PULL BOXES, CONDUIT, TERMINALS, etc.) ARE AFFECTED BY IMPROVEMENTS (REQUIRED BY LOCAL ORDINANCE SUCH AS STREET LIGHTS, SIDEWALK, GUTTERS, etc.) THE DEVELOPER SHALL BE RESPONSIBLE FOR THE ADJUSTMENT OF THESE FACILITIES AS REQUIRED.
- PLYWOOD BACKBOARDS ARE TO BE TREATED WITH FIRE RETARDANT MATERIAL, PAINT, OR SEALER.
- THE CONTRACTOR SHALL PROVIDE AND INSTALL A MEASURING TAPE CONSISTING OF A WATER PROOF, 400 POUND TENSILE STRENGTH, MARKED IN ONE FOOT OR LESS INCREMENTS IN AT LEAST ONE DUCT OF ALL CONDUIT SECTIONS. ALL OTHER DUCTS IN A MULTIPLE DUCT SYSTEM WILL HAVE A 3/32" INCH JET LINE PULL STRING WITH 400 POUND TENSILE STRENGTH.
- THE CONTRACTOR SHALL PROVE AND MANDEL ALL CONDUIT AFTER BACKFILLING WHILE A CENTURYLINK INSPECTOR IS PRESENT. MANDEL SIZE IS TO BE 1/4" SMALLER THAN THE INSIDE DIAMETER OF THE CONDUIT.
- IN ORDER TO INSURE ADEQUATE FACILITIES ARE PROVIDED FOR THIS PROJECT, IT IS IMPERATIVE THAT THE CONDUIT RECOMMENDATION NOT BE CHANGED WITHOUT CENTURYLINK OUTSIDE PLANT ENGINEERING APPROVAL.
- CONCRETE ENCASEMENT SHALL CONSIST OF 3/4" AGGREGATE, TYPE V, PORTLAND CEMENT CONCRETE. THE ENCASEMENT SHALL BE A MINIMUM OF 2" BETWEEN THE CONDUIT AND A MINIMUM OF 3" ON THE TOP, BOTTOM AND SIDES OF THE DUCT BANK.
- ALL TERMINALS, BACKBOARDS, CABINETS, ETC., SHALL BE EQUIPPED WITH A #6 GAUGE GROUND WIRE, RUN TO AN APPROVED GROUND SOURCE. A POLYETHYLENE DUCT PLUG SHALL BE INSTALLED IN ALL CONDUIT WHERE TERMINATED OR STUBBED.
- PROTECTIVE POSTS SHALL BE 4" RIGID STEEL PIPE, SIX FEET IN LENGTH, FILED AND SET IN CONCRETE AT LOCATIONS SHOWN. THE TOP OF THE PROTECTIVE POST SHALL BE 36" INCHES ABOVE THE PROPOSED FINISHED GRADE AND PAINTED WITH YELLOW STREET MARKING PAINT.
- IF EXISTING TERMINATORS ARE NOT UTILIZED TO JOIN SUBSTRUCTURES, CALL 244-7811 FOR CENTURYLINK INSPECTOR, 24 HOURS PRIOR TO PENETRATING ANY CENTURYLINK MANHOLE OR PULL BOX. THE ENTRANCE LOCATION IS VERY CRITICAL AND WILL BE DETERMINED AT THIS TIME. CORE DRILLING AND PROPER GROUTING IS MANDATORY. ENTERING THE SIDE OF A CENTURYLINK MANHOLE OR PULL BOX IS NOT PERMITTED UNLESS APPROVED BY CENTURYLINK.
- ALL TELEPHONE BOXES WILL BE REQUIRED TO HAVE AN 8" x 8" CONCRETE COLLAR POURED AROUND THE TOP PORTION OF THE BOX PER CENTURYLINK STANDARDS, EXCEPT WHEN BOXES ARE TO BE LOCATED IN A CONCRETE SIDEWALK AREA.
- CENTURYLINK WILL REQUIRE "AS-BUILT" FOOTAGES PRIOR TO ORDERING CABLE TO SERVE THIS DEVELOPMENT. THESE FOOTAGES MUST BE RECEIVED SIX WEEKS PRIOR TO SERVICE INSTALLATION DUE DATES.
- CALL 244-7811 TO SCHEDULE CENTURYLINK INSPECTION 24 HOURS PRIOR TO STARTING ANY WORK.

OFFSITE TRENCH DETAIL

ONSITE TRENCH DETAIL

CONTRACTOR // DEVELOPER NOTE

- THE DEVELOPER/CONTRACTOR SHALL CALL 244-7811 TO SCHEDULE INSPECTIONS 24 HOURS IN ADVANCE. REQUESTS RECEIVED AFTER 11:00 AM MAY NOT BE SCHEDULED FOR THE FOLLOWING WORKDAY.
- ANY MODIFICATIONS TO THE CENTURYLINK DESIGN MUST BE APPROVED BY THE ENGINEER.
- THESE PLANS WILL BE VALID FOR SIX MONTHS FROM DATE OF ISSUE.

EASEMENT / PERMIT CERTIFICATION	CITY OF LAS VEGAS PERMIT REQUIRED *	OWNER/CONTACT: GINA VENGLASS / CLV
EASEMENT / PERMIT REQUIRED: YES ☒ NO ☐	DEVELOPER/CONTRACTOR SHALL OBTAIN A CITY PERMIT BEFORE ANY EXCAVATION WORK WITHIN CITY OF LAS VEGAS RIGHT-OF-WAY	TELEPHONE: 229-6790
EASEMENT / PERMIT OBTAINED: YES ☐ NO ☒	*CENTURYLINK INSPECTOR WILL VERIFY CITY PERMIT FOR WORK DONE WITHIN CITY OF LAS VEGAS RIGHT-OF-WAY	
DATE EASEMENT / PERMIT OBTAINED: _____	INSPECTOR: _____ DATE: _____	
ROW ENGINEER SIGNATURE: _____		
CENTURYLINK EASEMENT/PERMIT NUMBER: _____		
REMARKS: _____		

APPROVED FOR CONSTRUCTION
THIS APPROVAL IS FOR WORK IN CLV R/W OR CLV EASEMENTS ONLY. OBTAINING PERMISSIONS OR EASEMENTS FOR WORK SHOWN ON PRIVATE PROPERTY IS THE RESPONSIBILITY OF THE UTILITY.

APPROVAL _____ DATE _____

CONSTRUCTION PERMIT REQUIRED BY CONTRACTOR

CenturyLink

NO.	REVISION	ENGR. MGR. DATE
1		
2		
3		

811
Know what's below.
Call before you dig.

TITLE	UNDERGROUND CONDUIT	DATE	S. PEREZ	DATE	E-207090
REQ.	REQUIREMENT FOR	NO.	244-1352	MAIN	
BY	NEON BONEYARD ADDITIONS	BY	S. GIFFORD	DATE	06/17/10
SCALE	1" = 10'	SHT. NO.	1	OF 1	

DISCLAIMER NOTE:
UTILITY LOCATIONS SHOWN ARE
APPROXIMATE ONLY. IT SHALL BE
THE CONTRACTOR'S RESPONSIBILITY
TO DETERMINE THE EXACT HORIZONTAL
AND VERTICAL LOCATION OF ALL
EXISTING UNDERGROUND UTILITIES PRIOR
TO COMMENCING CONSTRUCTION. CENTURYLINK
ASSUMES NO RESPONSIBILITY FOR
UTILITIES NOT SHOWN OR UTILITIES
NOT SHOWN IN THEIR PROPER LOCATION.

THIS DOCUMENT INCLUDES CENTURYLINK PROPRIETARY AND
CONFIDENTIAL INFORMATION AND IS PROTECTED BY U.S. COPYRIGHT
AND TRADEMARK LAWS. COPYING AND DISTRIBUTION OF THIS
DOCUMENT, AS WELL AS DISCLOSURE TO THIRD PARTIES OF ANY
INFORMATION CONTAINED HEREIN, ARE STRICTLY PROHIBITED.