
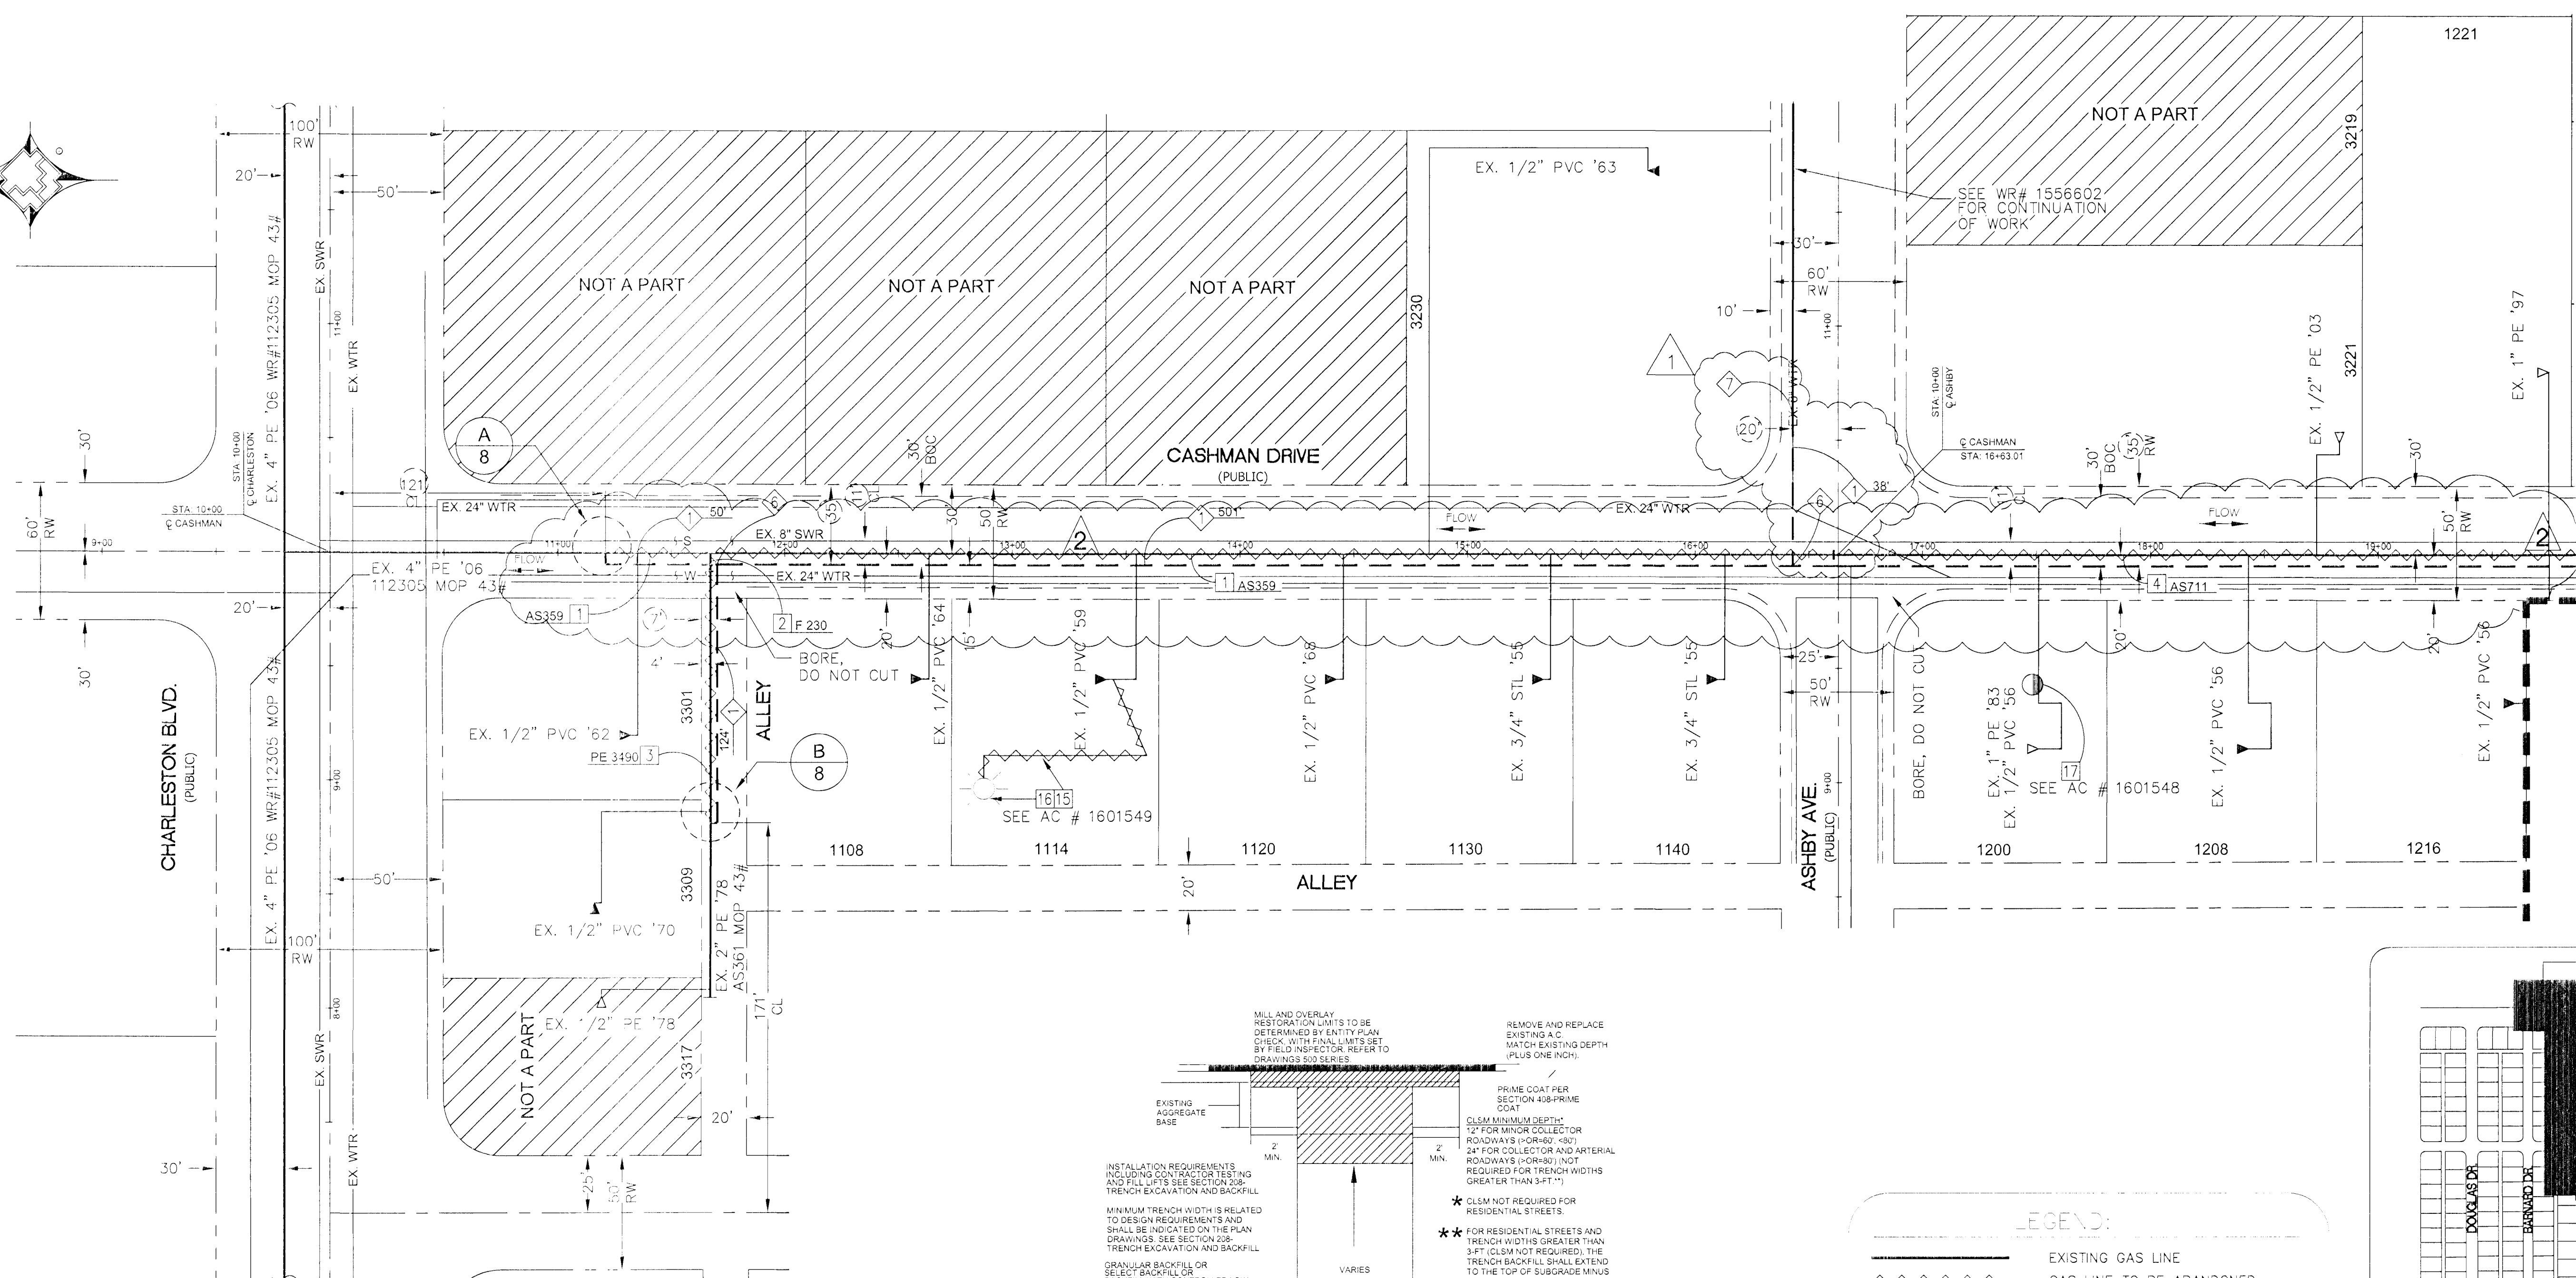


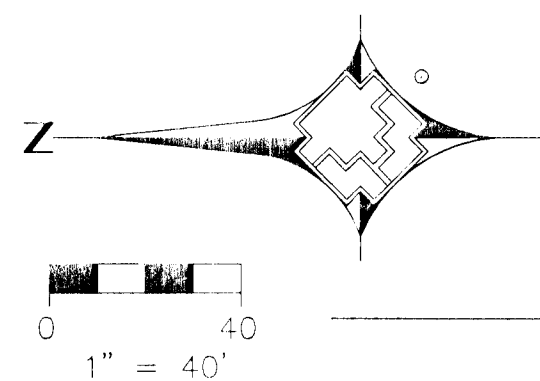





MATCHLINE - SEE SHEET 4

ABANDONED FACILITIES:

- 1 ABANDON EX. 2" STL '55 MOP 43#
- 2 ABANDON EX. 2" PE '82 MOP 43#
- 3 ABANDON EX. 2" PVC '70 MOP 43#
- 4 ABANDON EX. 2" STL '56 MOP 43#
- 15 ABANDON EX. 1/4" PVC '59 MOP 43#
- 16 ABANDON EX. GAS LIGHT
- 17 ABANDON EX. 1" NON-ESSENTIAL VALVE# 1104077

PROPOSED FACILITIES:

- 1 PROPOSED 2" PE MAIN #140-3074
- 6 PROPOSED 2" PE TEE #140-3074
- 7 PROPOSED 2" PE METFIT COUPLING #140-3504
- 8 PROPOSED 2" PE CAP #140-3060

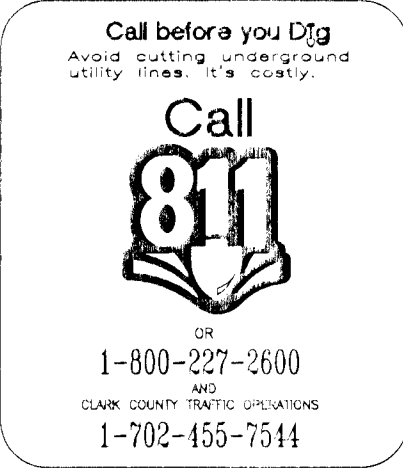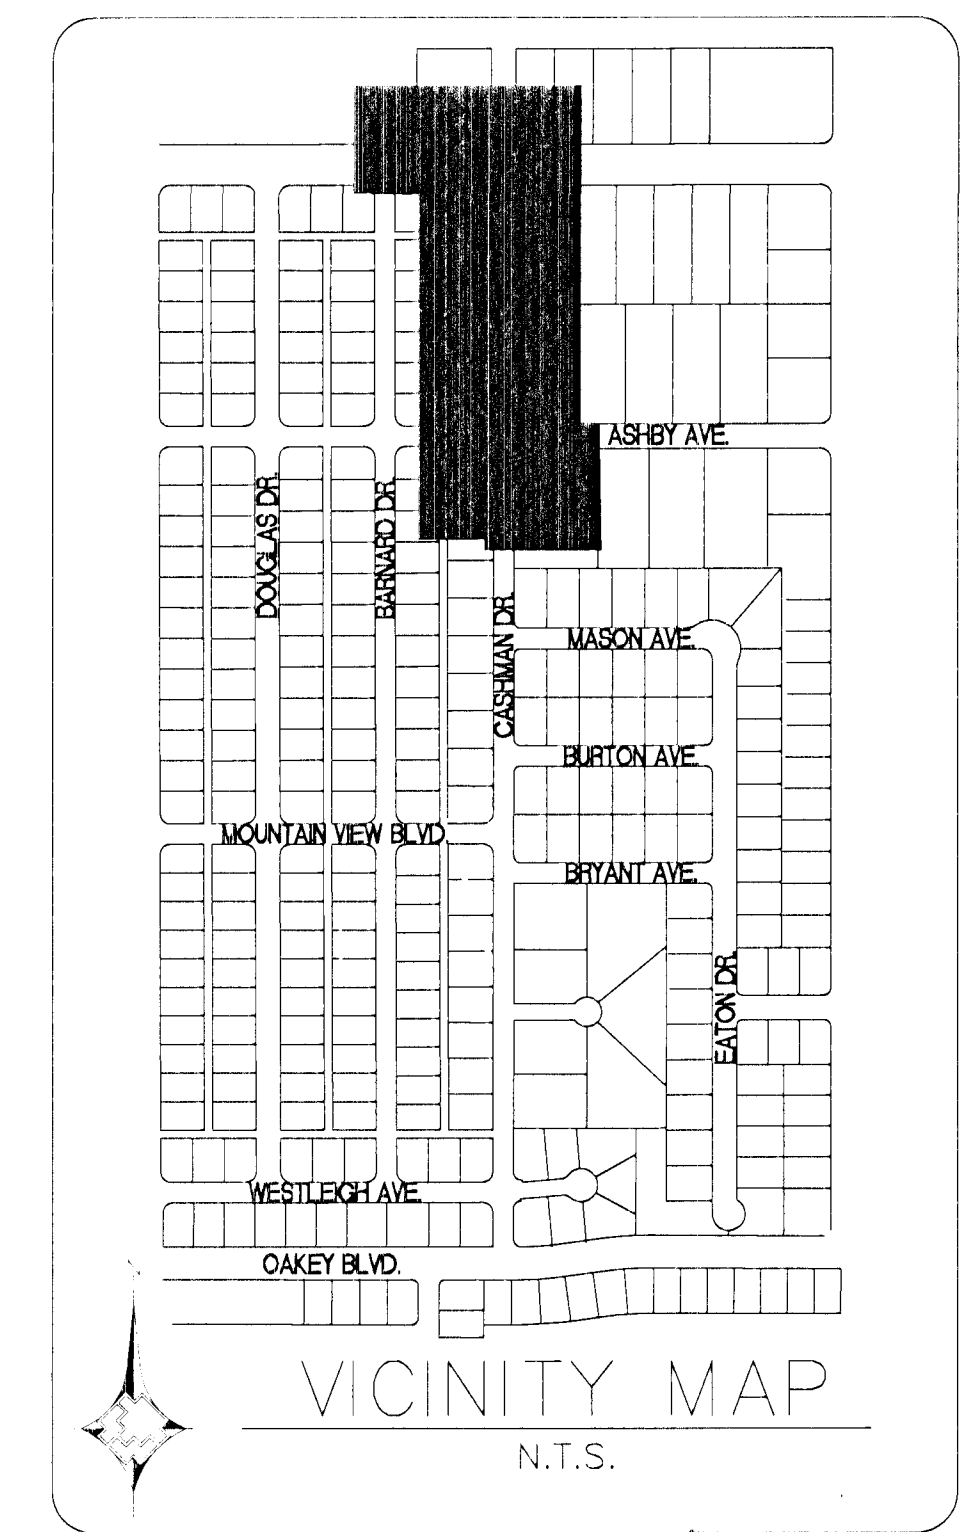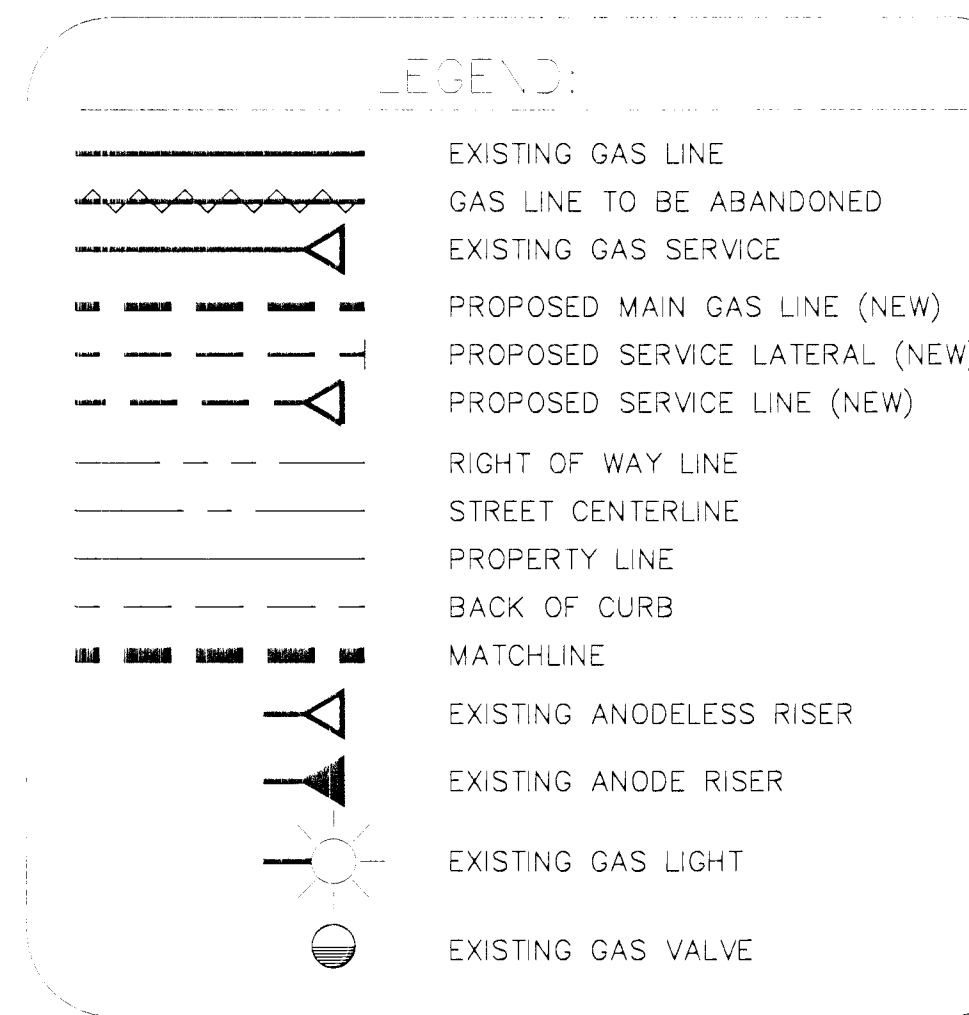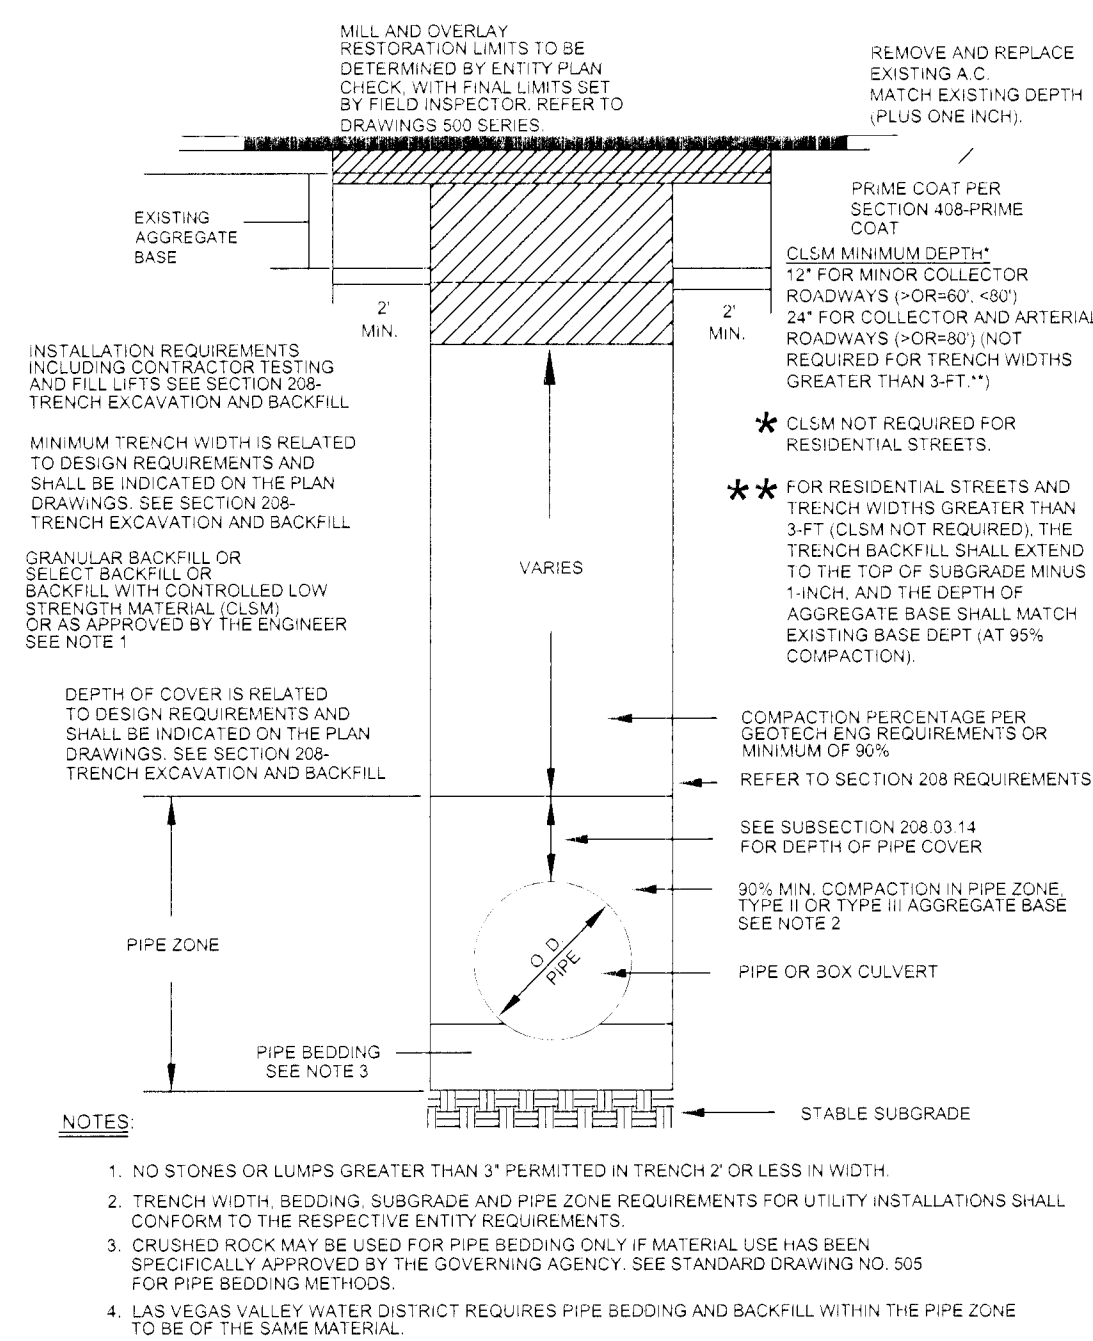

RUNNING LINE CHANGES
REV. LOC. OF MAIN

NMH 4/29/13
n-15-13 RK

SEE SHEET 2

AS-BUILT DRAWING-PRESSURE TEST DATA
SEE SHEET 2

VISUAL INSPECTION CERTIFICATION
SEE SHEET 2

CONSTRUCTION
SEE SHEET 2
PERMIT INFORMATION
CLV
TAX CODE
02-0200

95
1521082
T21S
R61E
Sec. 5
M.D.M.
x615y512
x615y500

SI-CLV-McNEIL MANOR 2A MAIN