


MATCHLINE - SEE SHEET 3

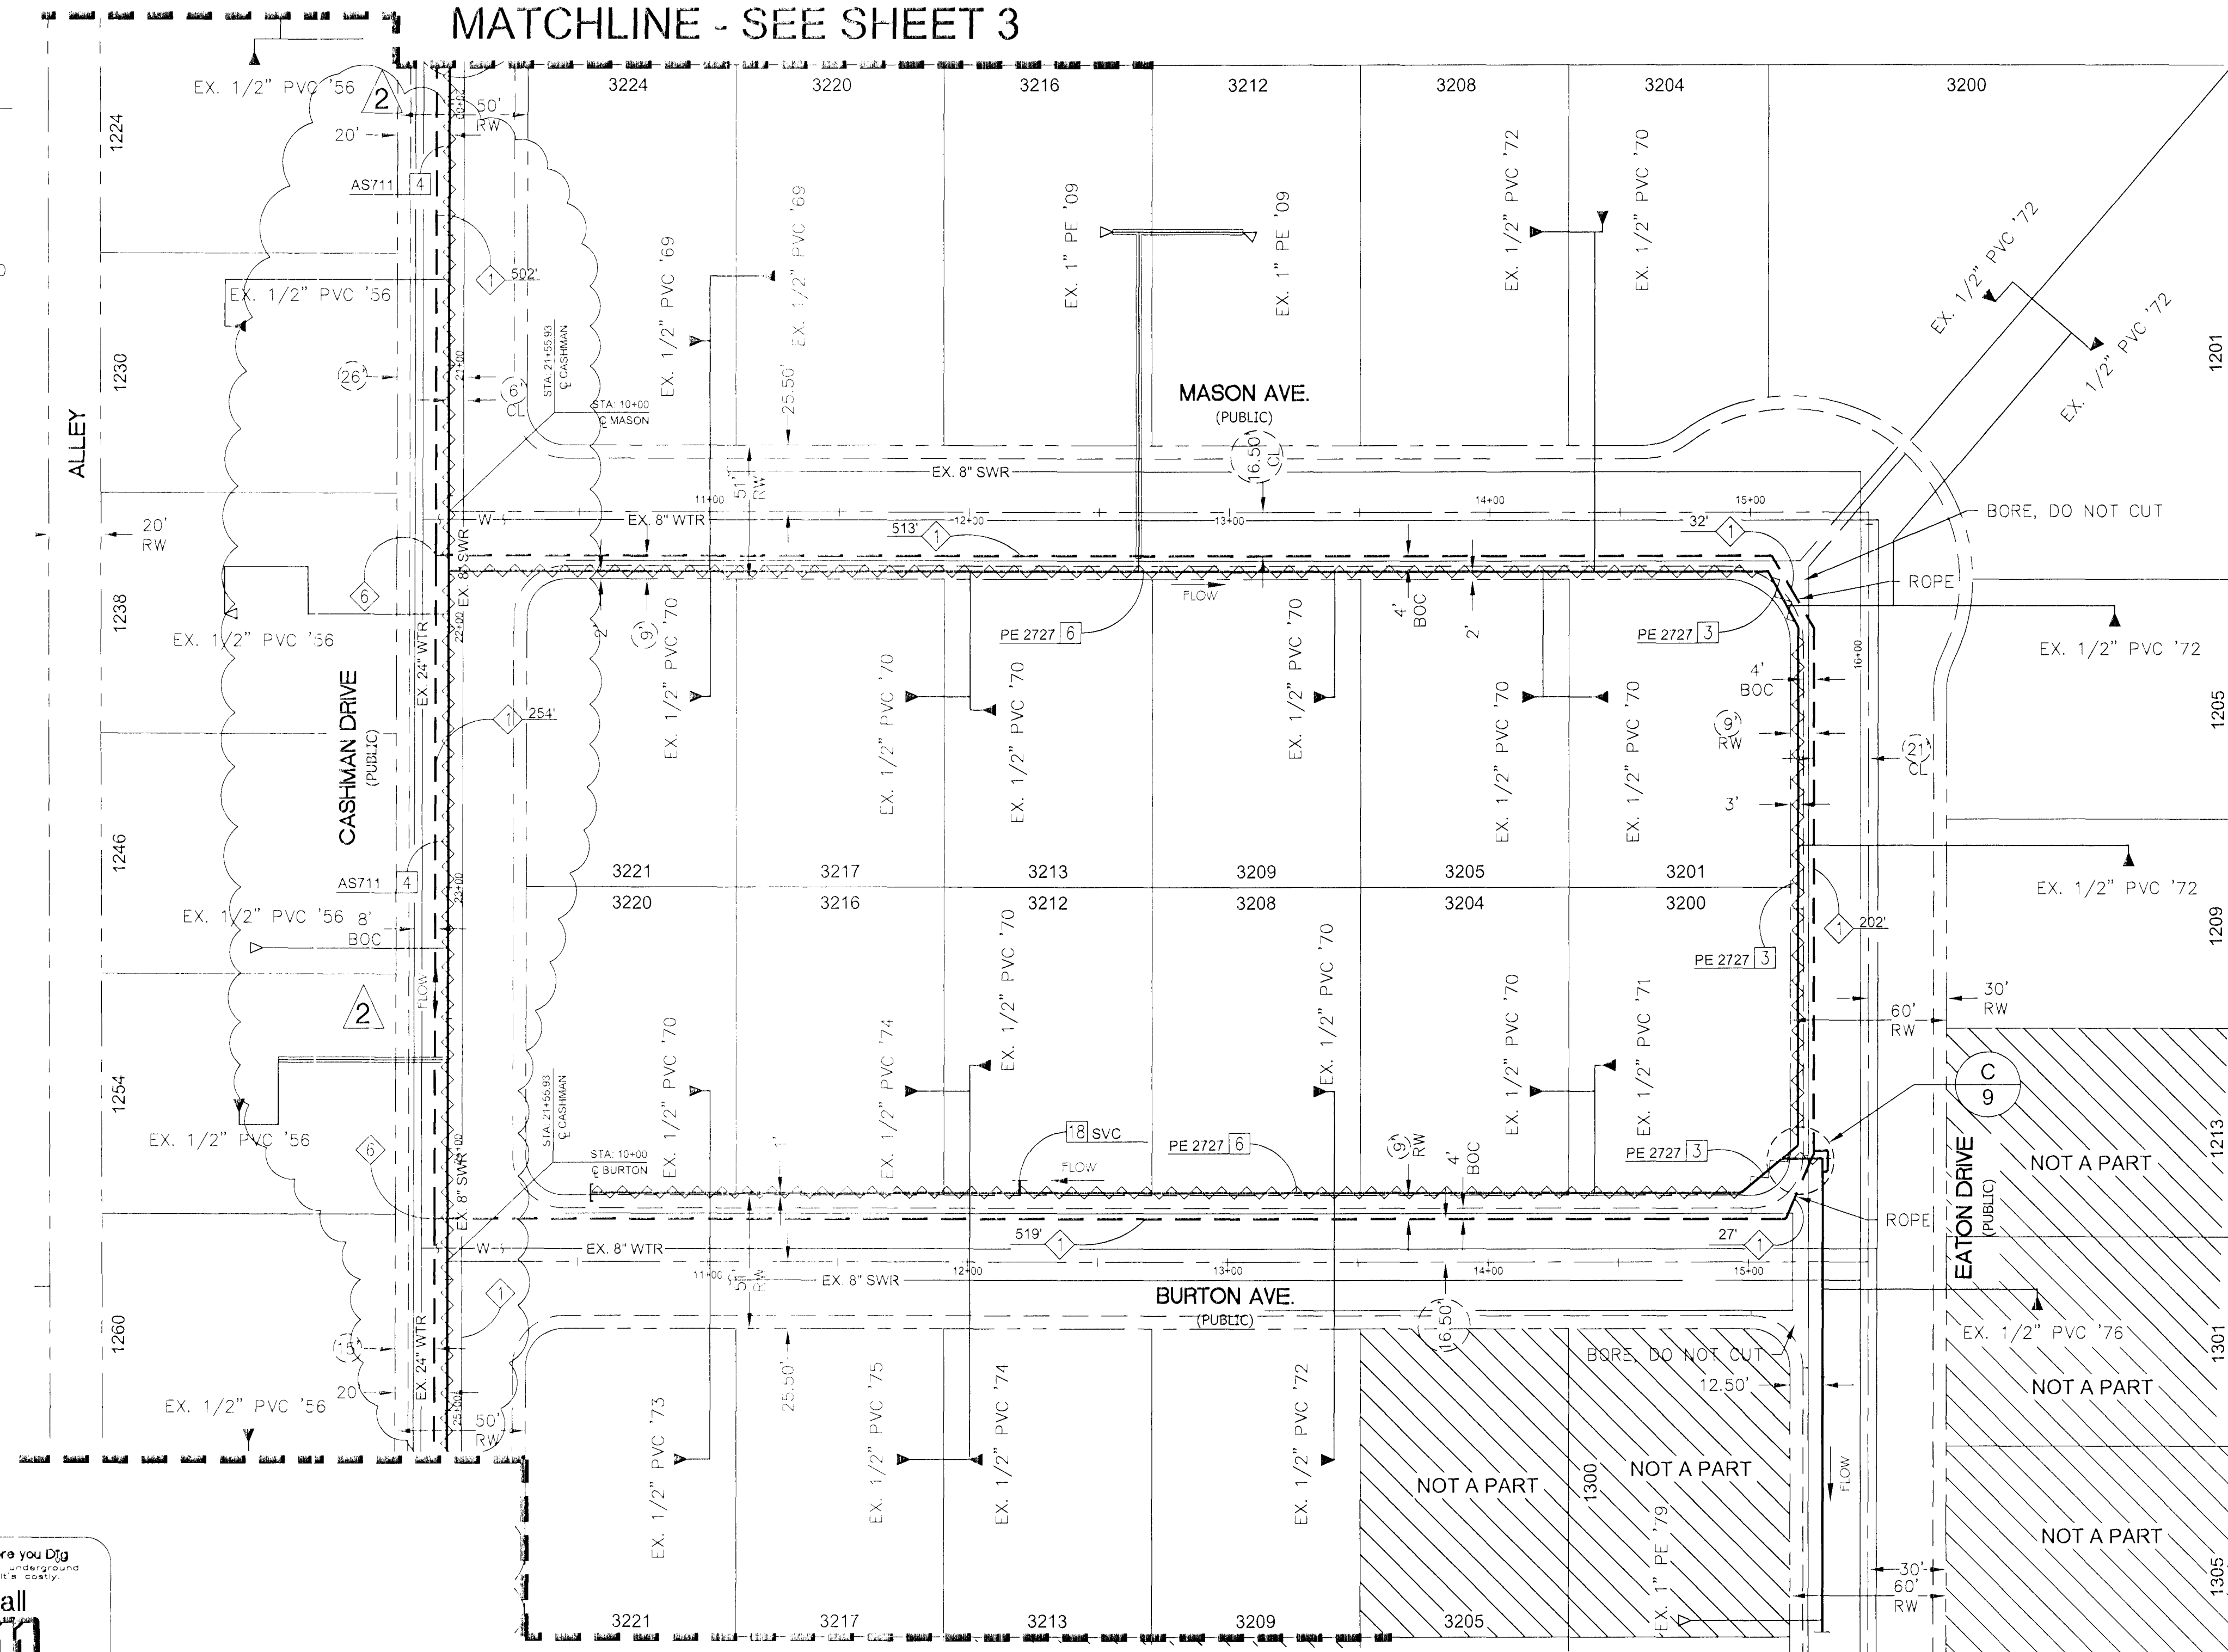

MATCHLINE - SEE SHEET 5

Call before you Dig
Avoid cutting underground utility lines. It's costly.



OR
1-800-227-2600
AND
CLARK COUNTY TRAFFIC OPERATIONS
1-702-455-7544

REV. LOC. OF MAIN

n-15-13 Rk

AS-BUILT DRAWING-PRESSURE TEST DATA

VISUAL INSPECTION CERTIFICATION

CONSTRUCTION

SEE SHEET 2

PERMIT INFORMATION

CLV
TAX CODE
02-0200

95

1521082

T21S
R61E
Sec. 5
MDM

x615y512
x615y500

RTC STD DWG 503

Repl

SI-CLV-McNEIL MANOR 2A MAIN