


0 1" = 40'

MATCHLINE - SEE SHEET 4

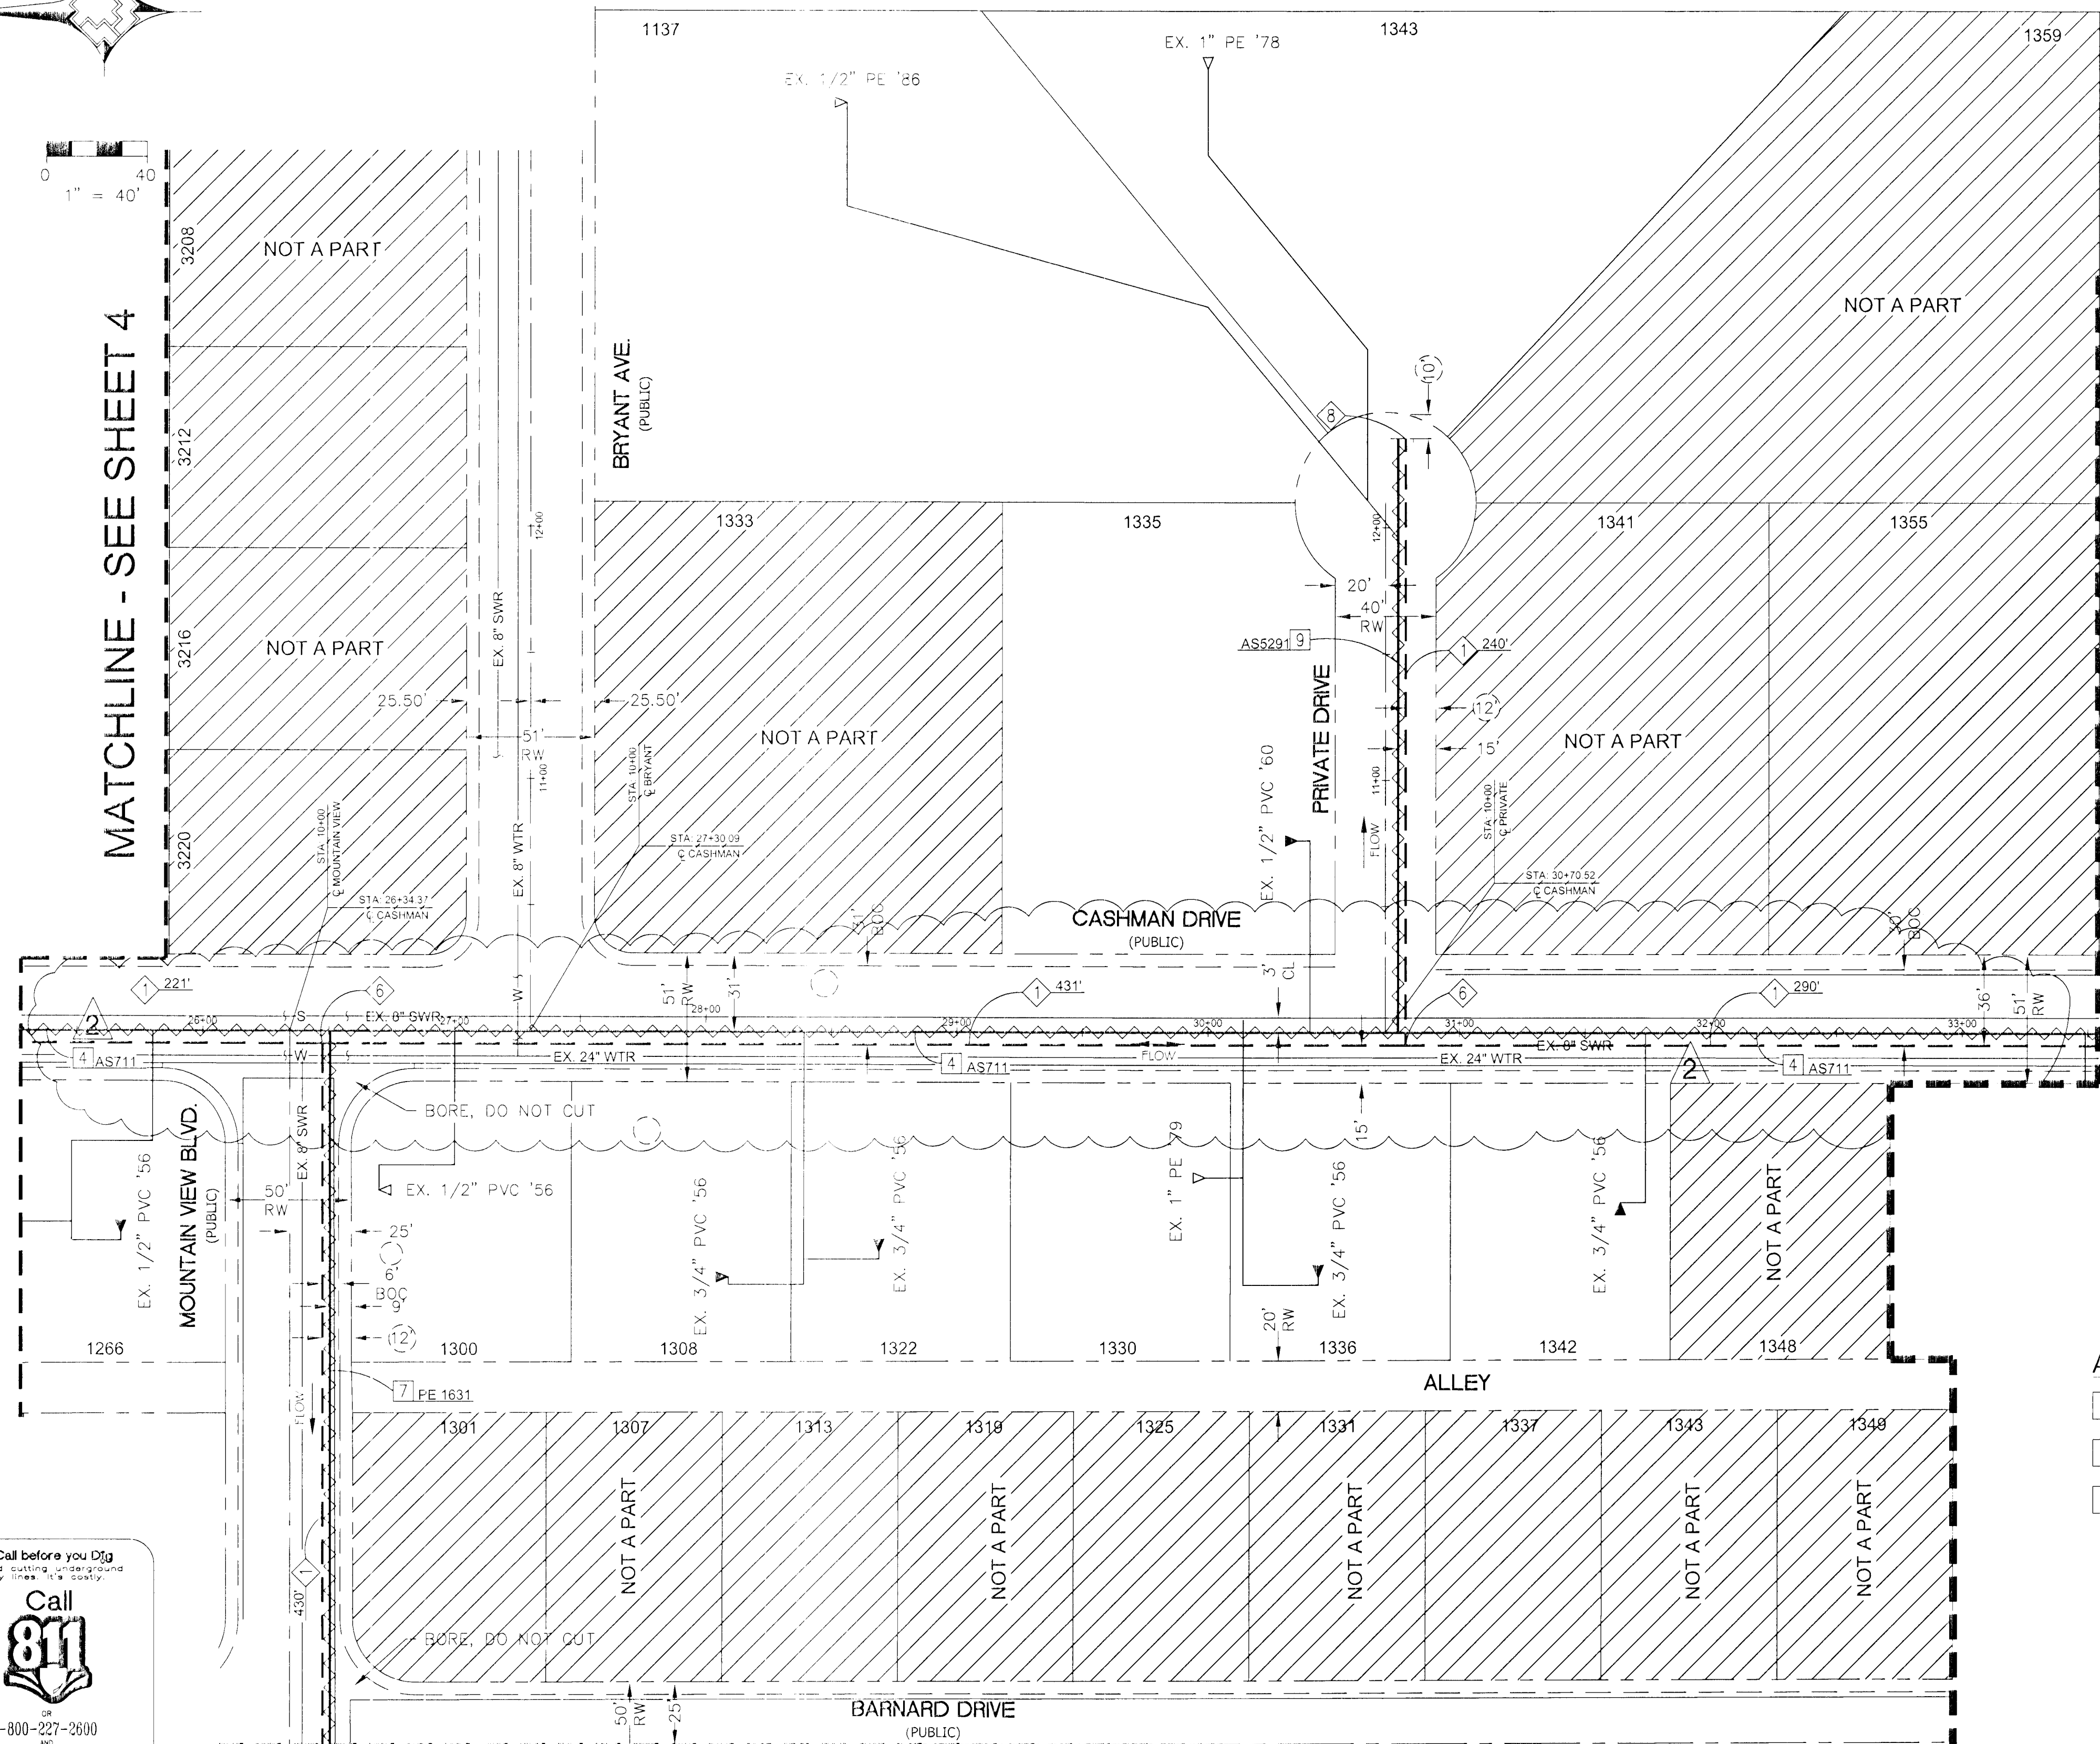

MATCHLINE - SEE SHEET 7

LEGEND:

- EXISTING GAS LINE
- GAS LINE TO BE ABANDONED
- EXISTING GAS SERVICE
- PROPOSED MAIN GAS LINE (NEW)
- PROPOSED SERVICE LATERAL (NEW)
- PROPOSED SERVICE LINE (NEW)
- RIGHT OF WAY LINE
- STREET CENTERLINE
- PROPERTY LINE
- BACK OF CURB
- MATCHLINE
- EXISTING ANODELESS RISER
- EXISTING ANODE RISER
- EXISTING GAS LIGHT
- EXISTING GAS VALVE



MATCHLINE - SEE SHEET 6

ABANDONED FACILITIES:

- 4 ABANDON EX. 2" STL '56 MOP 43#
- 7 ABANDON EX. 2" PVC '66 MOP 43#
- 9 ABANDON EX. 1" PVC '61 MOP 43#

PROPOSED FACILITIES:

- 1 PROPOSED 2" PE MAIN
- 6 PROPOSED 2" PE TEE #140-3074
- 8 PROPOSED 2" PE CAP #140-3060

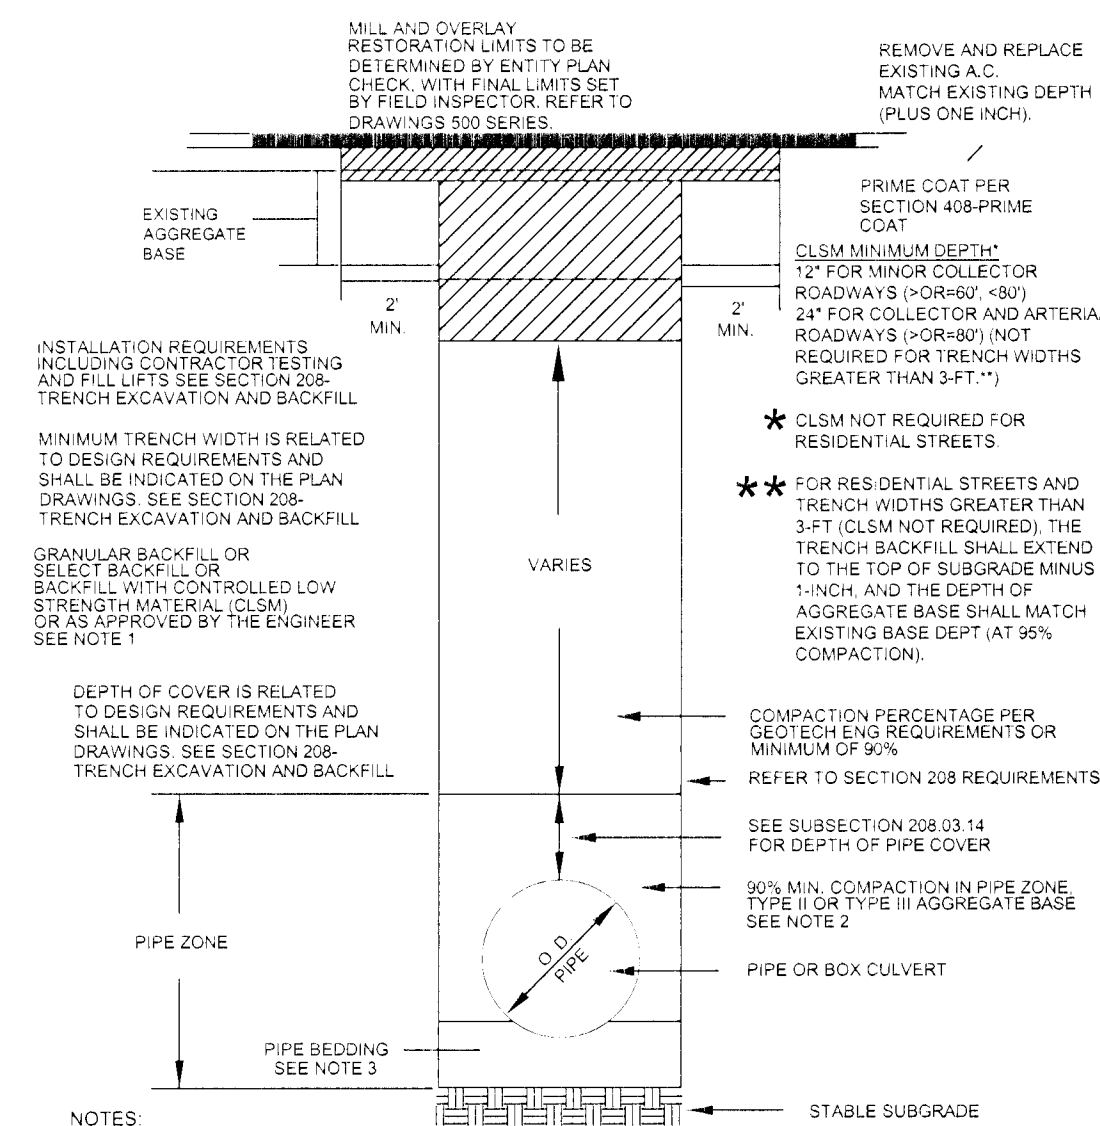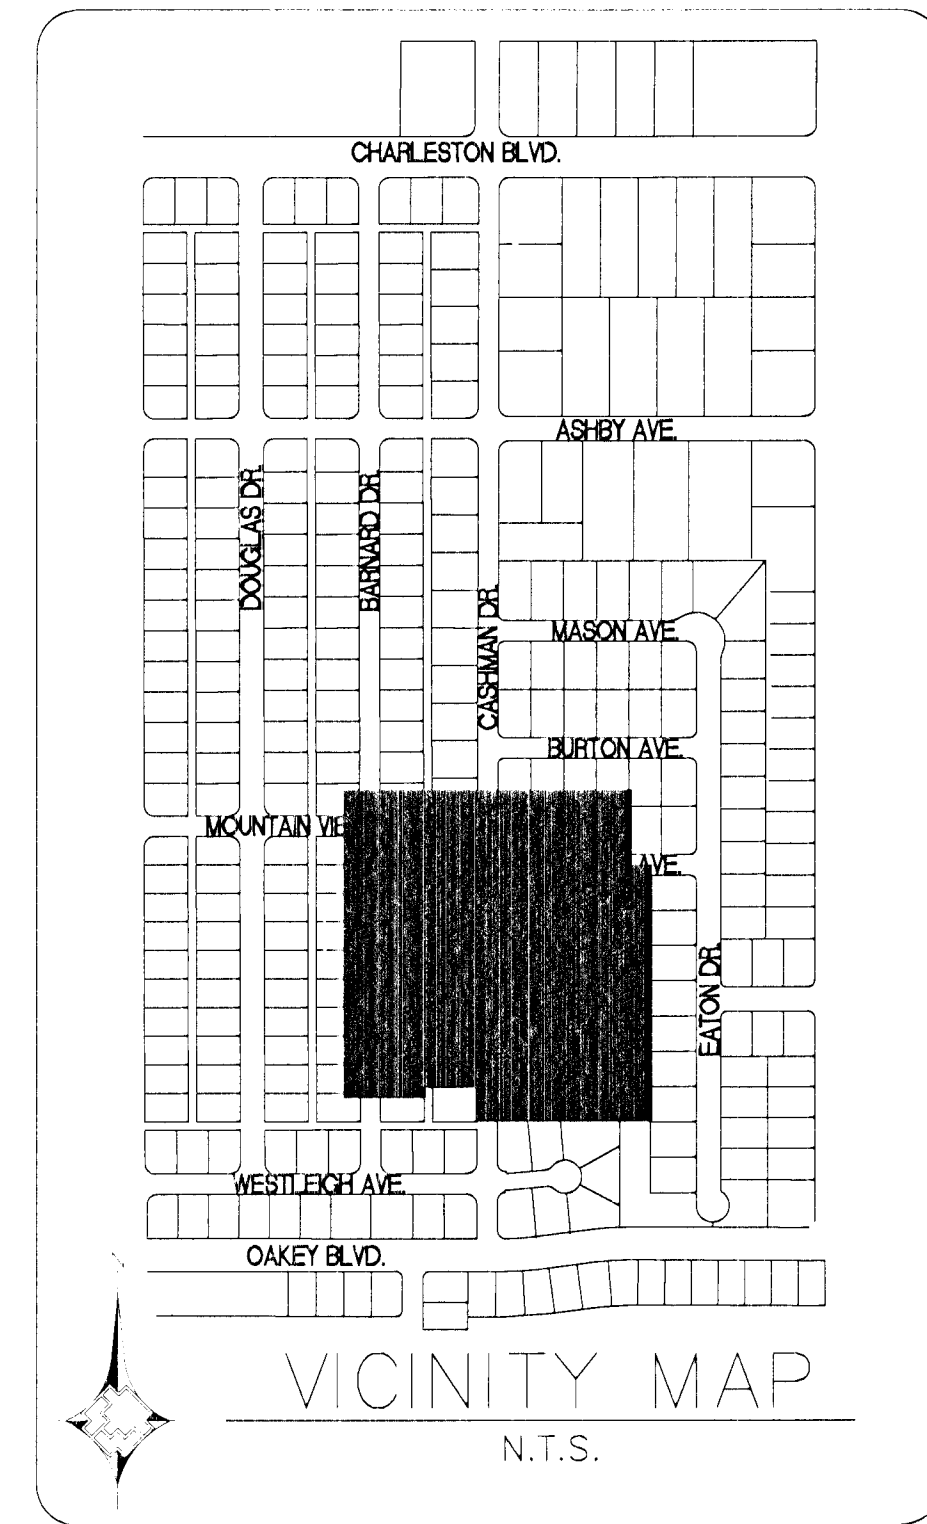

- NOTES:
- NO STONES OR LUMPS GREATER THAN 3" PERMITTED IN TRENCH 2' OR LESS IN WIDTH.
 - TRENCH WIDTH, BEDDING, SUBGRADE AND PIPE ZONE REQUIREMENTS FOR UTILITY INSTALLATIONS SHALL CONFORM TO THE RESPECTIVE ENTITY REQUIREMENTS.
 - CRUSHED ROCK MAY BE USED FOR PIPE BEDDING ONLY IF MATERIAL USE HAS BEEN SPECIFICALLY APPROVED BY THE GOVERNING AGENCY. SEE STANDARD DRAWING NO. 505 FOR PIPE BEDDING METHODS.
 - LAS VEGAS VALLEY WATER DISTRICT REQUIRES PIPE BEDDING AND BACKFILL WITHIN THE PIPE ZONE TO BE OF THE SAME MATERIAL.

RTC STD DWG 503

Revised

REV. LOC. OF MAIN

7-15-13 PK

AS-BUILT DRAWING-PRESSURE TEST DATA

VISUAL INSPECTION CERTIFICATION

CONSTRUCTION

SEE SHEET 2

PERMIT INFORMATION

CLV
TAX CODE
02-0200

95

1521082

T21S
R61E
Sec. 5
M.D.M.
x615y512
x615y500

SI-CLV-McNEIL MANOR 2A MAIN