
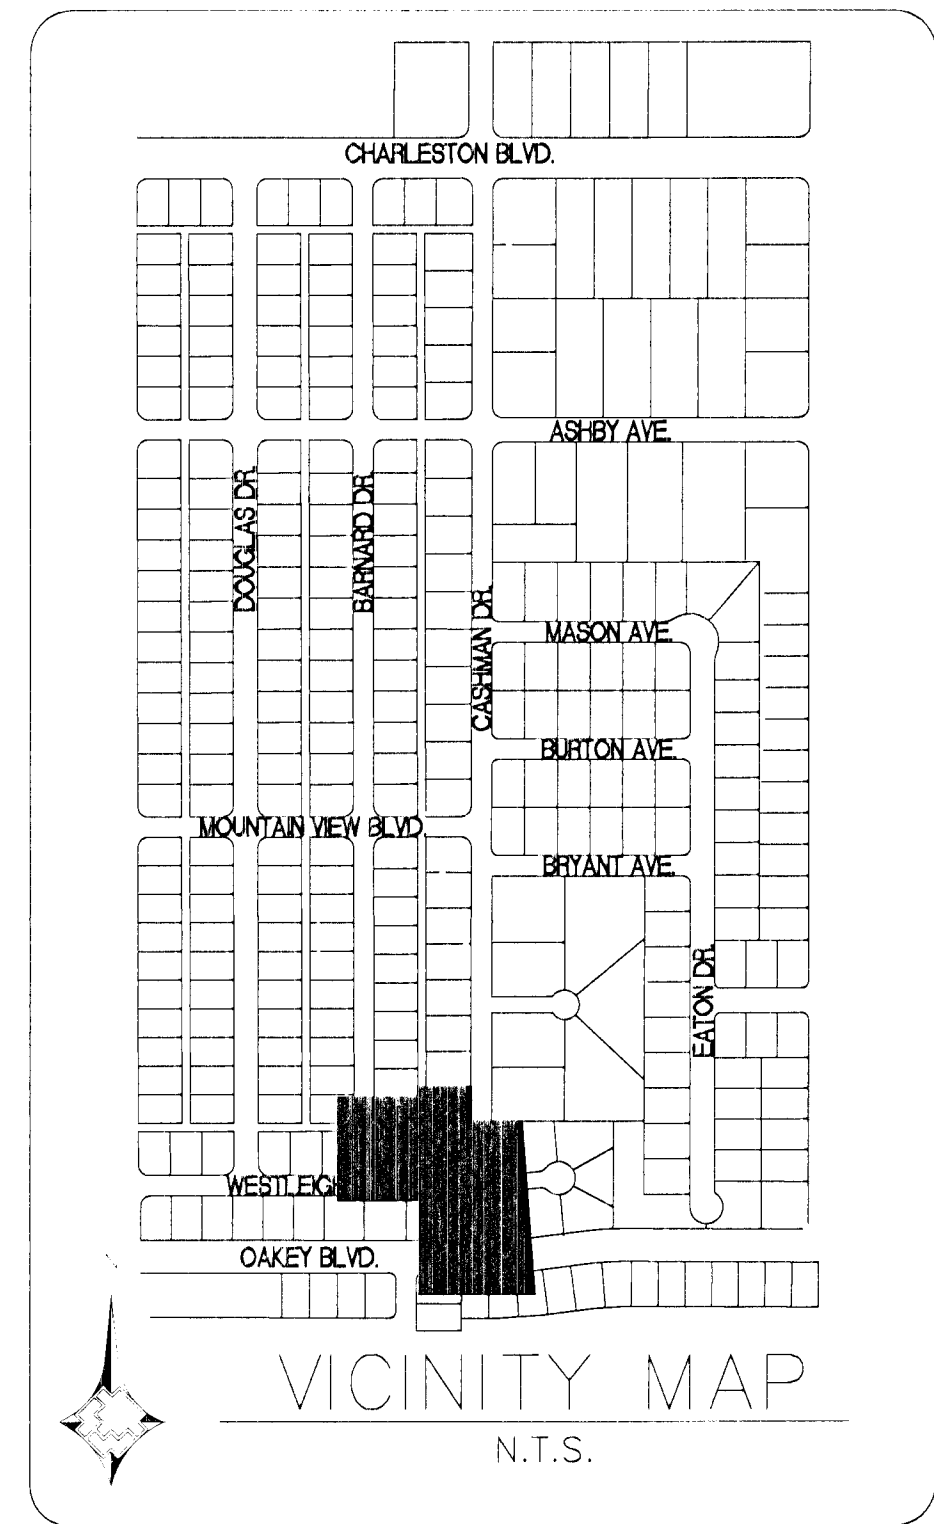
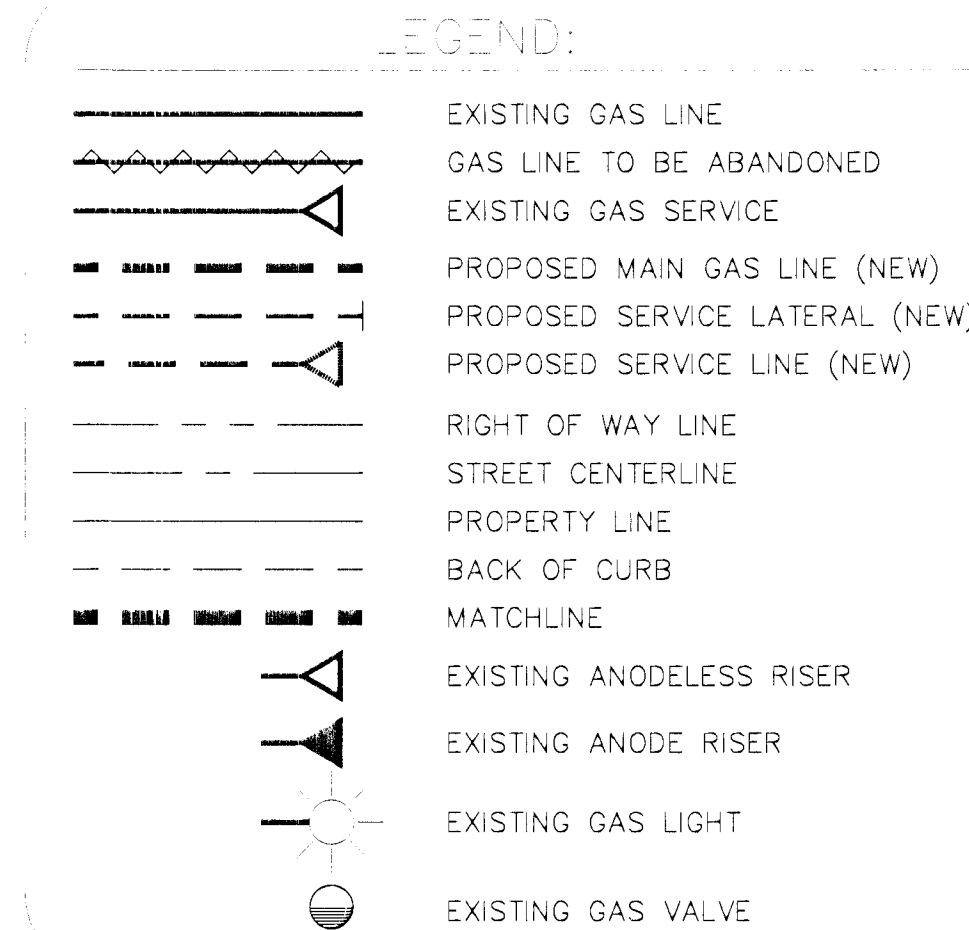
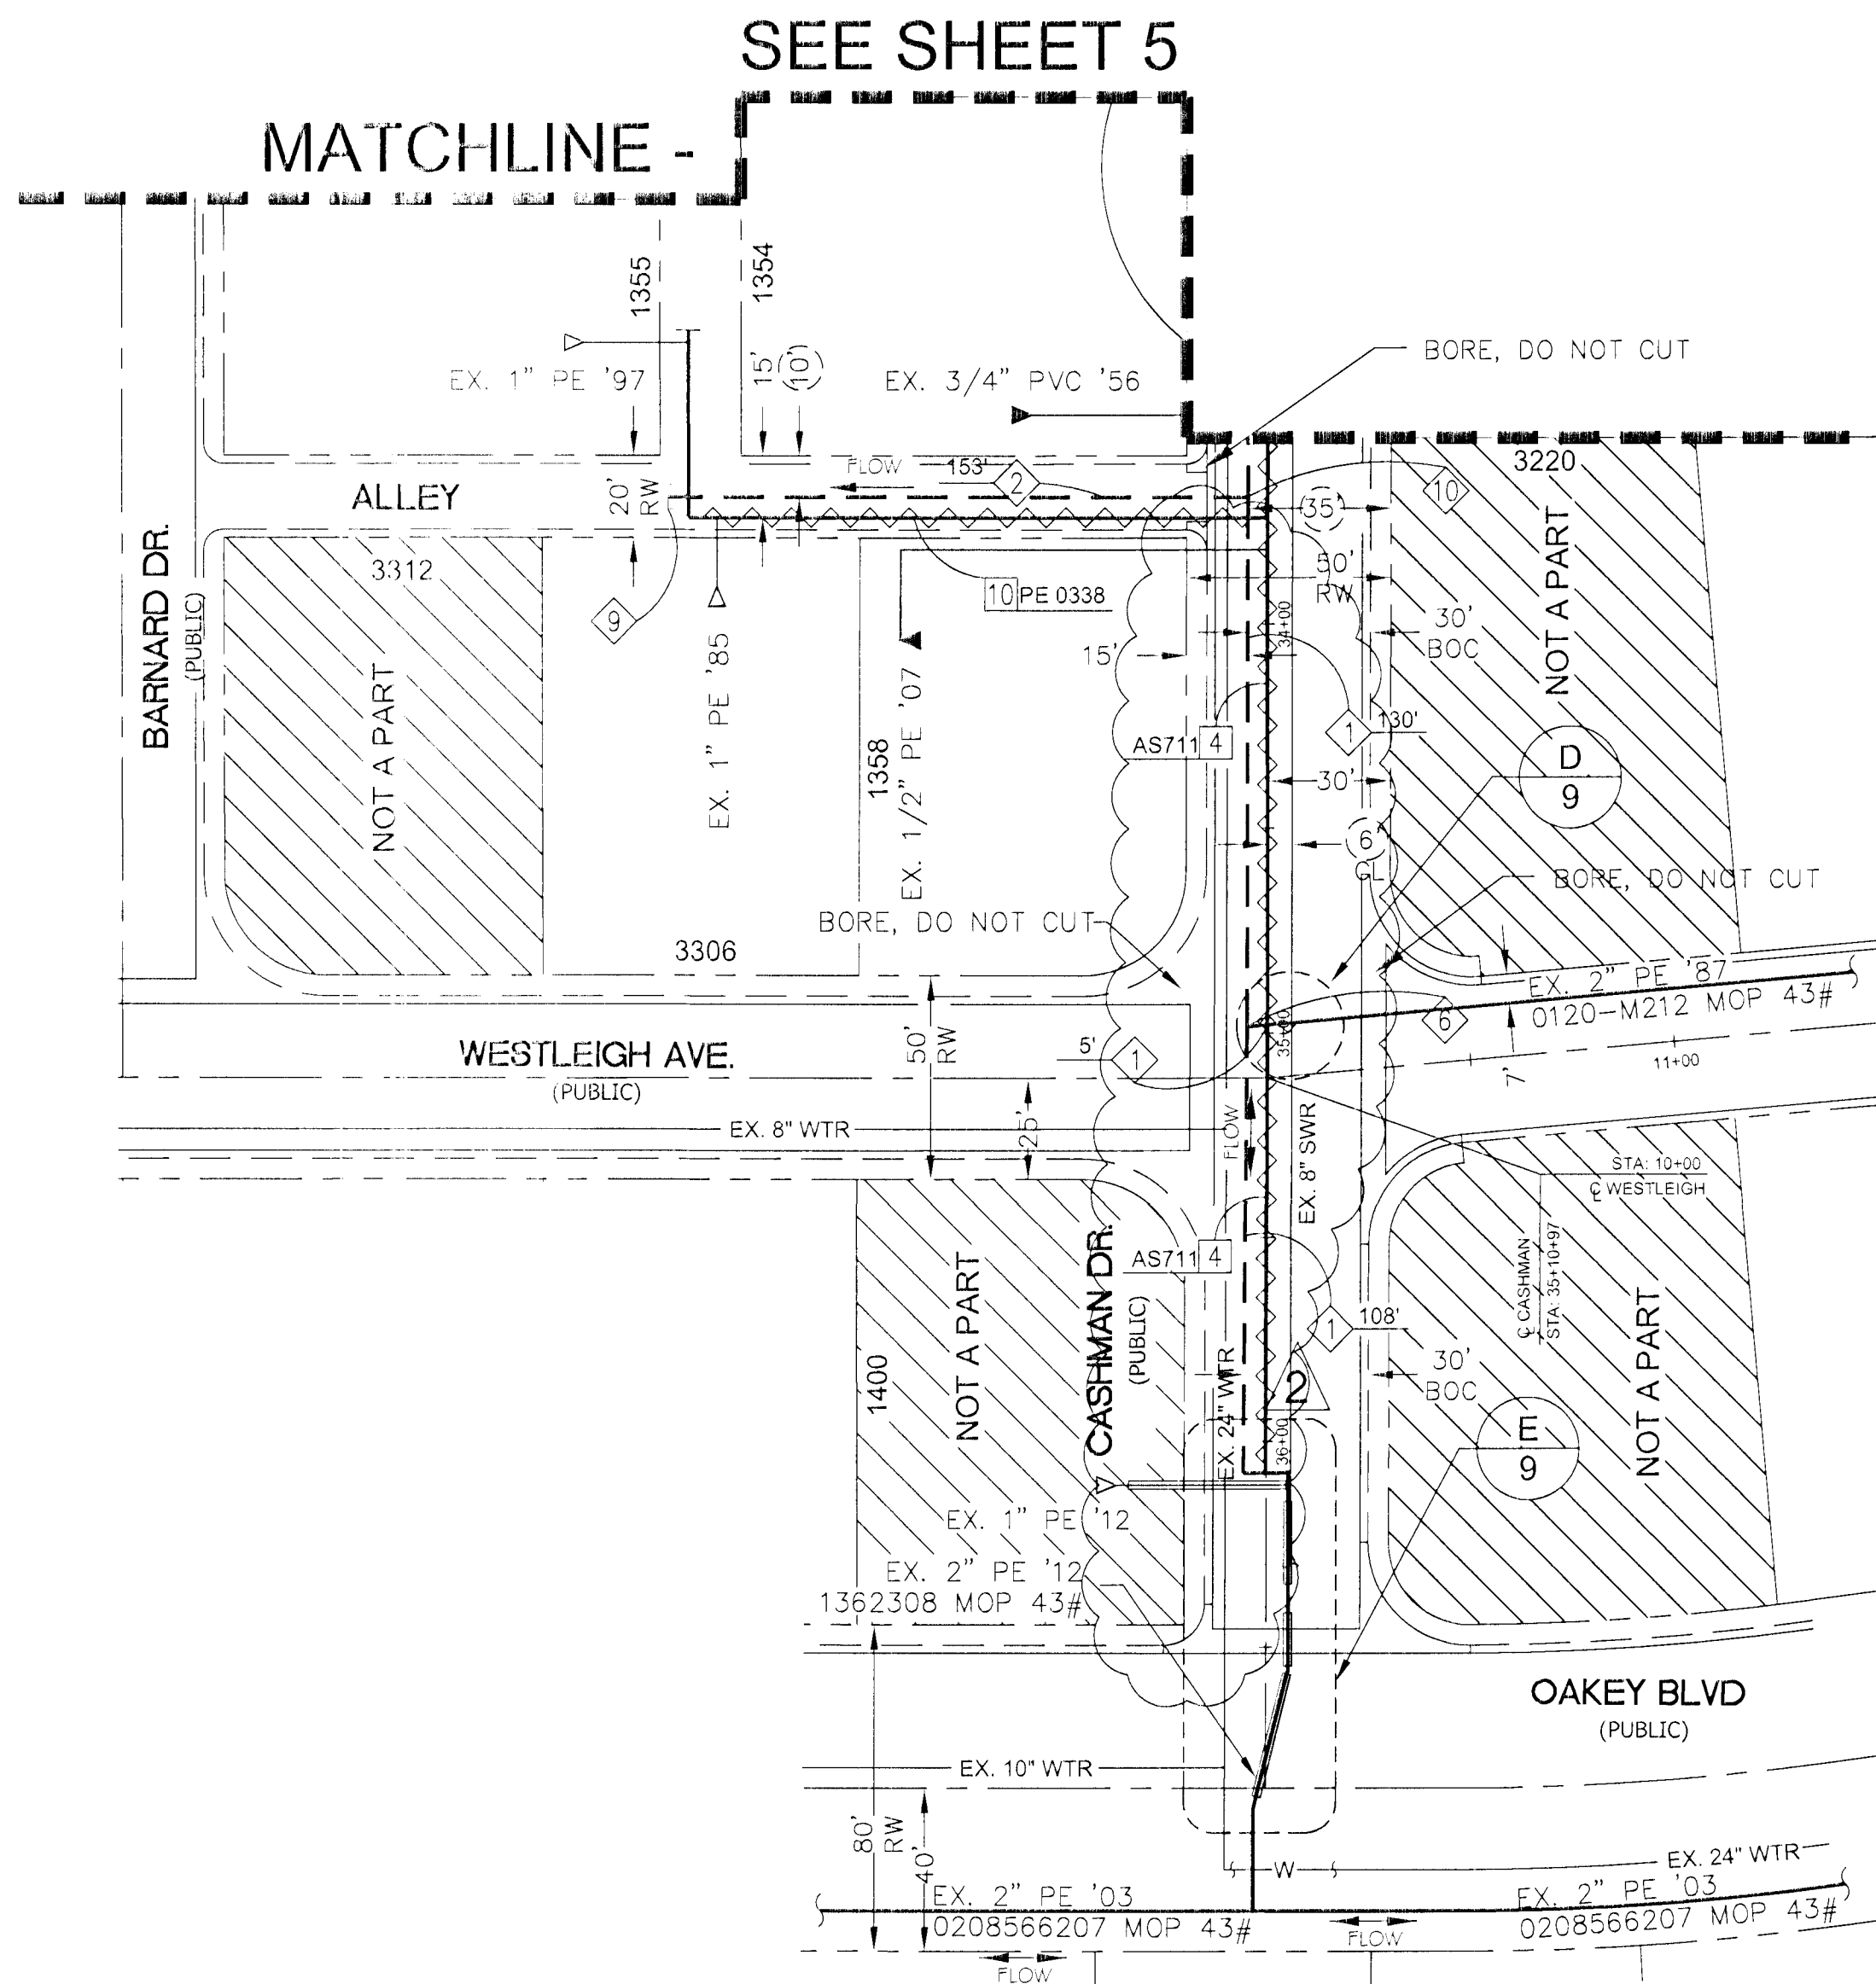


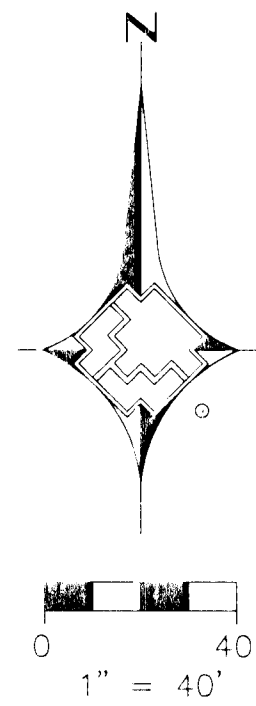


ABANDONED FACILITIES:

- 4 ABANDON EX. 2" STL '56 MOP 43#
- 10 ABANDON EX. 1" PVC '56 MOP 43#

PROPOSED FACILITIES:

- 1 PROPOSED 2" PE MAIN
- 2 PROPOSED 1" PE MAIN
- 9 PROPOSED 1" PE CAP #850-8773
- 10 PROPOSED 2" x 2" x 1" PE REDUCING TEE #140-5357

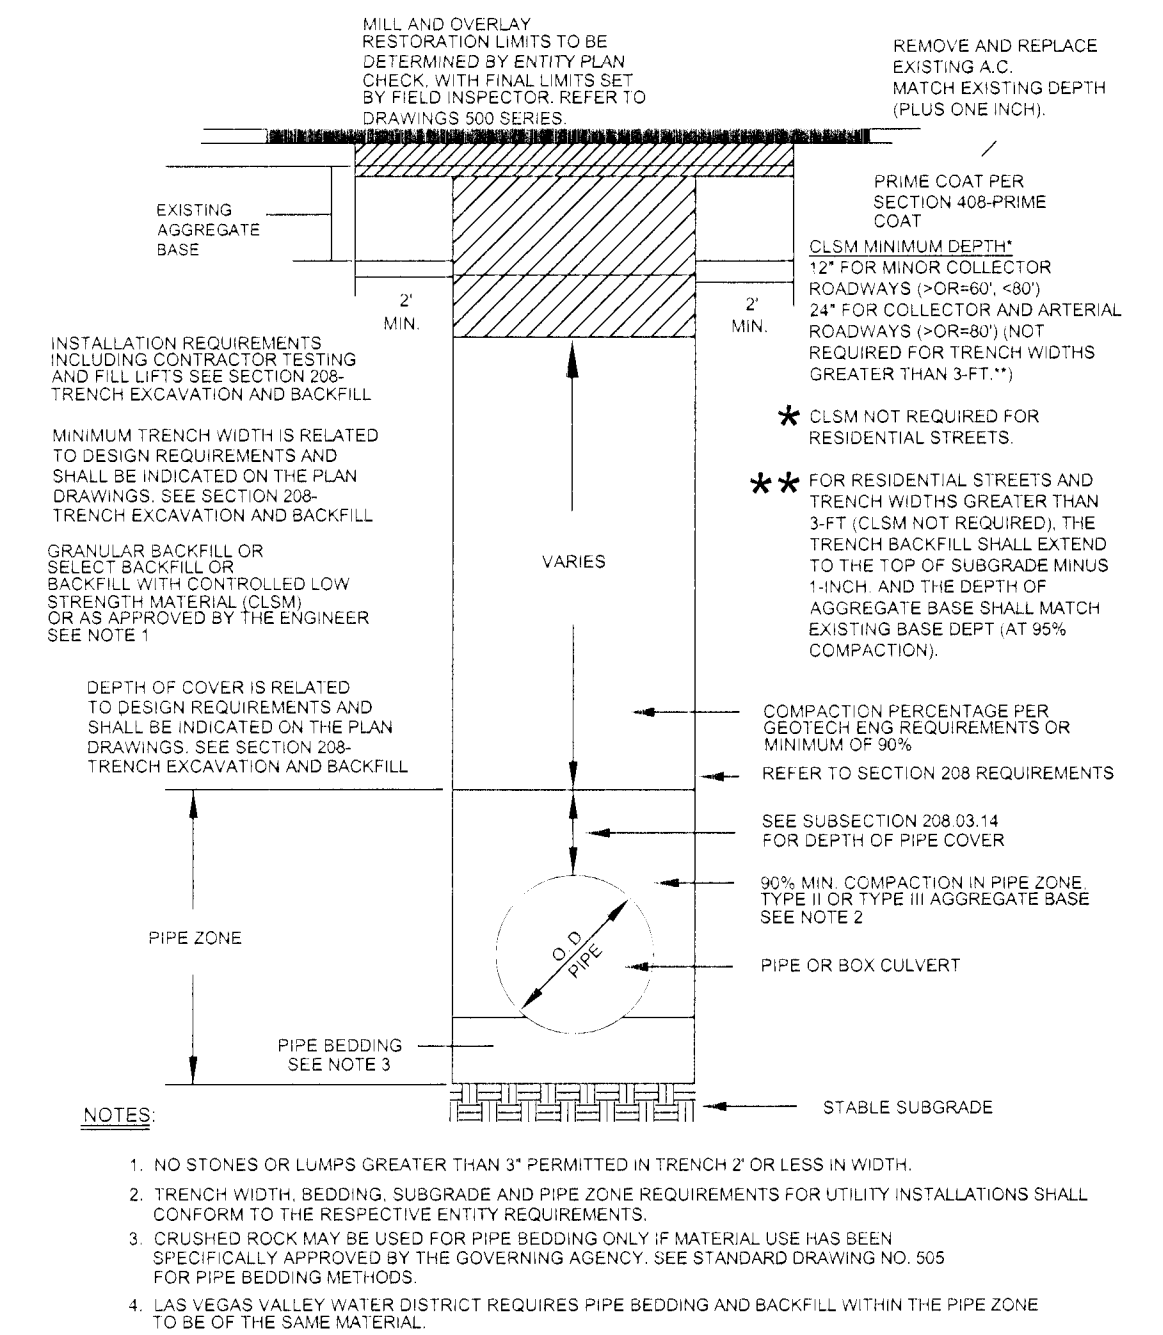

RTC STD DWG 503

PE Plot



REV. LOC. OF MAIN

7-15-13 PK

AS-BUILT DRAWING-PRESSURE TEST DATA

VISUAL INSPECTION CERTIFICATION

CONSTRUCTION

95

1521082

PERMIT INFORMATION

CLV

TAX CODE
02-0200

T21S
R61E
Sec. 5
M.D.M.

x615y512
x615y500

SI-CLV-McNEIL MANOR 2A MAIN