


ABBREVIATIONS
(SEE CIV. SH. FOR COMPLETE LIST)
AC ASPHALTIC CONCRETE
ADJ ADJUST
AGG AGGREGATE
B/C BACK OF CURB
B/CR BEGINNING OF CURB RETURN
BEG BEGIN
B/SW BACK OF SIDEWALK
B/V BEGINNING OF VERTICAL CURVE
CATV CABLE TV
CCAUSS CLARK COUNTY AREA UNIFORM STANDARD DRAWING
CORFO CLARK COUNTY REGIONAL FLOOD CONTROL DISTRICT CENTERLINE
CL CITY OF LAS VEGAS
CMU CONCRETE MASONRY UNIT
C/O CLEAN OUT
COMI COMMUNICATIONS
CONC CONCRETE
CONDU CONDUIT
CULV CULVERT
D/C DEEPENED CURB
DIP DROP INLET
DIP DUCTILE IRON PIPE
DOM DOMESTIC
ELEC ELECTRIC
E/C END OF CURB
E/CR END OF CURB RETURN
ELEV ELEVATION
E/P EDGE OF PAVEMENT
E/V END OF VERTICAL CURVE
EX EXISTING
FAST FREEWAY & ARTERIAL SYSTEM OF TRANSPORTATION
FF FLOOR FINISH
FH FIRE HYDRANT
FL FLOW LINE
FO FIBER OPTICS
FS FINISHED SURFACE
GB GRADE BREAK
HDPE HIGH DENSITY POLYETHYLENE
HDL HEADWALL
HGL HYDRAULIC GRADE LINE
HP HIGH POINT
INV INVERT
IRR IRRIGATION
LAT LATERAL
LAF LINEAL FEET
LND LANDSCAPE
LT LEFT
LVWD LAS VEGAS VALLEY WATER DISTRICT
MAX MAXIMUM
MH MANHOLE
MIN MINIMUM
MTR METER
PB PULL BOX
PL PROPERTY LINE
PP POWER POLE
PROP PROPOSED
PVC POLY VINYL CHLORIDE PIPE
PMT PAVEMENT
RIM TOP OF MANHOLE OR CLEANOUT
RT RIGHT
ROW RIGHT-OF-WAY
SS SANITARY SEWER
SD STORM DRAIN
SNWA SOUTHERN NEVADA WATER AUTHORITY
STA STATION
STLT STREET LIGHT
SVZ SIGHT VISIBILITY ZONE
SW SIDEWALK
TEL TELEPHONE
TC TOP OF CURB
TF TOP OF FOOTING
TW TOP OF WALL
TYP TYPICAL
UDACS UNIFORM DESIGN AND CONSTRUCTION STANDARDS
VG VALLEY GUTTER
WL WATER LINE

DESCRIPTION	EXISTING	PROPOSED
UTILITIES		
B.G. VALVE		
FIRE HYDRANTS		
CLEAN OUT		
GATE VALVE		
METER		
REDUCER		
CAP		
11.25' ELBOW		
22.5' ELBOW		
45' ELBOW		
90' ELBOW		
CROSS		
TEE		
MANHOLES		
ELECTRICAL		
SANITARY SEWER		
STORM DRAIN		
TELEPHONE		
STREET LIGHTS		
100W HPS STL		
150W HPS STL		
200W HPS STL		
250W HPS STL		
400W HPS STL		
GRADING		
SPOT ELEV.	(12.34)	12.34
SLOPE	(1.2%)	1.2%
5' CONT.	(2005)	2005
1' CONT.	(2002)	2002
SITE		
SIGN		
1" CURB		
2" CURB		
CODE OF PRACTICE		
WALL		
LINE TYPES		
CL OR SECTION LINE		
PROPERTY LINE		
RIGHT OF WAY LINE		
EASEMENT LINE		
SAVING LINE		
FLOW LINE		
SHADES		
HEAVY AD PAVEMENT		
LIGHT AD PAVEMENT		
CONCRETE PAVEMENT		

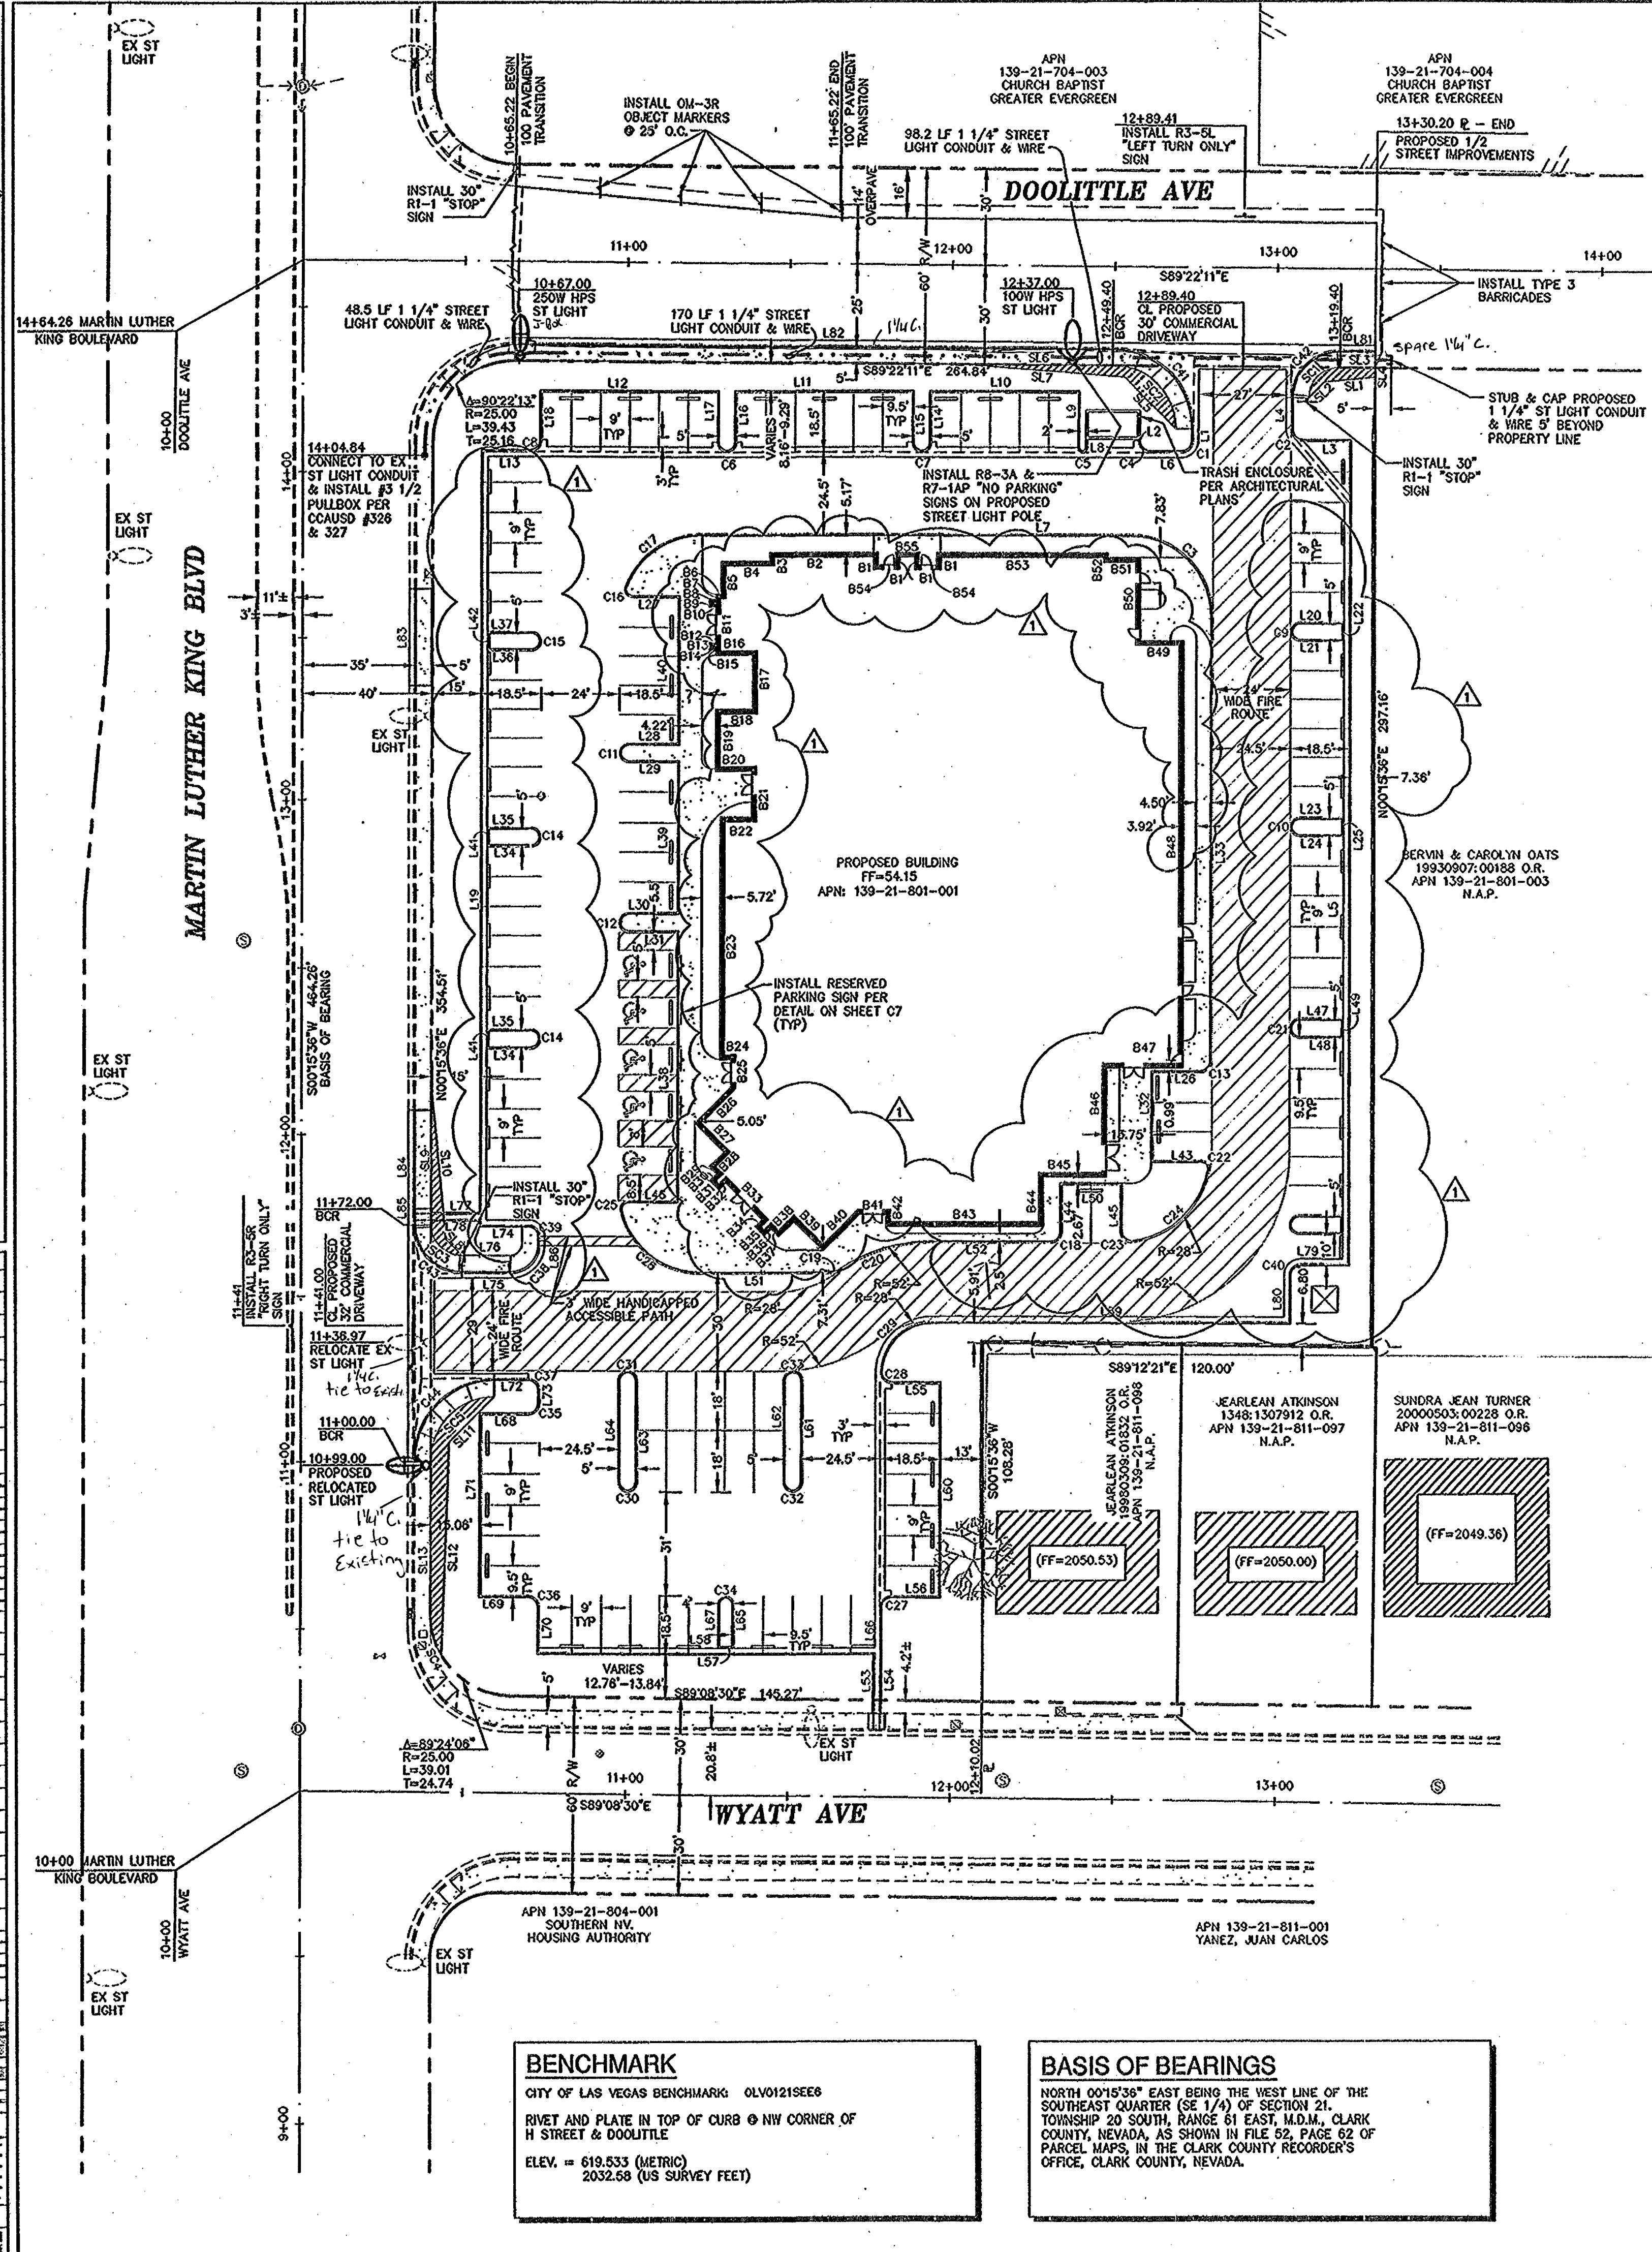

LINE	LENGTH	BEARING
B1	3.76	N0015°36'E
B2	33.33	S89°44'24\"E
B3	2.66	N0015°36'E
B4	15.00	S89°44'24\"E
B5	10.01	N0015°36'E
B6	1.82	S89°44'24\"E
B7	1.57	N0015°36'E
B8	1.99	S89°44'24\"E
B9	2.33	N0015°36'E
B10	1.59	S89°44'24\"E
B11	11.02	N0015°36'E
B12	1.99	S89°44'24\"E
B13	2.34	N0015°36'E
B14	1.99	S89°44'24\"E
B15	2.08	N0015°36'E
B16	11.42	N0015°36'E
B17	16.67	S89°44'24\"E
B18	11.42	S89°44'24\"E
B19	19.25	N0015°36'E
B20	11.19	S89°44'24\"E
B21	13.67	N0015°36'E
B22	9.68	S89°44'24\"E
B23	12.08	N0015°36'E
B24	3.50	S89°44'24\"E
B25	8.24	N0015°36'E
B26	15.74	N45°15'36\"E
B27	12.82	N44°44'24\"W
B28	6.42	N45°15'36\"E
B29	3.25	N44°44'24\"W
B30	3.00	N45°15'36\"E
B31	4.00	N44°44'24\"W
B32	13.33	N45°15'36\"E
B33	15.84	N44°44'24\"W
B34	3.00	N45°15'36\"E
B35	4.00	N44°44'24\"W
B36	3.33	S45°15'36\"E
B37	3.25	N44°44'24\"W
B38	6.42	S45°15'36\"E
B39	12.82	N44°44'24\"W
B40	15.85	S45°15'36\"E
B41	8.22	S89°44'24\"W
B42	3.57	N0015°36'E
B43	46.94	S89°44'24\"W
B44	15.08	S0015°36\"E
B45	15.85	S89°44'24\"W
B46	33.33	S0015°36\"E
B47	23.33	S89°44'24\"W
B48	128.84	S0015°36\"E
B49	13.33	S89°44'24\"E
B50	25.51	S0015°36\"E
B51	9.99	S89°44'24\"E
B52	12.82	S0015°36\"E
B53	62.87	S89°44'24\"E
B54	5.33	S89°44'24\"E
B55	7.34	S89°44'24\"E

LINE	LENGTH	BEARING
L81	10.80	S89°22'11\"E
L82	184.04	S89°22'11\"E
L83	29.70	N00°26'45\"E
L84	30.68	N00°01'18\"W
L85	5.00	S00°15'36\"W

CURVE	LENGTH	RADIUS	DELTA	TANGENT
C41	38.48	24.50	90°00'00\"	24.50
C42	22.87	14.50	90°22'13\"	14.59
C43	22.78	14.50	90°00'00\"	14.50
C44	38.48	24.50	90°00'00\"	24.50

CURVE	LENGTH	RADIUS	DELTA	TANGENT
C1	4.69	3.00	89°37'47\"	2.98
C2	4.71	3.00	90°00'00\"	3.00
C3	38.48	24.50	90°00'00\"	24.50
C4	4.71	3.00	90°00'00\"	3.00
C5	3.14	1.00	180°00'00\"	-----
C6	7.85	2.50	180°00'00\"	-----
C7	7.85	2.50	180°00'00\"	-----
C8	4.71	3.00	90°00'00\"	3.00
C9	7.85	2.50	180°00'00\"	-----
C10	7.85	2.50	180°00'00\"	-----
C11	7.85	2.50	180°00'00\"	-----
C12	7.85	2.50	180°00'00\"	-----
C13	4.71	3.00	90°00'00\"	3.00
C14	7.85	2.50	180°00'00\"	-----
C15	7.85	2.50	180°00'00\"	-----
C16	3.87	2.00	110°49'33\"	2.90
C17	28.58	24.50	89°10'27\"	16.89
C18	4.71	3.00	90°00'00\"	3.00
C19	2.92	5.00	33°24'24\"	1.50
C20	30.61	52.50	33°24'24\"	15.75
C21	7.85	2.50	180°00'00\"	-----
C22	3.52	2.00	100°55'34\"	2.42
C23	5.14	3.00	98°12'48\"	3.46
C24	34.01	27.50	70°51'39\"	19.57
C25	3.59	2.00	102°50'23\"	2.51
C26	32.99	24.50	77°02'37\"	19.54
C27	4.71	3.00	90°00'00\"	3.00
C28	4.83	3.00	92°17'43\"	3.12
C29	23.73	15.50	87°42'17\"	14.89
C30	7.85	2.50	180°00'00\"	-----
C31	7.85	2.50	180°00'00\"	-----
C32	7.85	2.50	180°00'00\"	-----
C33	7.85	2.50	180°00'00\"	-----
C34	6.28	2.00	180°00'00\"	-----
C35	4.71	3.00	90°00'00\"	3.00
C36	4.71	3.00	90°00'00\"	3.00
C37	4.71	3.00	90°00'00\"	3.00
C38	13.35	8.50	90°00'00\"	8.50
C39	4.71	3.00	90°00'00\"	3.00
C40	4.71	3.00	90°00'00\"	3.00

INDICATES FIRE LANE CURB TO BE PAINTED RED PER CLV FIRE DEPARTMENT SPECIFICATIONS

LINE	LENGTH	BEARING
L1	3.51	S00°37'49\"W
L2	3.00	N0015°36\"E
L3	15.00	N89°44'24\"W
L4	8.70	N0015°36\"E
L5	25.00	N0015°36\"E
L6	8.83	S89°44'24\"E
L7	132.64	S89°44'24\"E
L8	2.50	S0015°36\"W
L9	17.00	S0015°36\"W
L10	15.00	S89°44'24\"E
L11	55.00	S89°44'24\"E
L12	55.00	S89°44'24\"E
L13	15.00	S89°44'24\"E
L14	15.50	S0015°36\"W
L15	15.50	S0015°36\"W
L16	15.50	S0015°36\"W
L17	15.50	S0015°36\"W
L18	15.00	S0015°36\"W
L19	230.75	S0015°36\"W
L20	13.00	N89°44'24\"W
L21	13.00	N89°44'24\"W
L22	5.00	N0015°36\"E
L23	13.33	N89°44'24\"W
L24	13.00	N89°44'24\"W
L25	5.00	N0015°36\"E
L26	15.00	N89°44'24\"W
L27	14.53	N89°44'24\"W
L28	15.50	N89°44'24\"W
L29	15.50	N89°44'24\"W
L30	15.50	N89°44'24\"W
L31	15.50	N89°44'24\"W
L32	28.00	N0015°36\"E
L33	13.33	N0015°36\"E
L34	13.00	S89°44'24\"E
L35	13.00	S89°44'24\"E
L36	13.00	S89°44'24\"E
L37	13.00	S89°44'24\"E
L38	82.00	S0015°36\"W
L39	46.00	S0015°36\"W
L40	46.00	S0015°36\"W
L41	5.00	S0015°36\"W
L42	5.00	S0015°36\"W
L43	15.54	N89°44'24\"W
L44	15.00	N0015°36\"E
L45	14.75	N0015°36\"E
L46	15.44	N89°44'24\"W
L47	13.00	N89°44'24\"W
L48	13.00	N89°44'24\"W
L49	5.00	N0015°36\"E
L50	19.00	N89°44'24\"W
L51	40.34	N89°44'24\"W
L52	35.14	N89°44'24\"W
L53	15.00	S0015°36\"W
L54	18.06	S0015°36\"W
L55	14.39	N89°44'24\"W
L56	15.00	N89°44'24\"W
L57	4.00	N89°44'24\"W
L58	103.50	N89°44'24\"W
L59	110.14	N89°44'24\"W
L60	64.00	S0015°36\"W
L61	30.00	S0015°36\"W
L62	30.00	S0015°36\"W
L63	30.00	S0015°36\"W
L64	30.00	S0015°36\"W
L65	13.50	S0015°36\"W
L66	15.00	S0015°36\"W
L67	13.50	S0015°36\"W
L68	15.00	N89°44'24\"W
L69	15.00	N89°44'24\"W
L70	15.00	S0015°36\"W
L71	54.50	S0015°36\"W
L72	10.50	N89°44'24\"W
L73	4.00	S0015°36\"W
L74	15.00	S89°44'24\"E
L75	15.00	N89°44'24\"W
L76	0.75	S0015°36\"W
L77	15.00	S89°44'24\"E
L78	15.00	S89°44'24\"E
L79	15.00	N89°44'24\"W
L80	15.00	N0015°36\"E
L81	2.50	S0015°36\"W

LINE	LENGTH	BEARING
SL1	15.40	N85°28'09\"E
SL2	7.07	N45°26'43\"E
SL3	10.80	N89°22'11\"W
SL4	3.15	N0015°36\"E
SL5	22.18	N44°21'37\"W
SL6	45.00	S89°22'11\"E
SL7	50.46	N83°02'15\"W
SL8	7.03	N44°44'24\"W
SL9	43.50	S0015°36\"W
SL10	48.24	N05°07'46\"W
SL11	19.74	N45°15'36\"E
SL12	63.95	N02°07'40\"E
SL13	45.68	S0015°36\"W

CURVE	LENGTH	RADIUS	DELTA	TANGENT
SC1	14.98	9.50	90°22'13\"	9.58
SC2	30.63	19.50	90°00'00\"	19.50
SC3	14.92	9.50	90°00'00\"	9.50
SC4	13.31	25.00	30°30'26\"	6.82
SC5	30.63	19.50	90°00'00\"	19.50

GRAPHIC SCALE
(IN FEET)
1 inch = 30 ft.

VICINITY MAP

STOP
R1-1 (30")

R8-3A

ANY TIME
R7-1AP

ONLY
R3-5L

ONLY
R3-5R

OM-3R

street light As-Built
H#49860

Call before you dig
1-800-4-A-DIG
CLARK COUNTY TRAFFIC OPERATIONS
1-702-593-8111

Call before you dig
1-800-4-A-DIG
CLARK COUNTY TRAFFIC OPERATIONS
1-702-593-8111

Civilworks Inc.
Engineering with "sensible" solutions tailored to your "specific" needs.
Las Vegas, NV 89118
4945 W. Patrick Lane
Office#: (702)534-7555

CONSULTANT LIST:
URS Corporation
1100 D STREET
LAS VEGAS, NV 89106
PHONE: 702-648-1704
CONTACT: BISHOP JAMES ROGERS

OWNER/DEVELOPER:
NEW JERUSALEM CHURCH
AT MLK & DOOLITTLE
CHURCH BAPTIST NEW JERUSALEM
1100 D STREET
LAS VEGAS, NV 89106
PHONE: 702-648-1704
CONTACT: BISHOP JAMES ROGERS

HORIZONTAL CONTROL/TRAFFIC PLAN
SHEET #
C6
CLV#107V5992

PHILIP D. WAKEFIELD
PROFESSIONAL ENGINEER
No. 15468
8-26-13