
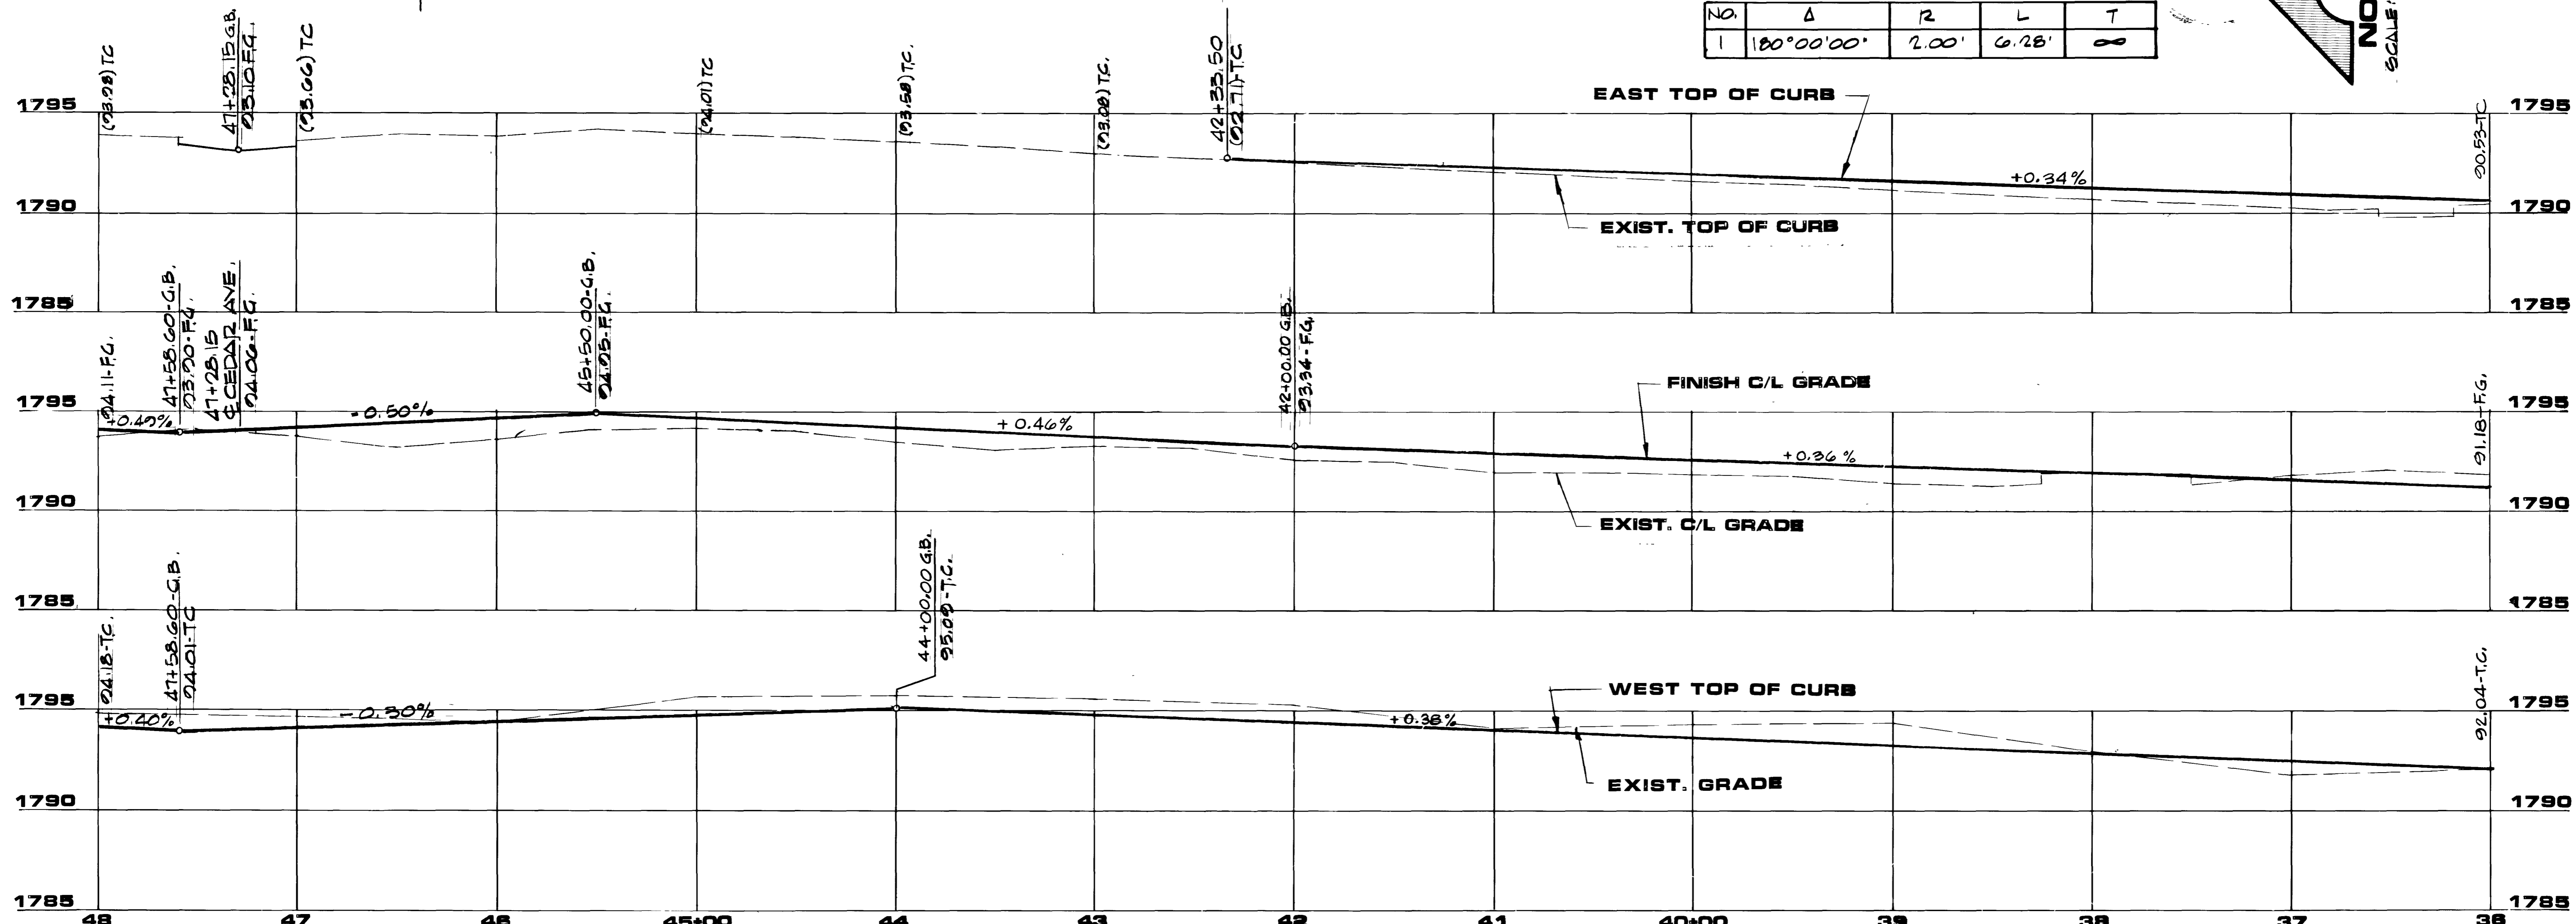


JOB NO. 412.160

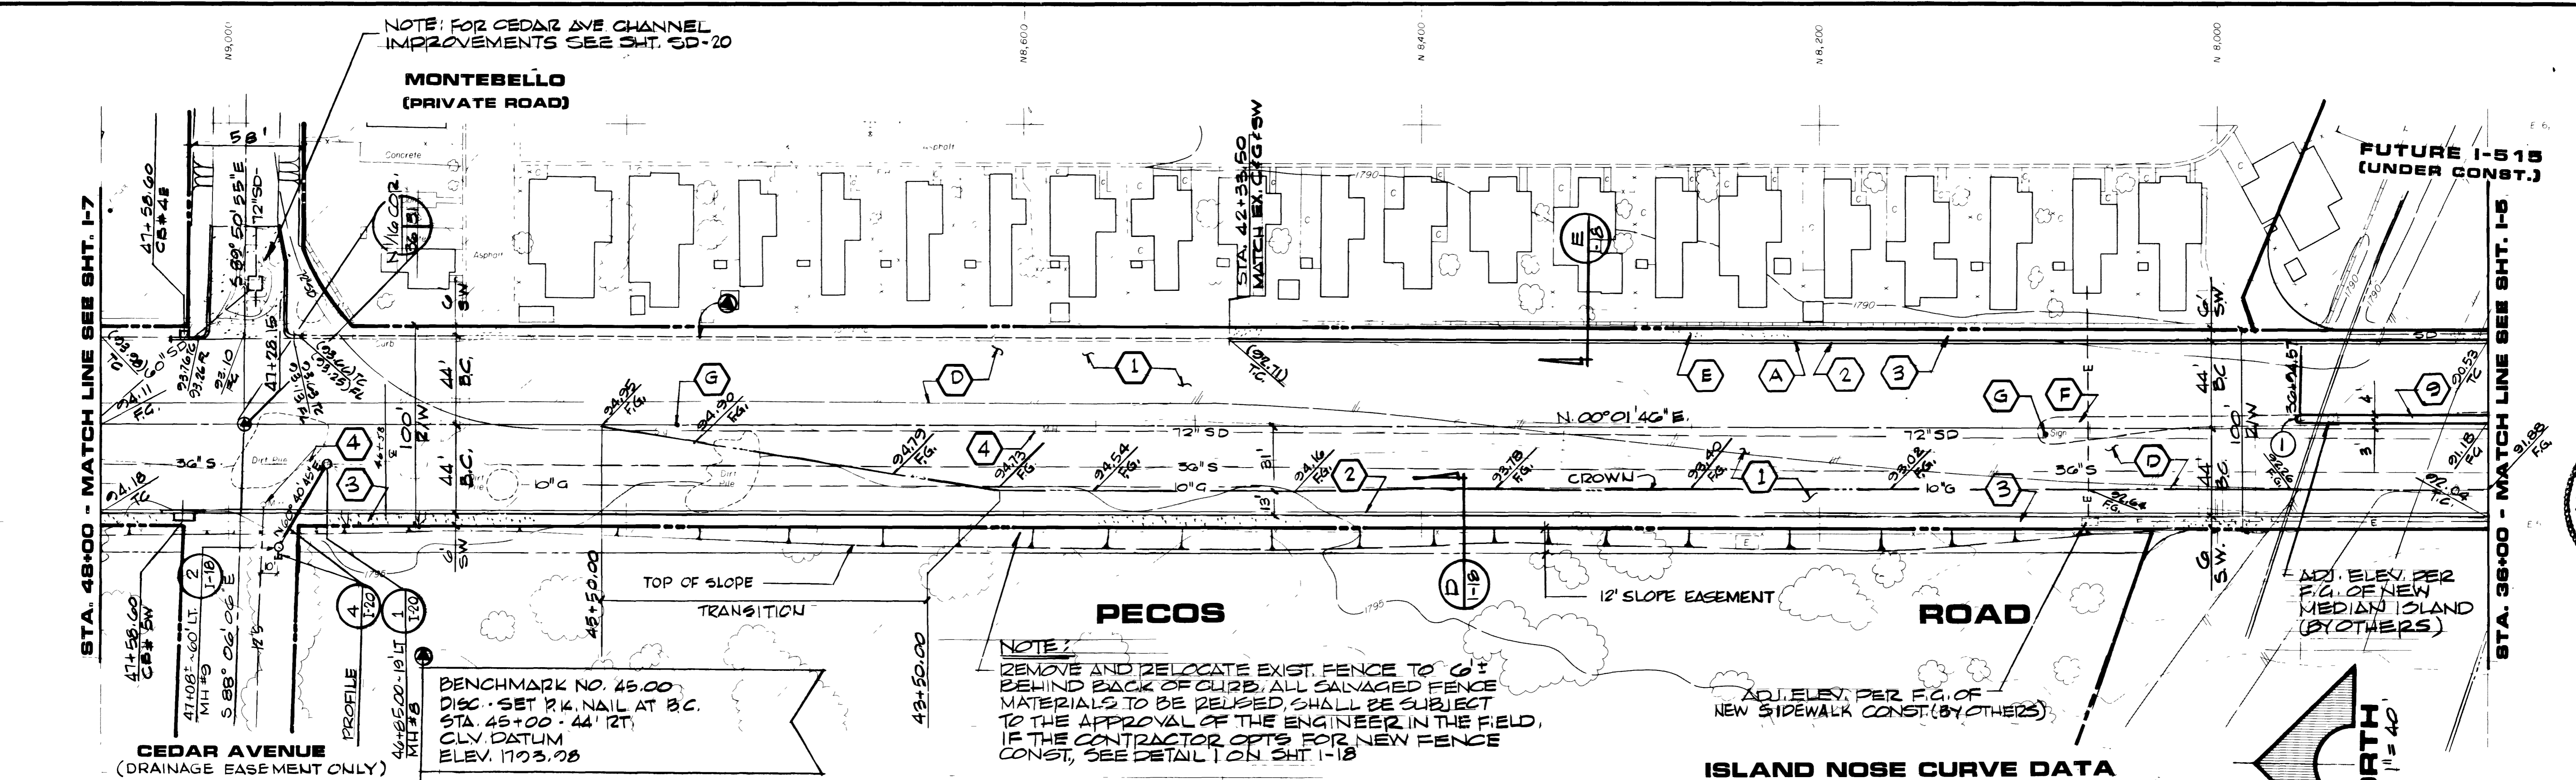

DEPARTMENT OF PUBLIC SERVICES
PECOS ROAD
PLAN & PROFILE
STA. 36+00 TO 48+00

G. C. WALLACE
Consulting Engineers, Inc.
1100 East Sahara Ave. • Las Vegas, Nevada 89104 • 732-3390

REVISIONS

NO.	DATE	DESCRIPTION
1	12/17/84	AS BUILT

REGISTERED PROFESSIONAL ENGINEER
STATE OF NEVADA
CIVIL
No. 1274

SHEET 1-6
OF 61 SHEETS

DATE JUN 11 1985

AS BUILT

2226

107-V-1248