


CITY OF LAS VEGAS NEVADA

OGDEN - MESQUITE AVENUE SEWER - 1965 -

<u>SHEET NO.</u>	<u>INDEX</u> <u>DESCRIPTION</u>
1	TITLE SHEET, KEY MAP, INDEX
2	PLAN & PROFILE, STA. 0+00 TO STA. 10+00
3	PLAN & PROFILE, STA. 10+00 TO STA. 20+00
4	PLAN & PROFILE, STA. 20+00 TO STA. 31+00
5	PLAN & PROFILE, STA. 31+00 TO STA. 40+00
6	PLAN & PROFILE, STA. 40+00 TO STA. 49+50
7	PLAN & PROFILE, STA. 49+50 TO STA. 58+60
8	PLAN & PROFILE, STA. 58+60 TO STA. 70+10
9	PLAN & PROFILE, STA. 70+10 TO STA. 81+60
10	PLAN & PROFILE, STA. 81+60 TO STA. 89+75
11	DETAILS

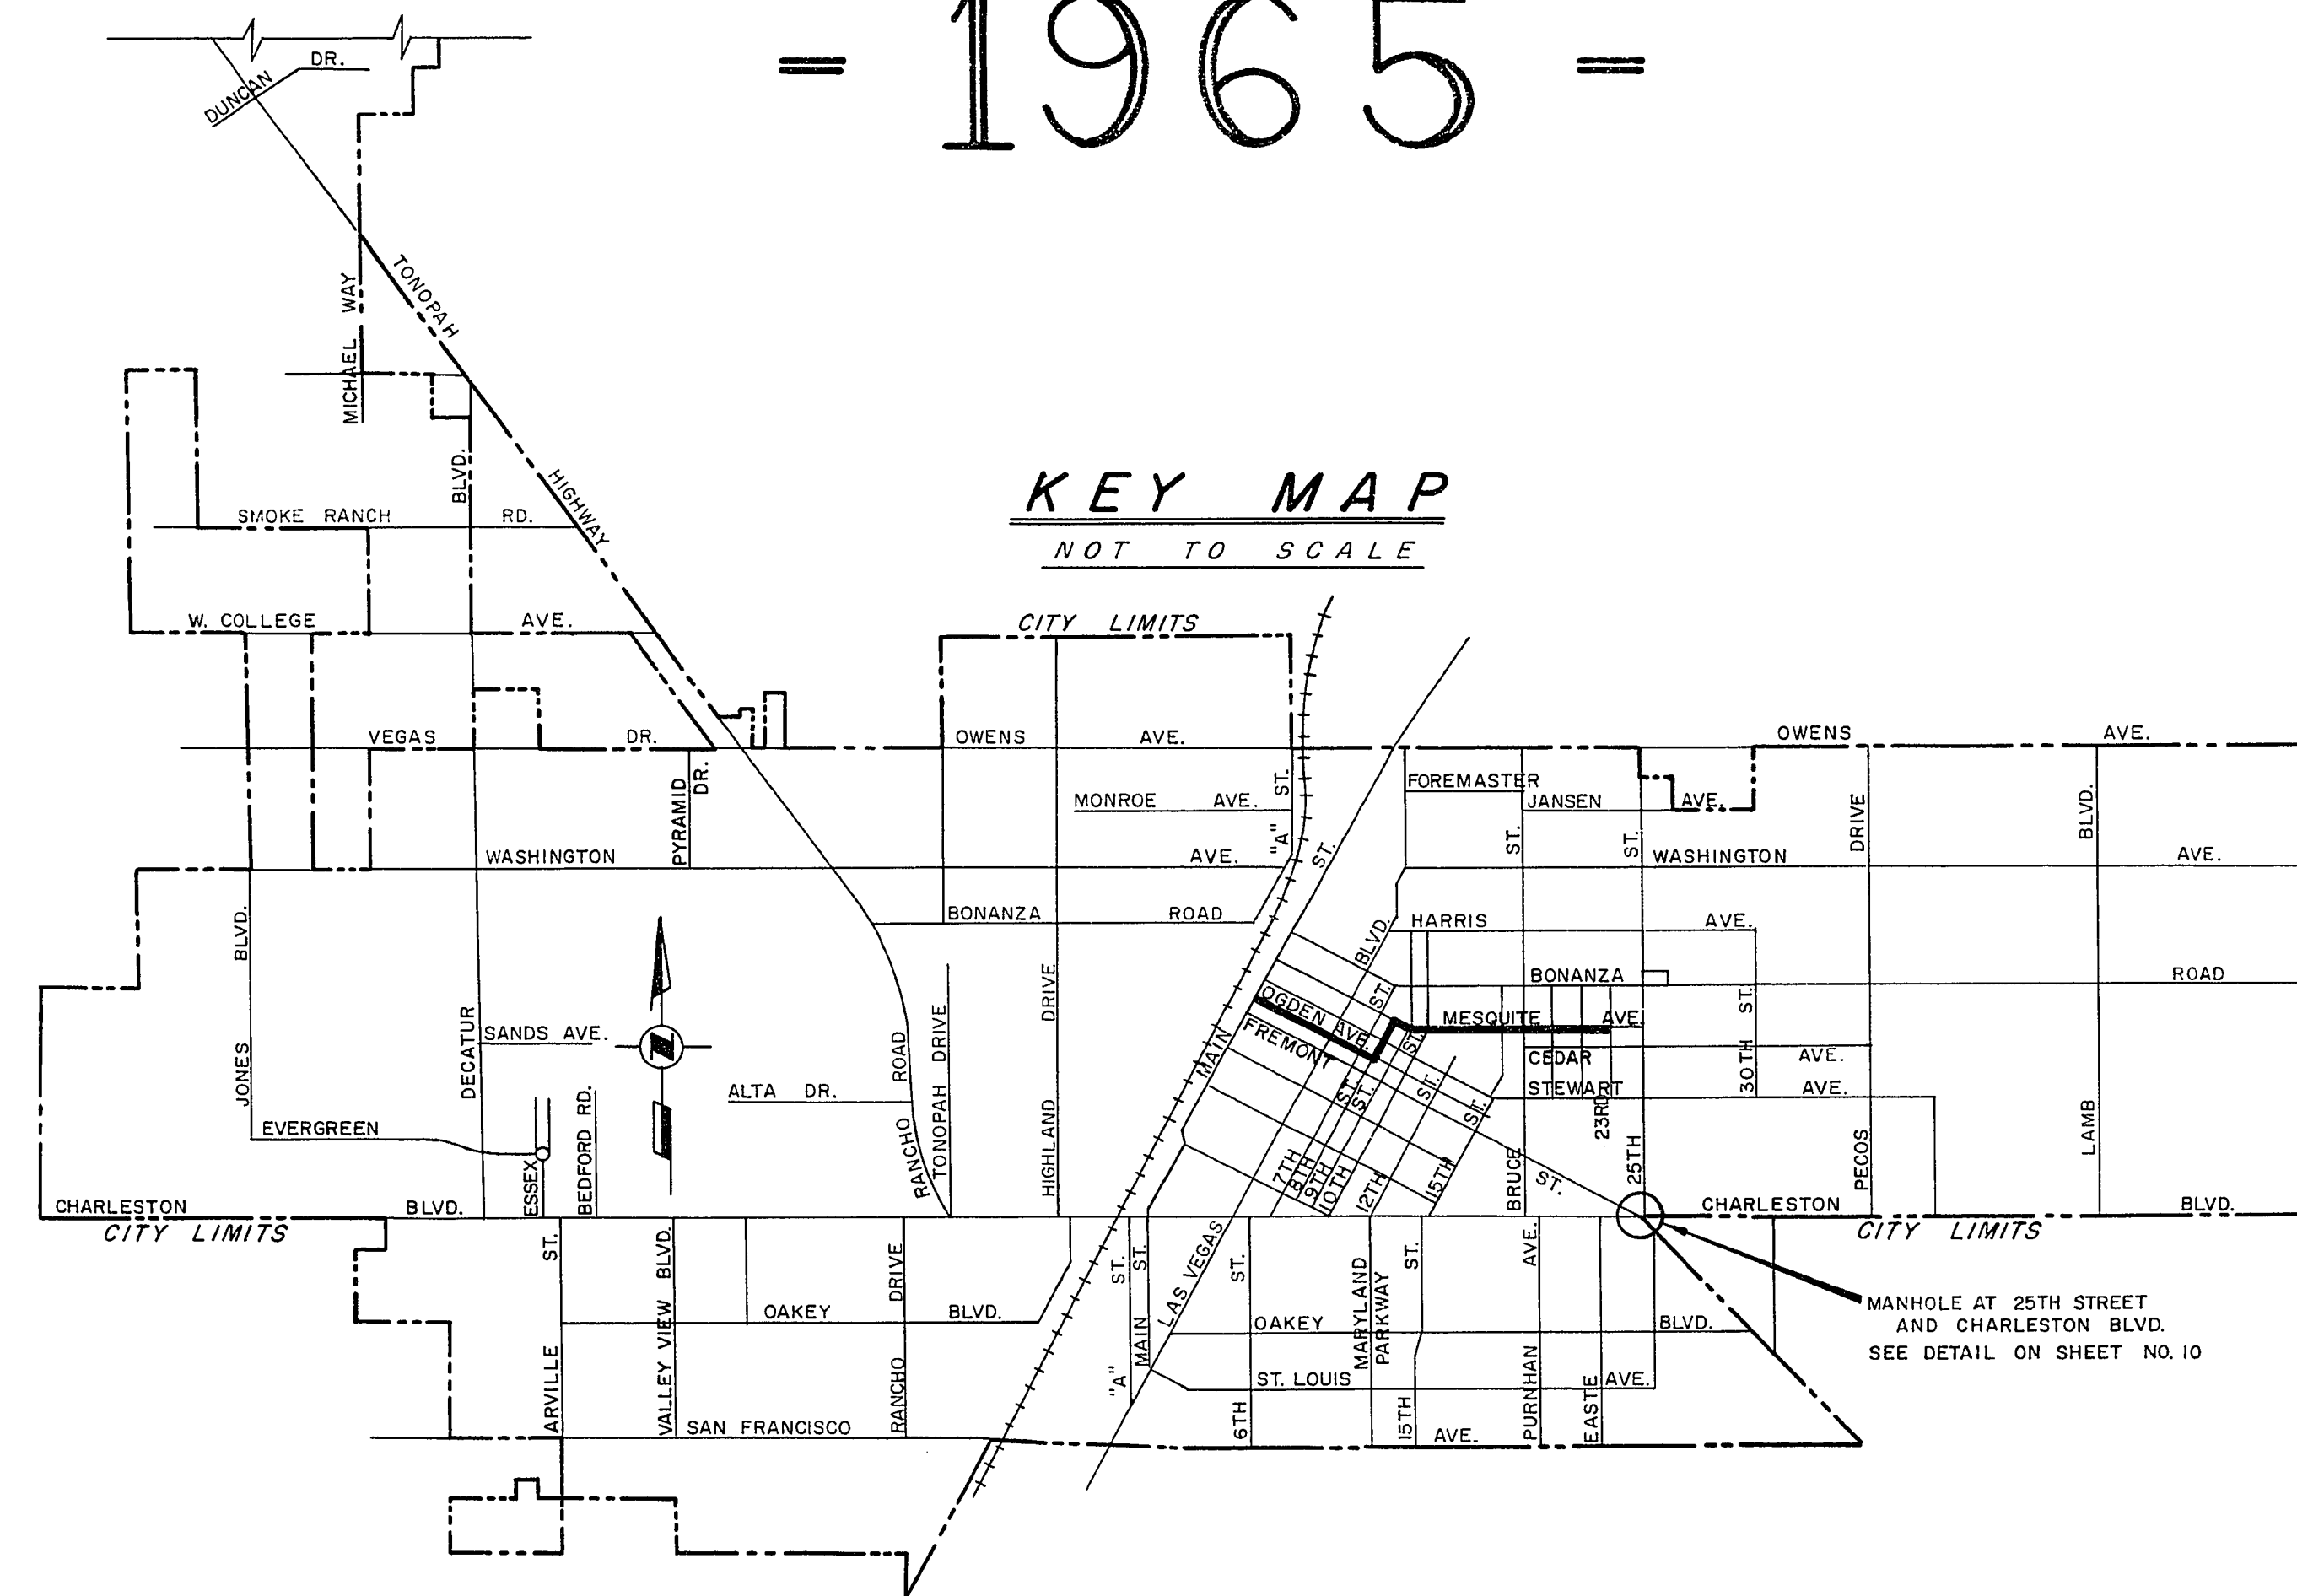

JOHN CAROLLO ENGINEERS
PHOENIX, ARIZONA


MAYOR
ORAN K. GRAGSON

COMMISSIONERS
E. W. FOUNTAIN
HARRY C. LEVY
PHILIP M. MIRABELLI
REED WHIPPLE

CITY MANAGER
A. R. TRELEASE

DIRECTOR OF PUBLIC WORKS
RICHARD P. SAUER

APPROVED
DIRECTOR OF PUBLIC WORKS
R. P. Sauer
R. P. SAUER
SUPERINTENDENT OF SANITATION
L. A. Anton
L. A. ANTON

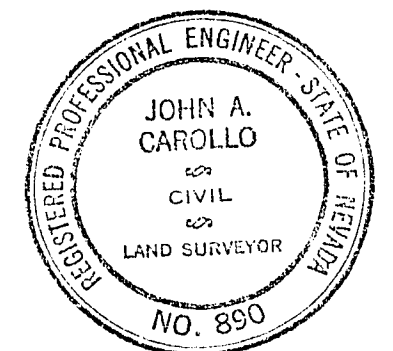


AS BUILT
CORRECTIONS MADE 12-10-65

DWG. NO. 7830B-1421.3
SHEET 1 OF 11

CITY OF LAS VEGAS
NEVADA

OGDEN - MESQUITE AVENUE
SEWER
- 1965 -

<u>SHEET NO.</u>	<u>INDEX</u>	<u>ABBREVIATION</u>
1	TITLE SHEET, KEY MAP, INDEX	
2	PLAN & PROFILE, STA. 0+00 TO STA. 30+00	
3	PLAN & PROFILE, STA. 30+00 TO STA. 40+00	
4	PLAN & PROFILE, STA. 40+00 TO STA. 51+00	
5	PLAN & PROFILE, STA. 51+00 TO STA. 60+00	
6	PLAN & PROFILE, STA. 60+00 TO STA. 65+00	
7	PLAN & PROFILE, STA. 65+00 TO STA. 70+00	
8	PLAN & PROFILE, STA. 70+00 TO STA. 75+00	
9	PLAN & PROFILE, STA. 75+00 TO STA. 81+40	
10	PLAN & PROFILE, STA. 81+40 TO STA. 88+00	
11	DETAILS	

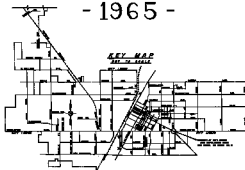

JOHN CAROLLO ENGINEERS
PHOENIX, ARIZONA

MAYOR

ORAN S. BRADSON

COMMISSIONERS

C.W. FOURTH
HARRY C. LEVY
PHILIP M. MIRABELLI
DEED WHIPPLE

CITY MANAGER

A.H. TRELKLE

DIRECTOR OF PUBLIC WORKS

RICHARD H. BAUER

APPROVED
DIRECTOR OF PUBLIC WORKS
[Signature]
BY
APPROVED BY ENGINEER
[Signature]
BY



AS BUILT
CORRECTED FROM 1965

JOHN CAROLLO
ENGINEER