


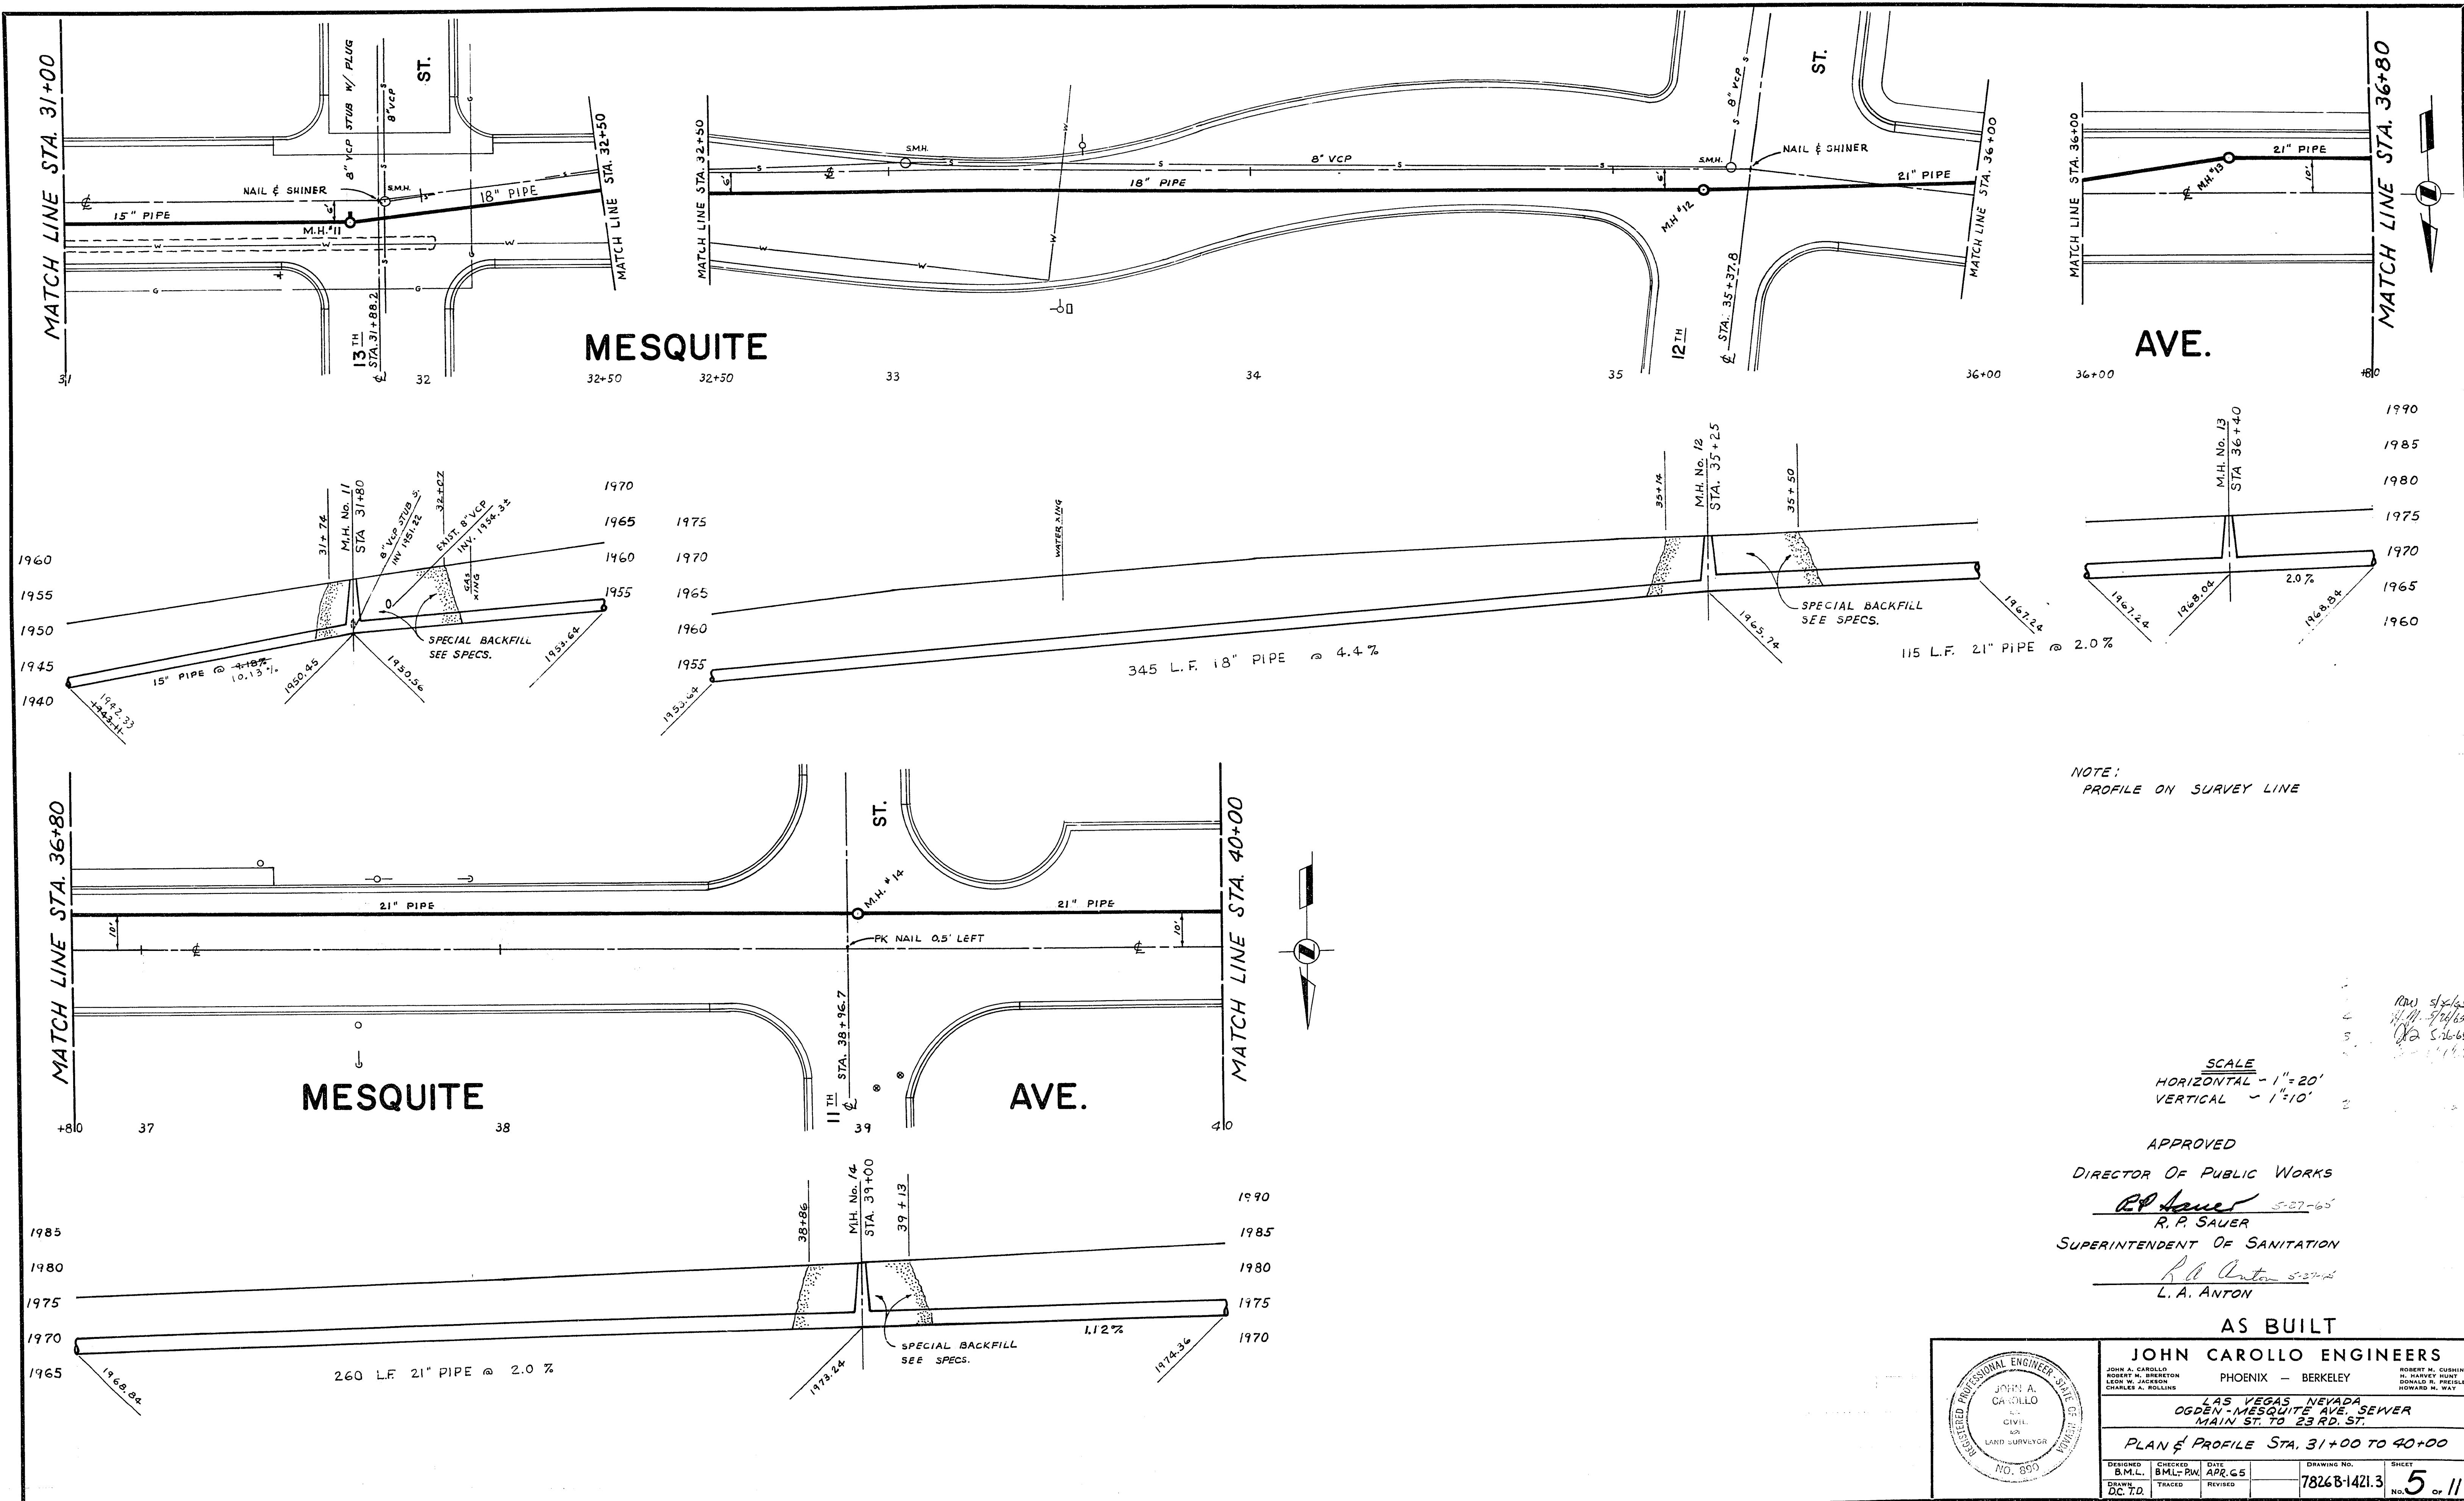

NOTE:
PROFILE ON SURVEY LINE

SCALE
HORIZONTAL - 1" = 20'
VERTICAL - 1" = 10'

APPROVED
DIRECTOR OF PUBLIC WORKS
R. P. SAUER 5-27-65
R. P. SAUER
SUPERINTENDENT OF SANITATION
L. A. ANTON 5-27-65
L. A. ANTON

AS BUILT

	JOHN CAROLLO ENGINEERS PHOENIX - BERKELEY LAS VEGAS, NEVADA OGDEN - MESQUITE AVE. SEWER MAIN ST. TO 23RD ST.		
	PLAN & PROFILE STA. 31+00 TO 40+00		
	DESIGNED B.M.L. DC 7.0	CHECKED B.M.L. PIN TRACED	DATE APR 65 REVISED
	DRAWING NO. 78268-1421.3	SHEET 5 of 11	

307-V 363