


NOTE:  
PROFILE ON SURVEY LINE

SCALE  
HORIZONTAL - 1" = 20'  
VERTICAL - 1" = 10'

APPROVED  
DIRECTOR OF PUBLIC WORKS  
*R. P. SAUER*  
SUPERINTENDENT OF SANITATION  
*L. A. ANTON*

AS BUILT

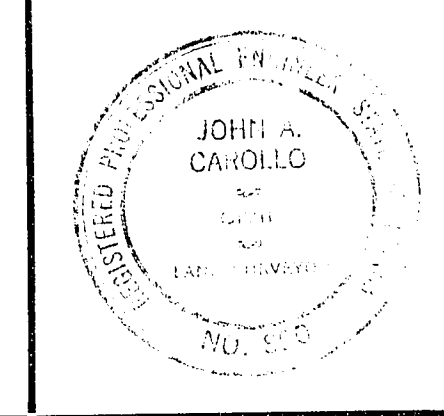

<b>JOHN CAROLLO ENGINEERS</b> PHOENIX - BERKELEY LAS VEGAS, NEVADA OGDEN - MESQUITE AVE. SEWER MAIN ST. TO 23 RD. ST. PLAN & PROFILE STA. 58+60 TO 70+10		JOHN A. CAROLLO ROBERT M. BRIDGEMAN KEON W. JACKSON CHARLES A. ROLLINS ROBERT M. CUSHING H. HARVEY HARRIS DONALD R. PRELLEGER HOWARD M. WATSON		
DESIGNED B.M.L.	CHECKED B.M.L./B.W.	DATE APR 05	DRAWING NO. 78238-1421.3	SHEET 8 OF 11

