


Peccole West

GOLF COURSE SEWER

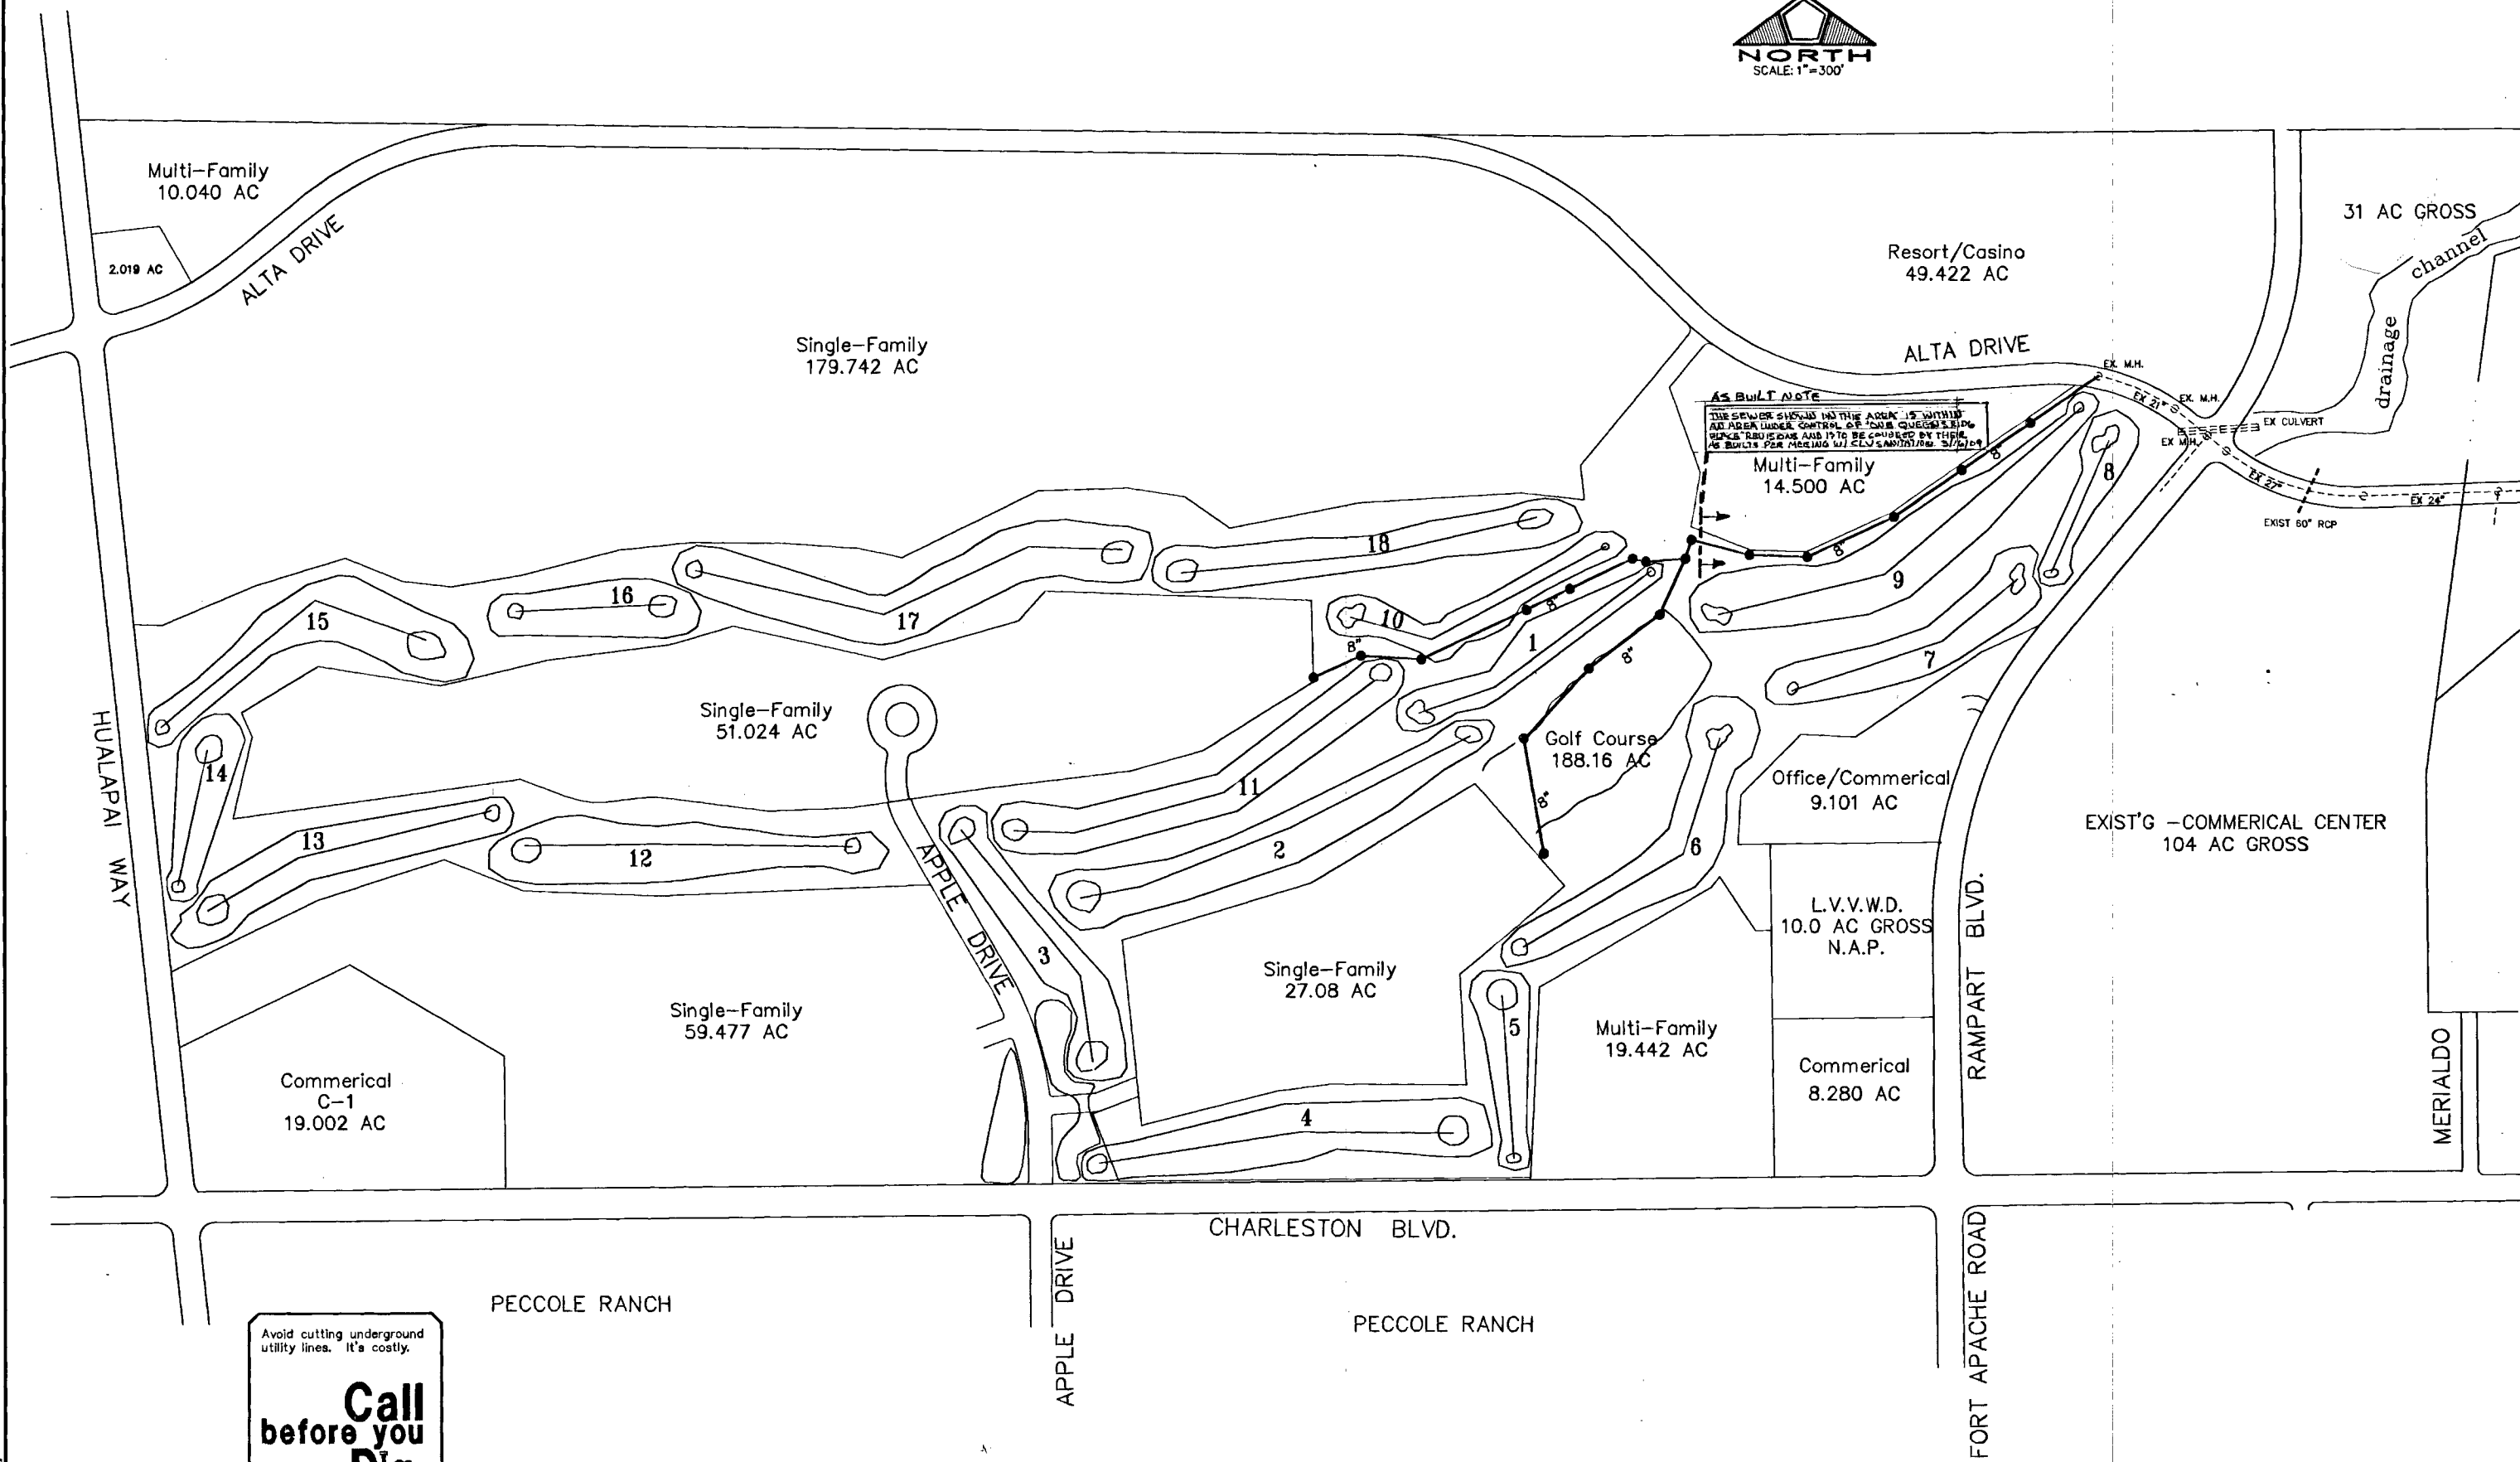

AS BUILT NOTE
 THE SEWER SHOWN IN THIS AREA IS WITHIN
 AN AREA UNDER CONTROL OF THE COURSE'S SLOPE
 PLANS. REVISIONS AND IS TO BE COVERED BY THE
 AS BUILT FOR MAKING W/ CLV'S NOTATION 3/1/99

Avoid cutting underground utility lines. It's costly.
Call before you Dig.
 1-800-227-2600
 UNDERGROUND SERVICE ALERT (USA)

NO.	DESCRIPTION	DATE	APP'D.

RECOMMENDED
 DRAWN BY: [Signature]
 CHECKED BY: DANIEL LA RUBIO
 R. E.V. 8/25
 DATE: 11-1-93

DATE: OCT. 27, 1995
 DRAWN BY:
 CHECKED BY:
 JOB NO.: 0145.0072
 SCALE: 1" = 300'

PENTACORE
 Engineering, Inc.
 6763 West Charleston Boulevard
 Las Vegas, Nevada 89102
 (702) 258-0115

PECCOLE NEVADA CORP.
 PECCOLE WEST
 GOLF COURSE SEWER
 MASTER SEWER PLAN

SHEET
3
 OF 9