



NORTH WALL
SCALE 1" = 10'-0"

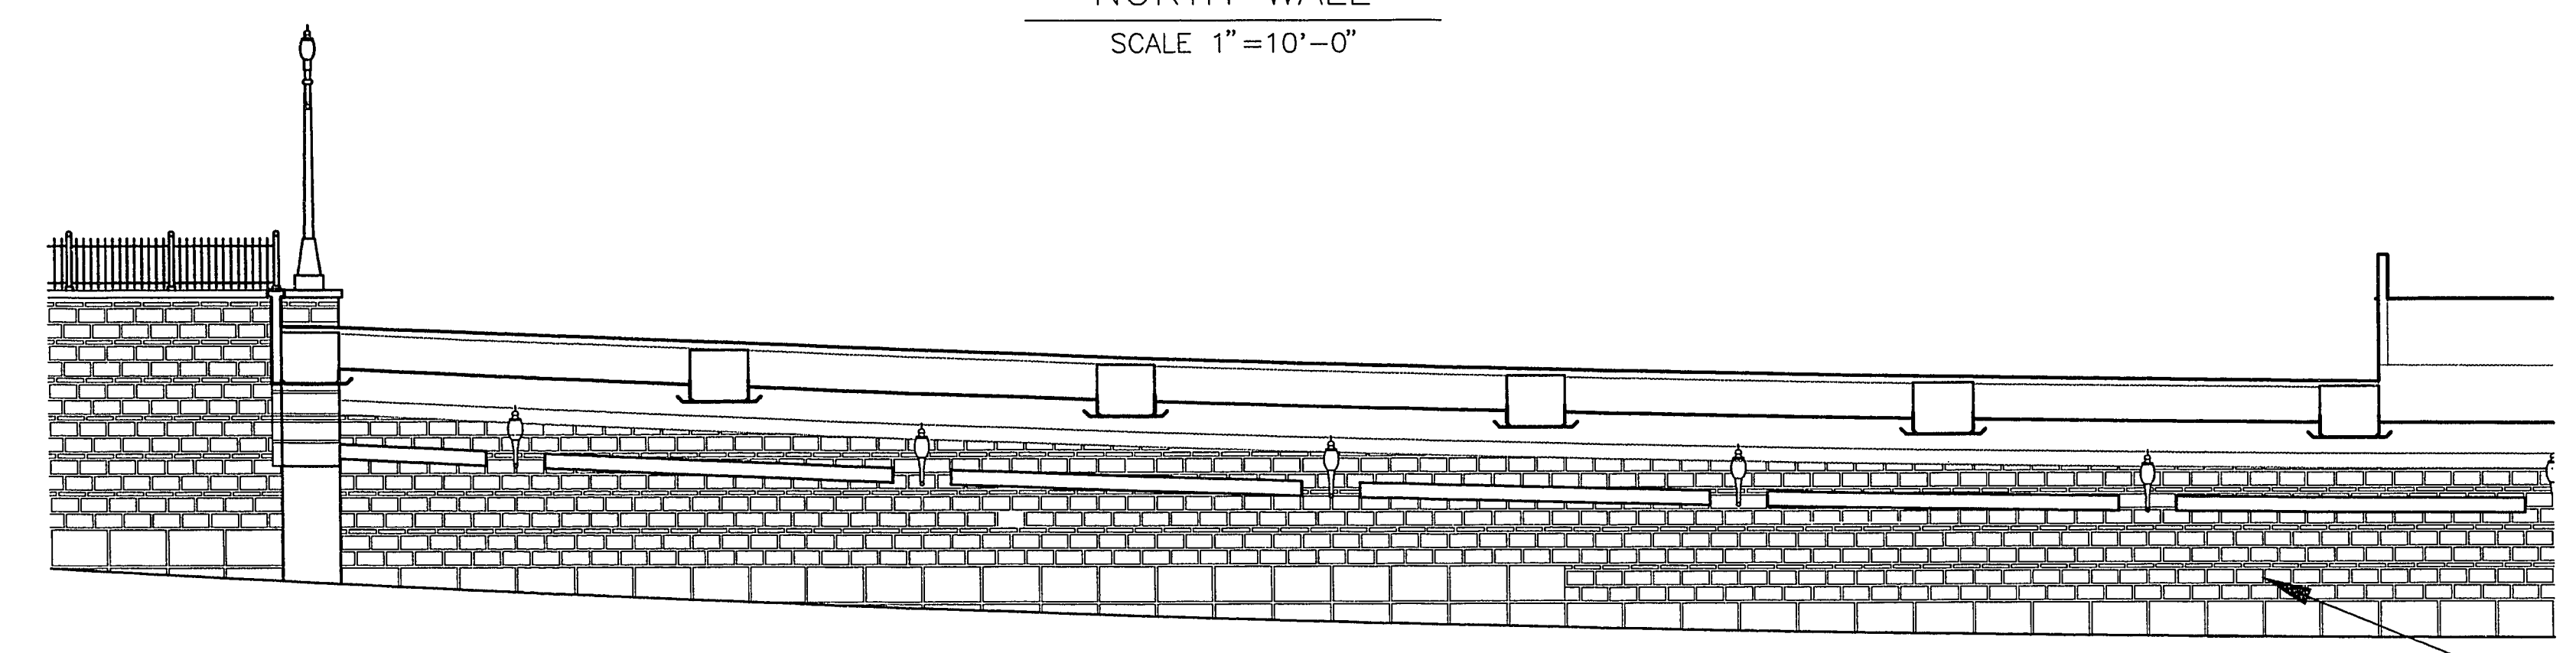

SOUTH WALL
SCALE 1" = 10'-0"

NOTE: WALL AND FORM LINER STEPS OCCUR IN THE SAME LOCATION AS IN THE NORTH WALL

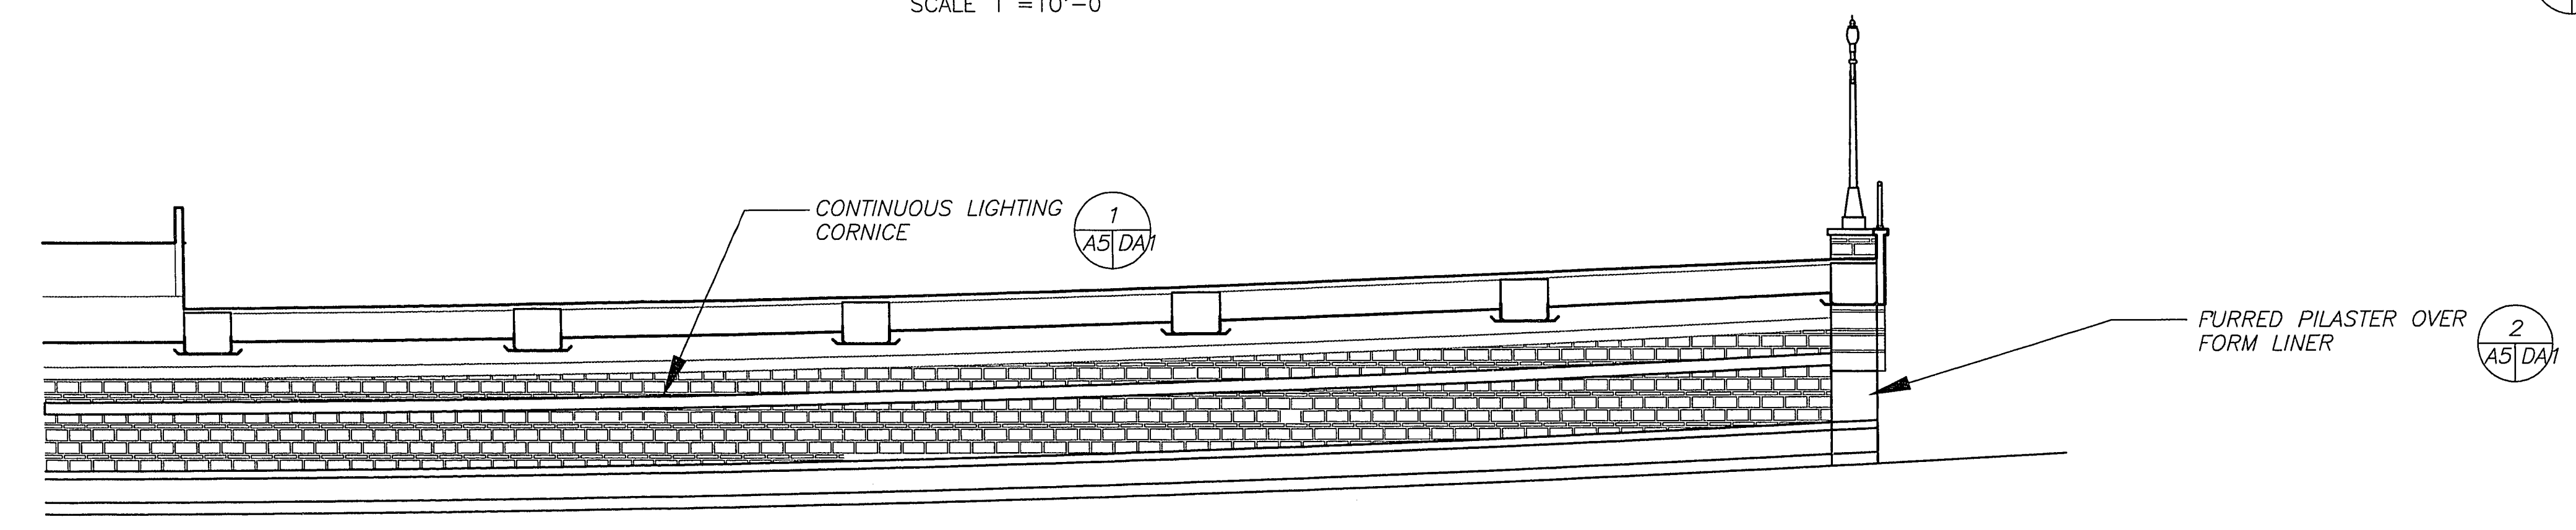

PIER WALL (TYPICAL BOTH SIDES)
SCALE 1" = 10'-0"

RECORD DRAWINGS

CLV DRAWING NO. 107-V2011

REISSUED 10-16-92 WITHOUT REVISION

FILENAME: OGD-A5.DWG
PLOT DATE: 10 SEPTEMBER 1992
PLOT BY: C. VENTURA

MARK	DATE	BY	REVISION

DESIGNED: GLB
DRAWN: CVT
CHECKED: GLB

PROJECT ENGINEER _____ DATE _____
PROJECT MANAGER _____ DATE _____

B Boyle Engineering Corporation
consulting engineers
Suite 300
1785 E. Sahara Ave.
Las Vegas, NV 89104
(702) 731-5511

CITY OF LAS VEGAS
DEPARTMENT OF PUBLIC WORKS

OGDEN AVENUE UNDERPASS AND ROADWAY
UNDERPASS ELEVATIONS
EASTERN HALF

DRAWING
A5
97 OF 125
OGD-A5

C:\VENM\OGDEN\ARCH\OGD-A5 Wed Nov 9 15:23:09 1994

3-2-97