



NORTH WALL
SCALE 1" = 10'-0"

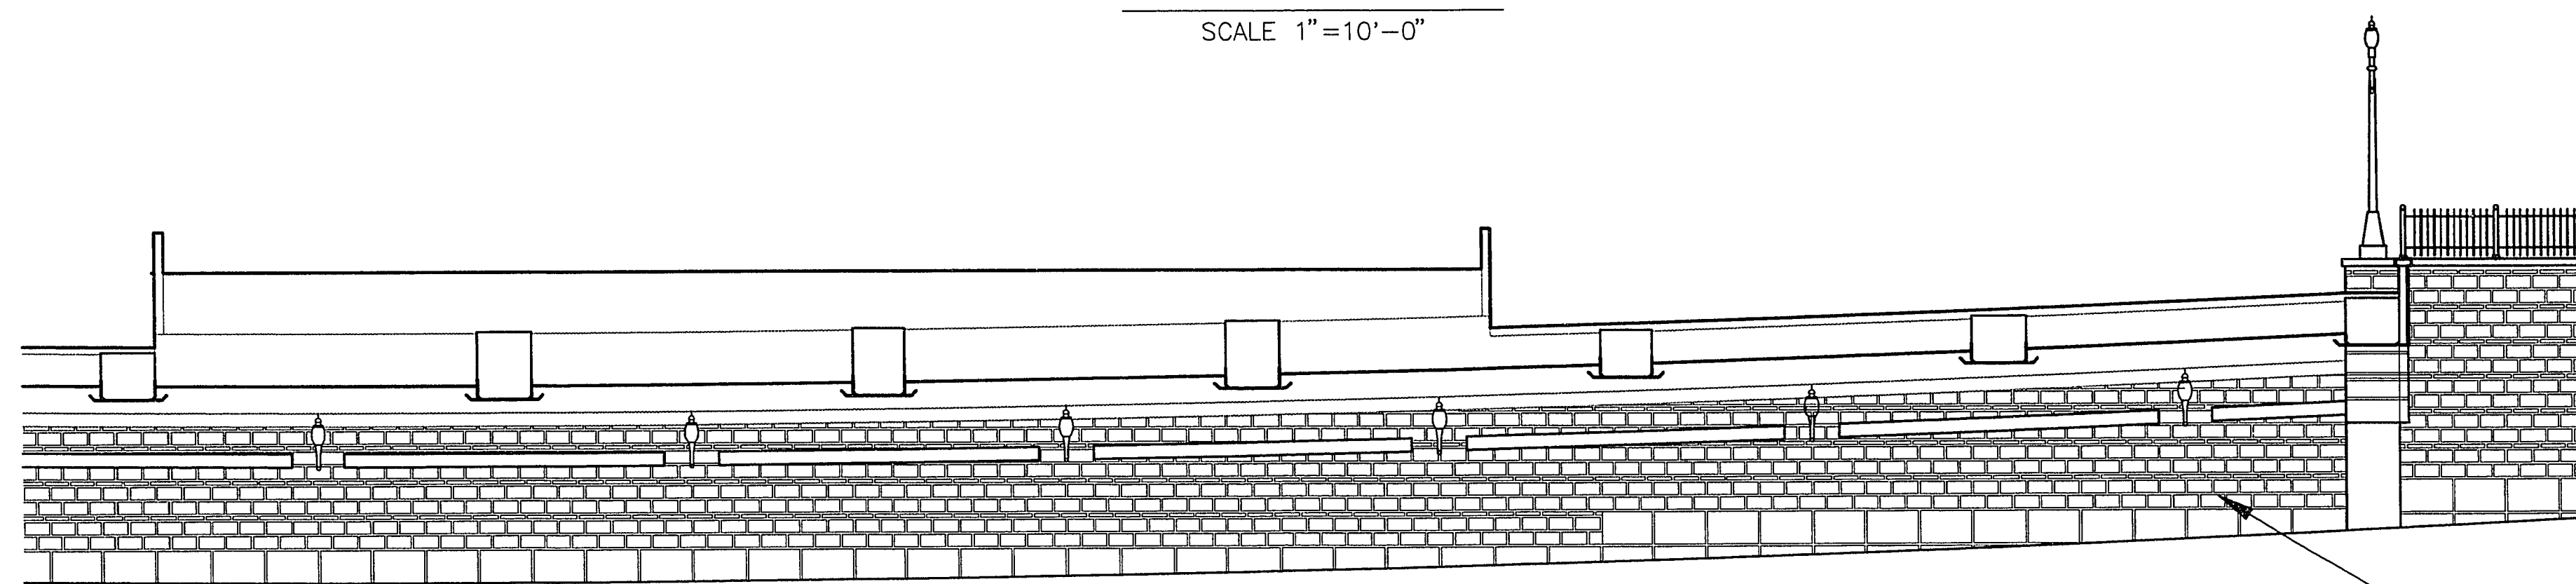

SOUTH WALL
SCALE 1" = 10'-0"

NOTE: WALL AND FORM LINER STEPS OCCUR IN THE SAME LOCATION AS IN THE NORTH WALL

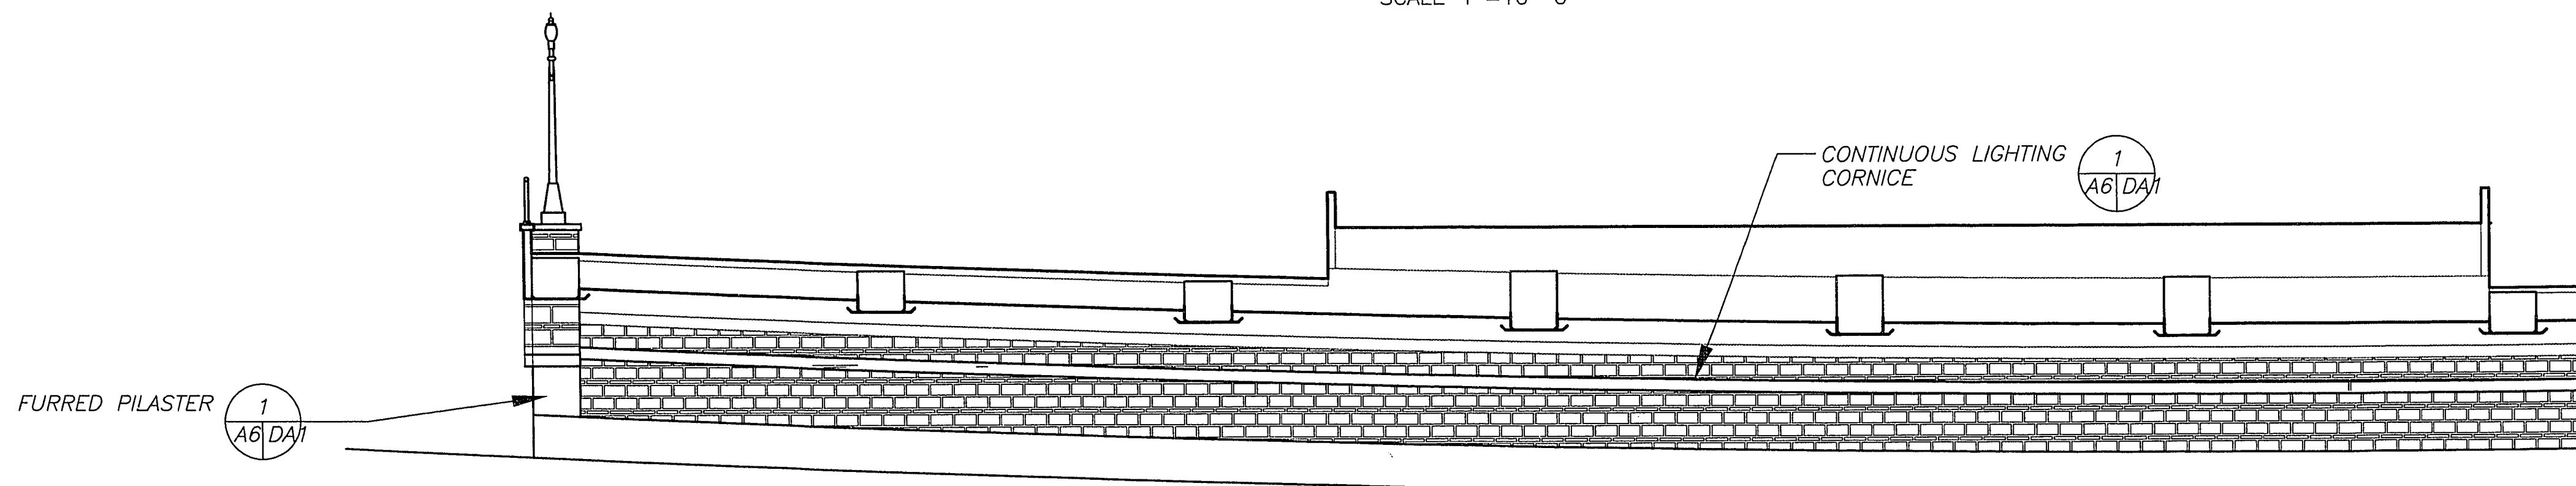

PIER WALL (TYPICAL BOTH SIDES)
SCALE 1" = 10'-0"

RECORD DRAWINGS

CLV DRAWING NO. 107-V2011

REISSUED 10-16-92 WITHOUT REVISION

FILENAME: OGD-A6.DWG
PLOT: 10 SEPTEMBER 1992
PLOT: 1410

MARK	DATE	BY	REVISION

DESIGNED: GLB	PROJECT ENGINEER _____ DATE _____
DRAWN: CVT	PROJECT MANAGER _____ DATE _____
CHECKED: GLB	

Boyle Engineering Corporation
consulting engineers
Suite 300
1785 E. Sahara Ave
Las Vegas, NV 89104
(702) 731-5511

CITY OF LAS VEGAS
DEPARTMENT OF PUBLIC WORKS

OGDEN AVENUE UNDERPASS AND ROADWAY
UNDERPASS ELEVATIONS
WESTERN HALF

DRAWING
A6
98 OF 125
OGD-A6

C:\KENT\OGDEN\ARCH\OGD-A6 Mod Nov 9 15:30:56 1994

30-99