



NORTH WALL
SCALE 1"=10'-0"

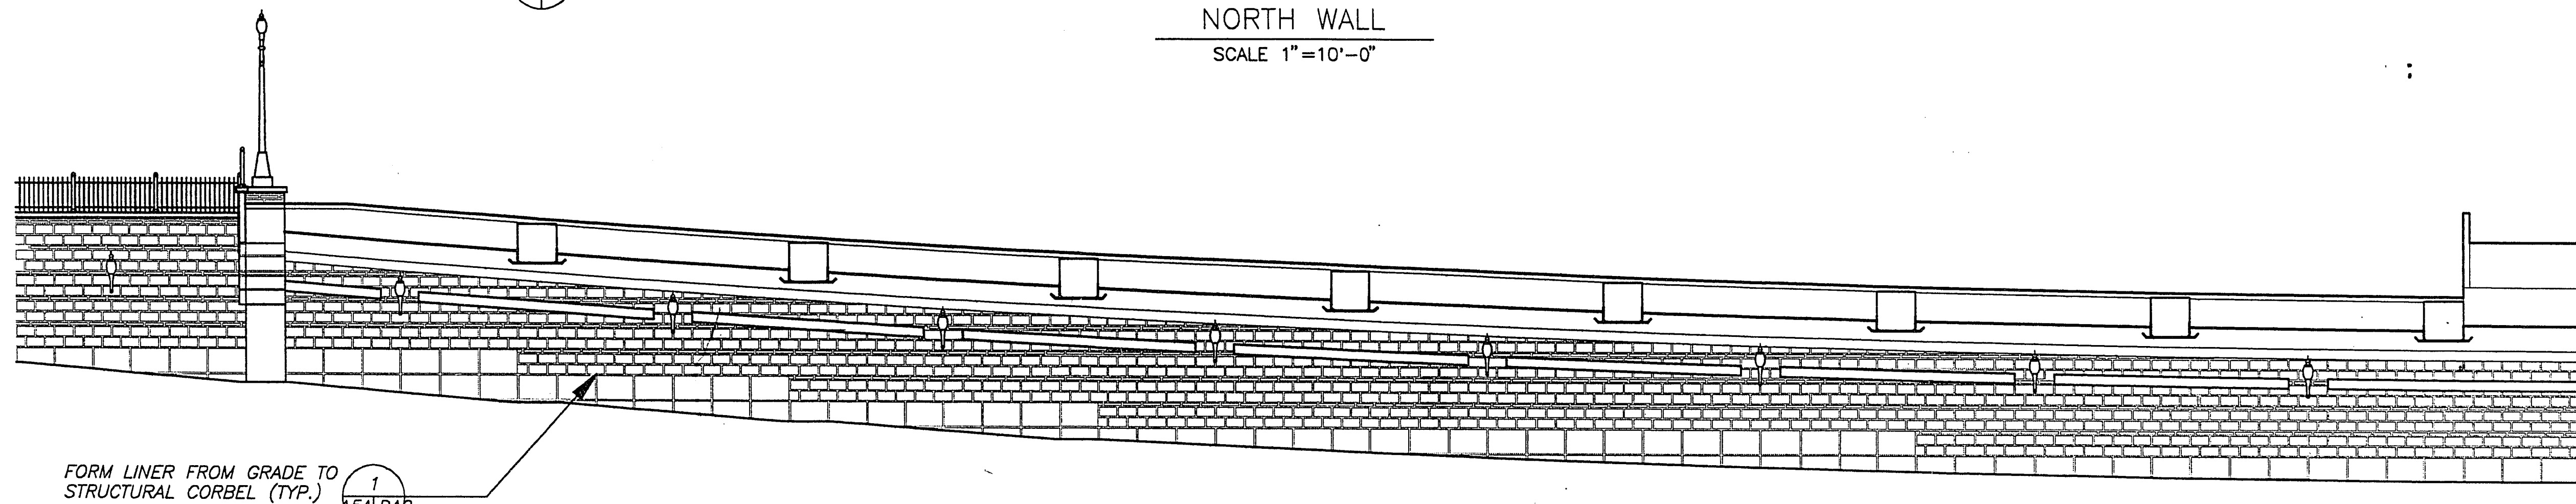

SOUTH WALL
SCALE 1"=10'-0"

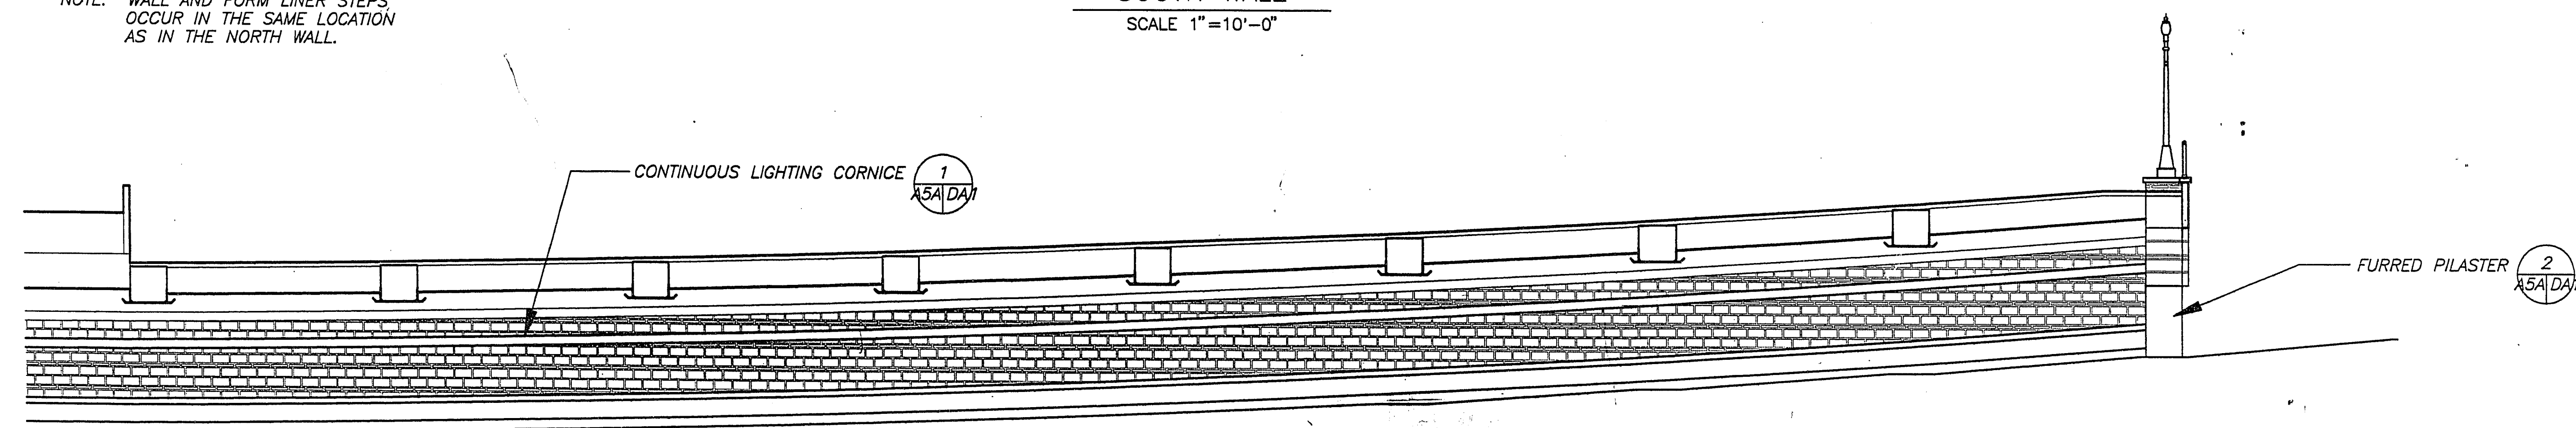

PIER WALL (TYPICAL BOTH SIDES)
SCALE 1"=10'-0"

**RECORD
DRAWINGS**

CLV DRAWING NO. 107-V2011

FILENAME: OGD-A5A.DWG
REV. DATE: 10 SEPTEMBER 1992

REISSUED 10-16-92 WITHOUT REVISION

MARK	DATE	BY	REVISION
1	10/7/94	BE	RECORD DRAWINGS

DESIGNED: GLB	PROJECT ENGINEER	DATE
DRAWN: CVT	PROJECT MANAGER	DATE
CHECKED: GLB		

Boyle Engineering Corporation
consulting engineers
Suite 300
1795 E. Sahara Ave.
Las Vegas, NV 89104
(702) 731-5511

CITY OF LAS VEGAS
DEPARTMENT OF PUBLIC WORKS

OGDEN AVENUE UNDERPASS AND ROADWAY
UNDERPASS ELEVATIONS
EASTERN HALF - ADDITIVE ALTERNATE

DRAWING
A5A
109 OF 125
OGD-A5A

3-2-110