


**AS BUILT**

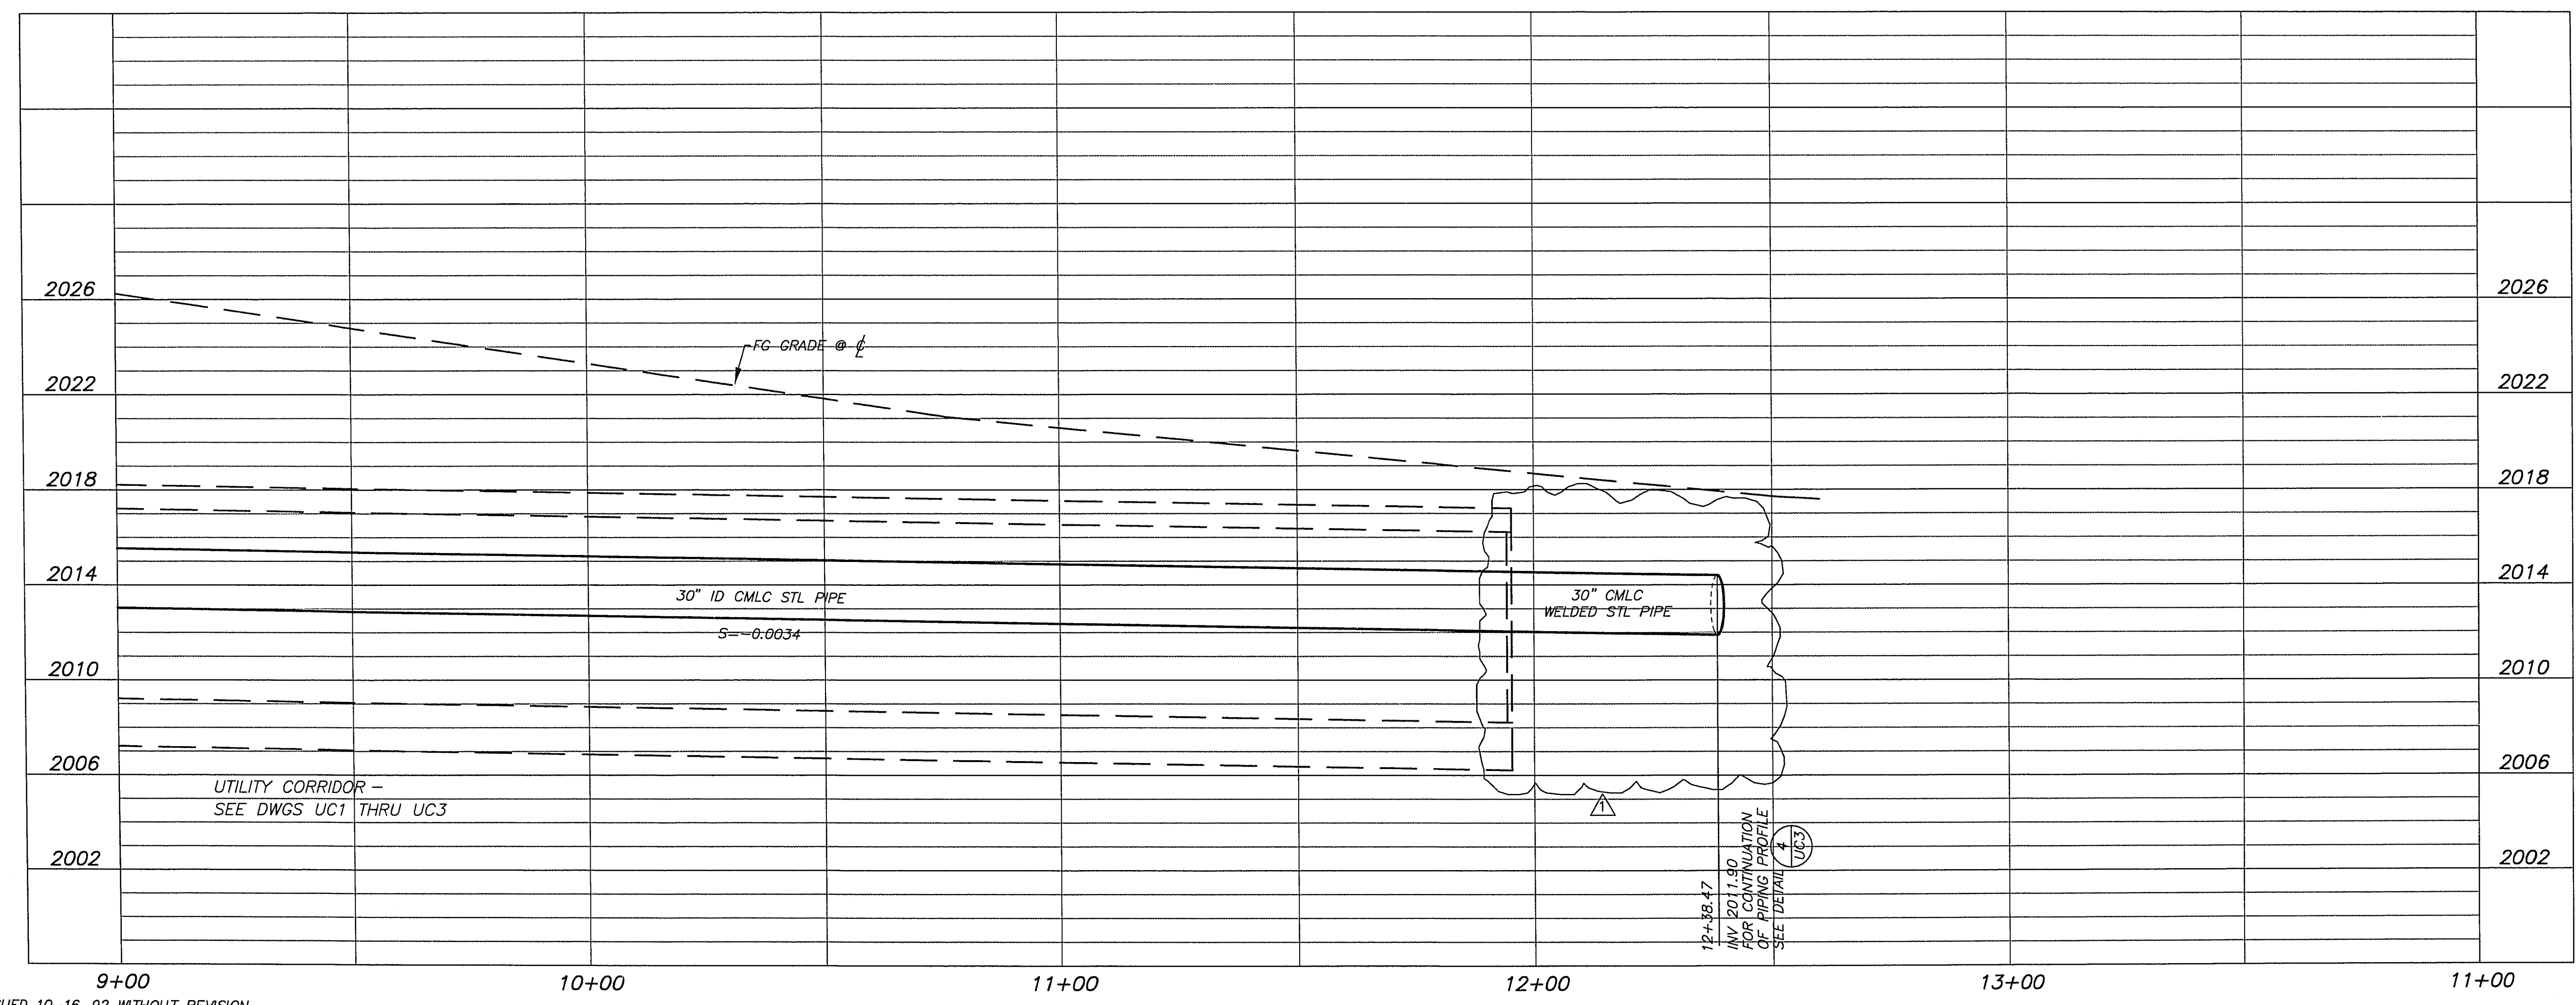

MARK	DATE	BY	REVISION
▲	10/7/94	BE	RECORD DRAWINGS
▲	6/4/93	AH	ADDENDUM NO. 2

DESIGNED:	MSL	PROJECT ENGINEER	DATE
DRAWN:	JAM	PROJECT MANAGER	DATE
CHECKED:	SCD		

**Boyle Engineering Corporation**  
consulting engineers  
Suite 200  
1750 E. Sahara Ave  
Las Vegas, NV 89104  
(702) 731-5511

**CITY OF LAS VEGAS**  
DEPARTMENT OF PUBLIC WORKS

OGDEN AVENUE UNDERPASS AND ROADWAY  
**WATERLINE RELOCATION**  
PLAN & PROFILE

DRAWING  
**W2**  
101 OF 125  
OF  
OGSHTW2

10-16-92 10:58:12 Tue Nov 15 12:55:32 1994

35-20