


Call before you Dig.
1-800-227-2600
UNDERGROUND SERVICE ALERT, USA

- NOTE:
- CONTRACTOR TO POTHOLE ALL UTILITIES ONE WEEK PRIOR TO STORM DRAIN OR PUMP STATION PIPELINE INSTALLATION.
 - INSTALL 16-5" CONDUITS WITH CONCRETE ENCASEMENT, 75' RADIUS. JOIN EXIST MH TERMINATORS WITH 4" TO 5" SWEDGE REDUCER. TELEPHONE CONDUIT TO BE INSTALLED PER CENTRAL TELEPHONE COMPANY UNDERGROUND STANDARDS, DATED 1992. CALL 877-7811, 24 HRS IN ADVANCE, TO SCHEDULE INSPECTION.
 - PRIME CABLE CONDUIT & CHRISTY B36 UTILITY BOX TO BE CONTRACTED BY PRIME CABLE. (CONTACT PRIME CABLE FOR DETAILS).

RECORD DRAWINGS

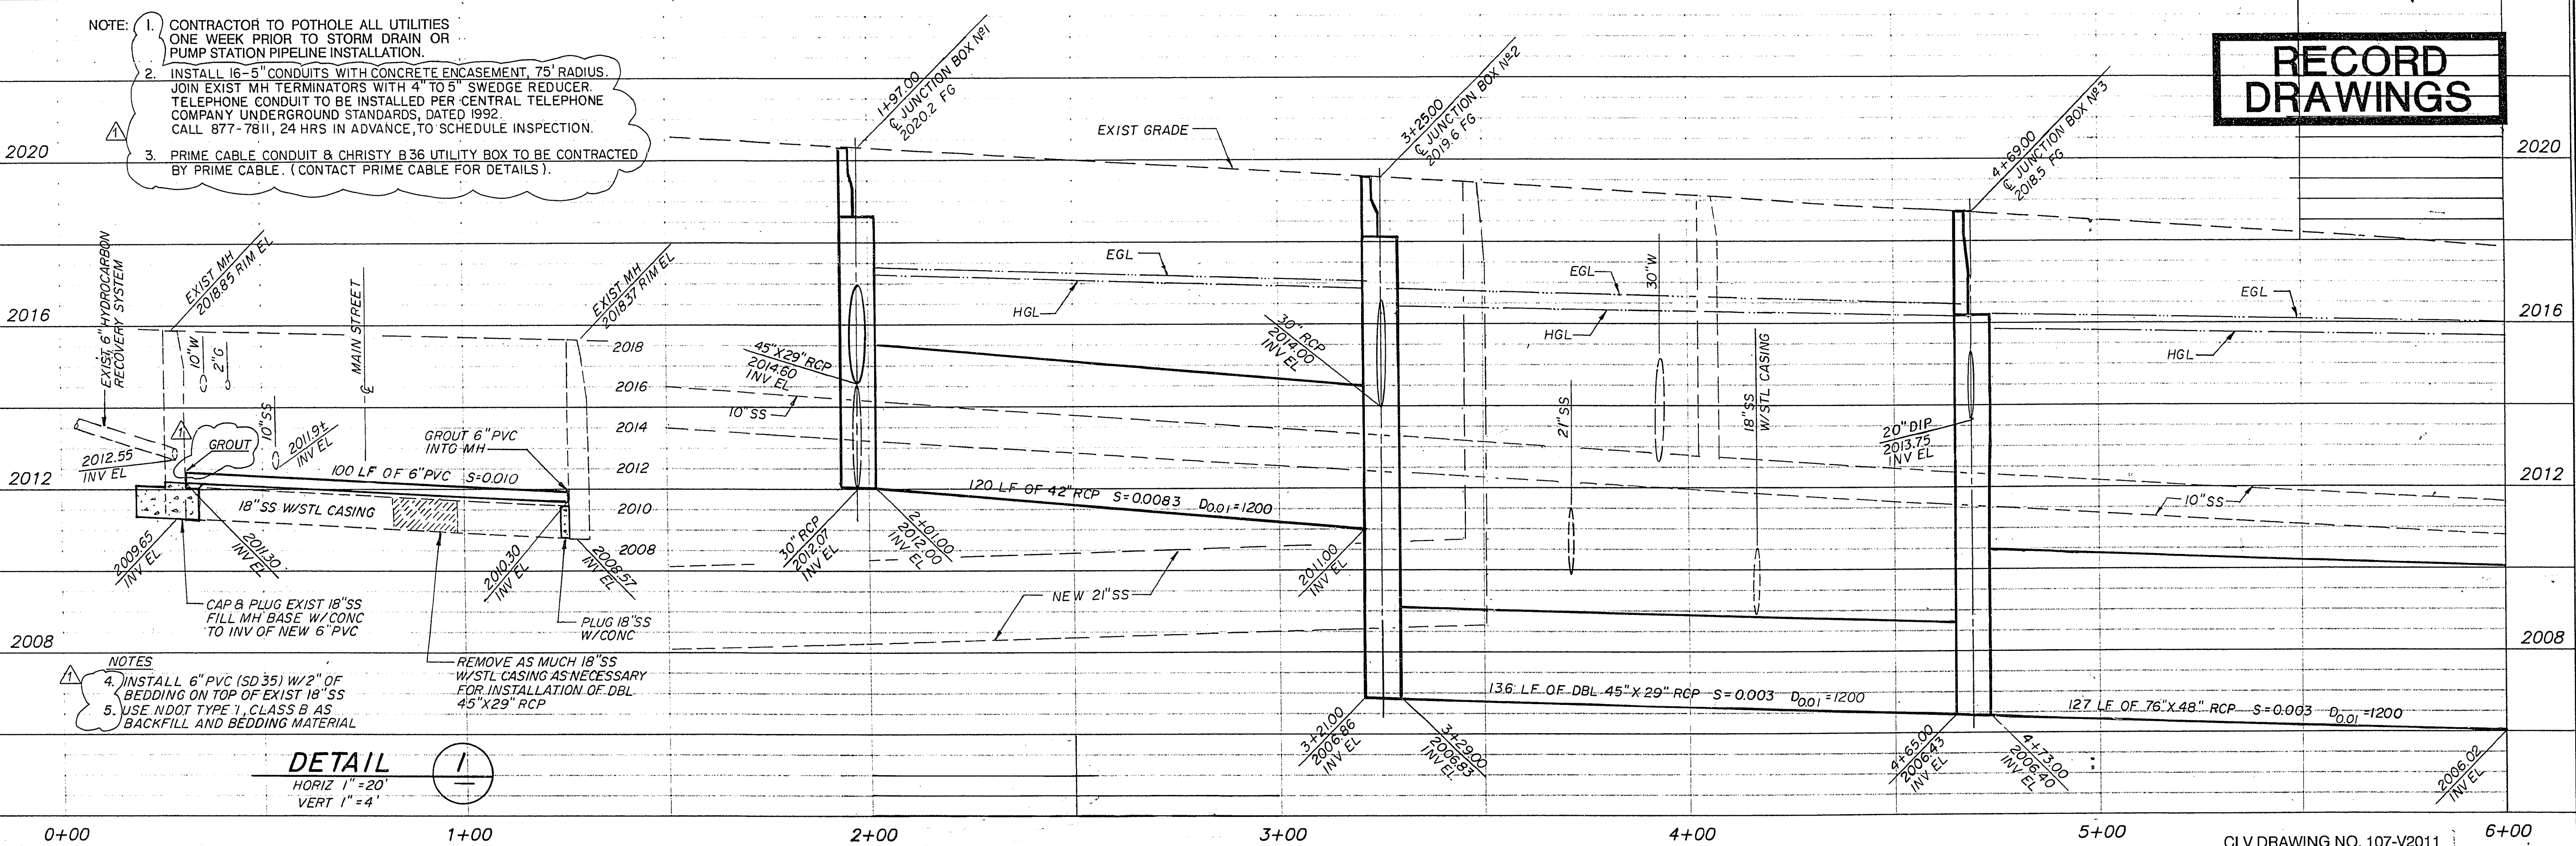

DETAIL 1
HORIZ 1" = 20'
VERT 1" = 4'

MARK	DATE	BY	REVISION
3	10/7/94	BE	RECORD DRAWINGS
4	2/5/94	PK	ADDED 2" RPPA
5	10/15/92	GM	PER ADDENDUM NO.1

DESIGNED: JPM	PROJECT ENGINEER	DATE
DRAWN: AH	PROJECT ENGINEER	DATE
CHECKED: GPM	PROJECT MANAGER	DATE

Boyle Engineering Corporation
consulting engineers
Suite 300
1785 E. Sahara Ave.
Las Vegas, NV 89104
(702) 731-5511

CITY OF LAS VEGAS
DEPARTMENT OF PUBLIC WORKS

OGDEN AVENUE UNDERPASS AND ROADWAY
MAIN STREET STORM DRAIN
PLAN & PROFILE

DRAWING
SD2
24 OF 125

3-2-95