

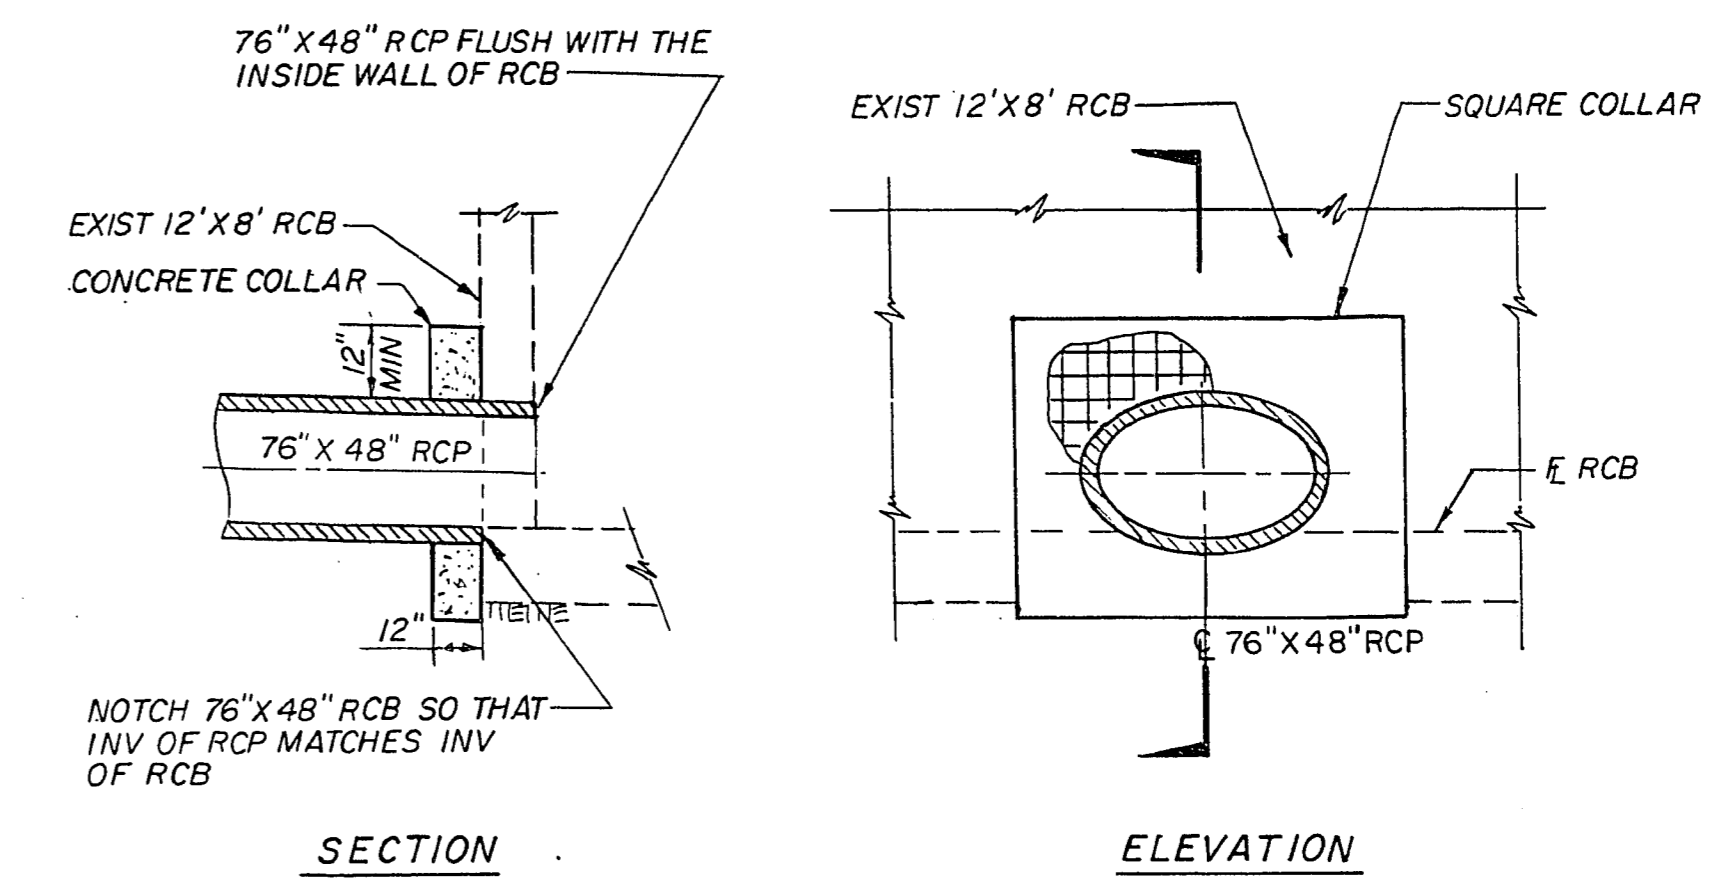


NOTE
 1. REMOVE AS NECESSARY FROM DOUBLE 10' X 2.5' RCB AND PLUG BOTH ENDS.

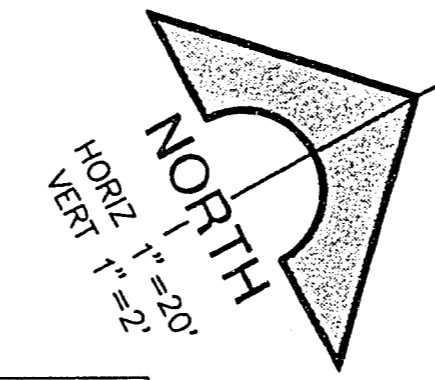

- NOTES:
1. SAWCUT HOLE SLIGHTLY SMALLER THAN PIPE DIAMETER.
 2. ENLARGE HOLE WITH HAMMER TO MINIMUM 8-INCH DIAMETER LARGER THAN PIPE O.D.
 3. REMOVE ONLY ENOUGH REBAR TO PROVIDE 1-INCH CLEARANCE OF PIPE.
 4. GROUT ANNULAR SPACE AND COLLAR MONOLITHICALLY.

76" X 48" RCP CONNECTION TO RCB
 NOT TO SCALE

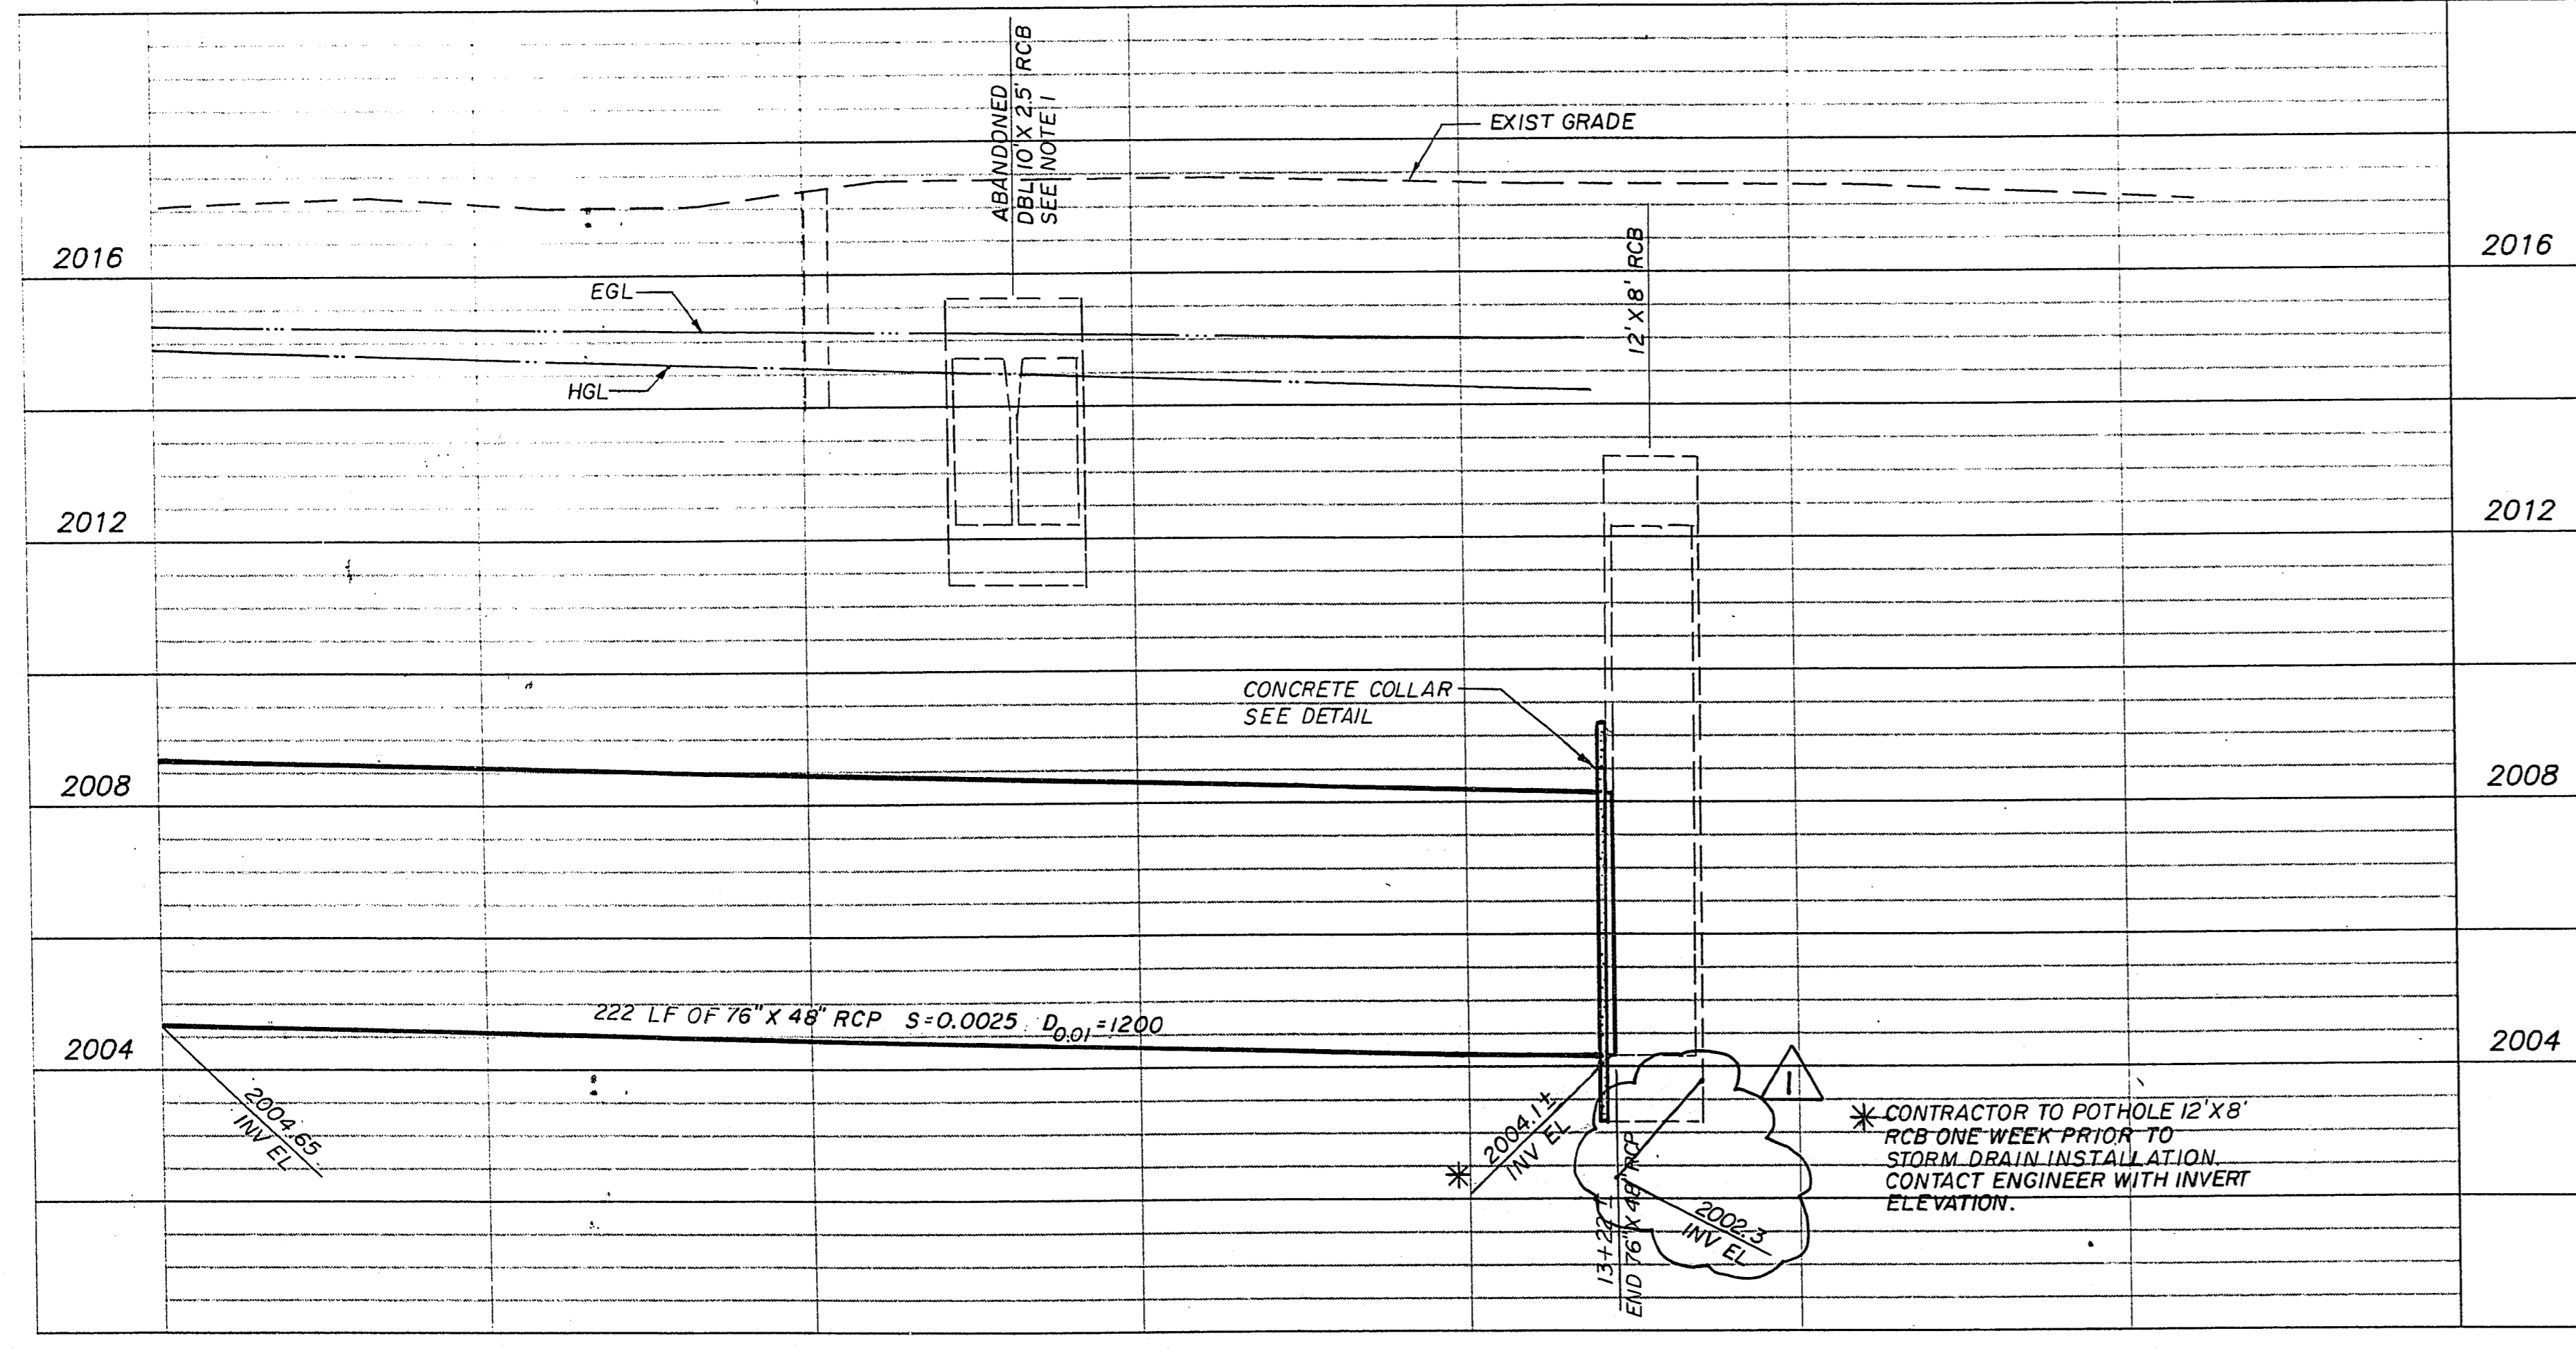


* CONTRACTOR TO POT HOLE 12' X 8' RCB ONE WEEK PRIOR TO STORM DRAIN INSTALLATION. CONTACT ENGINEER WITH INVERT ELEVATION.

RECORD DRAWINGS

Avoid cutting underground utility lines. It's costly.
Call before you Dig.
 1-800-227-2600
UNDERGROUND SERVICE ALERT USA

CLV DRAWING NO. 107-V2011

10/7/94	BE	RECORD DRAWINGS	DESIGNED: JPM	PROJECT ENGINEER	DATE
			DRAWN: AH	PROJECT ENGINEER	DATE
			CHECKED: GPM	PROJECT MANAGER	DATE

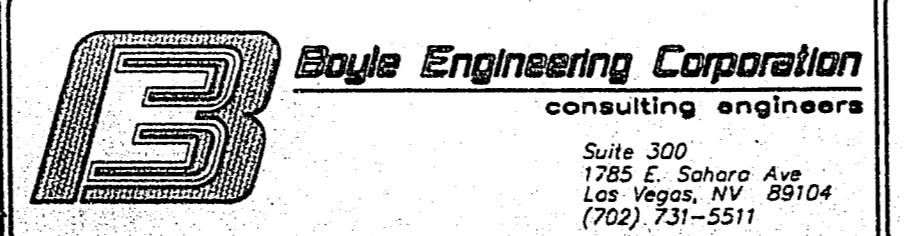

CITY OF LAS VEGAS
 DEPARTMENT OF PUBLIC WORKS

OGDEN AVENUE UNDERPASS, AND ROADWAY
MAIN STREET STORM DRAIN
 PLAN & PROFILE

DRAWING
SD4
 26 OF 125
 OGSHT012

3-2-27