
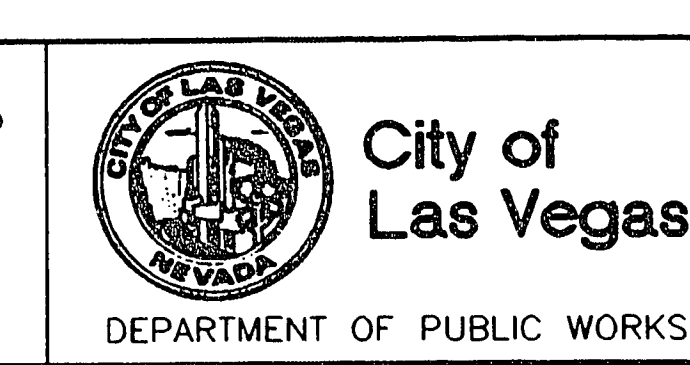
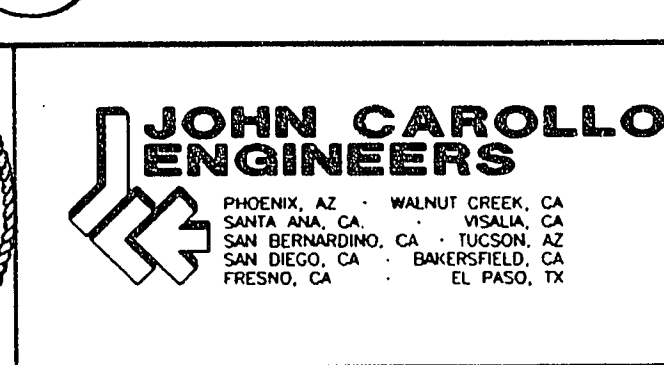
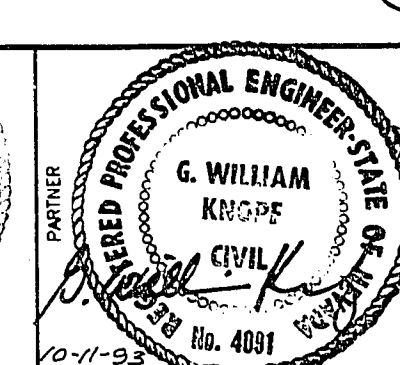


DESIGNED
K K
DRAWN
R E S
CHECKED
T H C
DATE
S E P '93

BAR IS ONE INCH ON
ORIGINAL DRAWING

0  1"

IF NOT ONE INCH ON
THIS SHEET, ADJUST
SCALES ACCORDINGLY

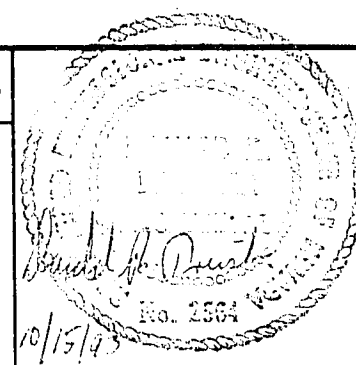

DUCTING DETAILS

JOB NO.	3752B.10
DRAWING NO.	Y-10
SHEET NO.	28 OF 72

RECORD DRAWING
THESE RECORD DRAWINGS HAVE BEEN PREPARED BASED
IN PART ON INFORMATION PROVIDED BY OTHERS.

THIS DRAWING WAS PREPARED ONLY FOR THE
PROJECT AND SITE SPECIFICALLY IDENTIFIED
HEREON AND IS NOT TO BE USED ELSEWHERE

Date 7/14/95
By Brian Hyl

4-1-7A

311.32