


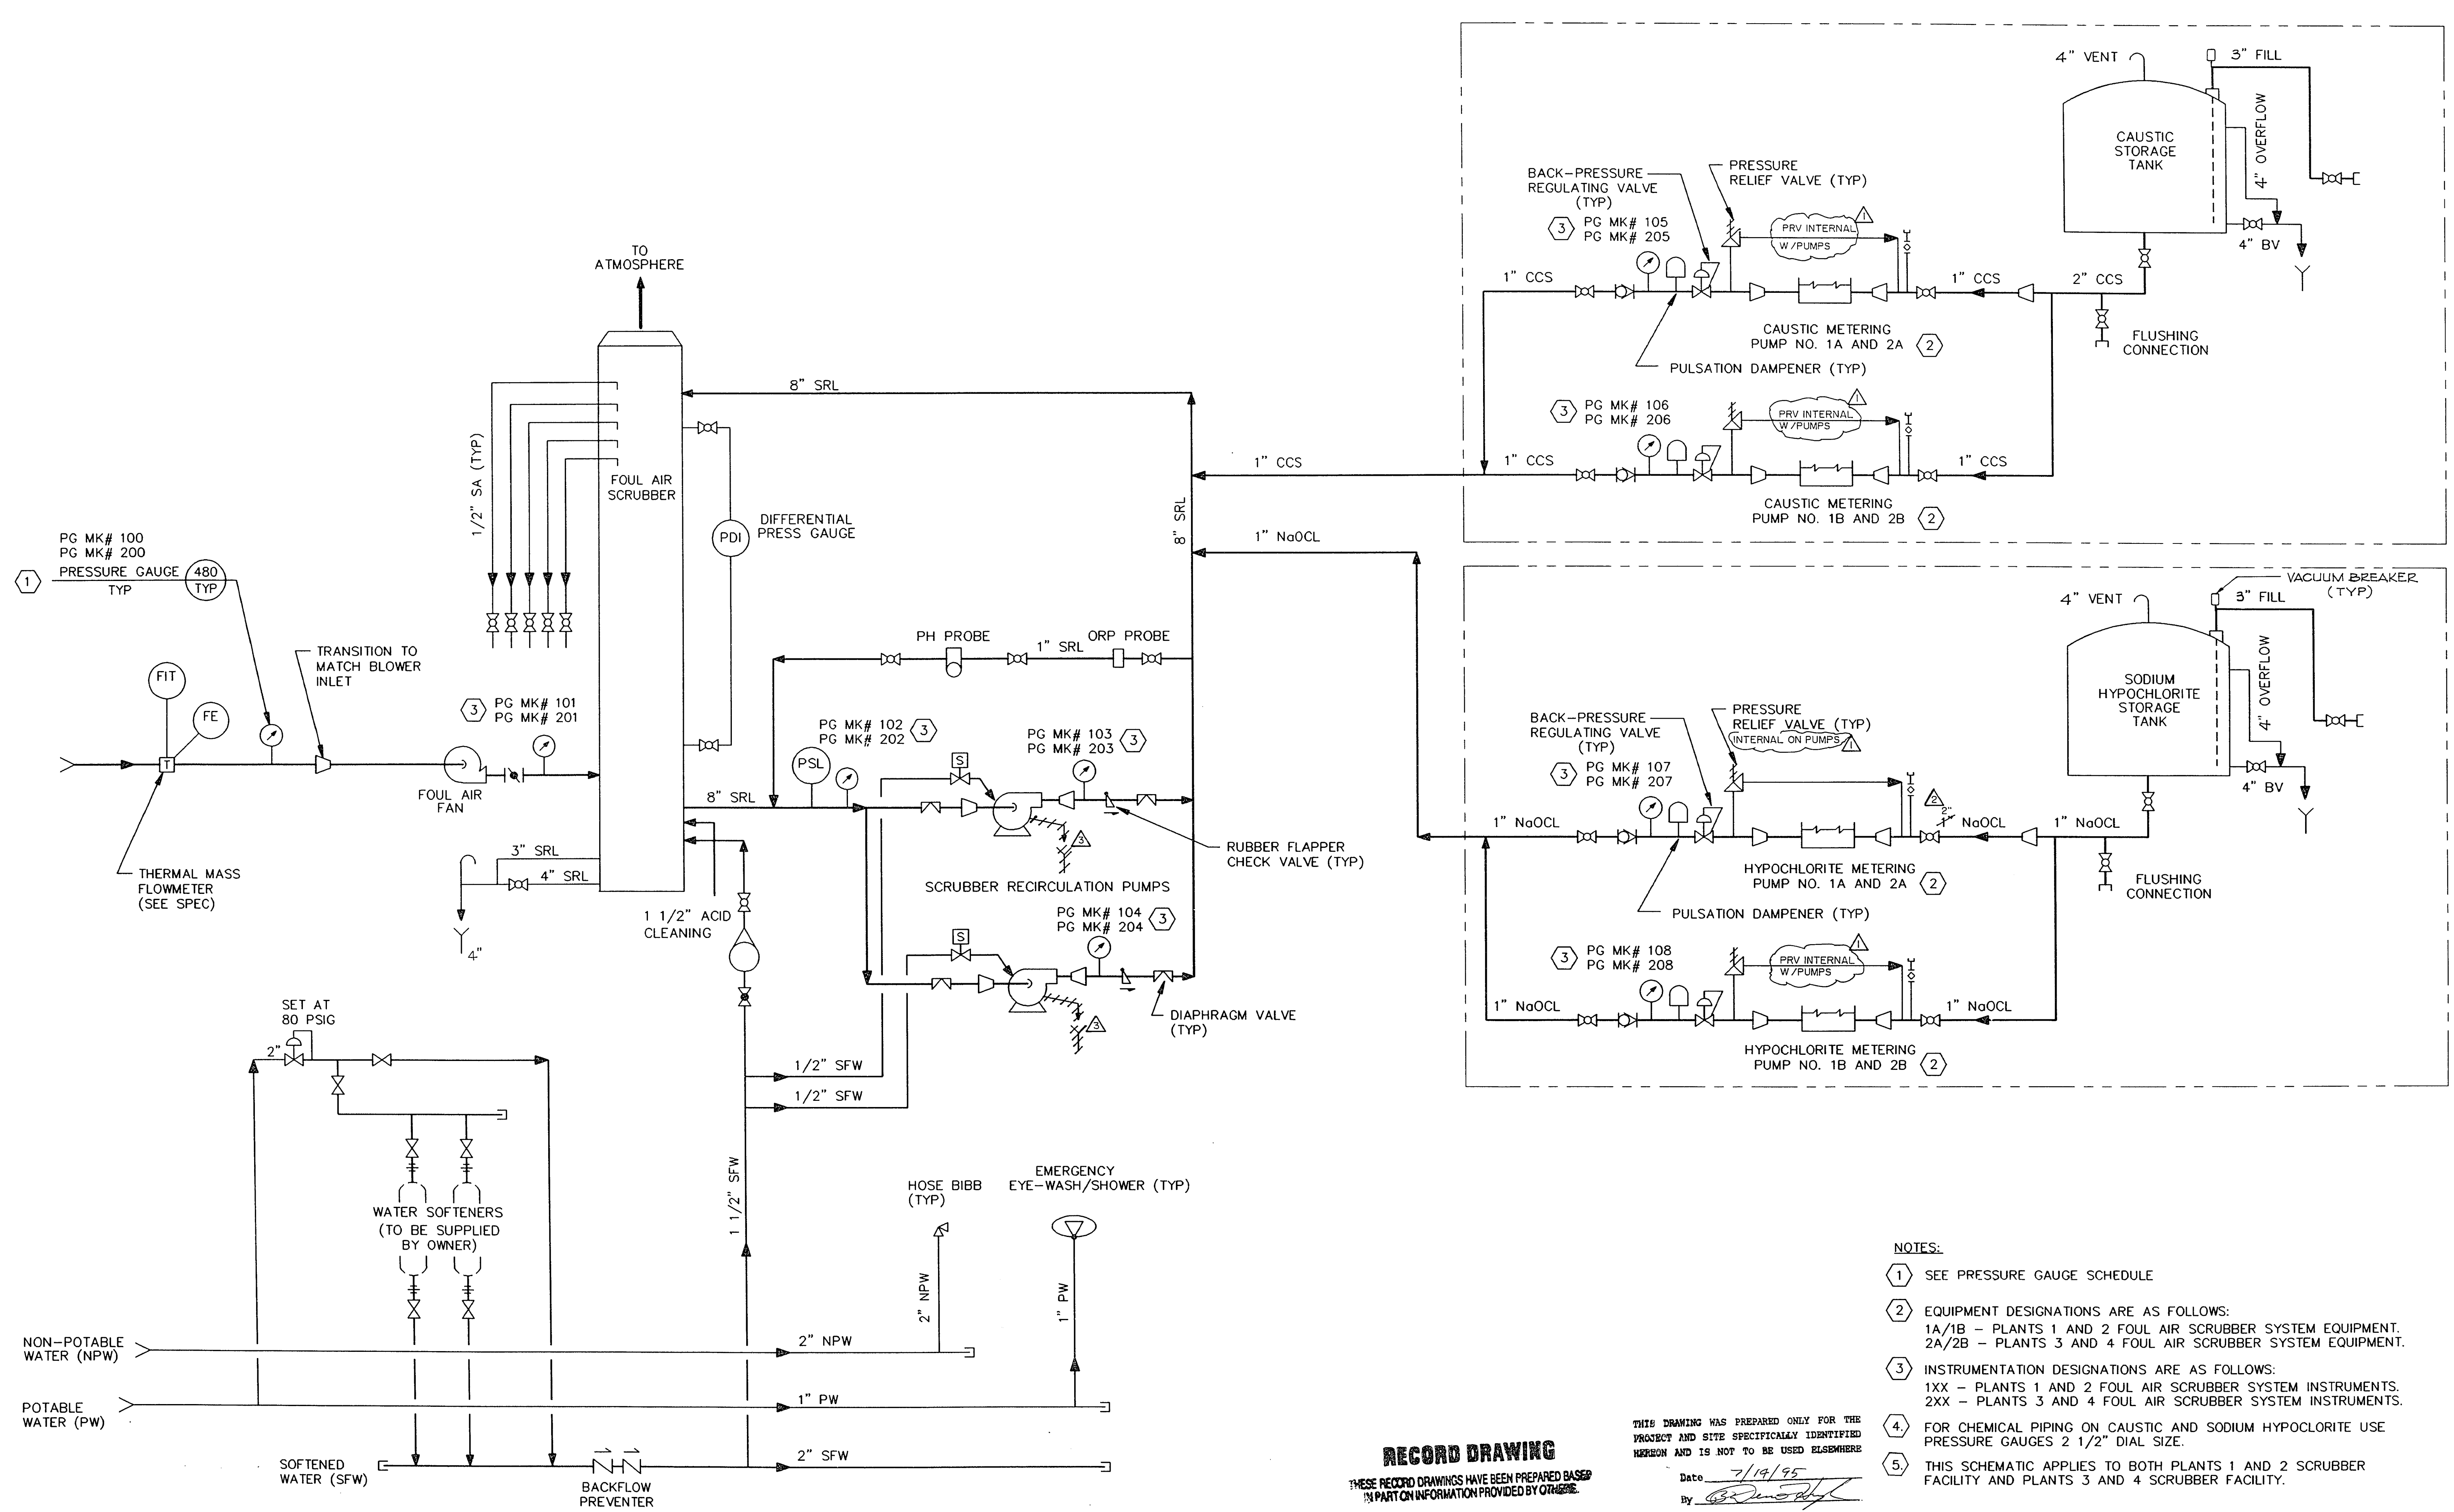

NOTES:

- 1 SEE PRESSURE GAUGE SCHEDULE
- 2 EQUIPMENT DESIGNATIONS ARE AS FOLLOWS:
1A/1B - PLANTS 1 AND 2 FOUL AIR SCRUBBER SYSTEM EQUIPMENT.
2A/2B - PLANTS 3 AND 4 FOUL AIR SCRUBBER SYSTEM EQUIPMENT.
- 3 INSTRUMENTATION DESIGNATIONS ARE AS FOLLOWS:
1XX - PLANTS 1 AND 2 FOUL AIR SCRUBBER SYSTEM INSTRUMENTS.
2XX - PLANTS 3 AND 4 FOUL AIR SCRUBBER SYSTEM INSTRUMENTS.
- 4 FOR CHEMICAL PIPING ON CAUSTIC AND SODIUM HYPOCHLORITE USE PRESSURE GAUGES 2 1/2" DIAL SIZE.
- 5 THIS SCHEMATIC APPLIES TO BOTH PLANTS 1 AND 2 SCRUBBER FACILITY AND PLANTS 3 AND 4 SCRUBBER FACILITY.

RECORD DRAWING
THESE RECORD DRAWINGS HAVE BEEN PREPARED BASED
ON PART ON INFORMATION PROVIDED BY OTHERS.

THIS DRAWING WAS PREPARED ONLY FOR THE
PROJECT AND SITE SPECIFICALLY IDENTIFIED
HEREON AND IS NOT TO BE USED ELSEWHERE

Date: 7/19/95
By: [Signature]

--	--	