
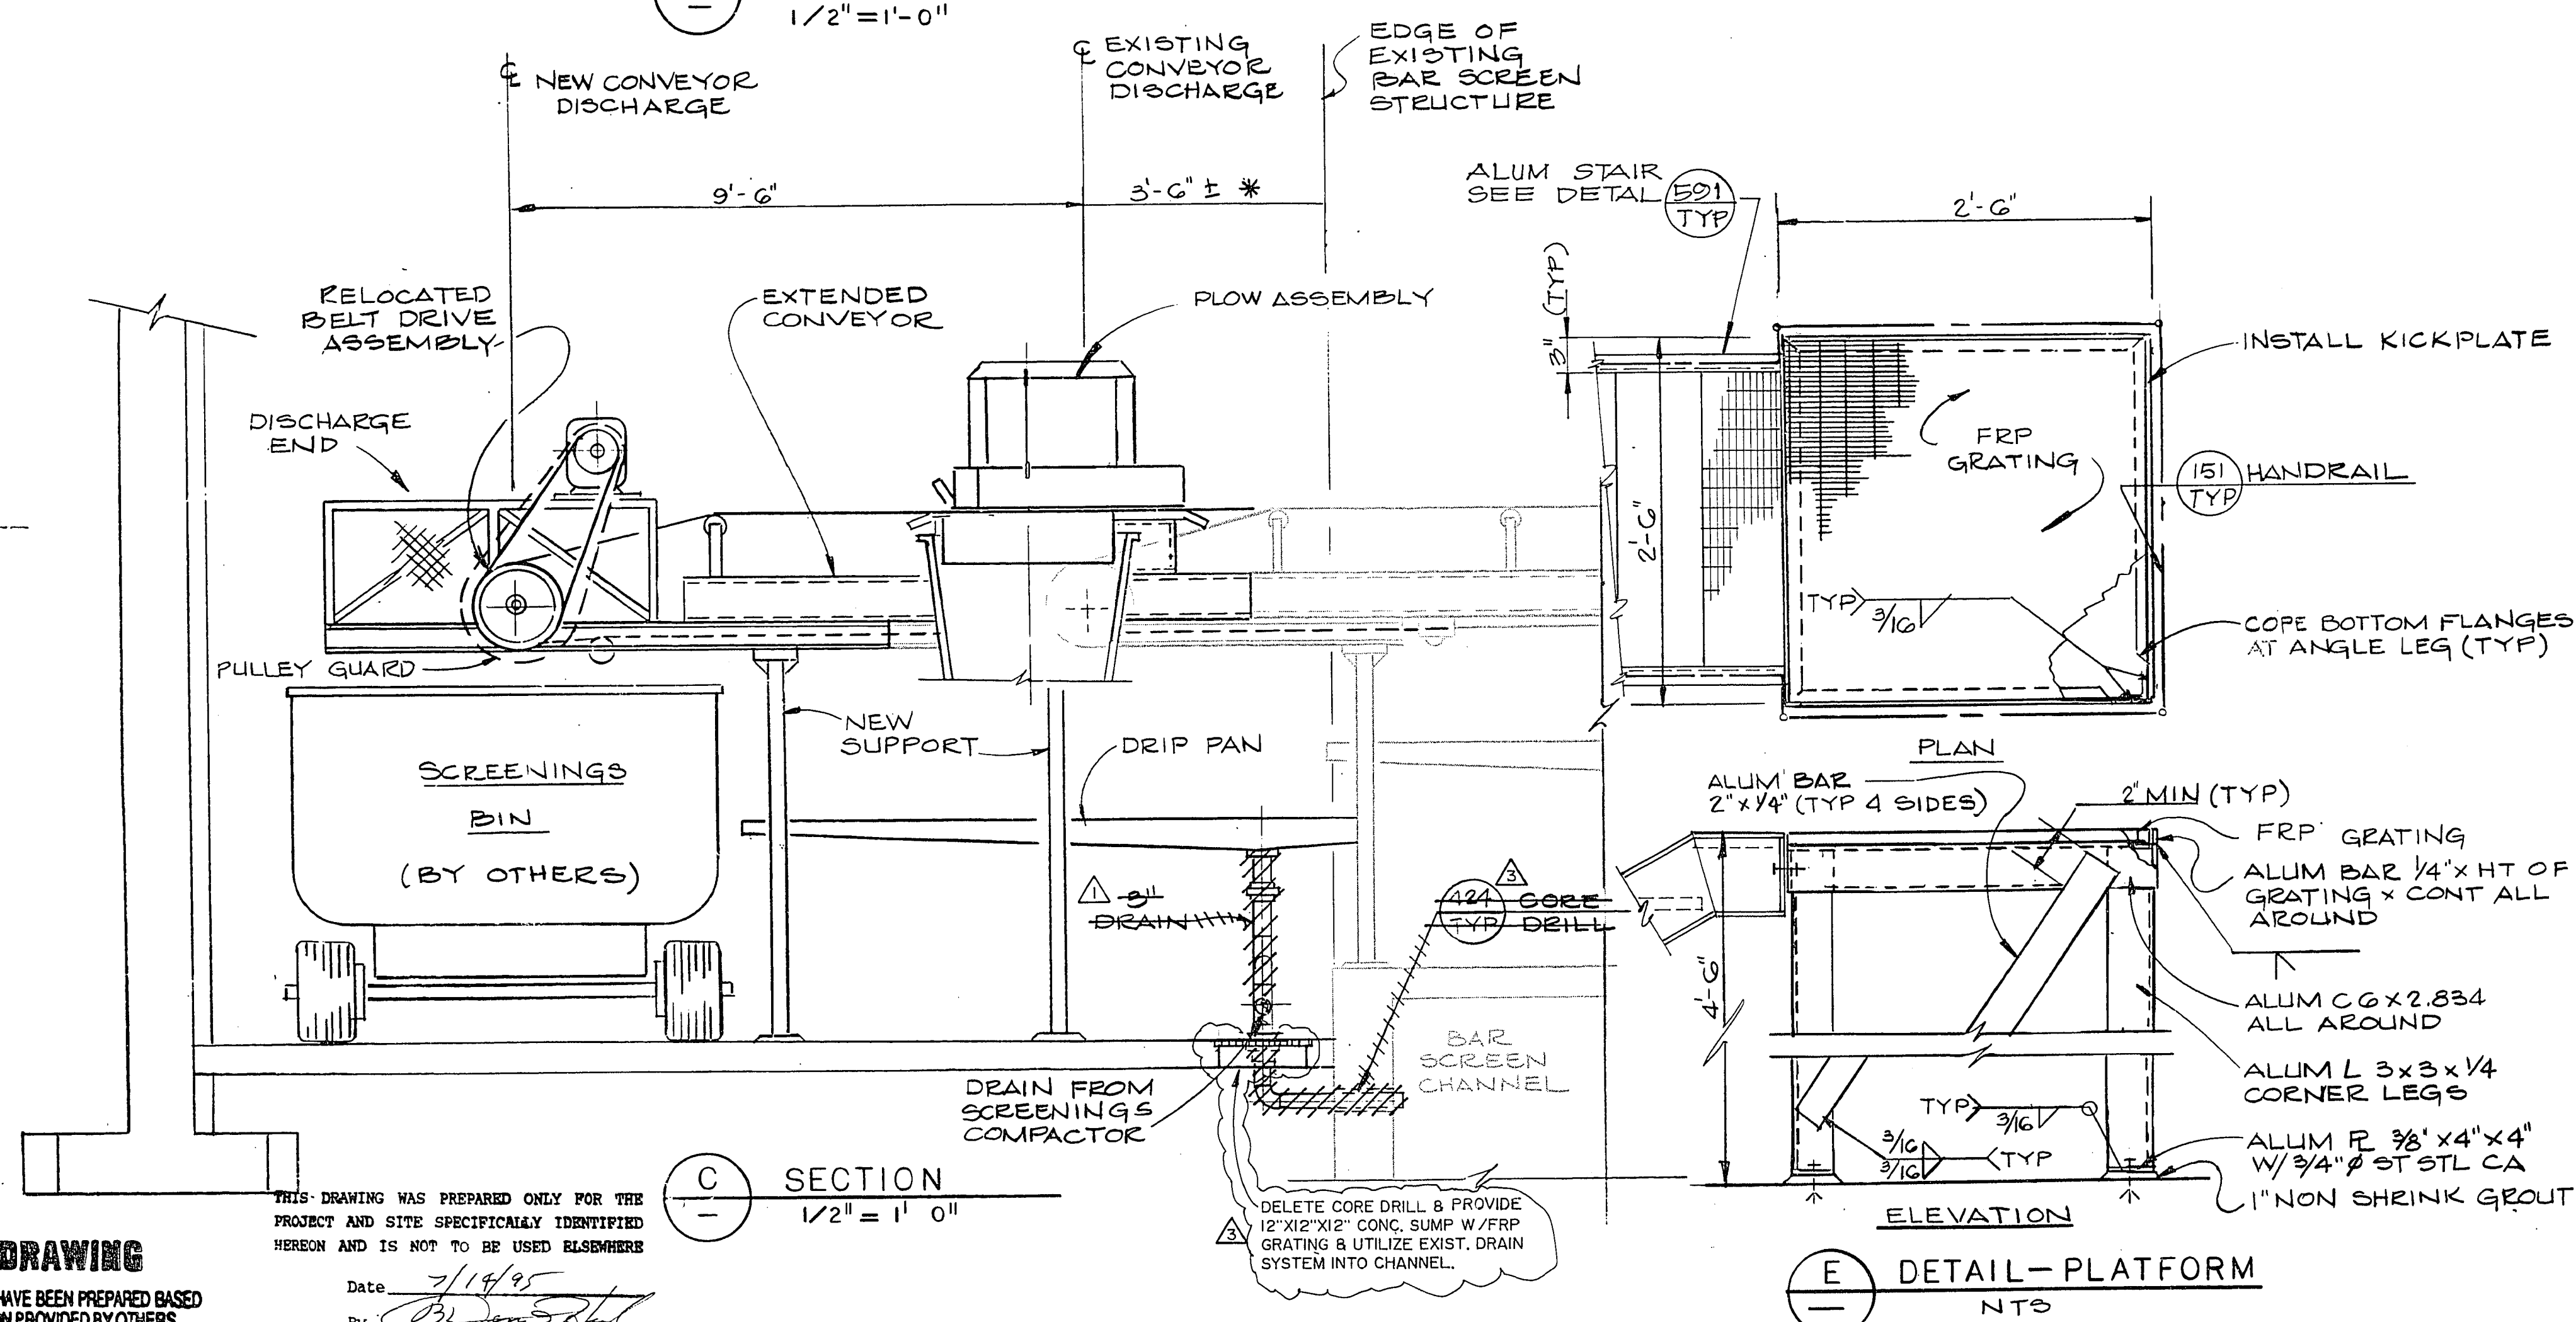
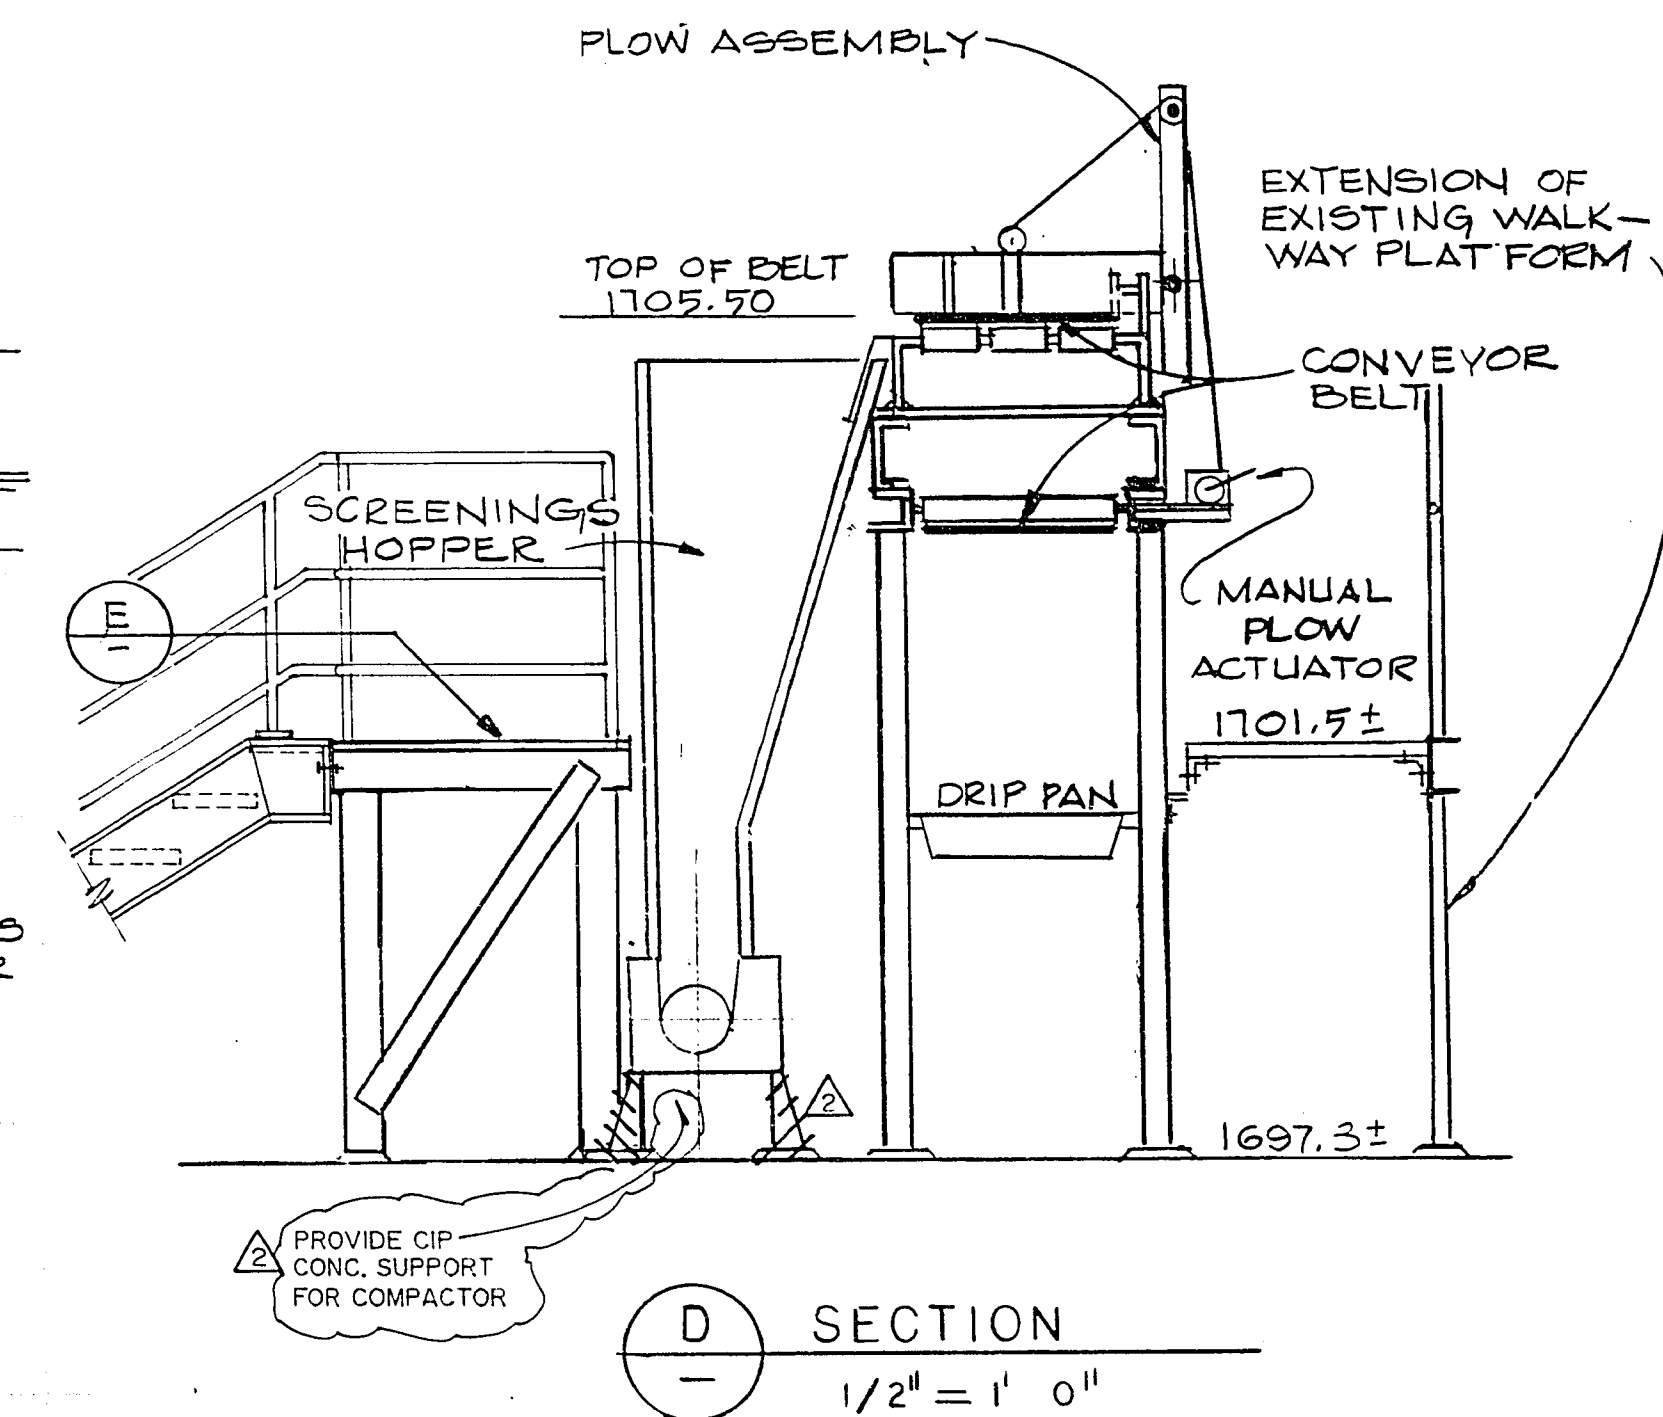
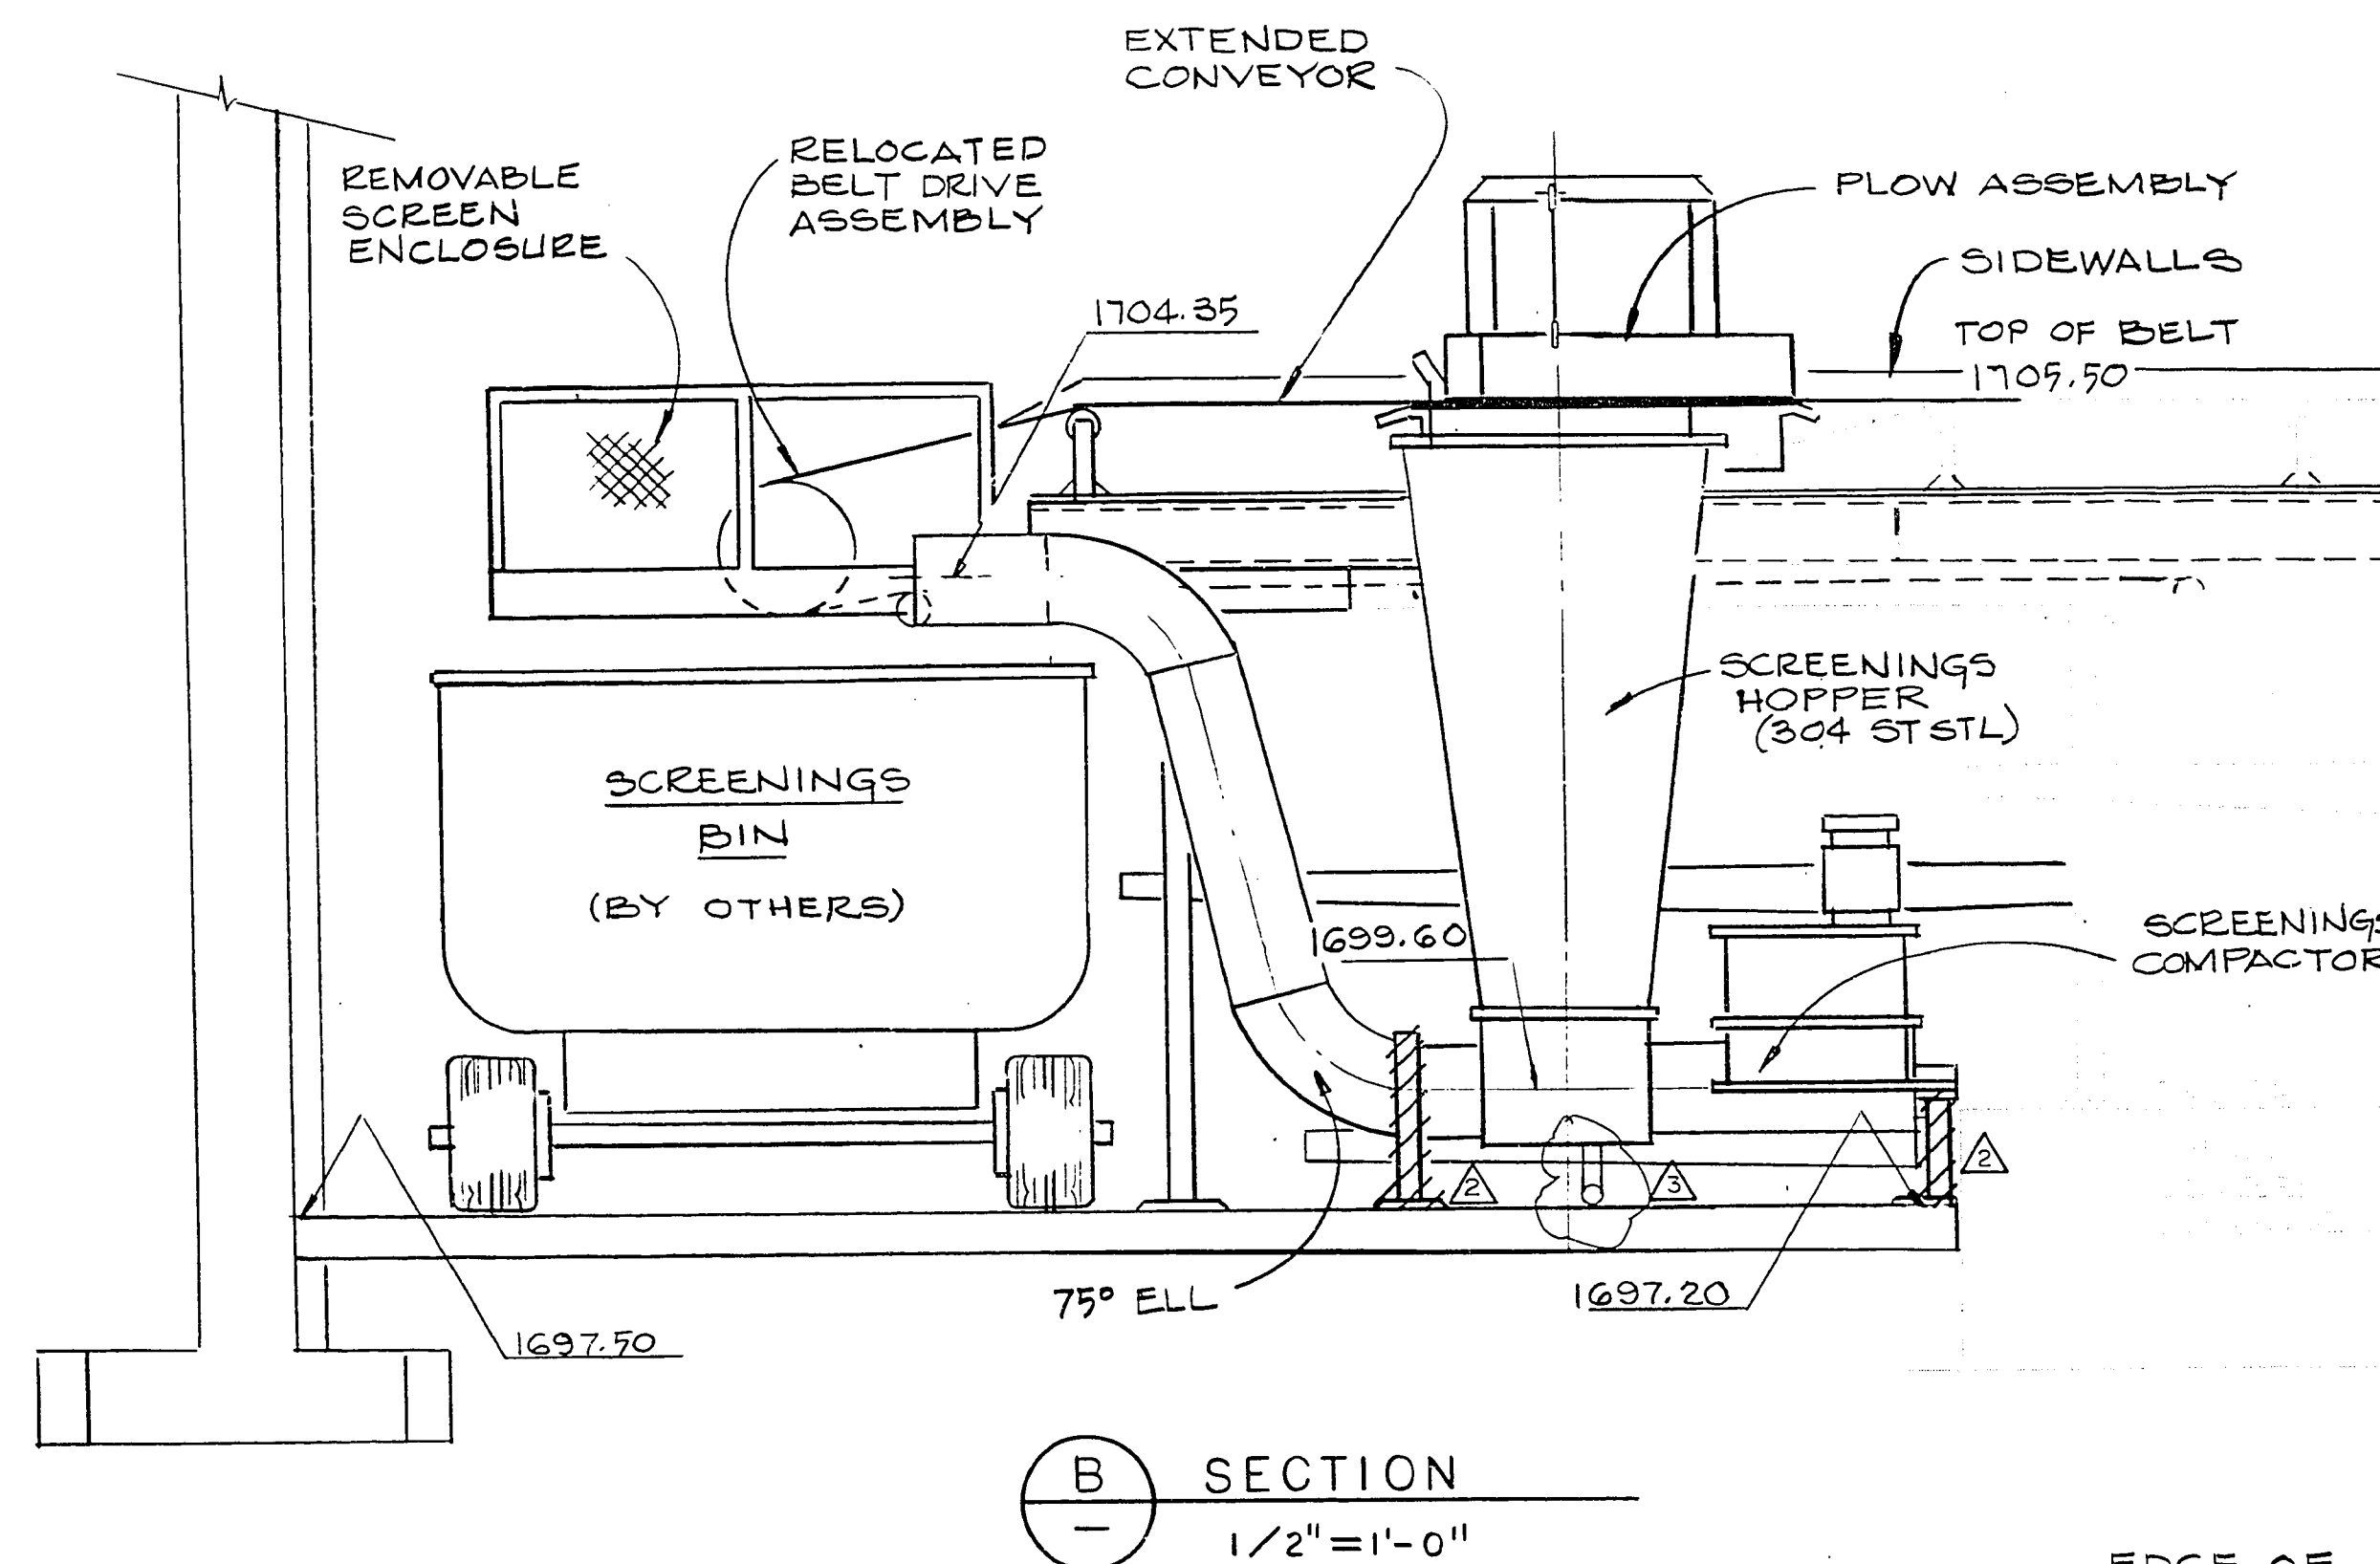


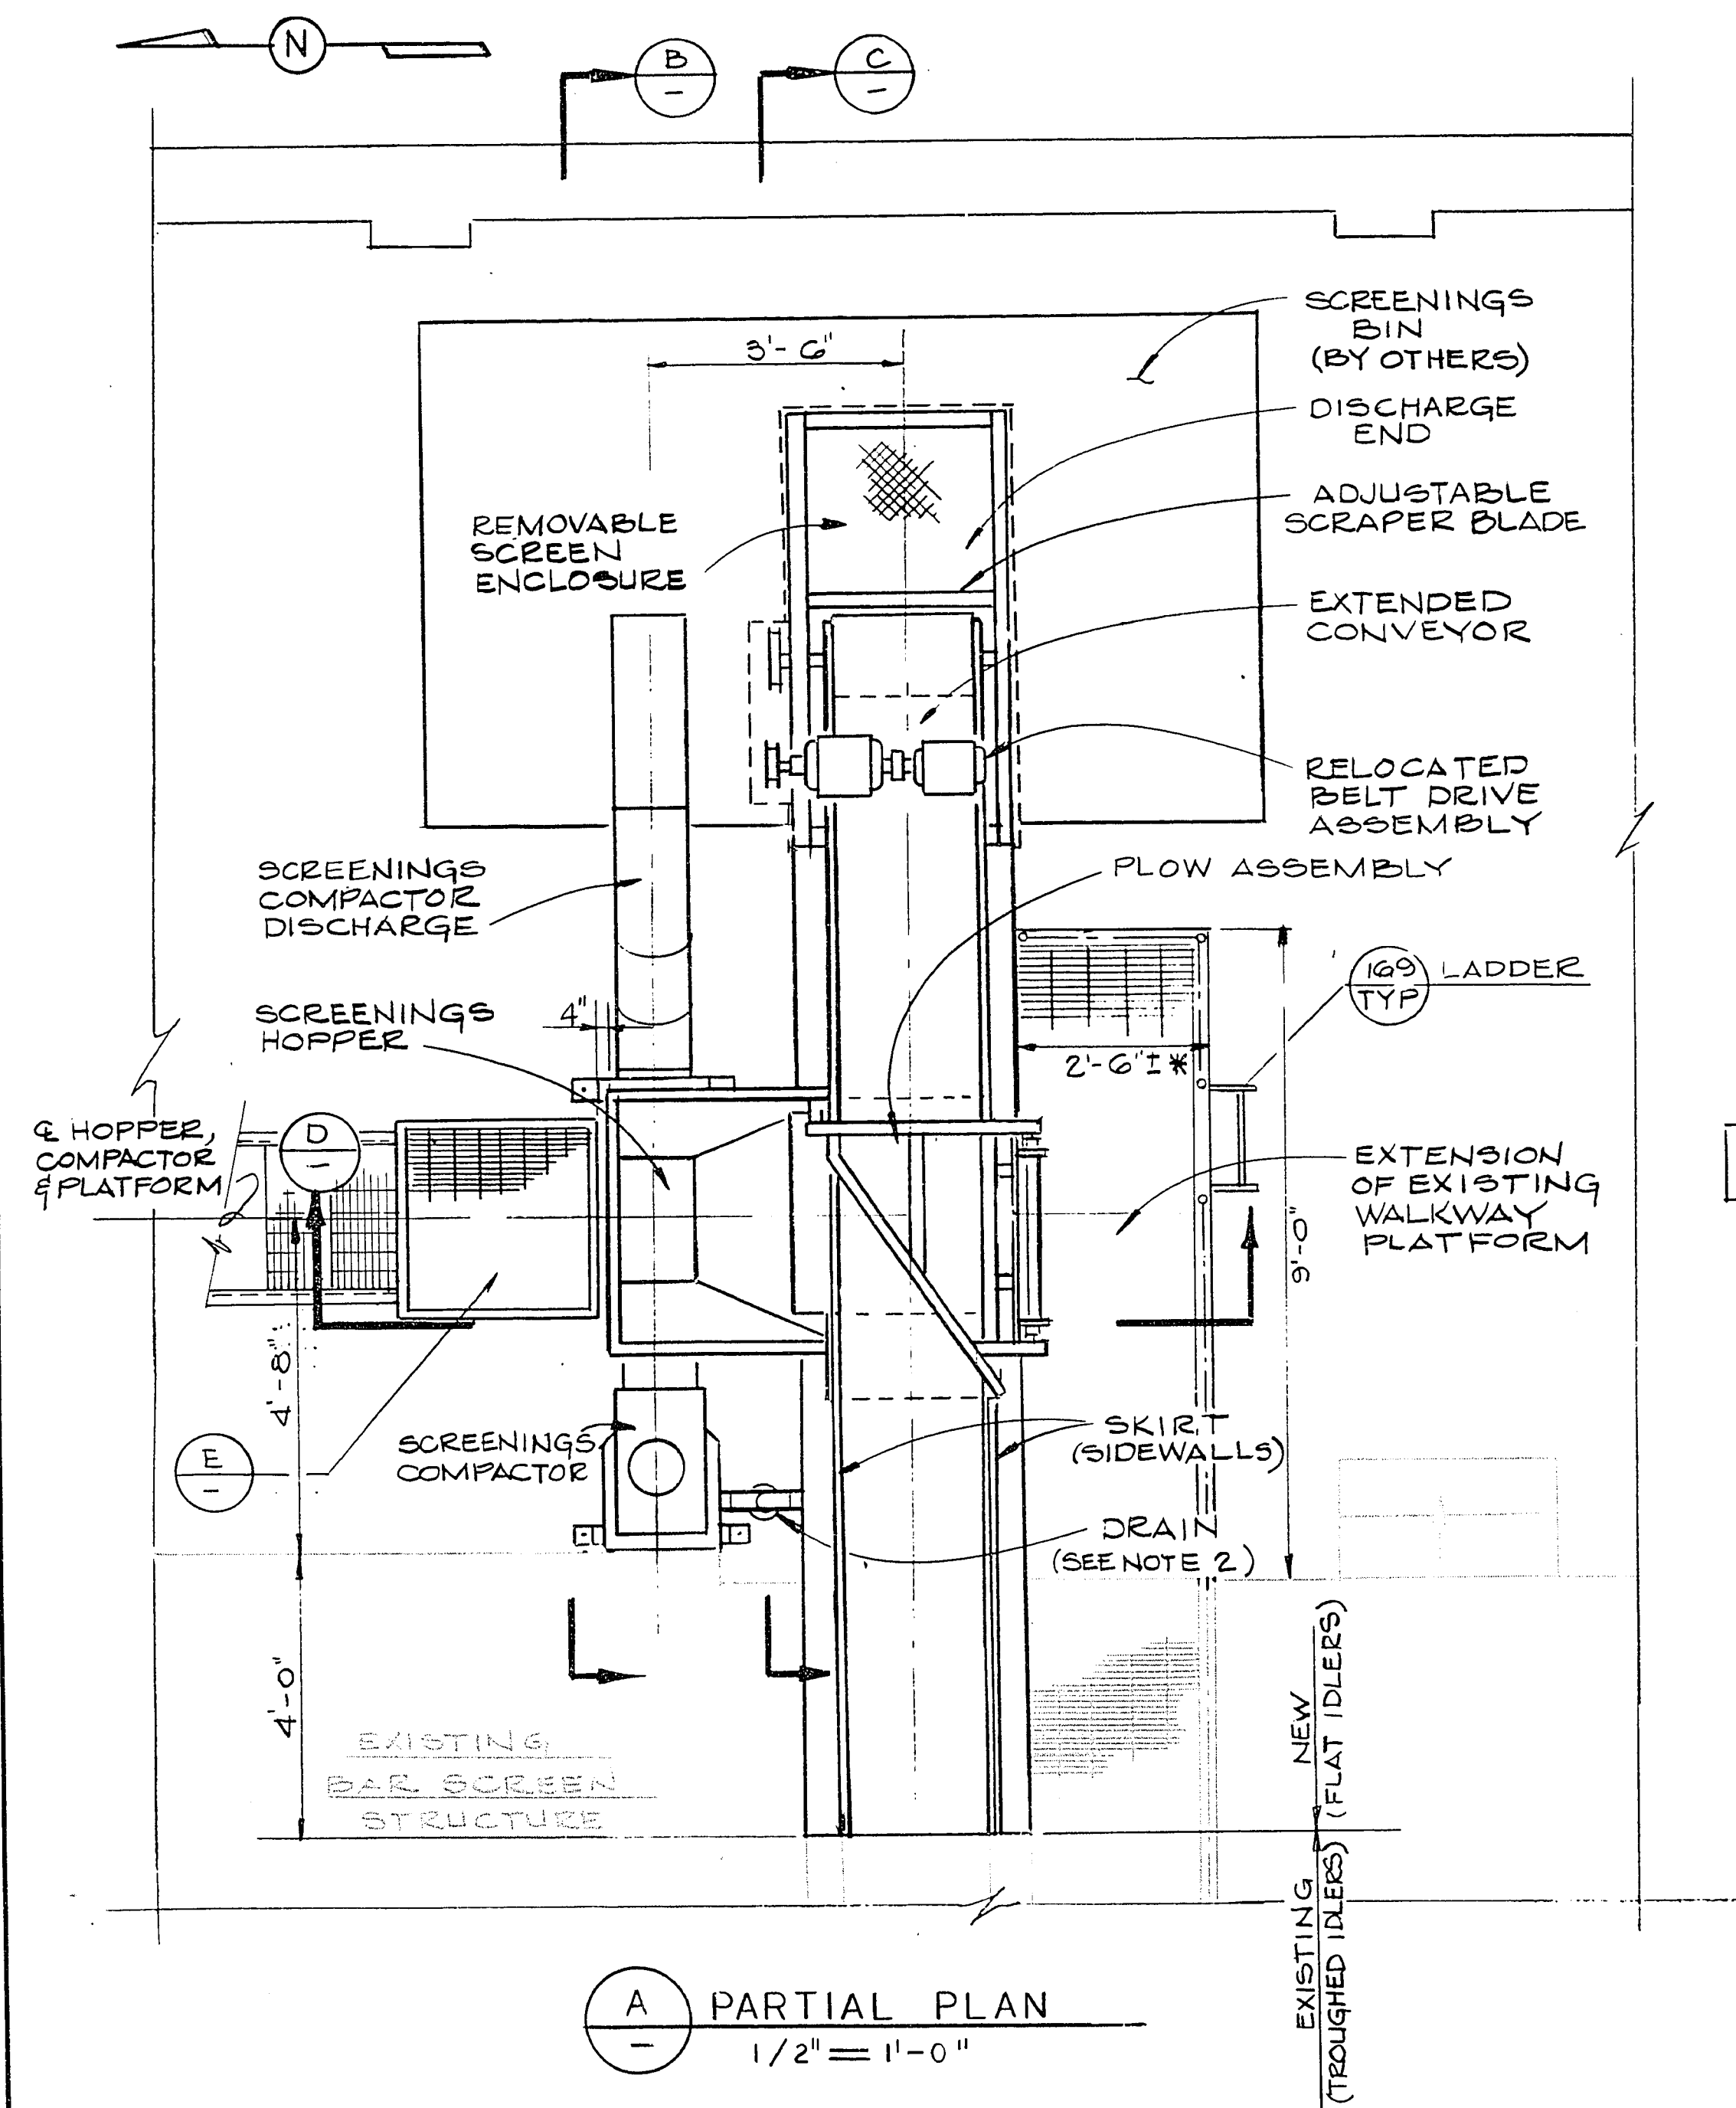

NOTES:

1. DIMENSIONS DENOTED BY AN ASTERISK (*) SHALL BE FIELD VERIFIED BY CONTRACTOR PRIOR TO FABRICATION OF RELATED ITEMS.
2. THE FLOOR DRAIN SHALL BE INSTALLED PER DETAIL ON DWG S-12. EXACT LOCATION SHALL BE DETERMINED BY CONTRACTOR BASED ON COORDINATION WITH SCREENINGS COMPACTOR AND CONVEYOR SUPPLIERS.




RECORD DRAWING

THESE RECORD DRAWINGS HAVE BEEN PREPARED BASED ON PARTIAL INFORMATION PROVIDED BY OTHERS.

Date: 7/14/95
By: [Signature]

VERIFY SCALES

BAR IS ONE INCH ON ORIGINAL DRAWING
0 1"
IF NOT ONE INCH ON THIS SHEET, ADJUST SCALES ACCORDINGLY

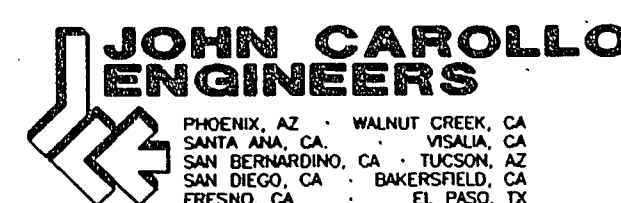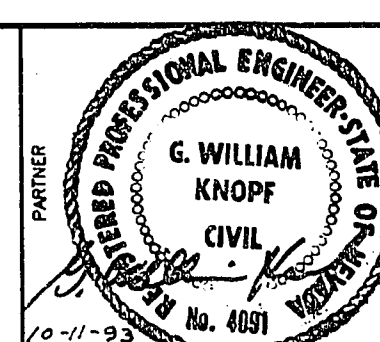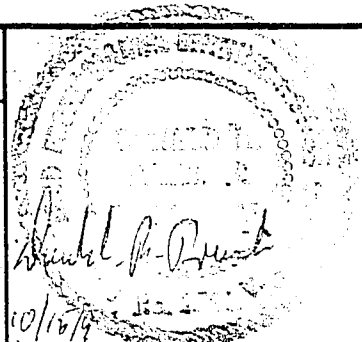

City of Las Vegas
DEPARTMENT OF PUBLIC WORKS

Las Vegas Water Pollution Control Facility
ODOR CONTROL AT HEADWORKS AND PRIMARY CLARIFIERS
SCREENINGS DEWATERING AND LOADING

JOB NO.
3752B.10
DRAWING NO.
M-9
SHEET NO.
56 OF 72

311.32