


N  
1" = 20'

- (A) HANDRAIL IS REMOVED AND ELECTRICAL CONDUIT HAS BEEN REROUTED TO RUN ALONG THE BOTTOM SIDE OF THE FOUL AIR SUPPORTS. (TYP OF 2)
- (B) OUTLET RECEPTACLES HAVE BEEN MOUNTED PER 815 TYP
- (C) NEW FEEDERS TO THE COLLECTIVE DRIVE UNITS ARE FED FROM OVERHEAD ALONG THE BOTTOM SIDE OF THE FOUL AIR SUPPORTS.
- (D) IN GROUND CONCRETE HANDHOLES ARE SUBSTITUTED IN PLACE OF PEDESTAL MOUNTED PULLBOXES.

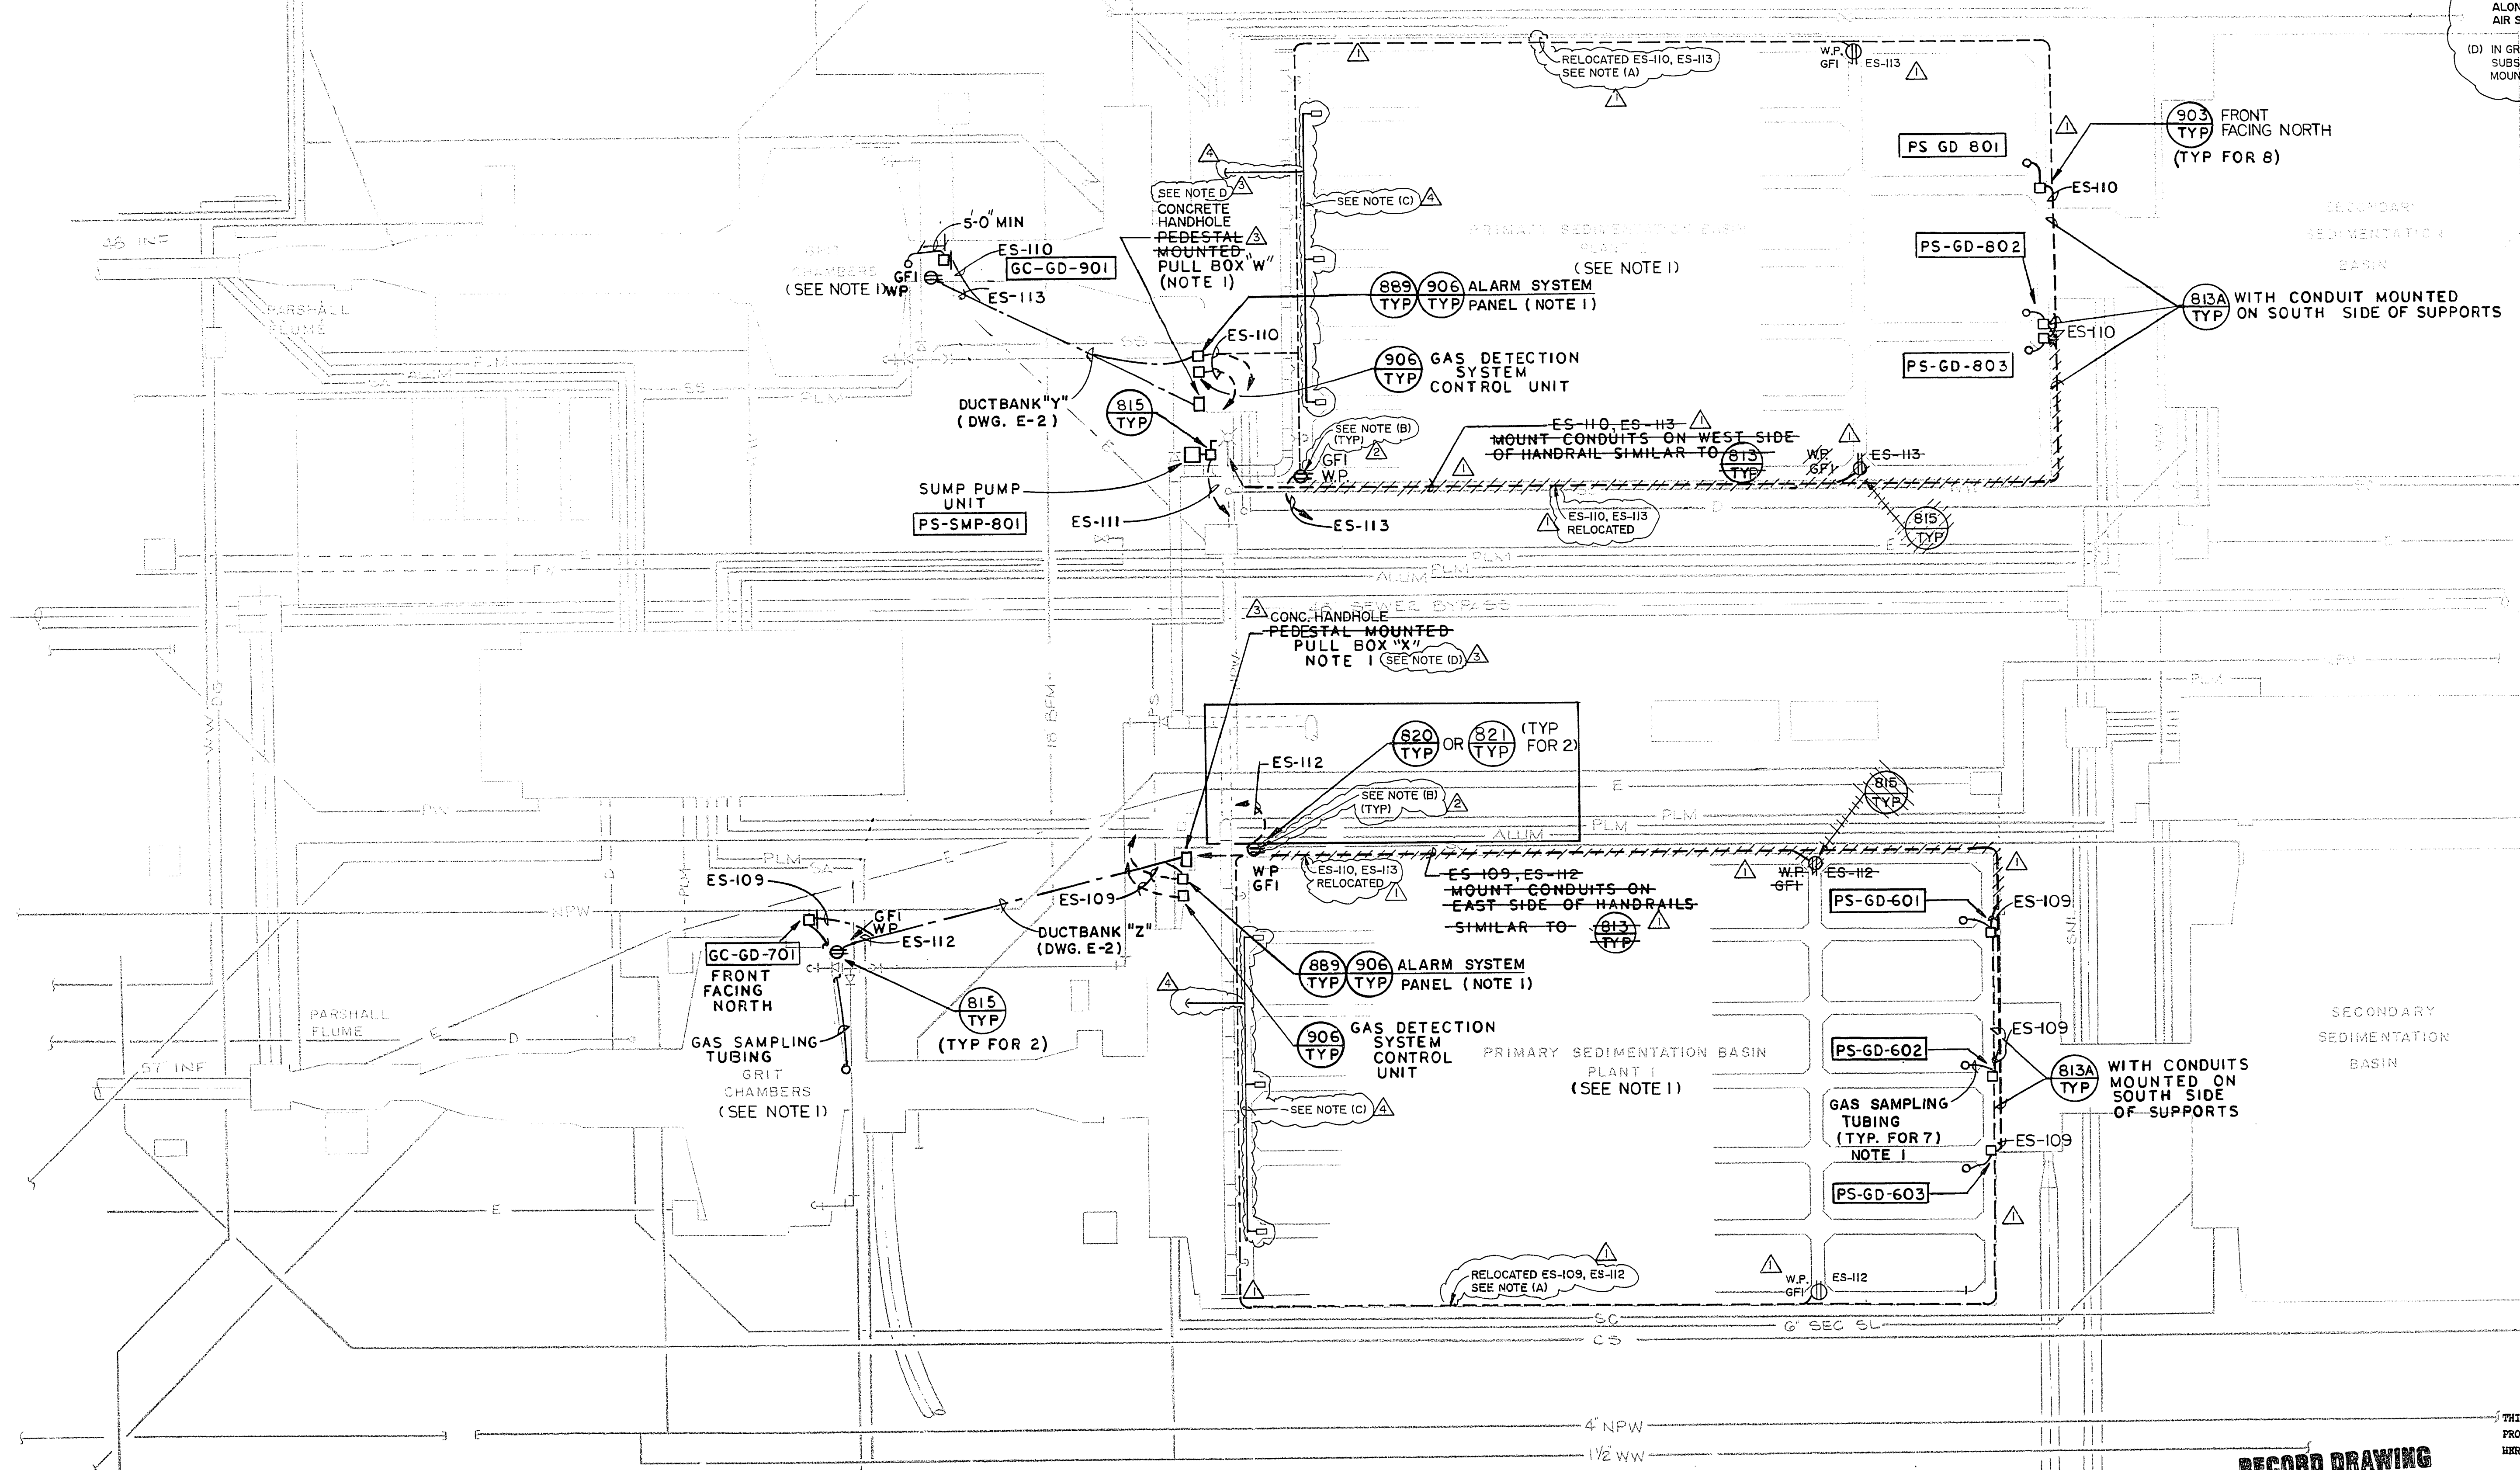

- NOTES
1. REFER TO NOTES 1 THRU 4 ON DWG. E-5
2. REFER TO NOTE 6.20 ON DWG. E-2

A PLANTS 1 & 2 GRIT CHAMBERS AND SEDIMENTATION BASINS (SEE NOTES)

RECORD DRAWING

THESE RECORD DRAWINGS HAVE BEEN PREPARED BASED ON PARTIAL INFORMATION PROVIDED BY OTHERS.

THIS DRAWING WAS PREPARED ONLY FOR THE PROJECT AND SITE SPECIFICALLY IDENTIFIED HEREON AND IS NOT TO BE USED ELSEWHERE

Date: 7/14/95

By: [Signature]

| YBIA    |      |      |     |                                                 |  |
|---------|------|------|-----|-------------------------------------------------|--|
| YOL-1D  |      | 3/95 | AMS | CONSTR. REV. - ADDED NOTES                      |  |
| YOL-1EB |      | 3/95 | AMS | PCH #24 - REROUTE CONDUIT FOR SED. DRIVE MOTORS |  |
| YOL-1EP |      | 3/95 | AMS | INSTALLED CONC. HANDHOLES IN LEU OF METAL PB'S  |  |
|         |      | 3/95 | AMS | MOUNT OUTLETS ONTO STANDS/HANDRAIL REMOVED      |  |
|         |      | 3/95 | AMS | REROUTE CONDUITS ON TO FOUL AIR SUPPORTS        |  |
| REV     | DATE | BY   |     | DESCRIPTION                                     |  |


|          |            |
|----------|------------|
| DESIGNED | JS         |
| DRAWN    | HFC        |
| CHECKED  | TL         |
| DATE     | SEPT. 1993 |

VERIFY SCALES

BAR IS ONE INCH ON ORIGINAL DRAWING

0 1"

IF NOT ONE INCH ON THIS SHEET, ADJUST SCALES ACCORDINGLY

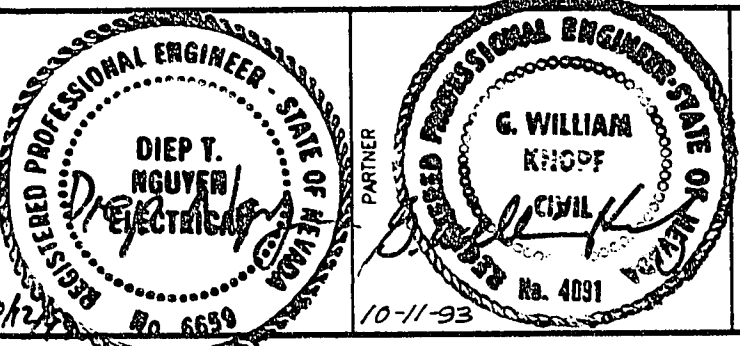

JOHN CAROLLO ENGINEERS

PHOENIX, AZ • WALNUT CREEK, CA  
SANTA ANA, CA • TUCSON, AZ  
SAN BERNARDINO, CA • BAKERSFIELD, CA  
SAN DIEGO, CA • EL PASO, TX

CITY OF LAS VEGAS

DEPARTMENT OF PUBLIC WORKS

Las Vegas Water Pollution Control Facility

ODOR CONTROL AT HEADWORKS AND PRIMARY CLARIFIERS

ELECTRICAL

PLANTS 1 & 2

GRIT CHAMBERS & SEDIMENTATION BASINS

|             |          |
|-------------|----------|
| JOB NO.     | 3752B.10 |
| DRAWING NO. | E-4      |
| SHEET NO.   | 60 OF 72 |