




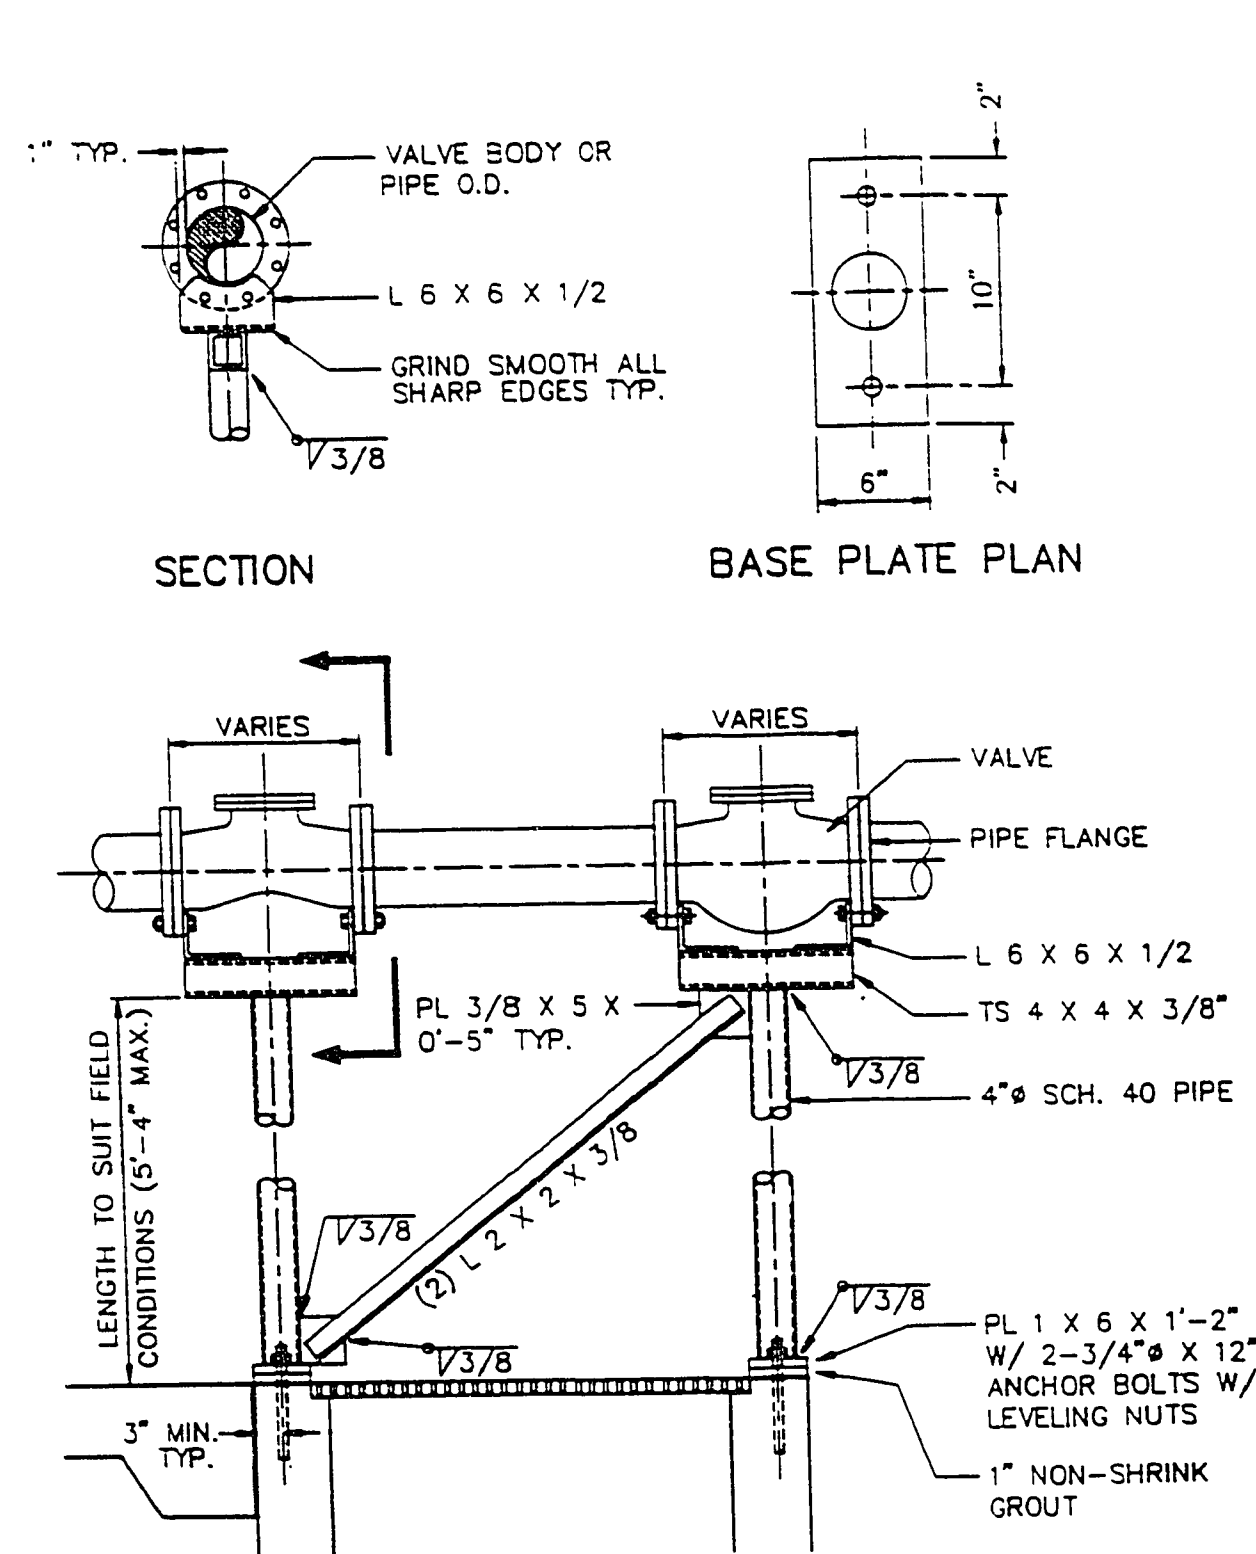


546 PIPE SUPPORT
TYP

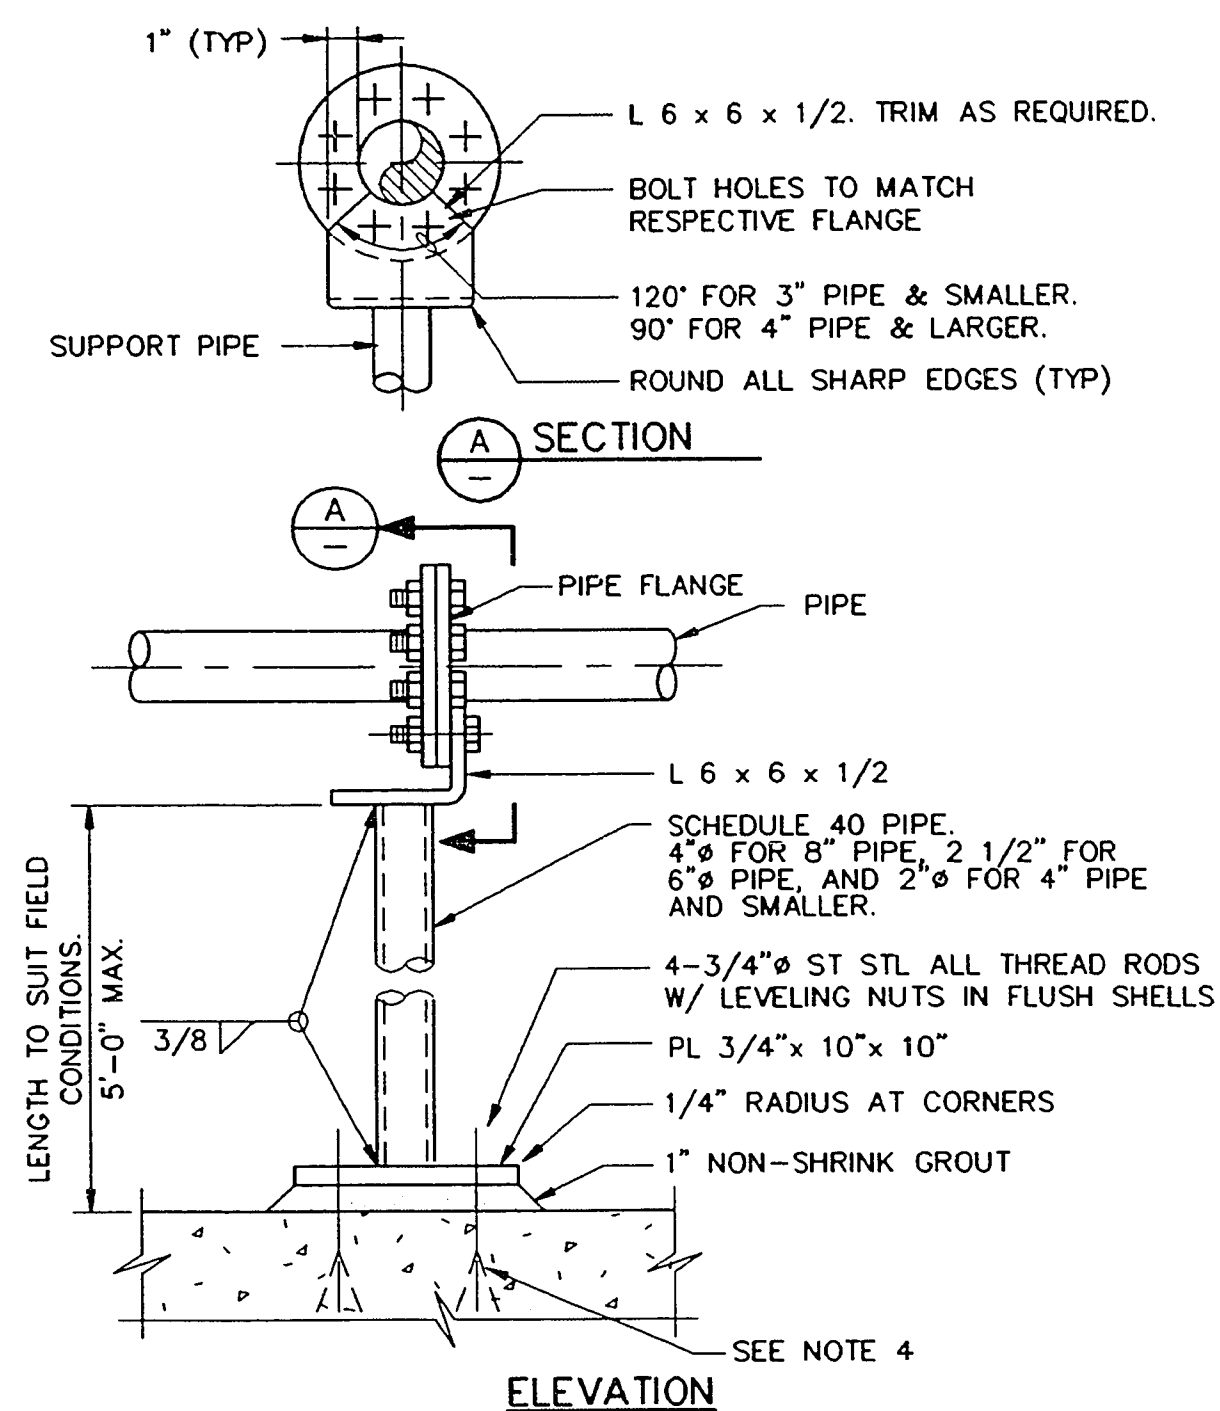


548 PIPE SUPPORT
TYP

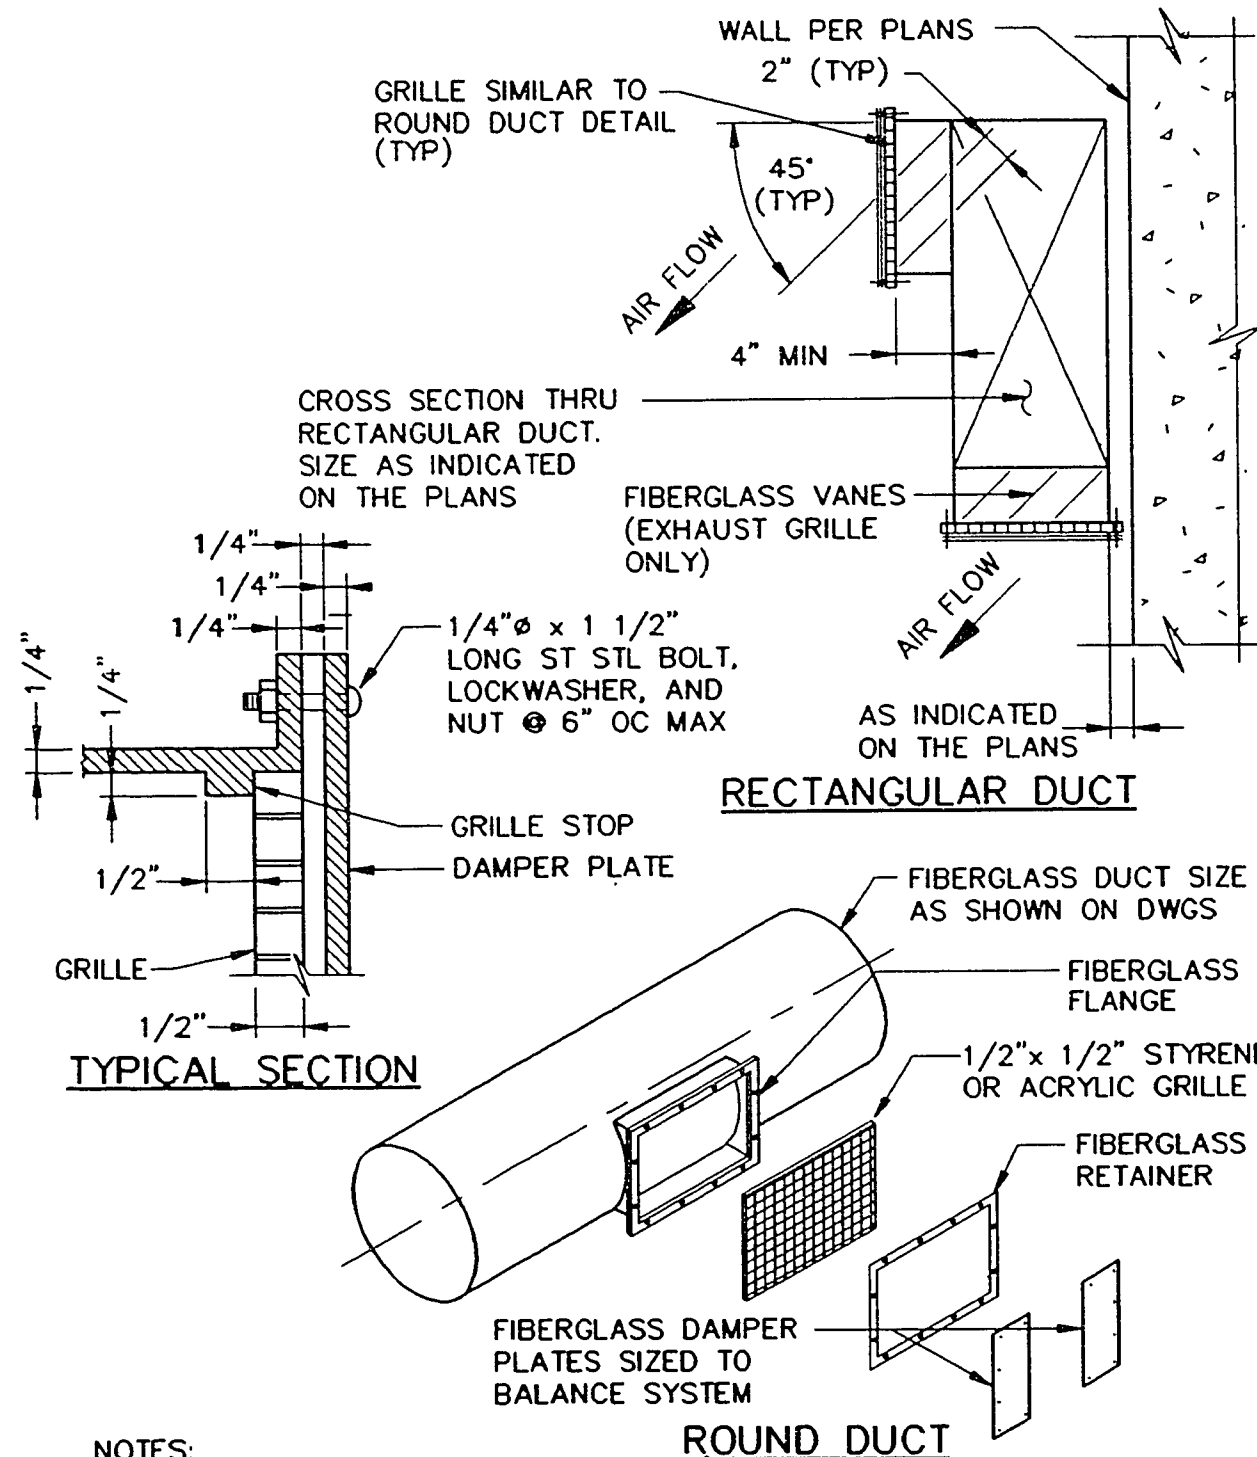


566 DETAIL - AIR SUPPLY OR EXHAUST GRILLE
TYP

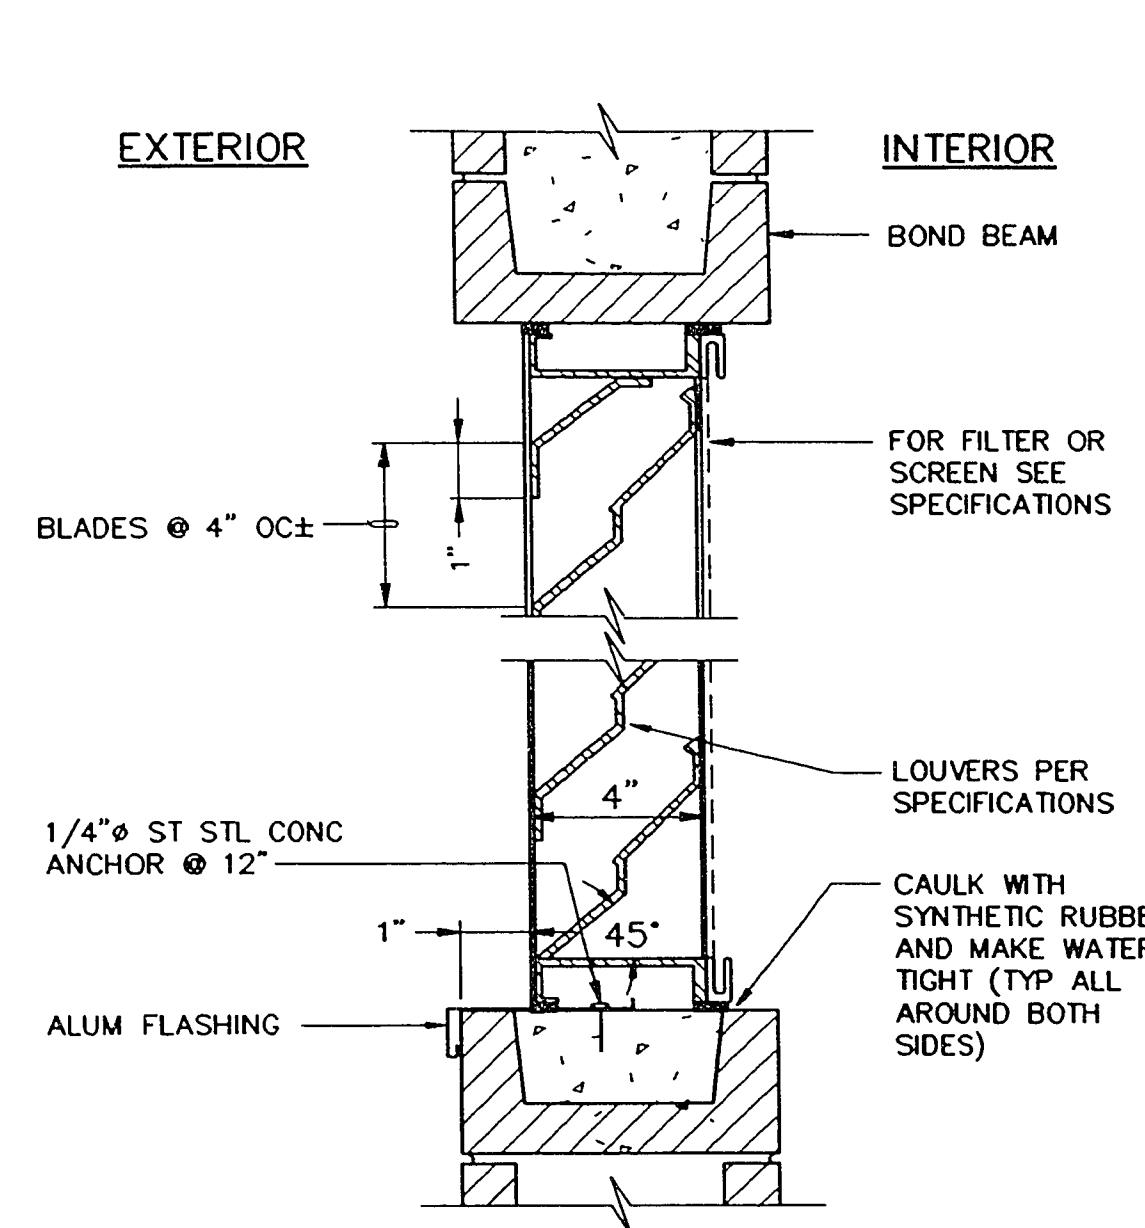

575 FIXED WALL LOUVER
TYP

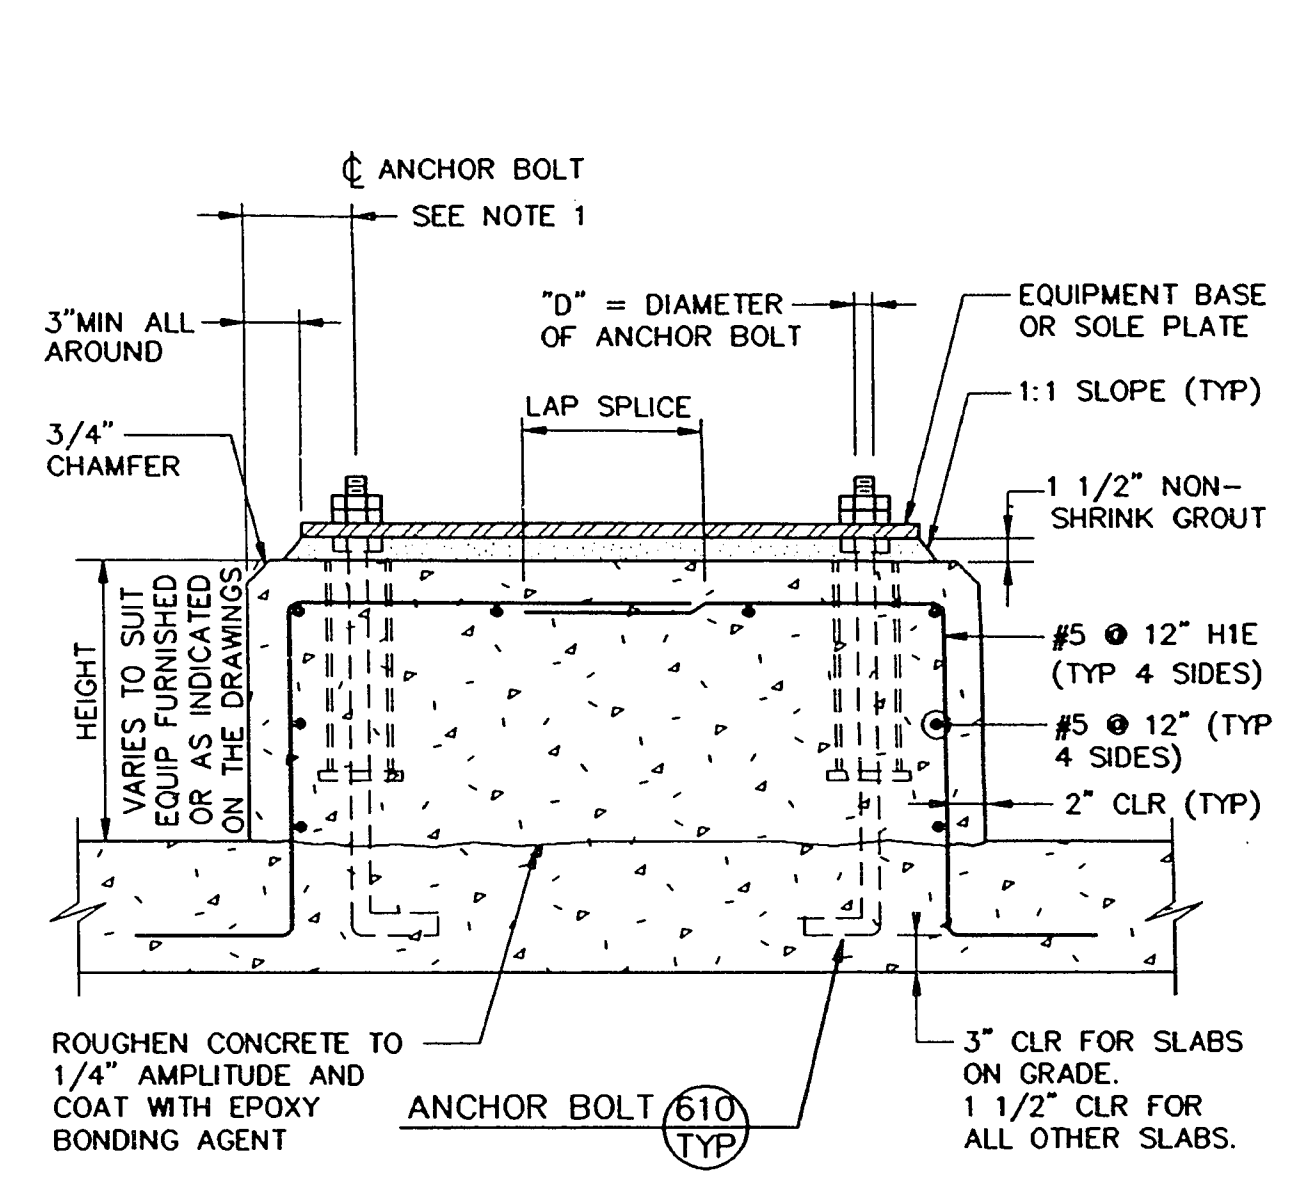

600 EQUIPMENT BASE
TYP

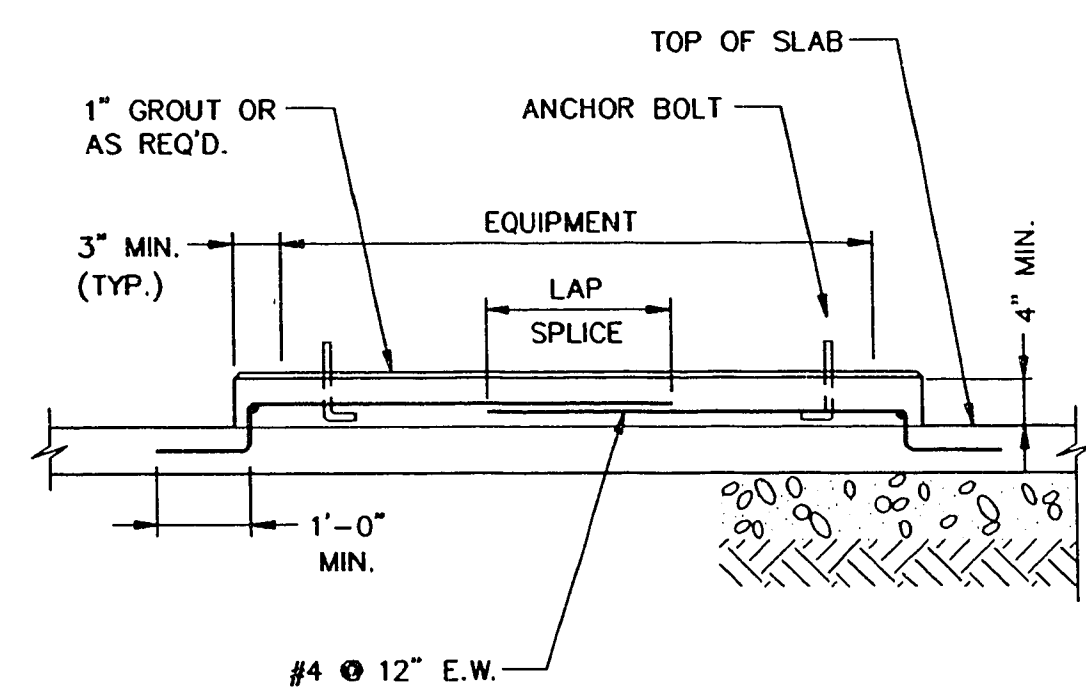

- NOTES:
- PAD DIMENSIONS, ANCHOR BOLT SIZE AND LOCATION AND OTHER EMBEDDED STEEL SHALL CONFORM TO EQUIPMENT MANUFACTURER'S RECOMMENDATION.
 - ALL MECHANICAL AND ELECTRICAL EQUIPMENT SHALL BE ANCHORED TO THE EQUIPMENT PAD, AND ANCHORAGES SHALL MEET THE REQUIREMENTS OF SEISMIC ZONE 3 PER SECTION 2336 OF UBC 91, AND SHALL WITHSTAND WIND UPLIFT DUE TO 100 MPH WIND W/ 1.3 GUST FACTOR, EXPOSURE C.


RECORD DRAWING

THESE RECORD DRAWINGS HAVE BEEN PREPARED BASED ON PART OR INFORMATION PROVIDED BY OTHERS.

THIS DRAWING WAS PREPARED ONLY FOR THE PROJECT AND SITE SPECIFICALLY IDENTIFIED HEREON AND IS NOT TO BE USED ELSEWHERE.


Date: 7/14/95
By: [Signature]

602 CONCRETE EQUIPMENT PAD
TYP

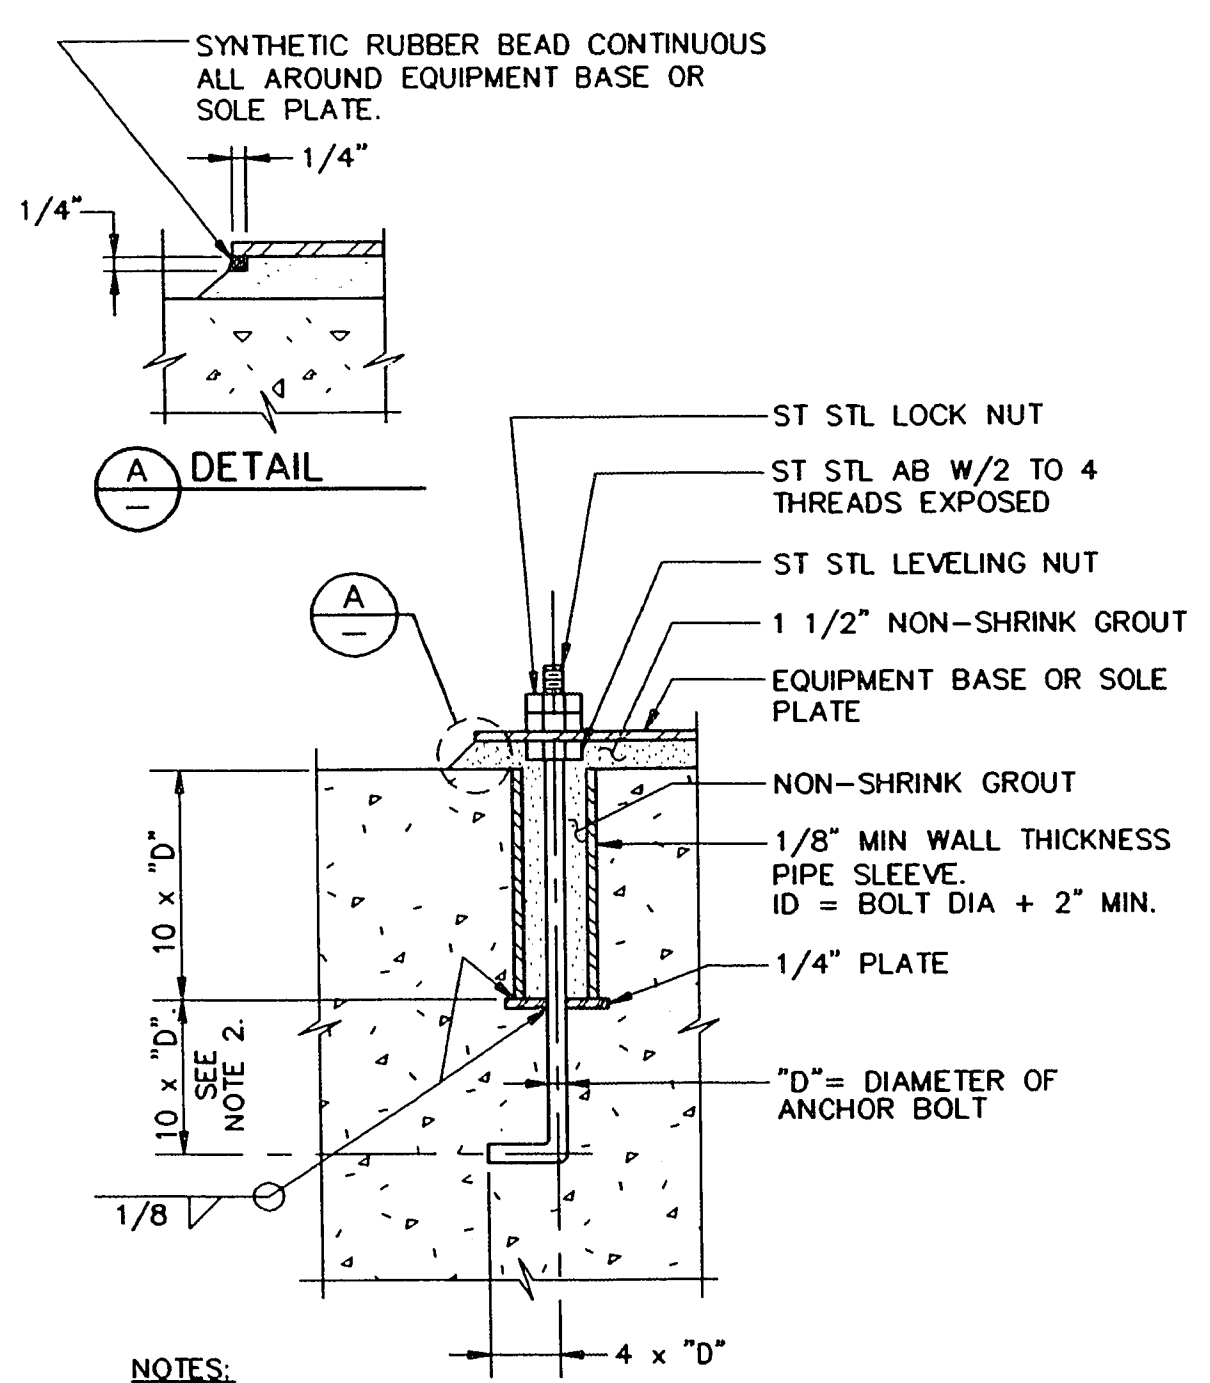


- NOTES:
- ANCHOR BOLT SIZE AND LENGTH AS INDICATED ON THE DRAWINGS. IF NOT INDICATED ON THE DRAWINGS, THE ANCHOR BOLT SIZE SHALL BE AS RECOMMENDED BY THE EQUIPMENT MANUFACTURER.
 - WHERE CONCRETE SLAB OR BEAM THICKNESS WILL NOT ACCOMMODATE THE ANCHOR BOLT, PROVIDE EXTRA THICKNESS OF SLAB OR BEAM.
 - PREFABRICATED PLASTIC ANCHOR BOLT SLEEVE OPTIONAL.


610 ANCHOR BOLT
TYP

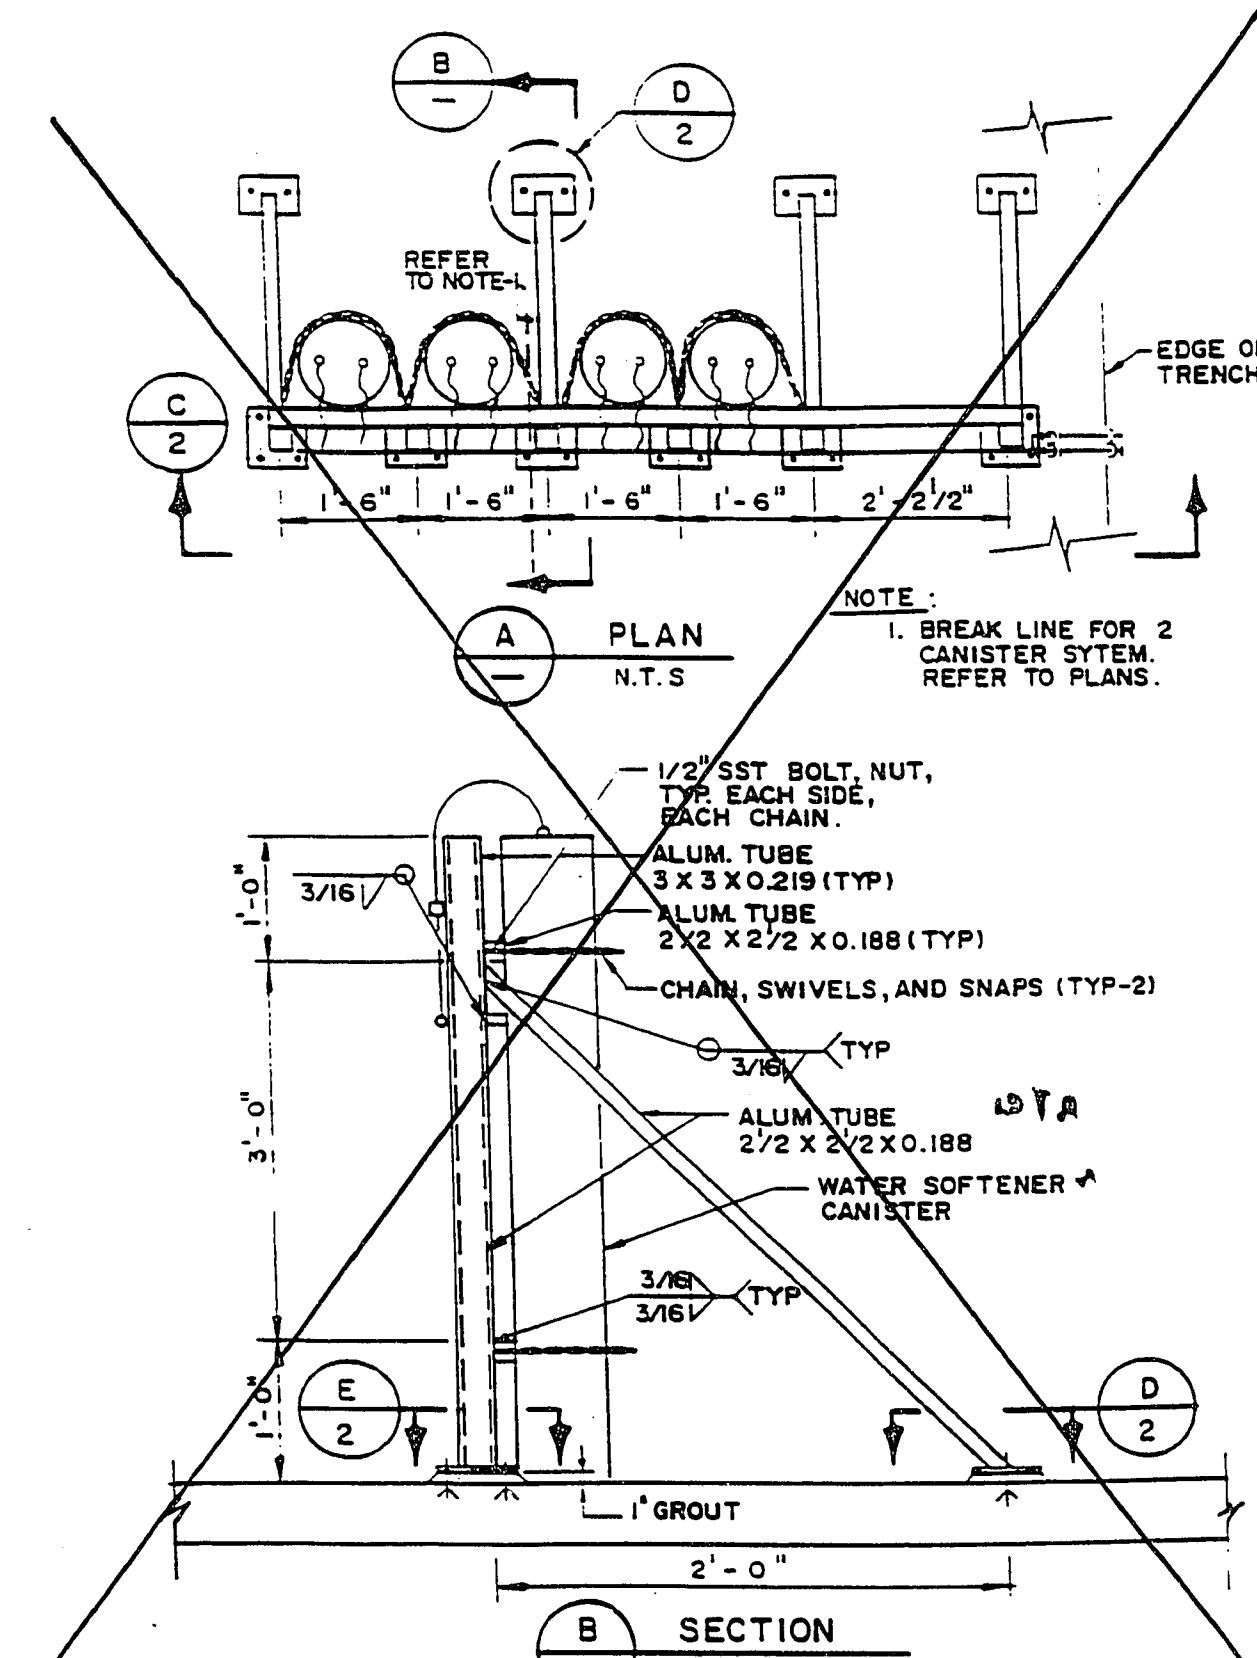


619 WATER SOFTENER SYSTEM
TYP - SHEET 1 OF 2

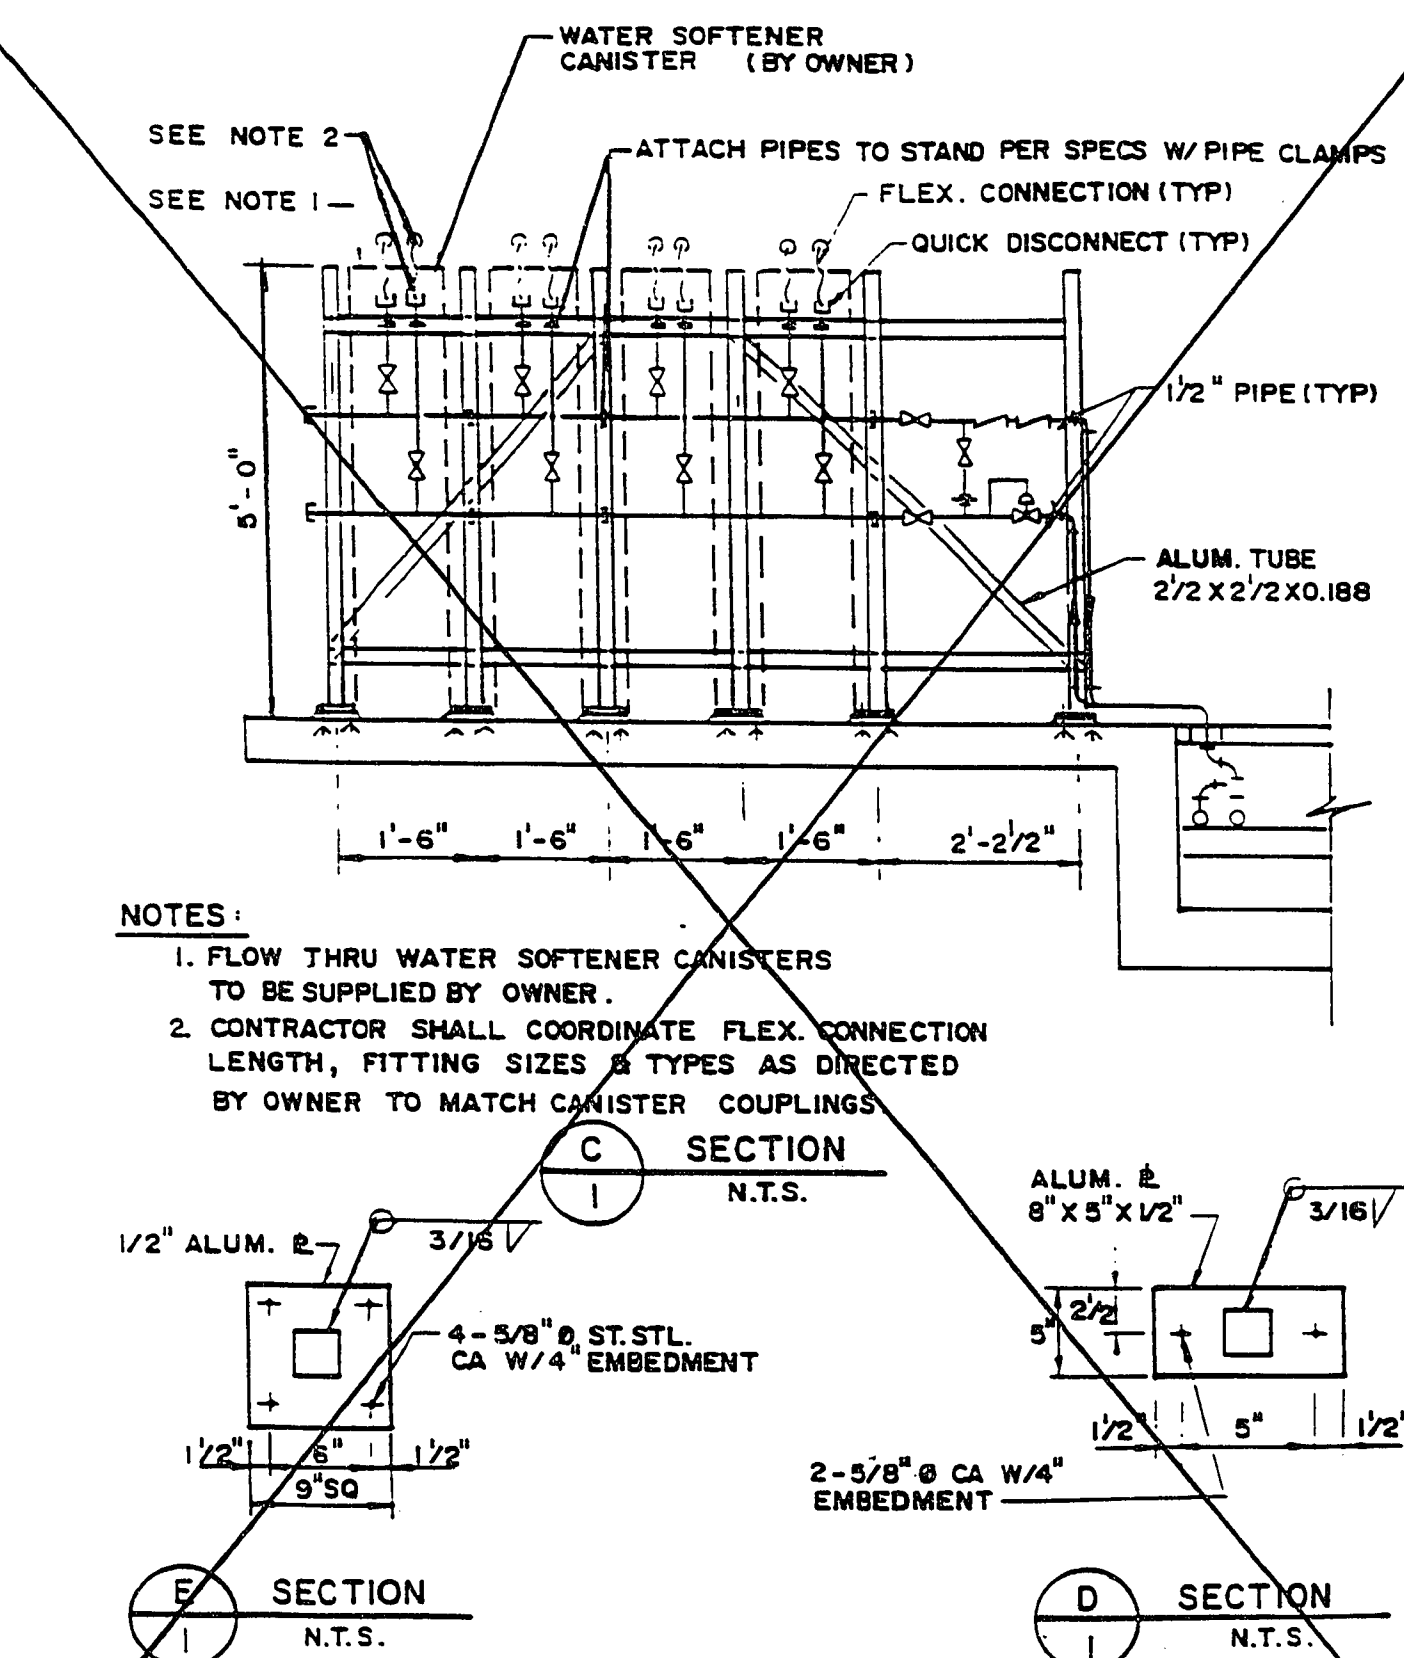

619 WATER SOFTENER SYSTEM
TYP - SHEET 2 OF 2

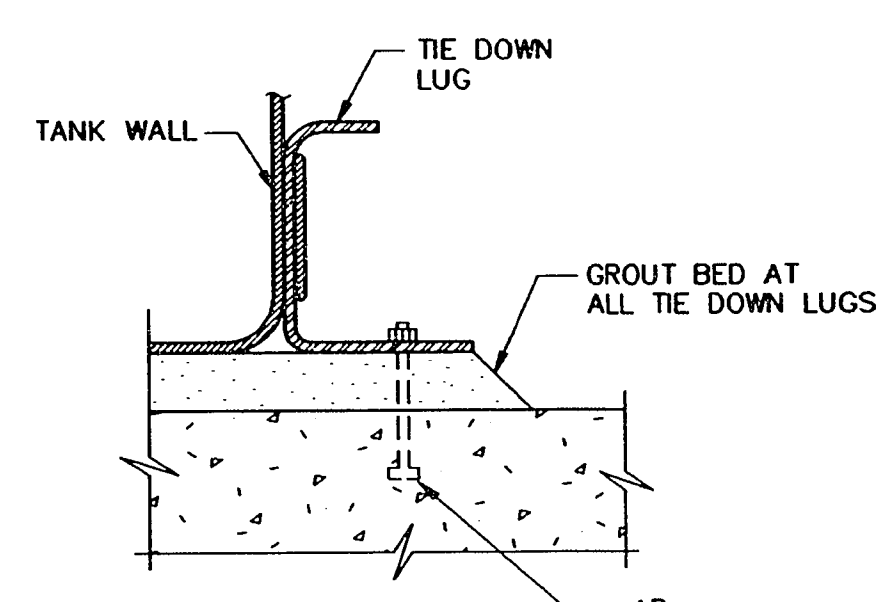

N SECTION

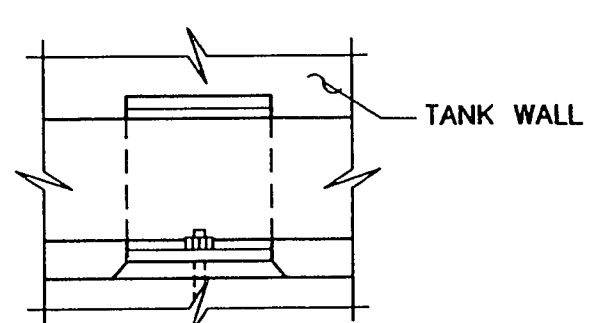

Q ELEVATION - TIE DOWN LUG

720 FIBERGLASS TANK
TYP

				DESIGNED JCE		VERIFY SCALES				 JOHN CAROLLO ENGINEERS		 City of Las Vegas		Las Vegas Water Pollution Control Facility		JOB NO. 3752B.10	
				DRAWN JCE		BAR IS ONE INCH ON ORIGINAL DRAWING								ODOR CONTROL AT HEADWORKS AND PRIMARY CLARIFIERS		DRAWING NO. T-8	
				CHECKED JCE		0 1"											
				DATE SEPT 1993		IF NOT ONE INCH ON THIS SHEET, ADJUST SCALES ACCORDINGLY										SHEET NO. 13 OF 72	
 3/95 AMS DELETE SOFTENER RACK																	
REV. DATE BY DESCRIPTION																	

8-1-13

311.32

DATE & TIME: 10/09/95 10:39:10 3752B/SSLV022.DWG XREFS: NONE