




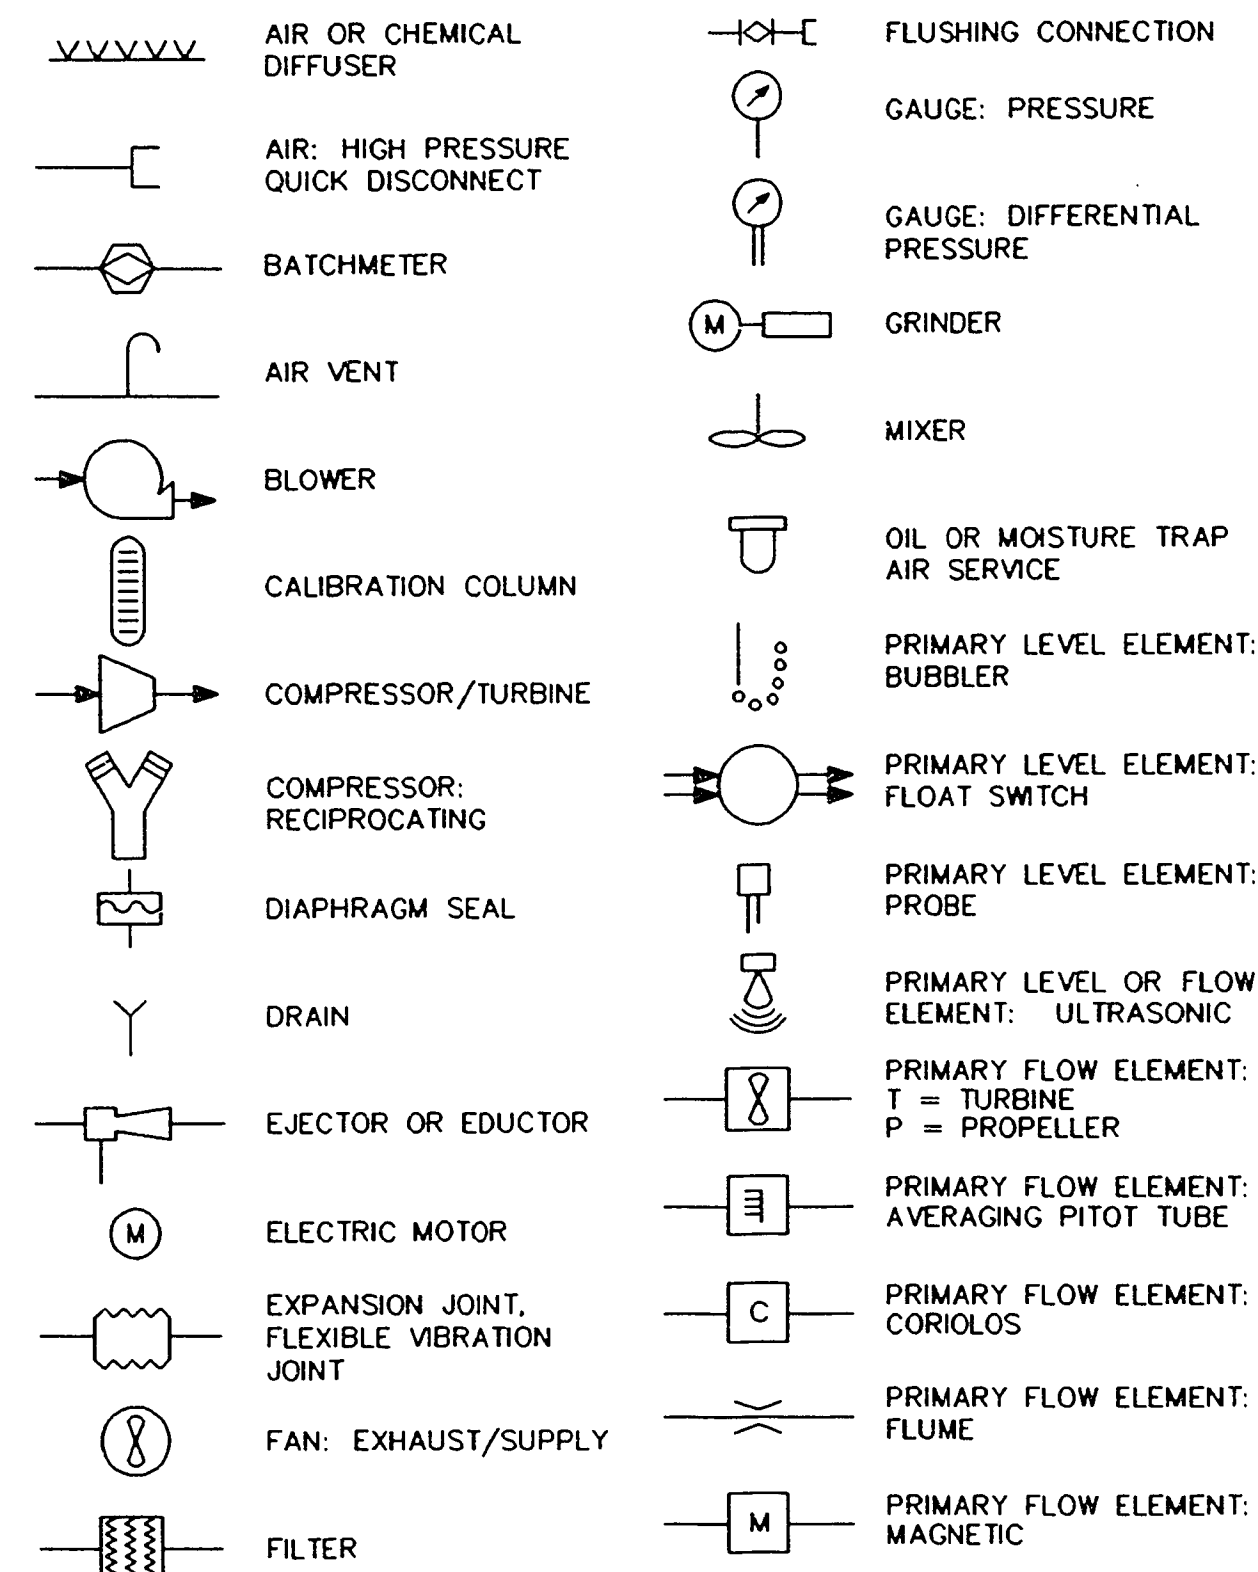


950. PIPING SYMBOLS AND ABBREVIATIONS
TYP SHEET 1 OF 3

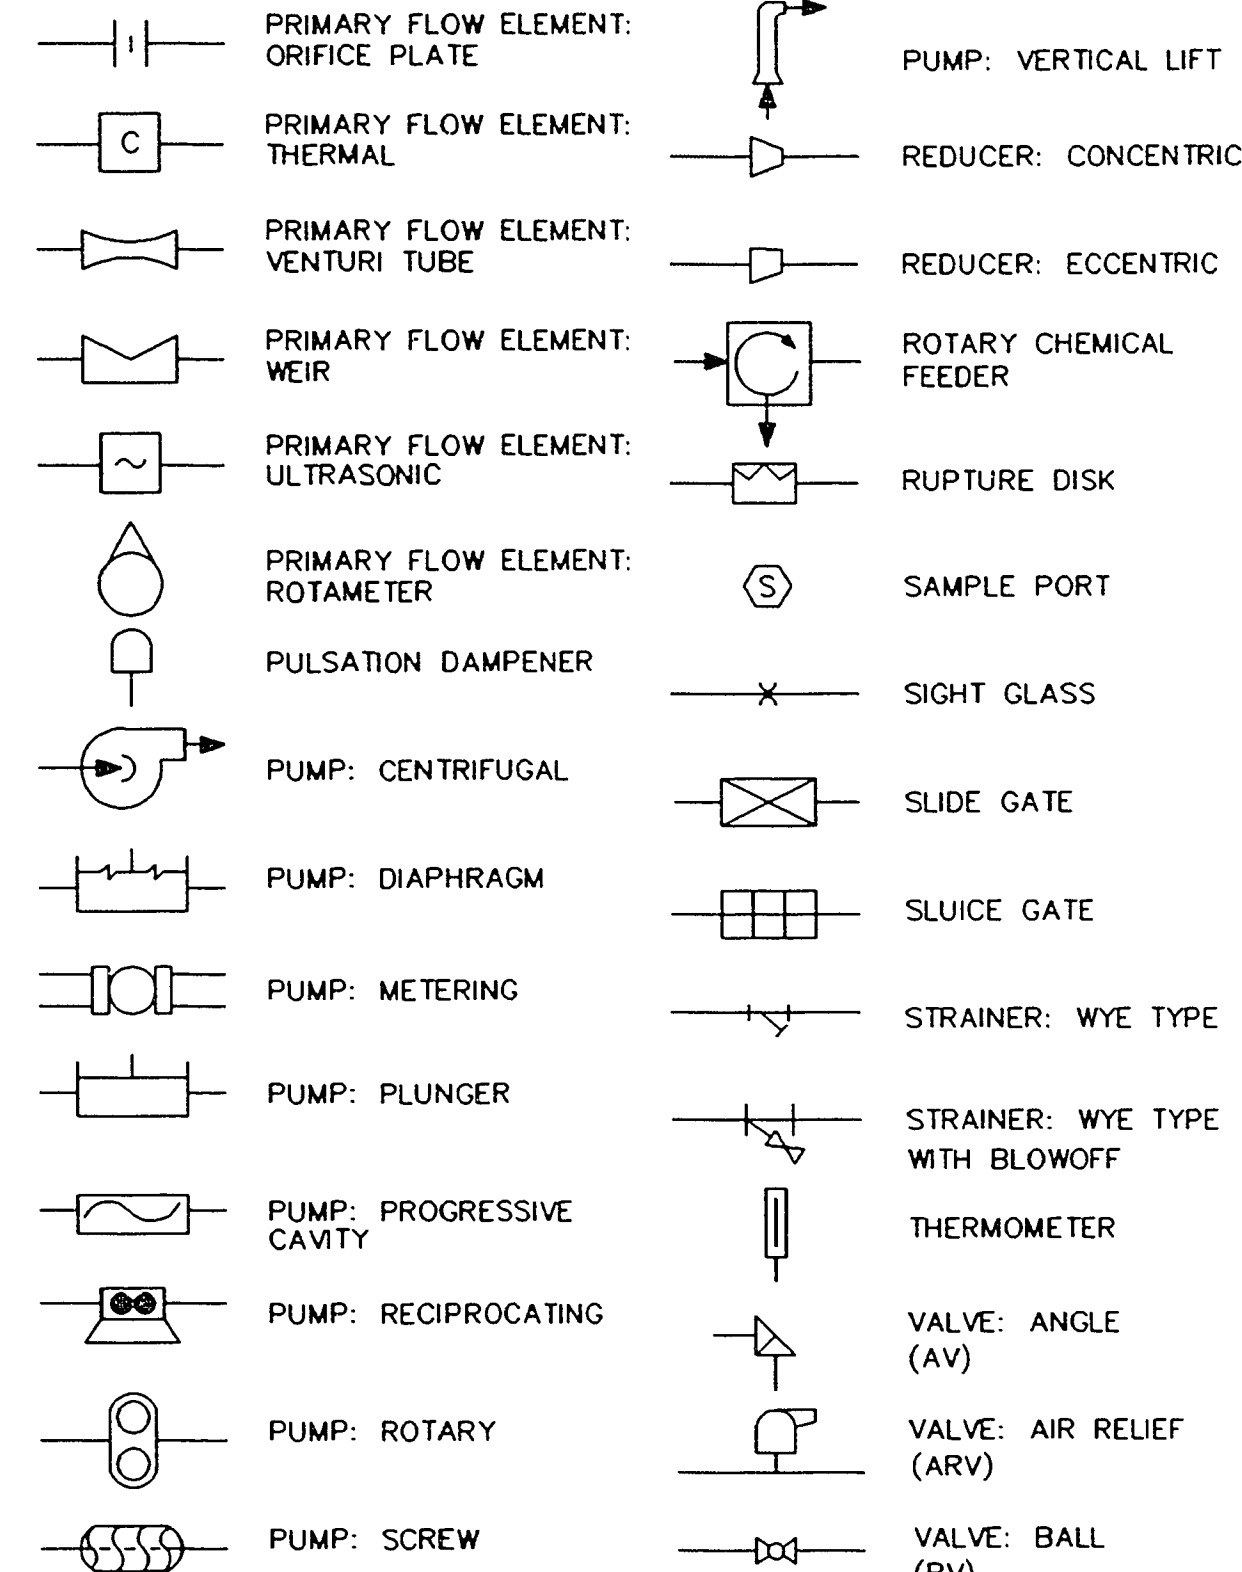

950. PIPING SYMBOLS AND ABBREVIATIONS
TYP SHEET 2 OF 3

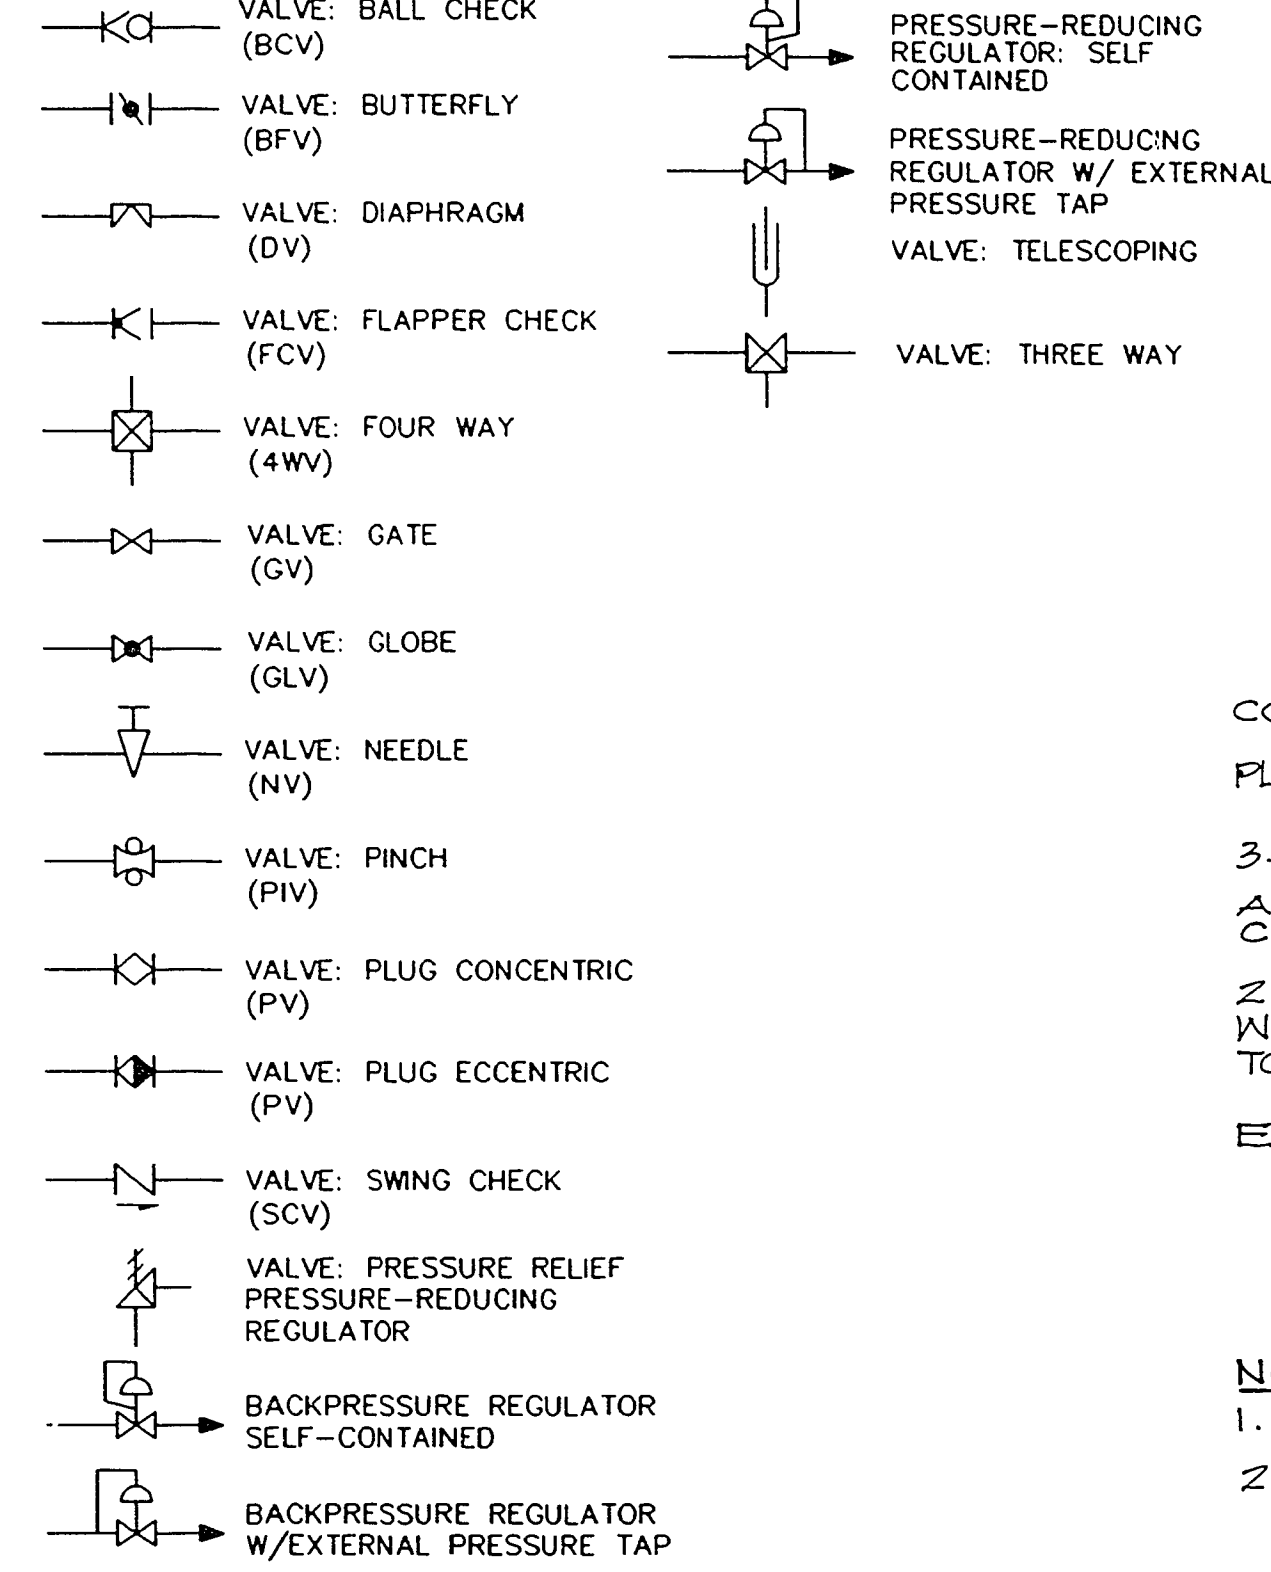

950. PIPING SYMBOLS AND ABBREVIATIONS
TYP SHEET 3 OF 3

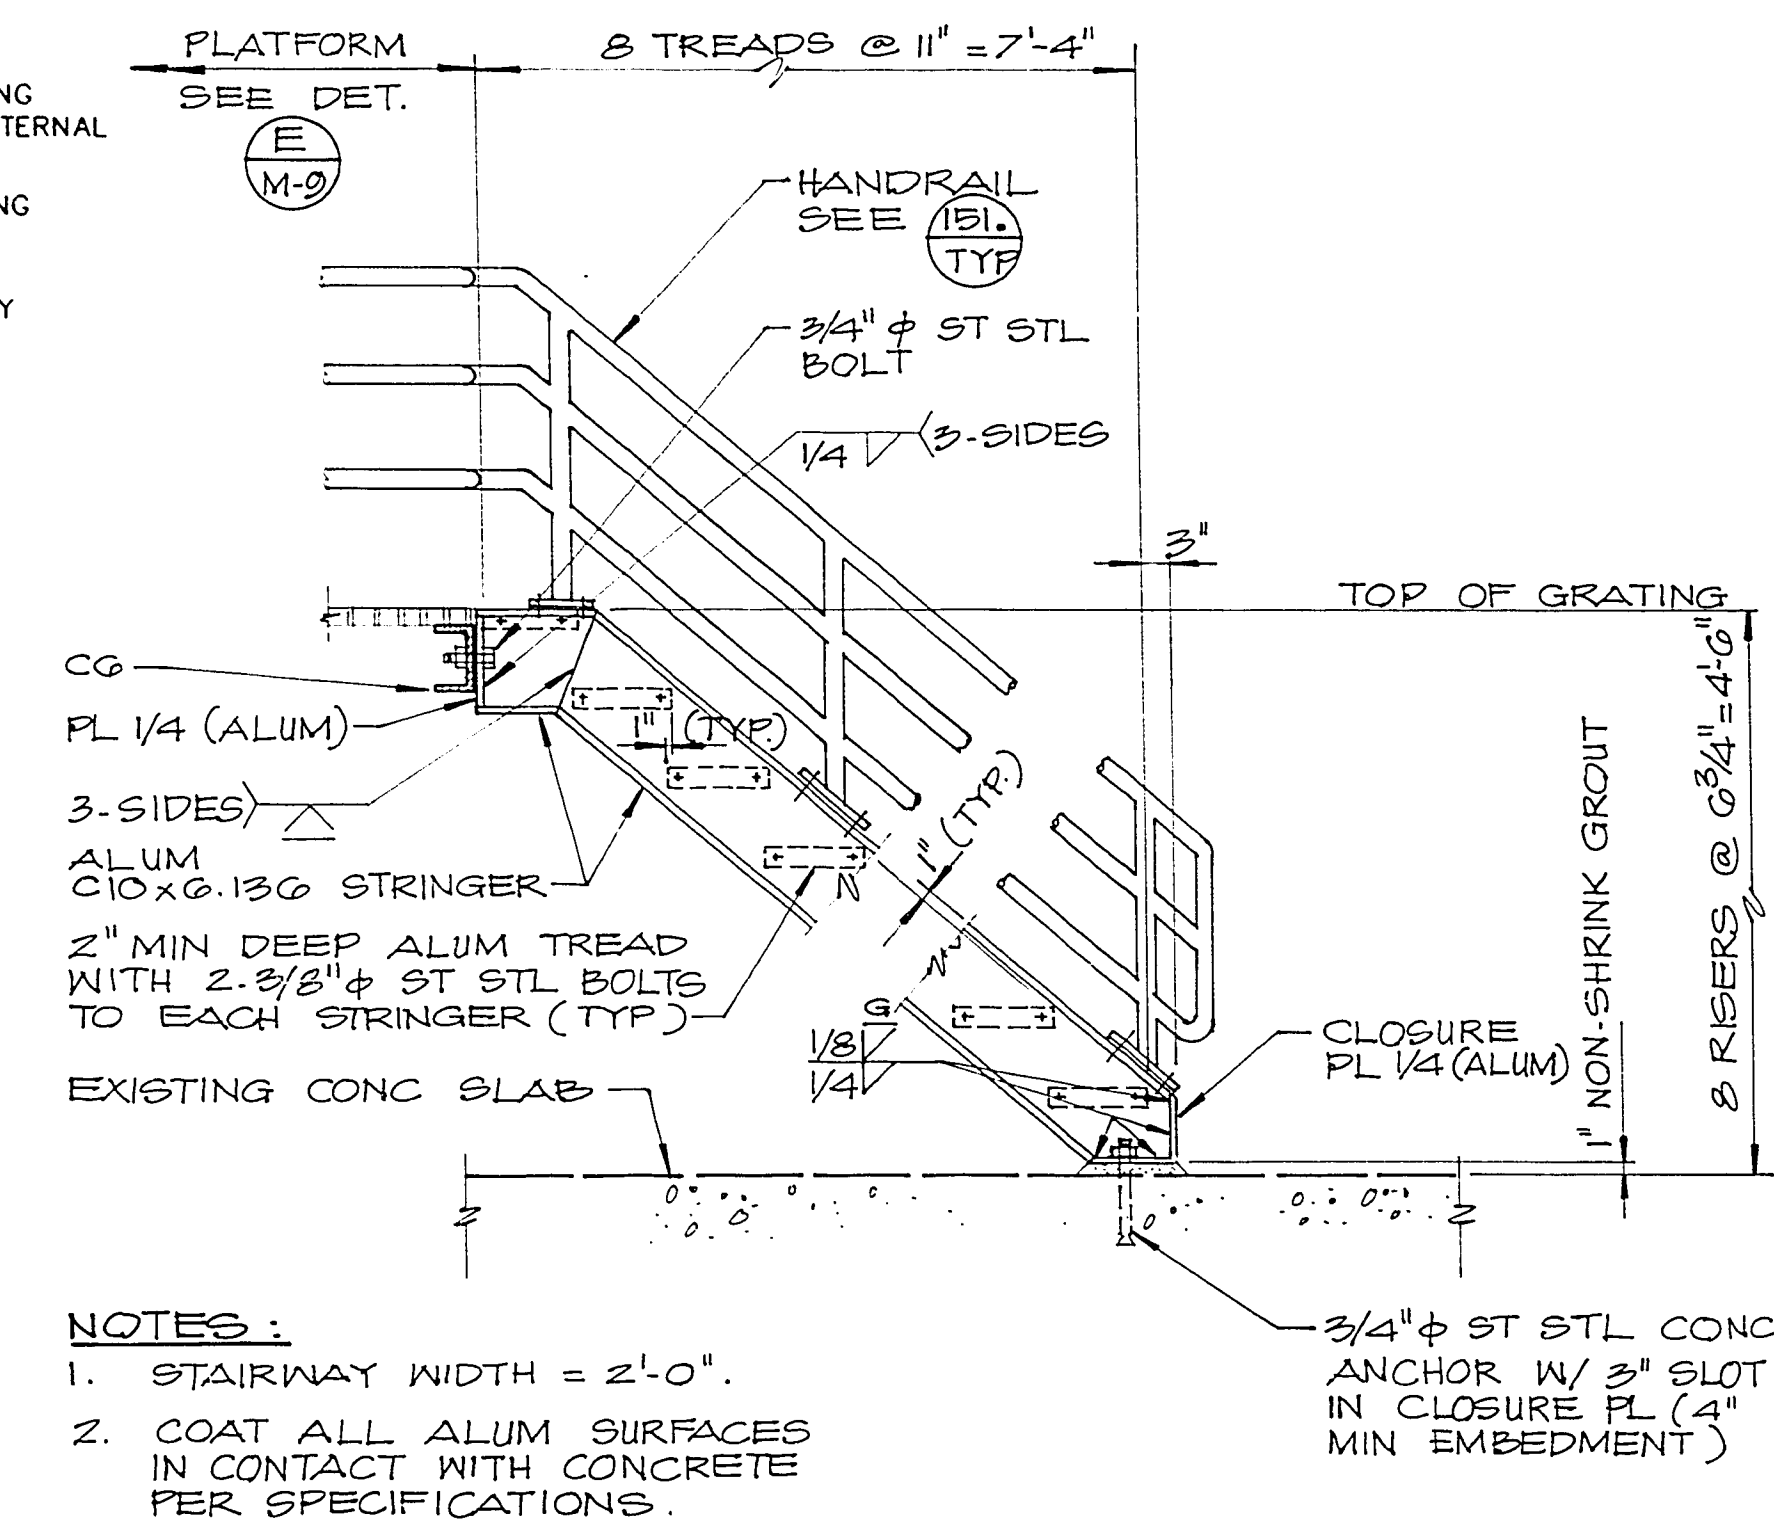

951 ALUMINUM STAIR
TYP

RECORD DRAWING

THESE RECORD DRAWINGS HAVE BEEN PREPARED BASED
ON PARTIAL INFORMATION PROVIDED BY OTHERS.

THIS DRAWING WAS PREPARED ONLY FOR THE
PROJECT AND SITE SPECIFICALLY IDENTIFIED
HEREON AND IS NOT TO BE USED ELSEWHERE

Date 7/14/95

By [Signature]


REV.	DATE	BY	DESCRIPTION

DESIGNED JCE
DRAWN JCE
CHECKED JCE
DATE SEPT 1993


VERIFY SCALES

BAR IS ONE INCH ON
ORIGINAL DRAWING
0 1"

IF NOT ONE INCH ON
THIS SHEET, ADJUST
SCALES ACCORDINGLY

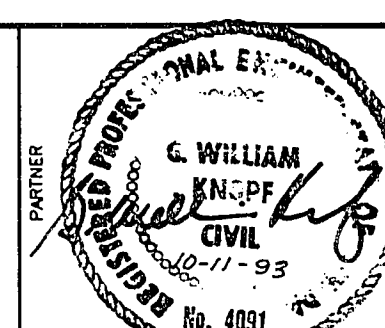

JOHN CAROLLO ENGINEERS
PHOENIX, AZ • WALNUT CREEK, CA
SANTA ANA, CA • VISALIA, CA
SAN BERNARDINO, CA • TUCSON, AZ
SAN DIEGO, CA • BAKERSFIELD, CA
FRESNO, CA • EL PASO, TX

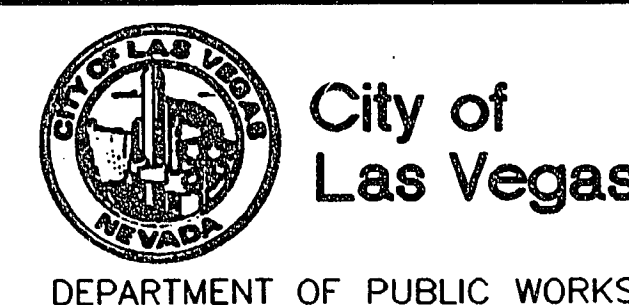

Las Vegas Water Pollution Control Facility	JOB NO. 3752B.10
ODOR CONTROL AT HEADWORKS AND PRIMARY CLARIFIERS	DRAWING NO. T-13
TYPICAL DETAILS	SHEET NO. 18 OF 72